


APPENDIX B

**HISTORICAL MINERAL WATER SYSTEM
INFORMATION**



Street and Lot Layout

Prepared by
 Horton Dennis and Associates, Incorporated

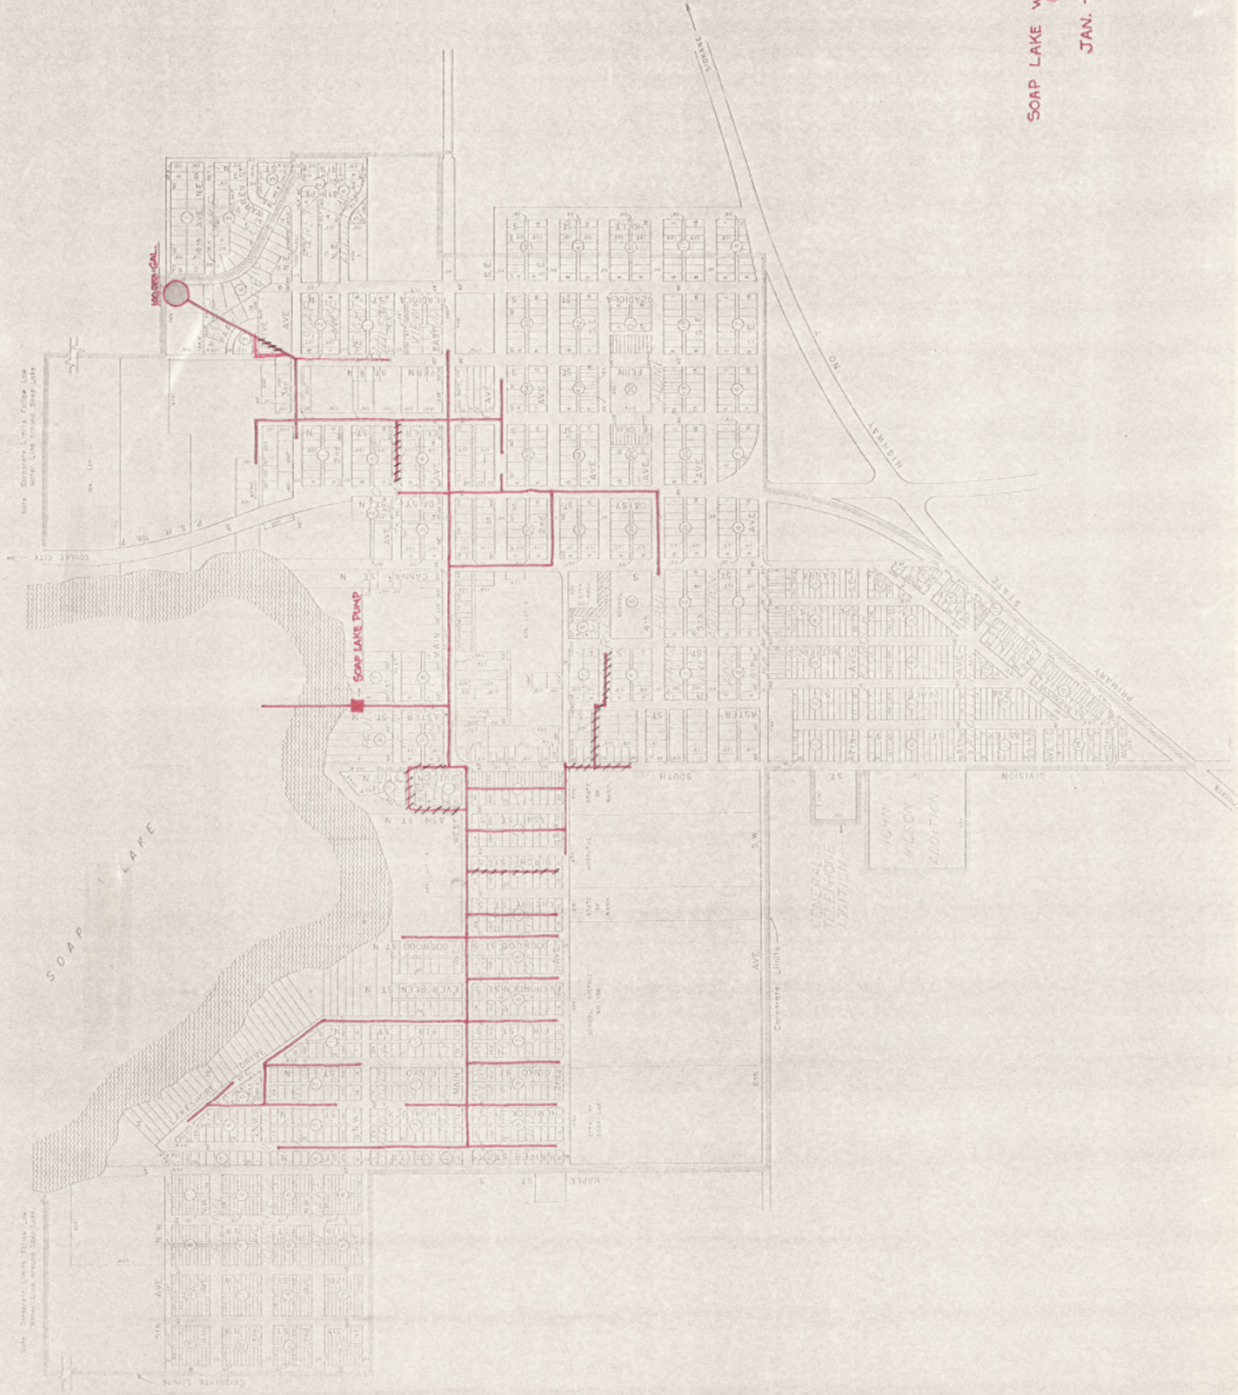

SOAP LAKE WATER SYSTEM
 (GENERAL)
 JAN. - 1987

1. MAIN AVE. WEST & DIVISION STREET
2. MAIN AVE. WEST & ALLEY WEST OF DIVISION
3. MAIN AVE. WEST & ASH ST. N. & S.
4. MAIN AVE. WEST & ALLEY BETWEEN ASH & BIRCH
5. MAIN AVE. WEST & BIRCH STREET SOUTH
6. MAIN AVE. WEST & ALLEY BETWEEN BIRCH & CHERRY
7. MAIN AVE. WEST & CHERRY STREET SOUTH
8. MAIN AVE. WEST & ALLEY BETWEEN CHERRY & DOGWOOD
9. MAIN AVE. WEST & DOGWOOD STREET SOUTH & NORTH
10. MAIN AVE. WEST & DOGWOOD STREET NORTH
11. MAIN AVE. WEST & EVERGREEN STREET NORTH
12. MAIN AVE. WEST & FIR STREET NORTH & SOUTH
13. MAIN AVE. WEST & GINKO STREET NORTH & SOUTH
14. MAIN AVE. WEST & HEMLOCK STREET
15. MAIN AVE. WEST & JUNIPER STREET NORTH & SOUTH
16. MAIN AVE. WEST & MAPLE STREET NORTH & SOUTH
17. 1ST. AVE. NW. & ASH STREET NORTH
18. 1ST. AVE. NW. & FIR STREET NORTH
19. 1ST. AVE. NW. & GINKGO STREET NORTH
20. 1ST. AVE. NW. & HEMLOCK STREET NORTH
21. 1ST. AVE. NW. & JUNIPER STREET NORTH
22. L.S. DRIVE & ALLEY BETWEEN FIR & GINKGO STREET NORTH
23. L.S. DRIVE & 3RD. AVE. NW. & GINKGO STREET NORTH
24. 3RD. AVE. NW. & HEMLOCK STREET NORTH
25. 3RD. AVE. NW. & JUNIPER STREET NORTH
26. L.S. DRIVE & HEMLOCK STREET NORTH
27. L.S. DRIVE & JUNIPER STREET NORTH

PAGE TWO

28. 2ND. AVE. & DIVISION STREET
29. 2ND. AVE. SW. & ALLEY BETWEEN DIVISION & ASH S.
30. 2ND. AVE. SW. & ASH STREET SOUTH
31. 2ND. AVE. SW. ALLEY BETWEEN ASH & BIRCH SOUTH
32. 2ND. AVE. SW. & BIRCH STREET SOUTH
33. 2ND. AVE. SW. & CHERRY STREET SOUTH
34. 2ND. AVE. SW. & DOGWOOD STREET SOUTH
35. 2ND. AVE. SW. & EVERGREEN STREET SOUTH
36. 2ND. AVE. SW. & FIR STREET SOUTH
37. 2ND. AVE. SW. & GINKGO STREET SOUTH
38. 2ND. AVE. SW. & HEMLOCK STREET SOUTH
39. 2ND. AVE. SW. & JUNIPER STREET SOUTH
40. 2ND. AVE. SW. & MAPLE STREET SOUTH
41. MAIN AVE EAST & DIVISION NORTH
42. MAIN AVE. EAST & ASTER STREET NORTH
43. MAIN AVE. EAST & WHERE BUTTERCUP SHOULD BE.
44. MAIN AVE. EAST & CANNA & DAISY STREET NORTH & SOUTH
45. MAIN AVE. EAST & CANNA NORTH & SOUTH
46. MAIN AVE. EAST & DAISY STREET NORTH & SOUTH
47. MAIN AVE. EAST & ELDER STREET NORTH & SOUTH
48. MAIN AVE. EAST & FERN STREET NORTH & SOUTH
49. MAIN AVE. EAST & GLADIOLA NORTH & WEST HAVEN
50. 1ST AVE. NE. & CANNA STREET NORTH
51. 1ST AVE NE. & ALLEY THROUGH PARK BEHIND B&B

PAGE THREE

52. 1ST AVE. NE. & DAISY STREET NORTH
53. 1ST AVE. NE. & ELDER STREET NORTH
54. 1ST AVE. NE. & FERN STREET NORTH
55. 1ST AVE. NE. & GLADIOLA STREET NORTH
56. 2ND AVE. NE. & DAISY NORTH
57. 2ND AVE. NE. & ELDER STREET NORTH
58. 2ND AVE. NE. & FERN STREET NORTH
59. 2ND AVE. NE. & GLADIOLA STREET NORTH
60. 2ND AVE. NE. & GLADIOLA & HOLLY STREET NORTH
61. 2ND AVE. NE. & IRIS STREET NORTH
62. 3RD AVE. NE. & DAISY STREET NORTH
63. 3RD AVE. NE. & ELDER NORTH
64. 3RD AVE. NE. & FERN STREET NORTH
65. 3RD AVE. NE. & GLADIOLA STREET NORTH
66. 3RD AVE. NE. GLADIOLA NORTH # 2 LOTS 5,6
67. 3RD AVE. NE. & IRIS STREET NORTH
68. 4TH AVE. NE. & DAISY NORTH
69. 4TH AVE. NE. & ELDER STREET NORTH
70. 4TH AVE. NE. & FERN & PARK DRIVE
71. DAISY & SMOKIAM ENTRANCE
72. 1ST AVE SE. & FERN STREET SOUTH
73. 1ST AVE. SE. & CANNA STREET SOUTH
74. 1ST AVE. SE. & DAISY STREET SOUTH
75. 1ST AVE. SE. & ELDER STREET SOUTH

PAGE FOUR


76. 2ND AVE. SE. & ASTER STREET SOUTH
77. 2ND AVE. SE. & BUTTERCUP SOUTH
78. 2ND AVE. SE. & IN FRONT OF COMMUNITY CENTER
79. 2ND AVE. SE. & CANNA STREET SOUTH
80. 2ND AVE. SE. & DAISY STREET SOUTH
81. 2ND AVE. SE. & ELDER (FUTURE MAP)
82. 2ND AVE. SE. & FERN STREET SOUTH
83. 3RD AVE. SE. & DIVISION STREET SOUTH
84. 3RD AVE. SE. & ASTER STREET SOUTH
85. 3RD AVE. SE. & BUTTERCUP STREET SOUTH
86. 3RD AVE. SE. & CANNA STREET SOUTH
87. 3RD AVE. SE. & DAISY STREET SOUTH
88. 3RD AVE. SE. & ELDER STREET SOUTH
89. 3RD AVE. SE. & FERN STREET SOUTH
90. 4TH AVE. SE. & DIVISION STREET SOUTH
91. 4TH PLACE & 4TH SE. & ASTER STREET SOUTH
92. 4TH PLACE & 4TH SE. & BUTTERCUP STREET SOUTH
93. 4TH AVE. SE. & CANNA STREET SOUTH
94. 4TH AVE. SE. & DAISY STREET SOUTH
95. 4TH AVE. SE. & ELDER STREET SOUTH
96. 4TH AVE. SE & FERN STREET SOUTH
97. 5TH AVE. SE. & DIVISION STREET SOUTH
98. 5TH AVE. SE. & ASTER STREET SOUTH
99. 5TH AVE. SE. & BUTTERCUP STREET SOUTH

PAGE FIVE

100. 5TH AVE. SE. & CANNA STREET SOUTH
101. 5TH AVE. SE. & DAISY STREET SOUTH
102. 5TH AVE. SE. & ELDER STREET SOUTH
103. 5TH AVE. SE. & DIVISION STREET SOUTH
104. 6TH AVE. SE. & DIVISION STREET SOUTH
105. 6TH AVE. SE. & ASTER STREET SOUTH
106. 6TH AVE. SE. & 3RD PLACE
107. 6TH AVE. SE. & BUTTERCUP SOUTH
108. 6TH AVE. SE. & 2ND PLACE
109. 6TH AVE. SE. & CANNA STREET SOUTH
110. 6TH AVE. SE. & DAISY STREET SOUTH
111. 6TH AVE. SE. & ELDER STREET SOUTH
112. 7TH AVE. SW. & DIVISION STREET SOUTH
113. 7TH AVE. SE. & ASTER STREET SOUTH
114. 7TH AVE. SE. & 3RD PLACE
115. 7TH AVE. SE. & BUTTERCUP STREET SOUTH
116. 7TH AVE. SE. & 2ND PLACE
118. 8TH AVE. SE. & ASTER STREET SOUTH
119. DIVISION STREET & 1ST NE. & NW.
120. CITY SHOP & DOGPOUND AREA
121. 8TH AVE. & 2ND PLACE (HIRAM KNOTT WATER EXT. EAST FROM ASTER TO 2ND PLACE SE. THEN SOUTH APPROX. 130' TO 160' OR JUST PAST EXISTING METER BOXES)




MAIN AVE W / DIVISION ST

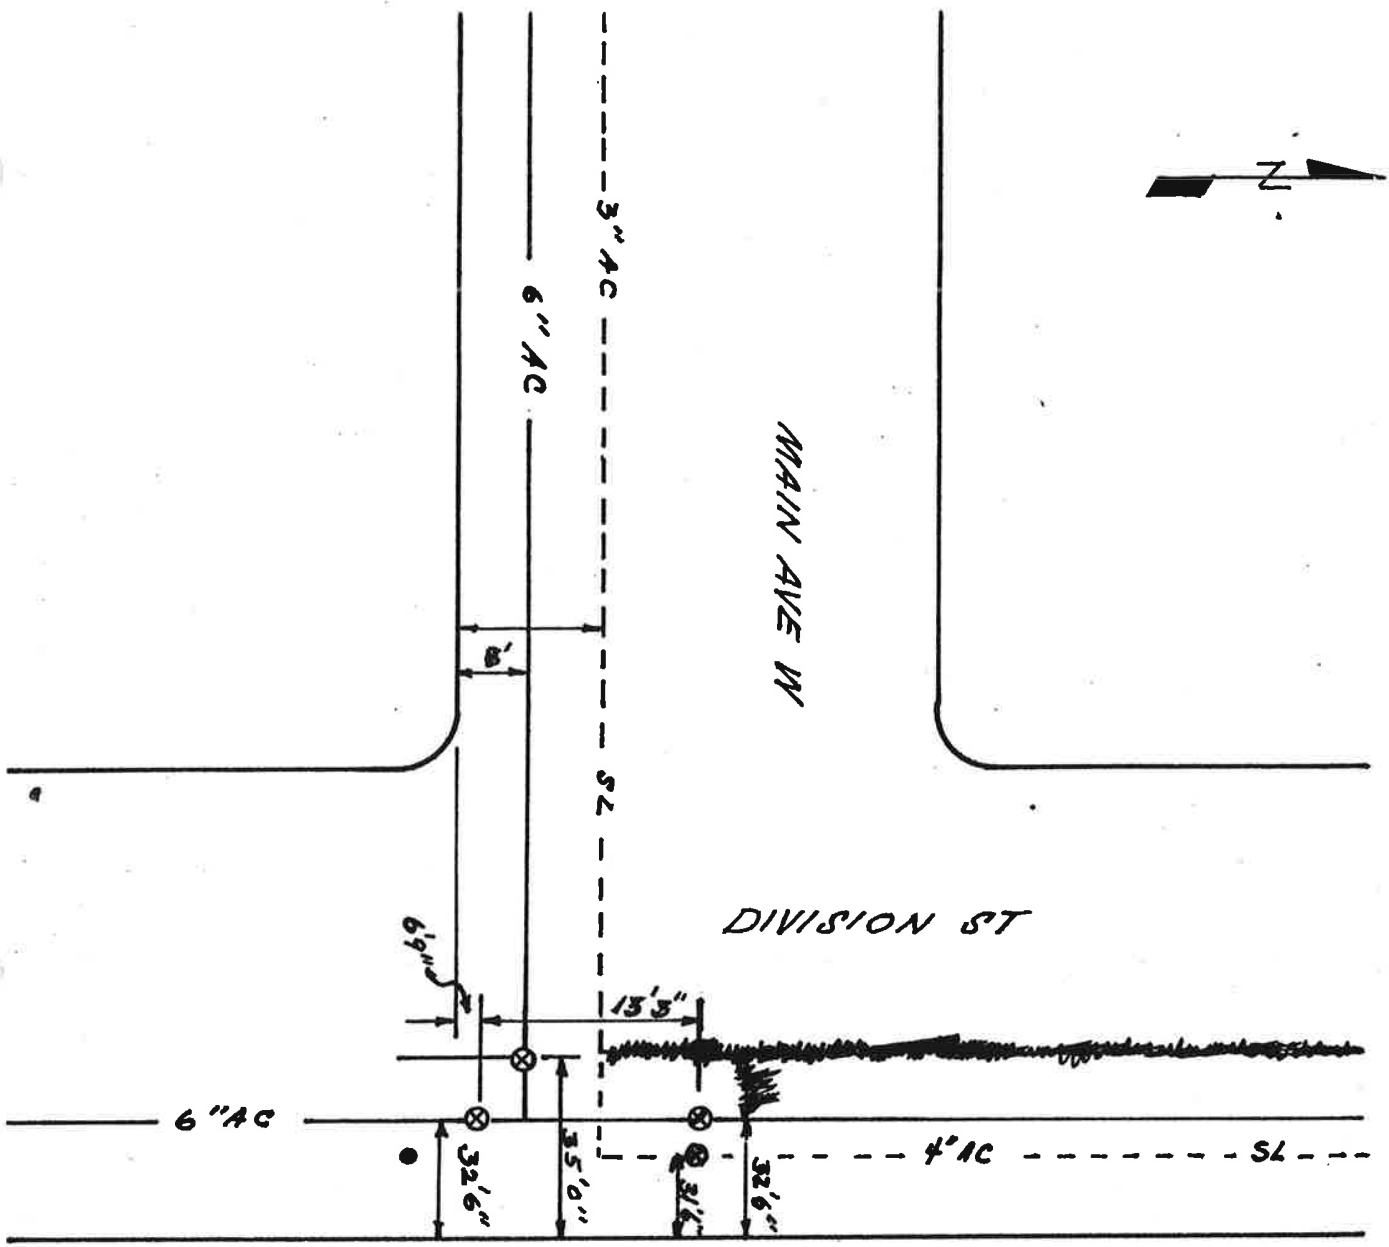

check all map


Y/for over

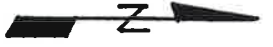

MAIN AVE W / ALLEY W OF DIVISION

MAIN AVE W

ALLEY W OF DIVISION

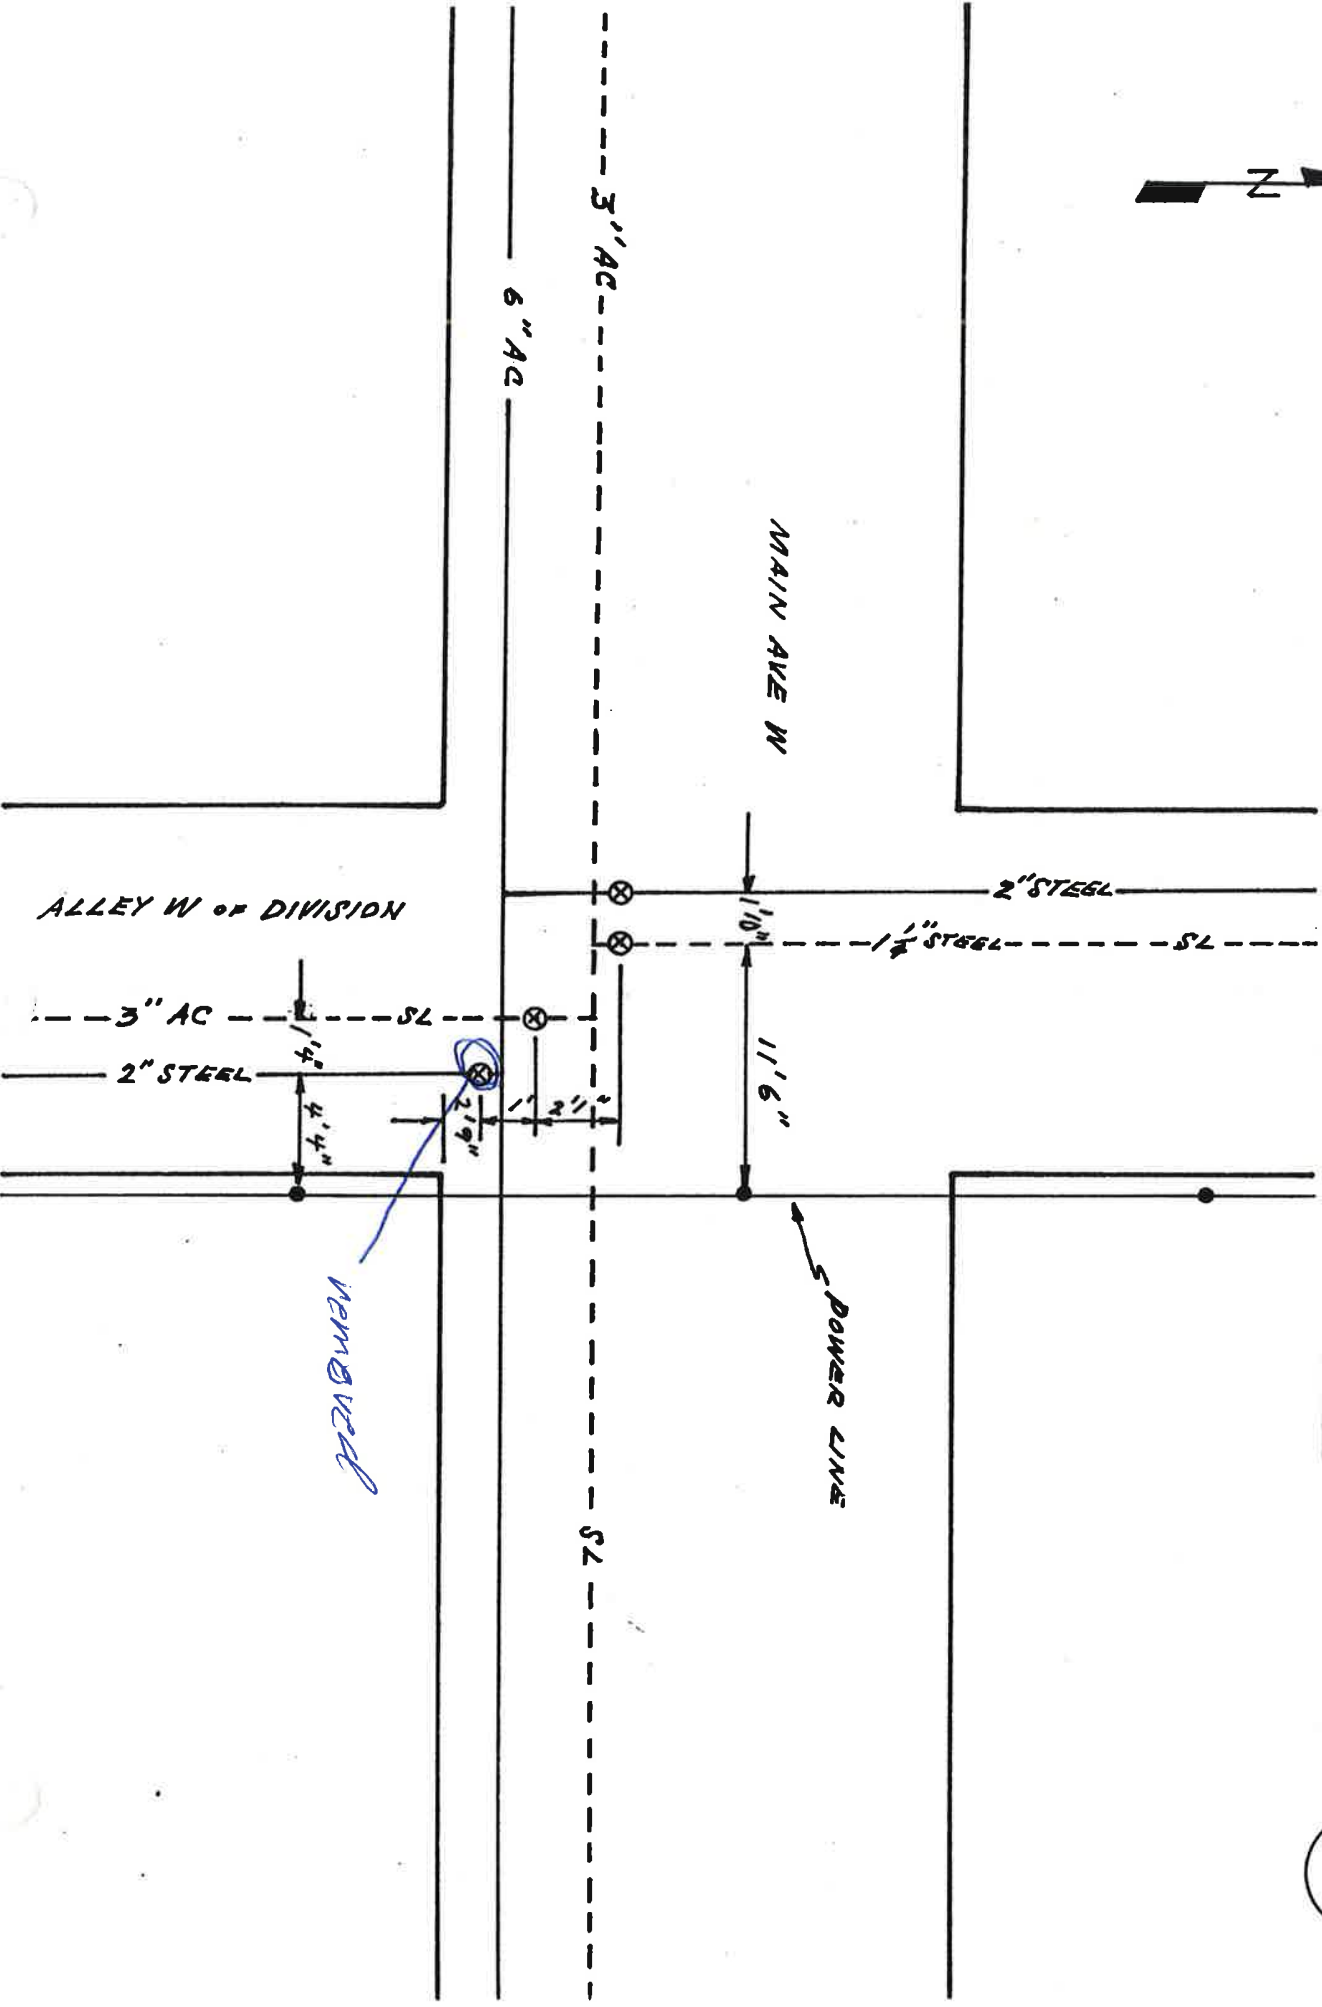

REMOVE

POWER LINE

3" AC

6" AC

2" STEEL

1 1/2" STEEL

3" AC

2" STEEL

SL

1' 10"


11' 6"

1/4"


4' 4"

2' 9"

2' 1/4"

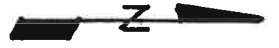

3

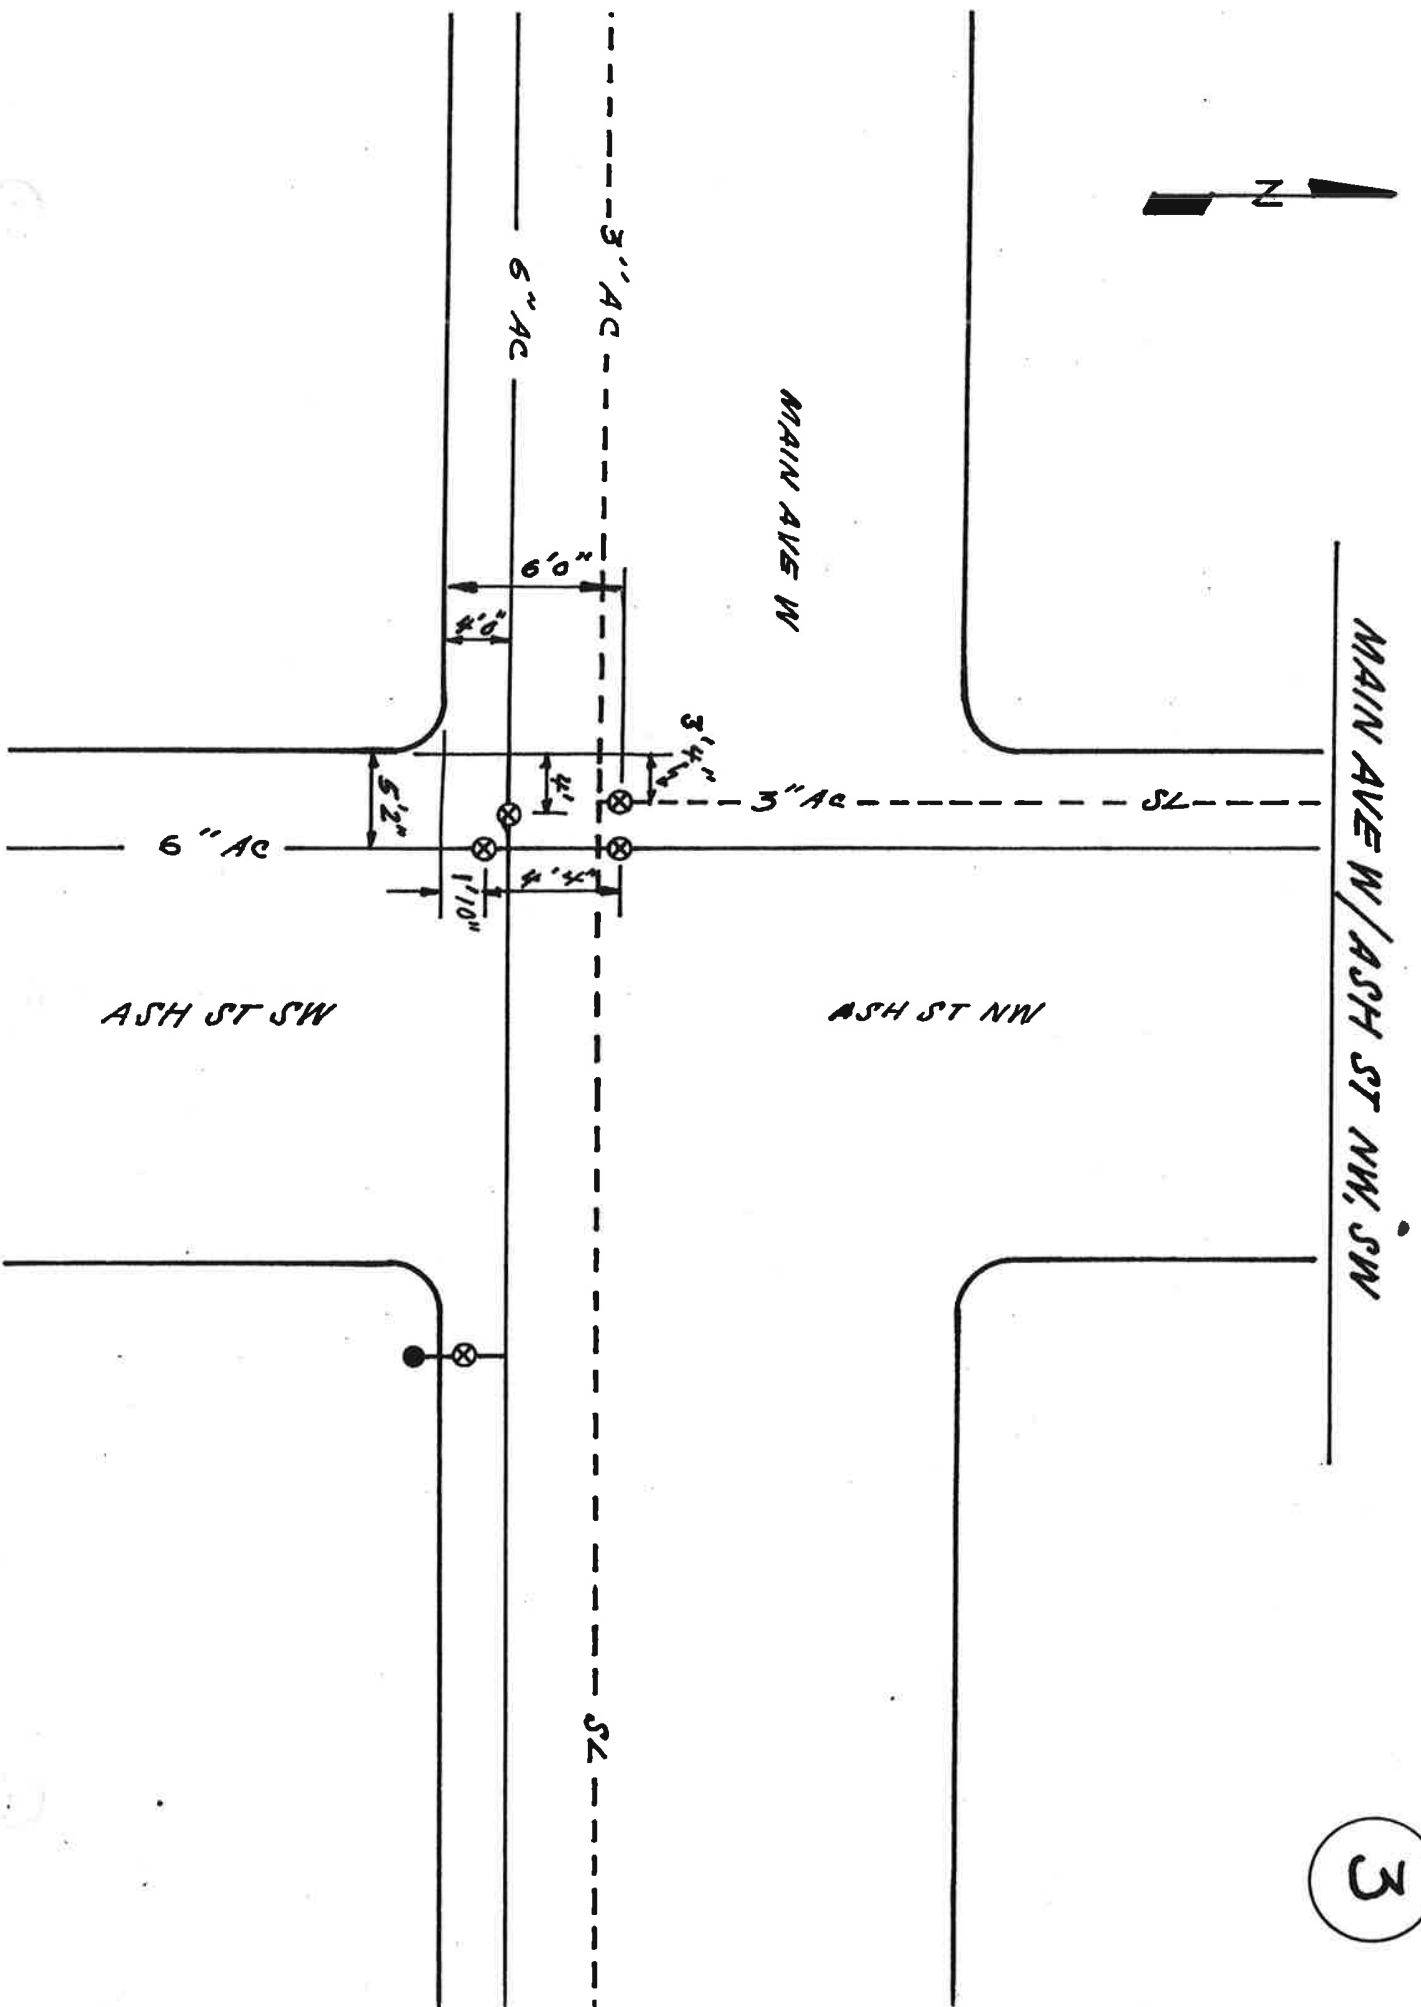



MAIN AVE W / ALLEY BETWEEN ASH/BIRCH

4




MAIN AVE W

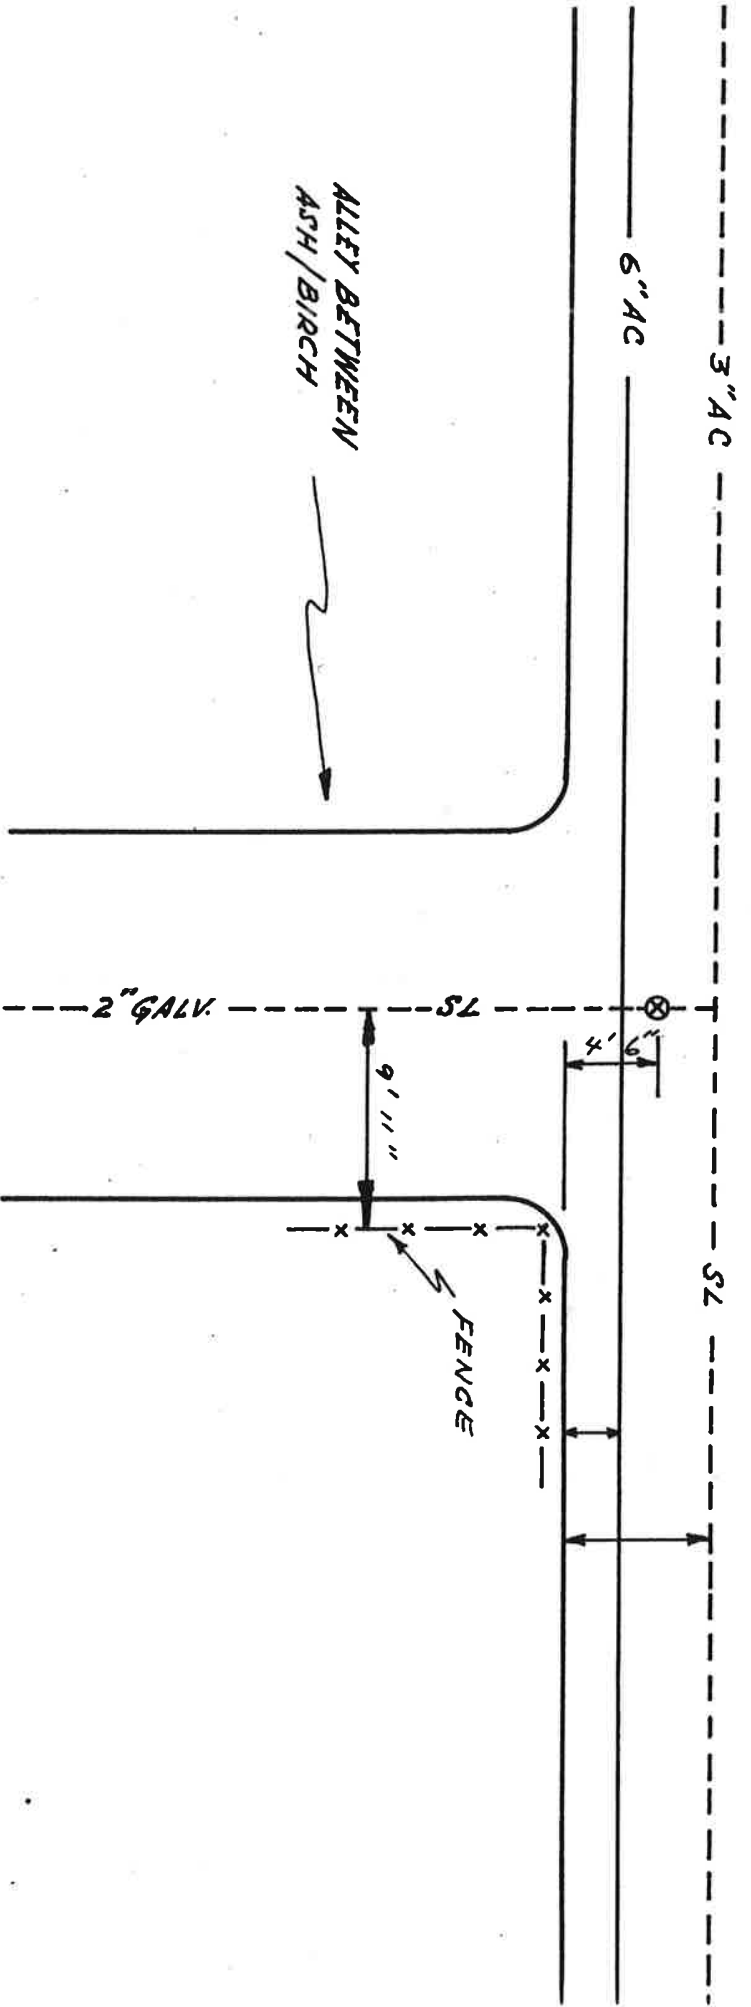

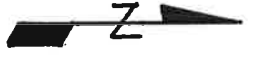

MAIN AVE W / BIRCH ST SW


5

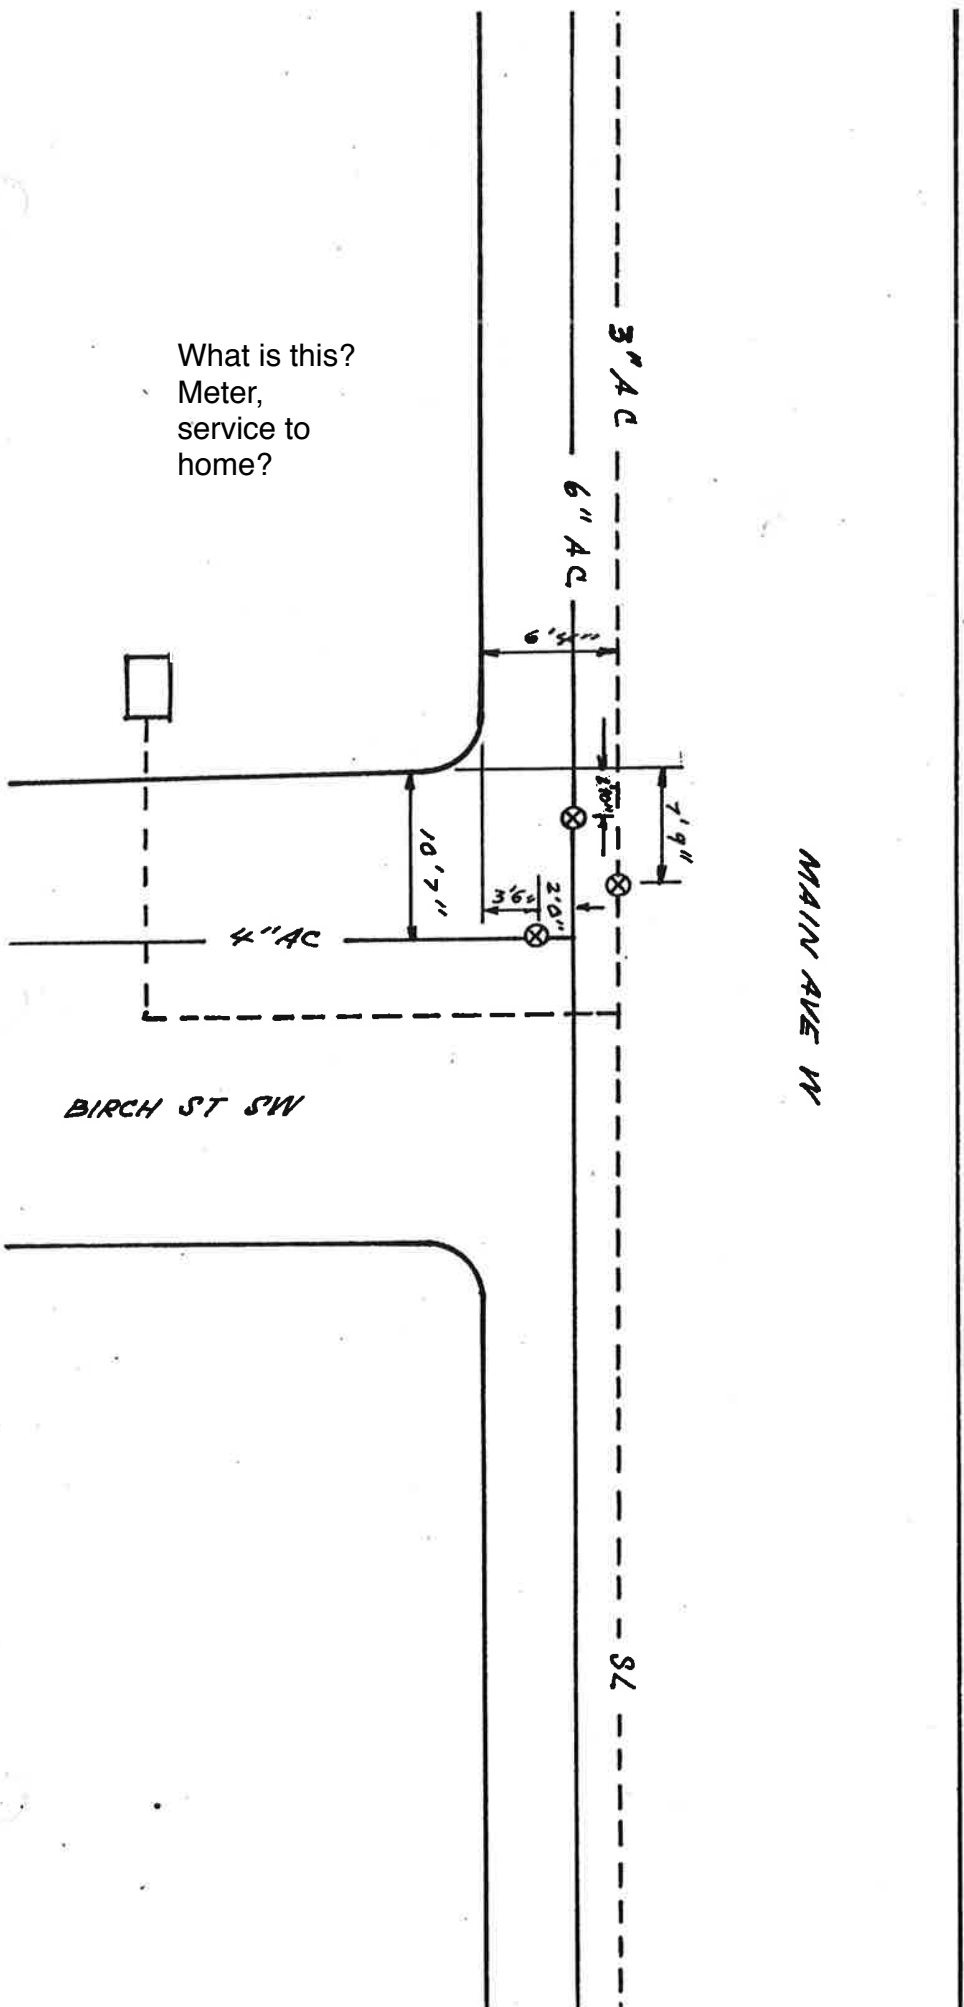

What is this?
Meter,
service to
home?


6

MAIN AVE W / ALLEY BETWEEN BIRCH / CHERRY

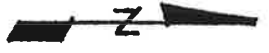


MAIN AVE W

OMH

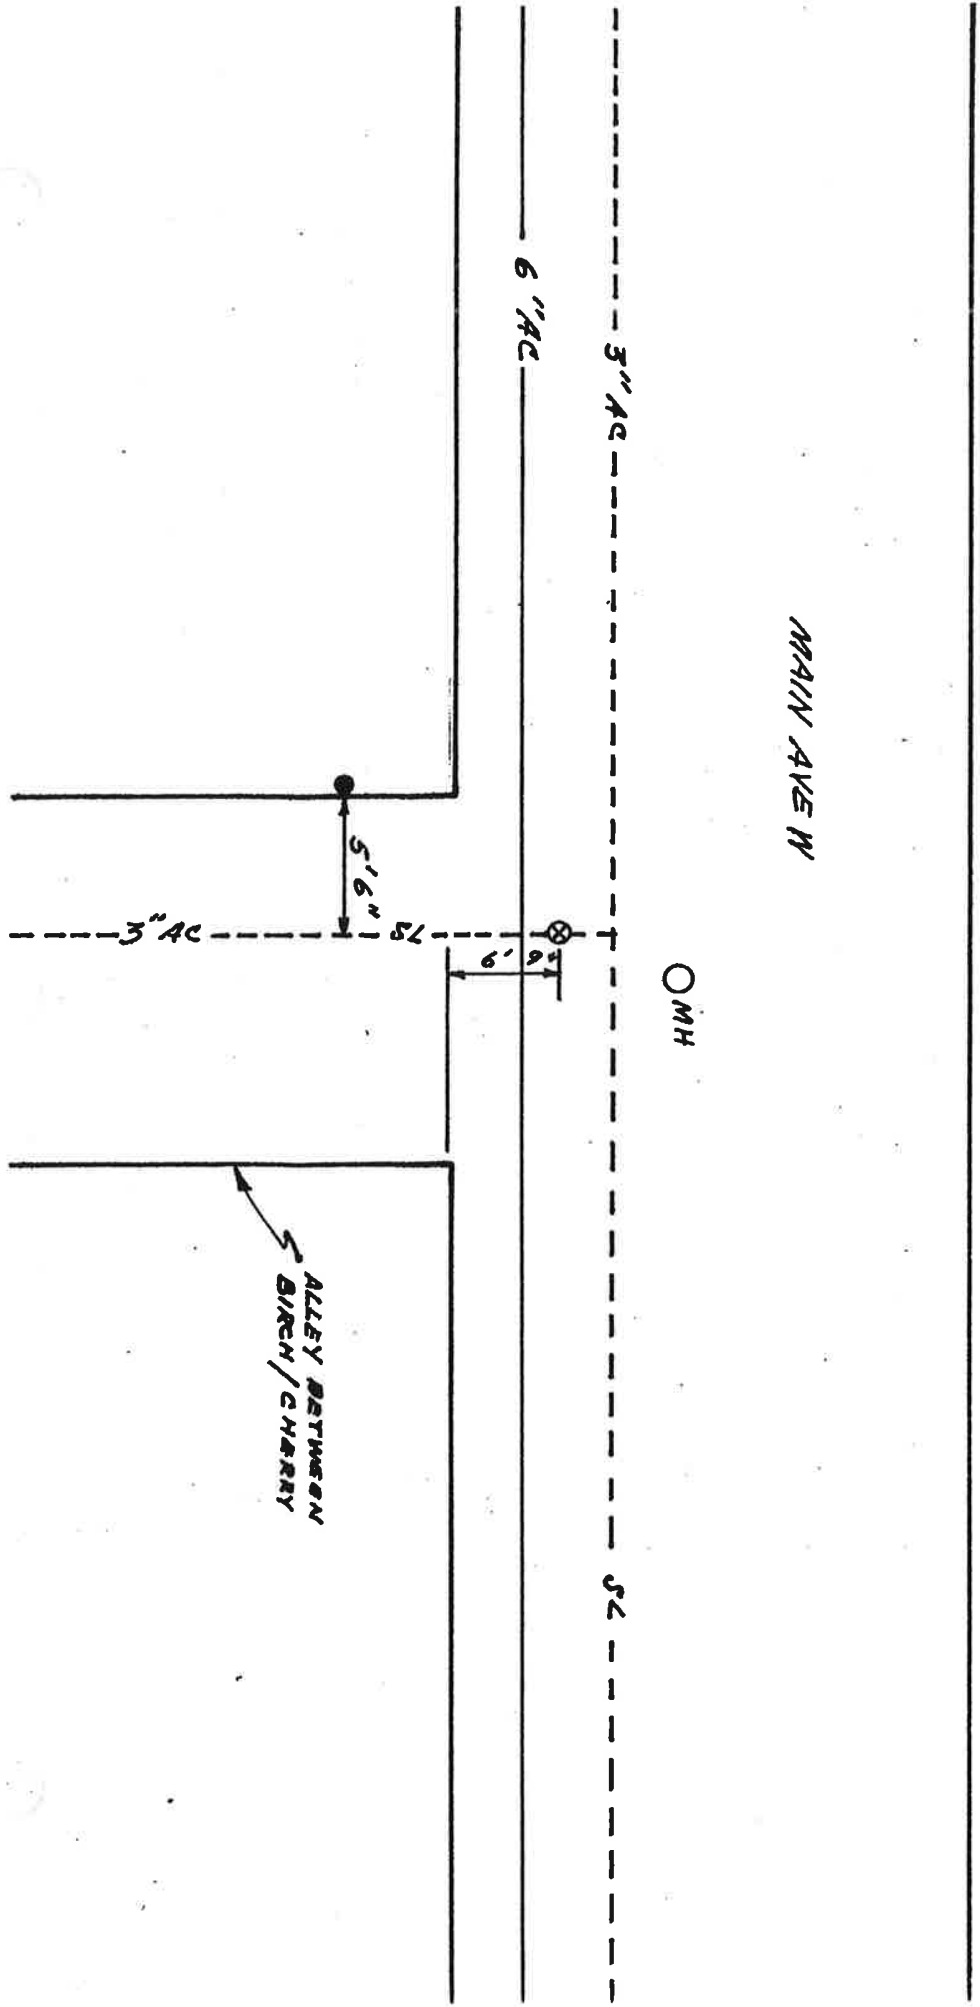

MAIN AVE W / CHERRY ST SW

7

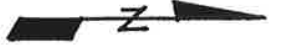

MAIN AVE W

3" AC

6" AC

5'6"

22'9"


24'11"

4" AC

3'6"

CHERRY ST SW

SL

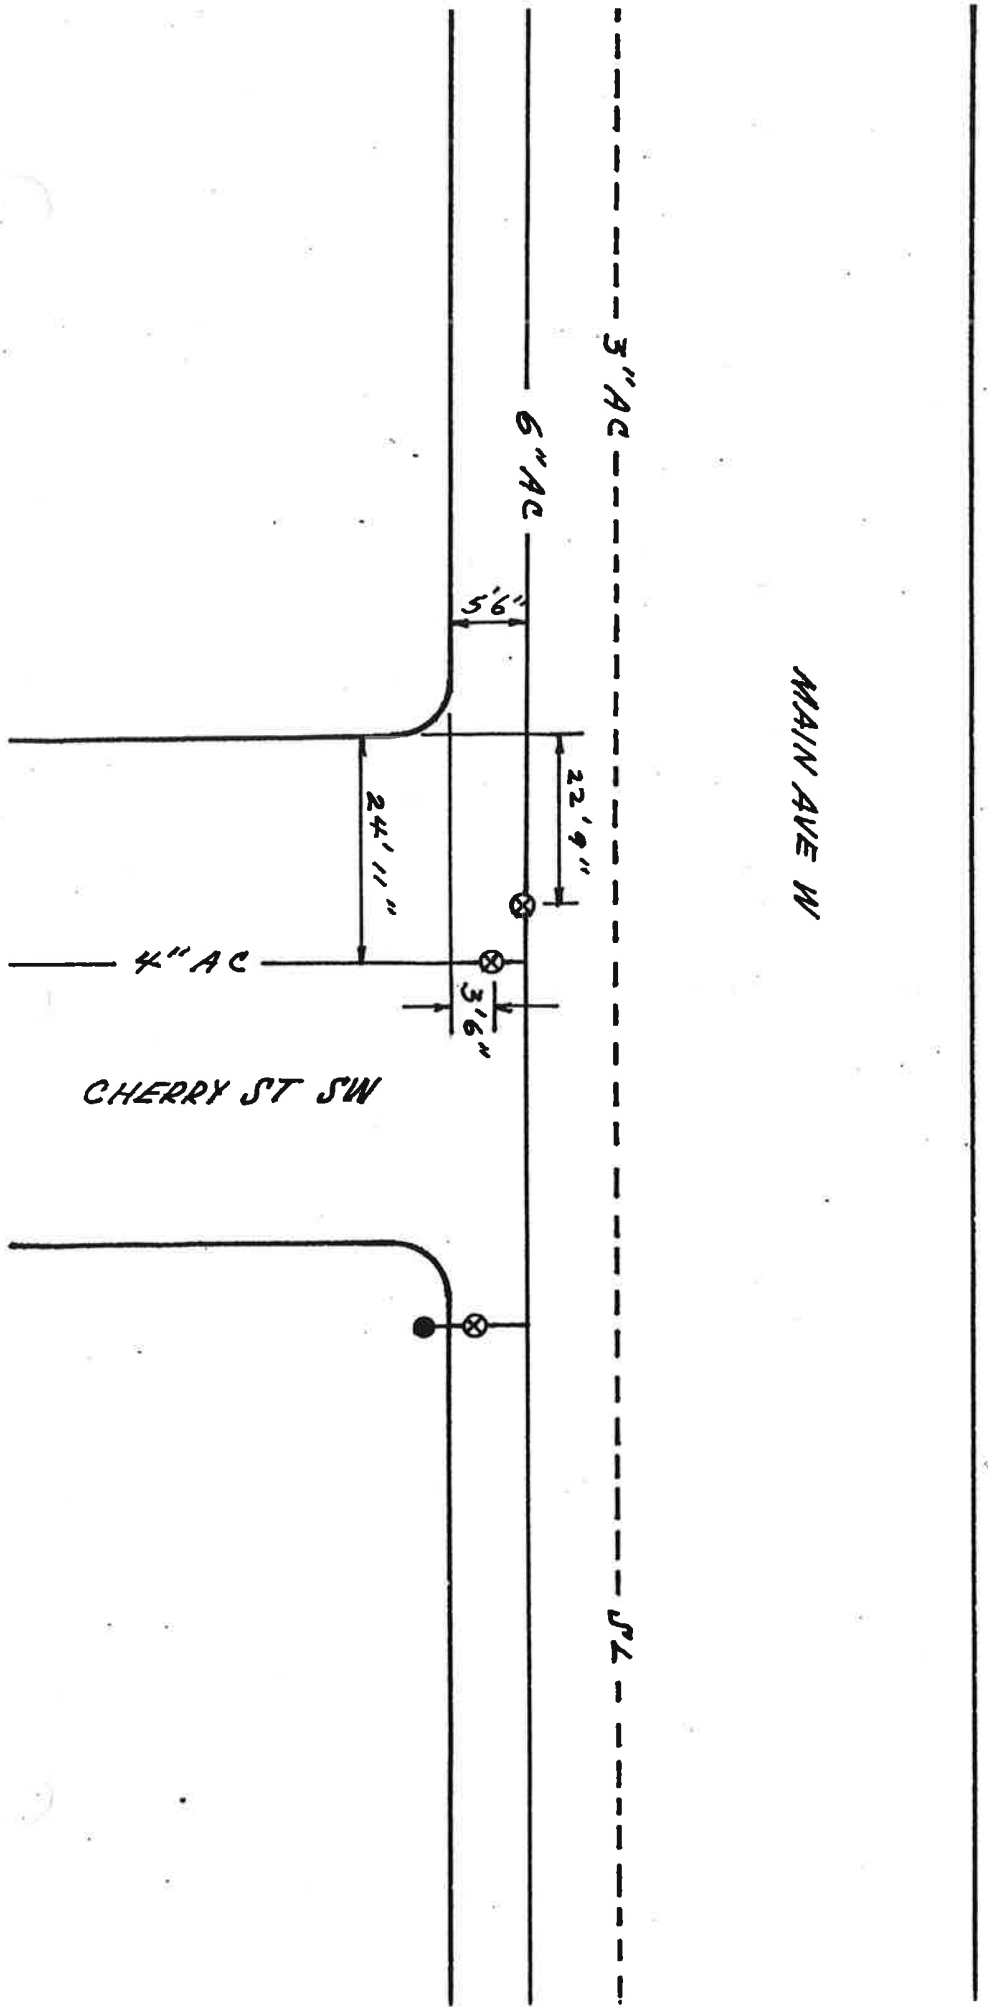


MAIN AVE W / ALLEY BETWEEN CHERRY / DOGWOOD

8




MAIN AVE W

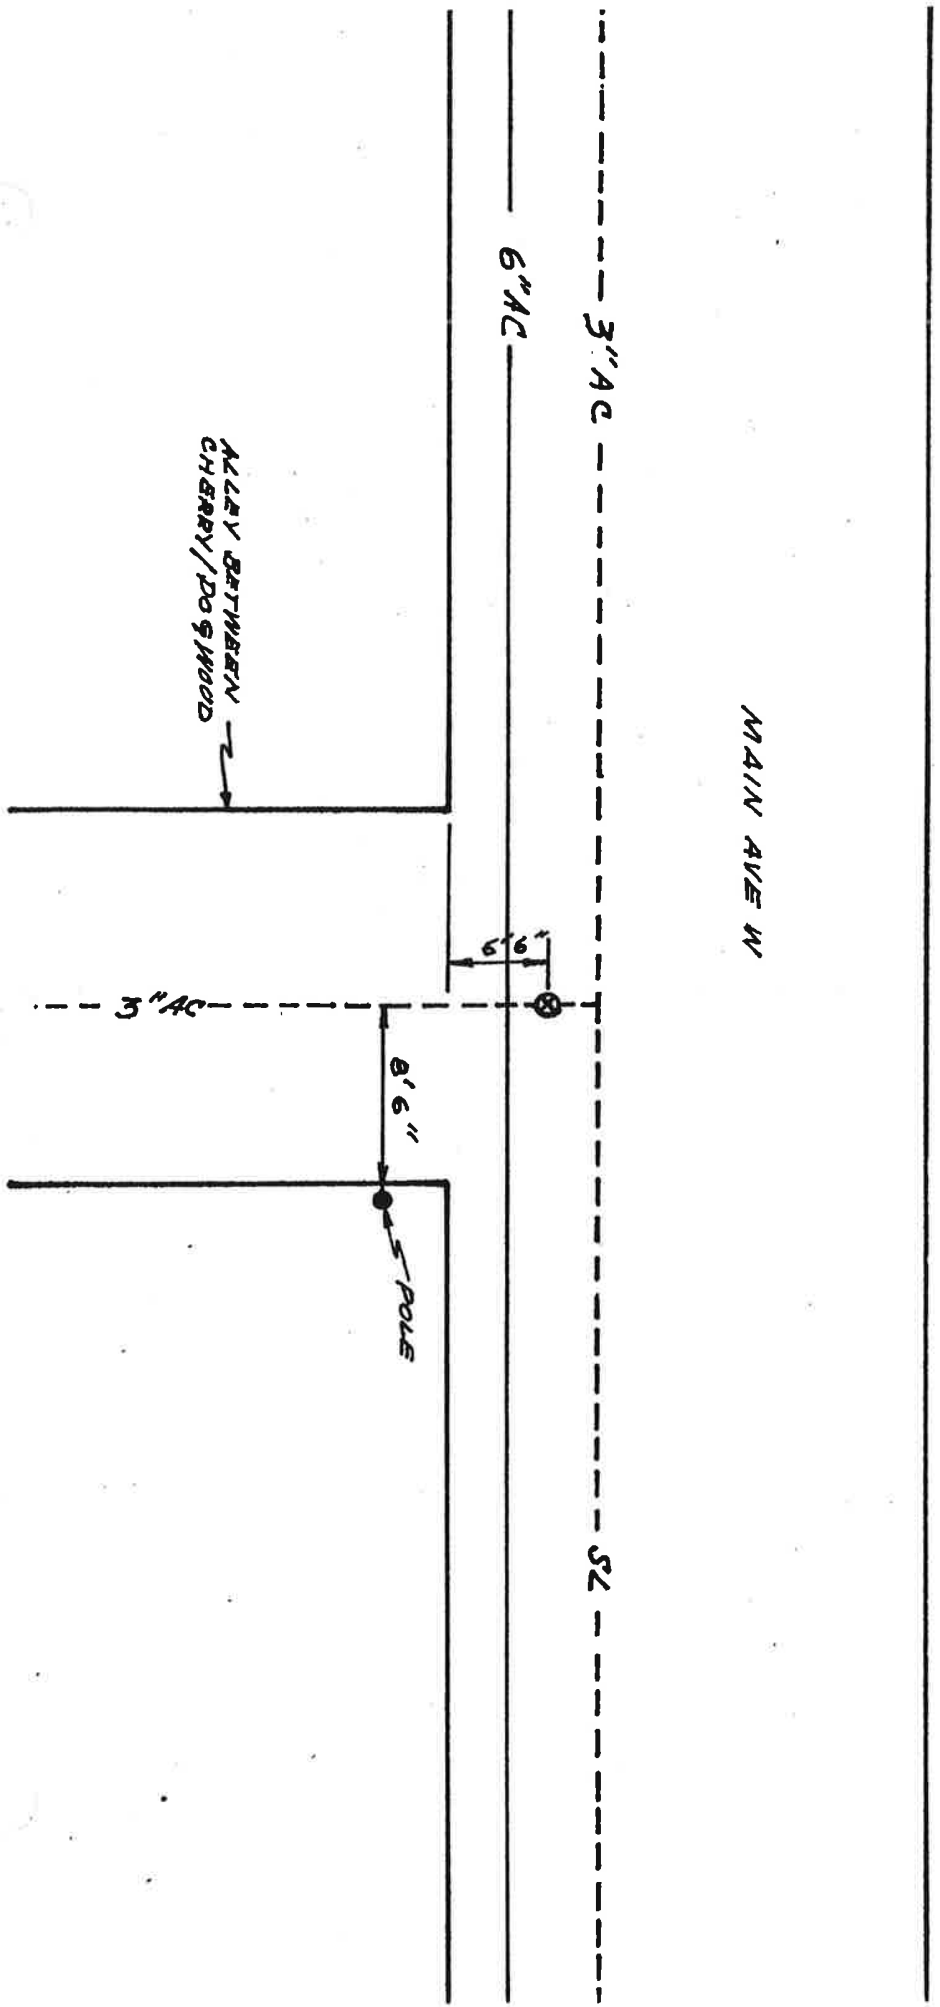





MAIN AVE W / DOGWOOD ST SW, NW

MAIN AVE W

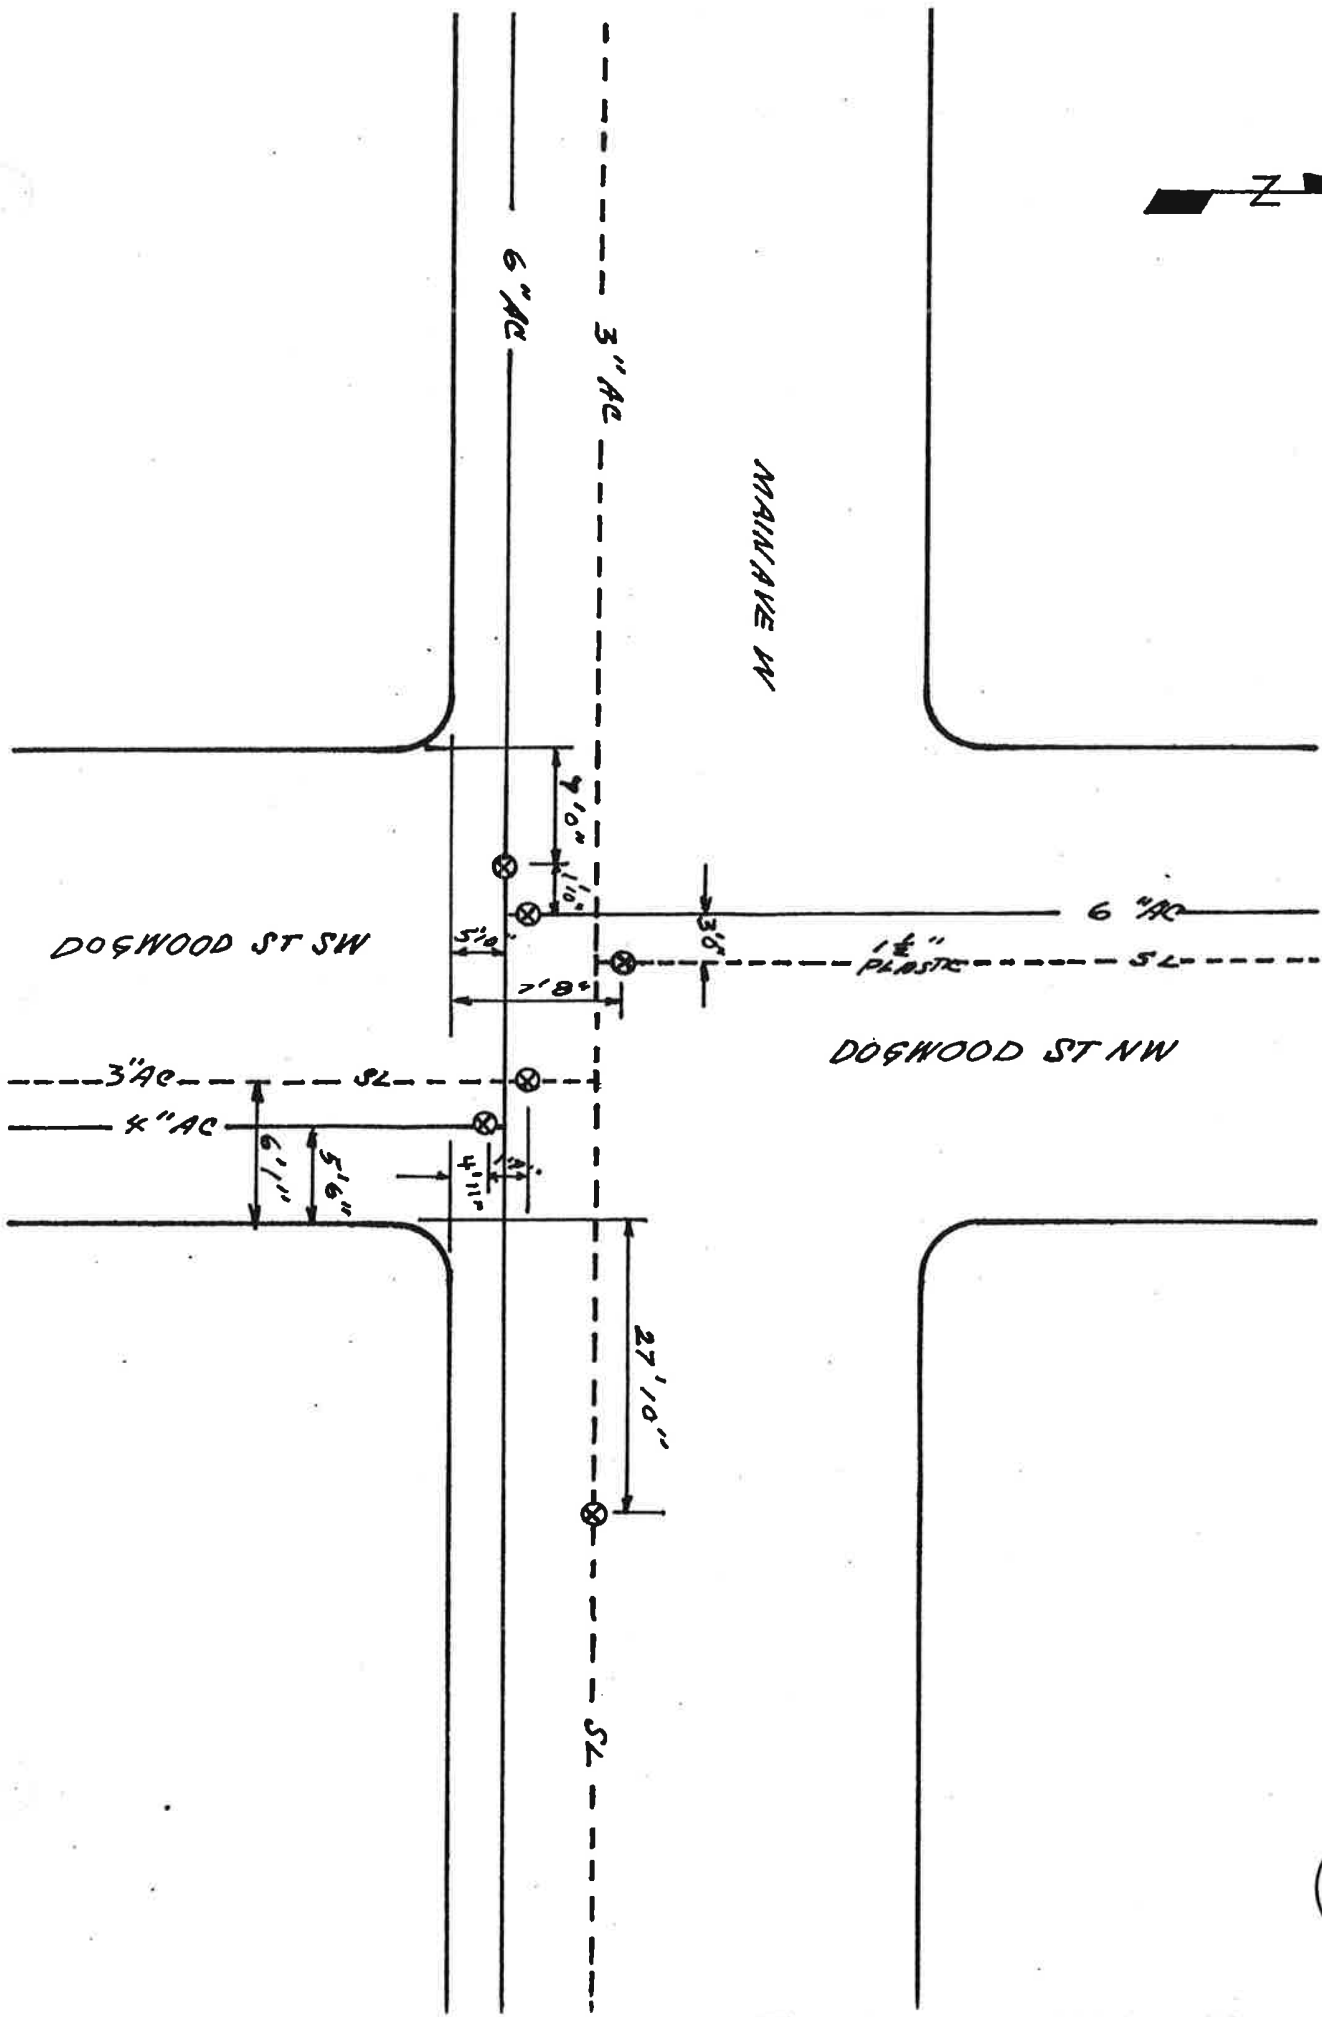

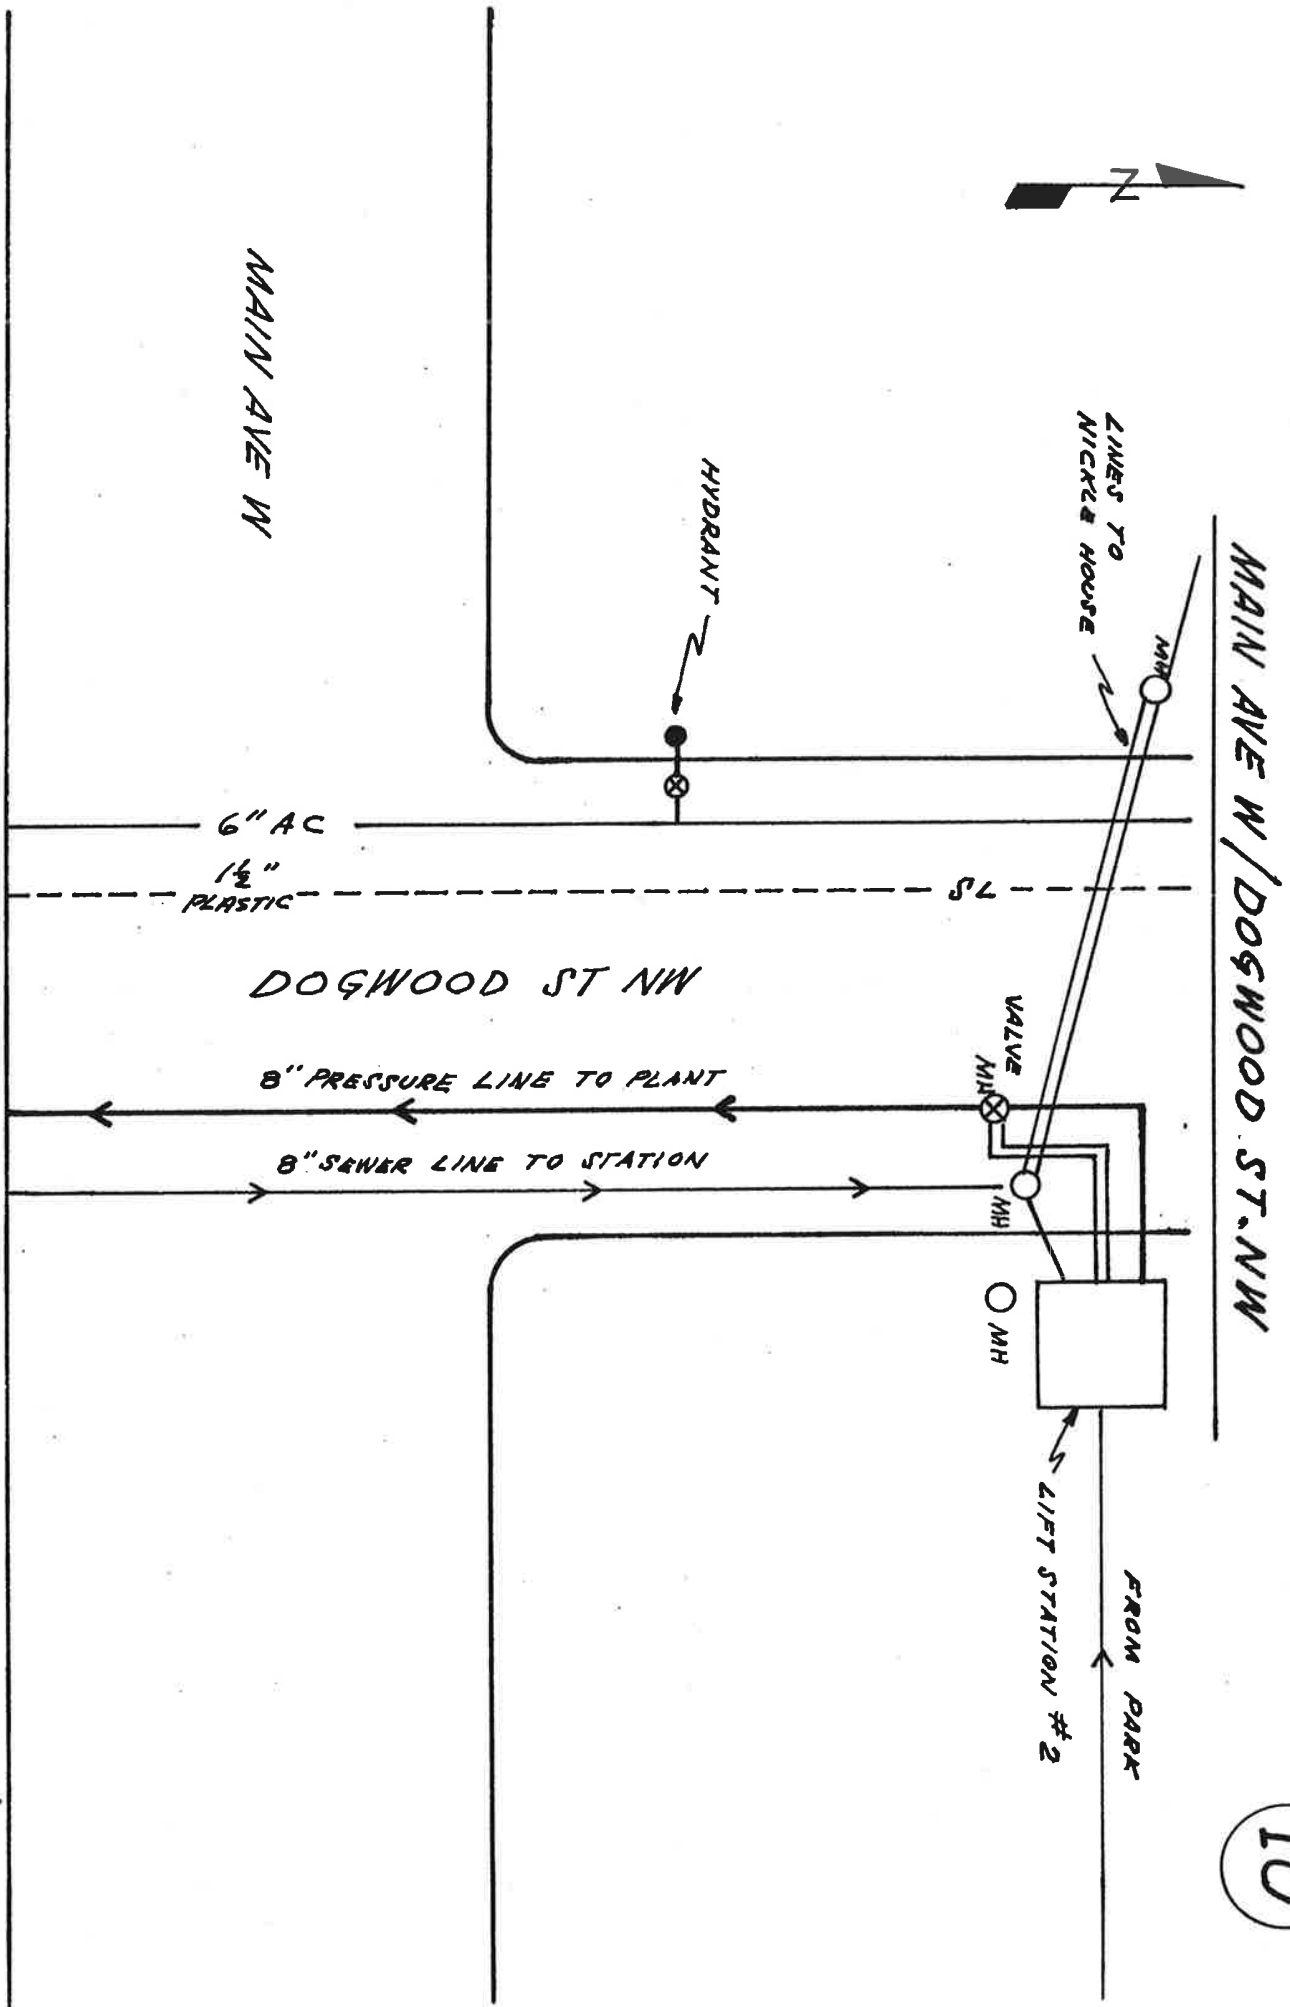

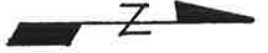

MAIN AVE W / EVERGREEN ST NW

3/ EVERGREEN N.
RETAINER
WALL

EVERGREEN ST NW

MAIN AVE W

3" AC


6" AC


3" AC
4" AC

SL

NO VALVE
FOUND

HYDRANT

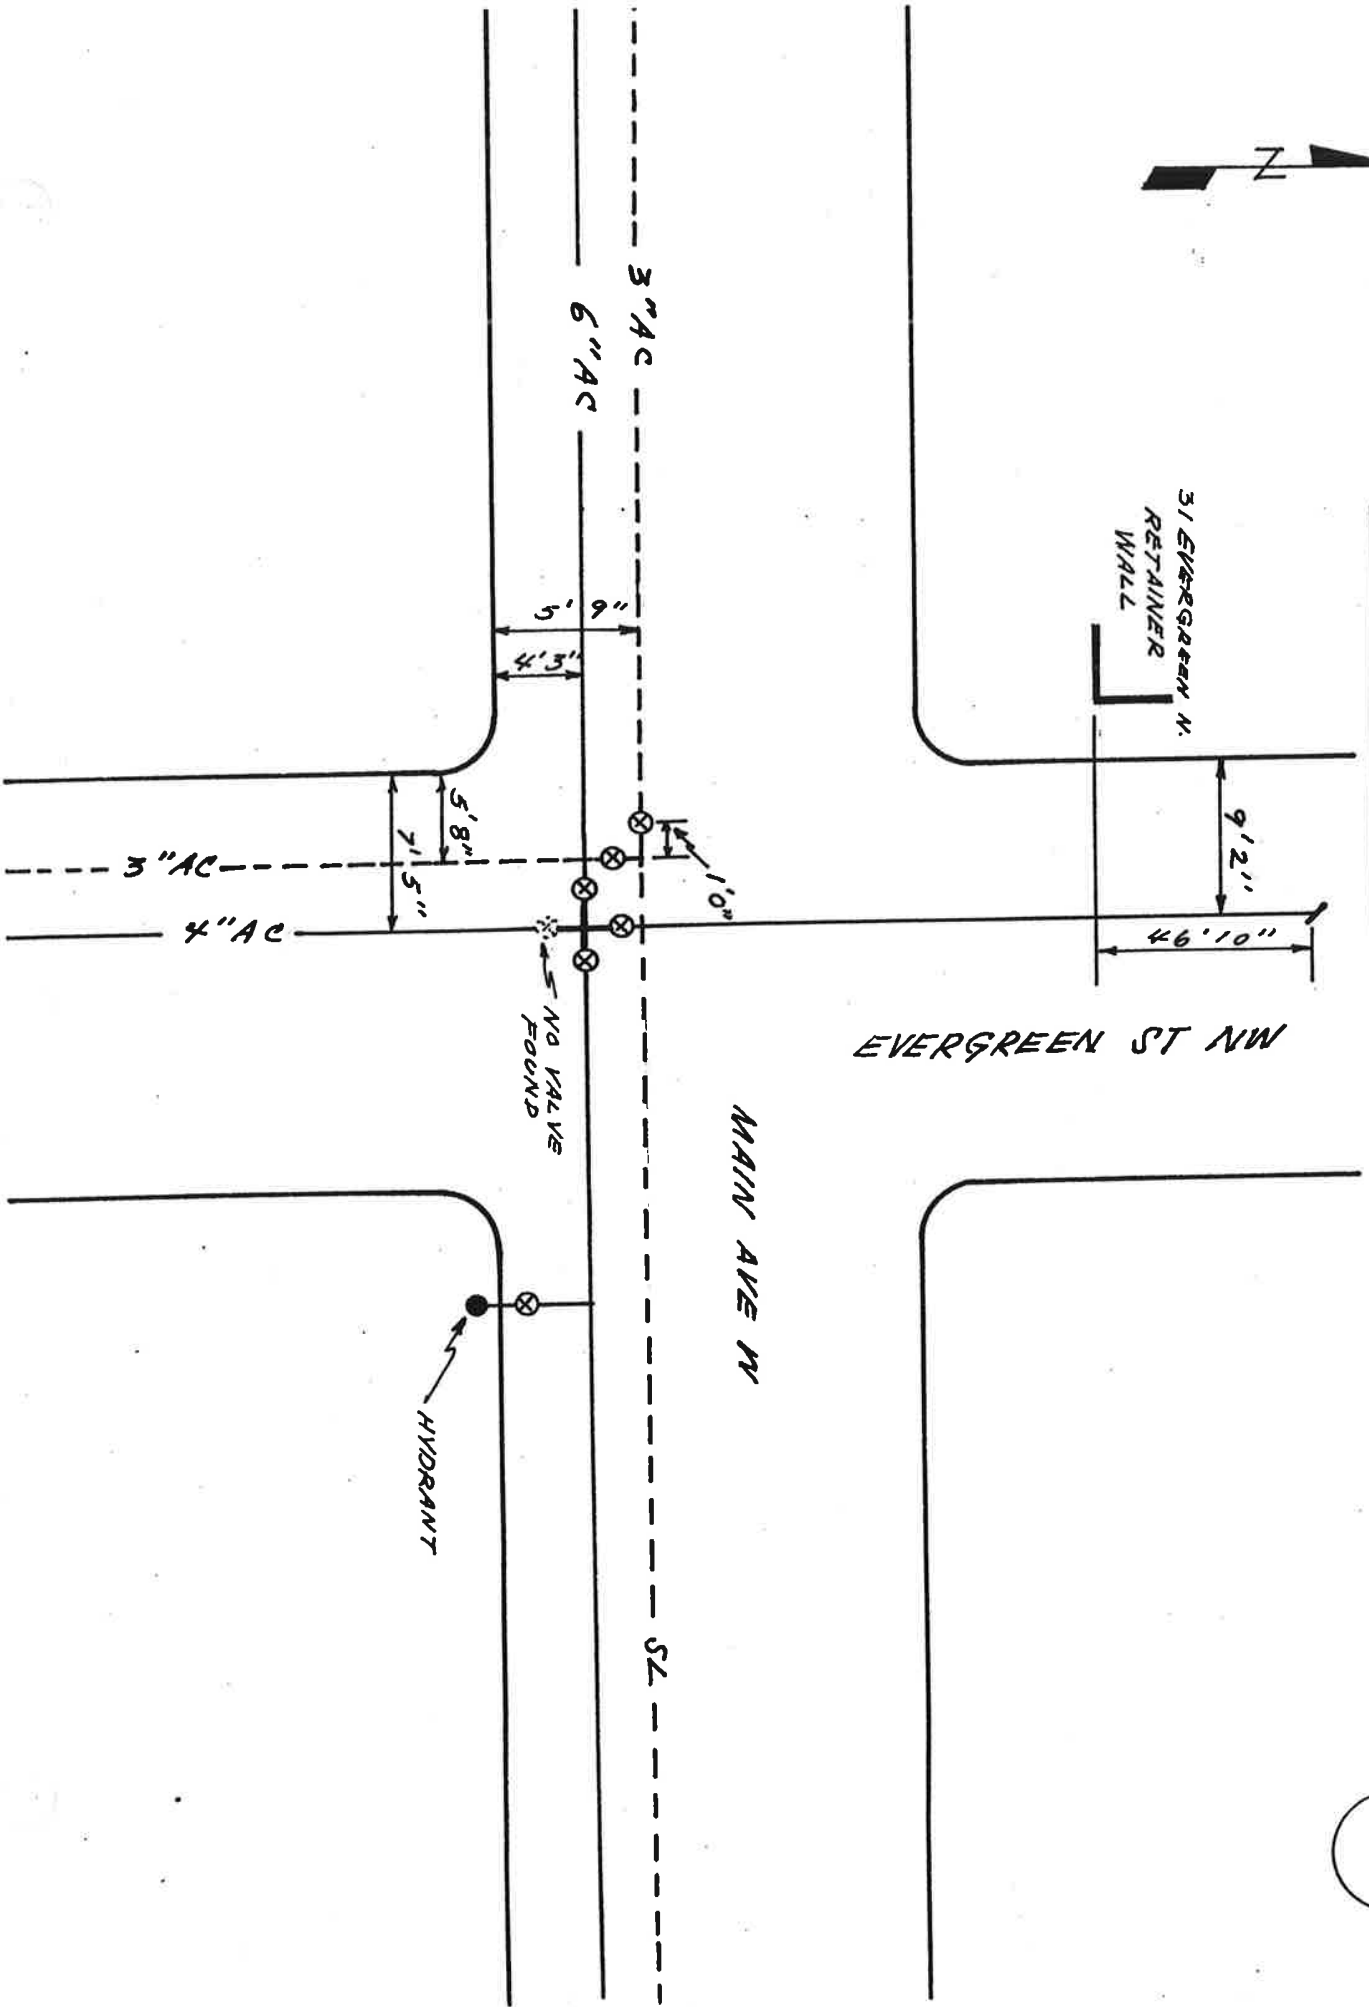

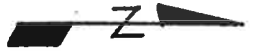




MAIN AVE W / FIR ST SW, NW


MAIN AVE W

FIR ST NW

FIR ST SW

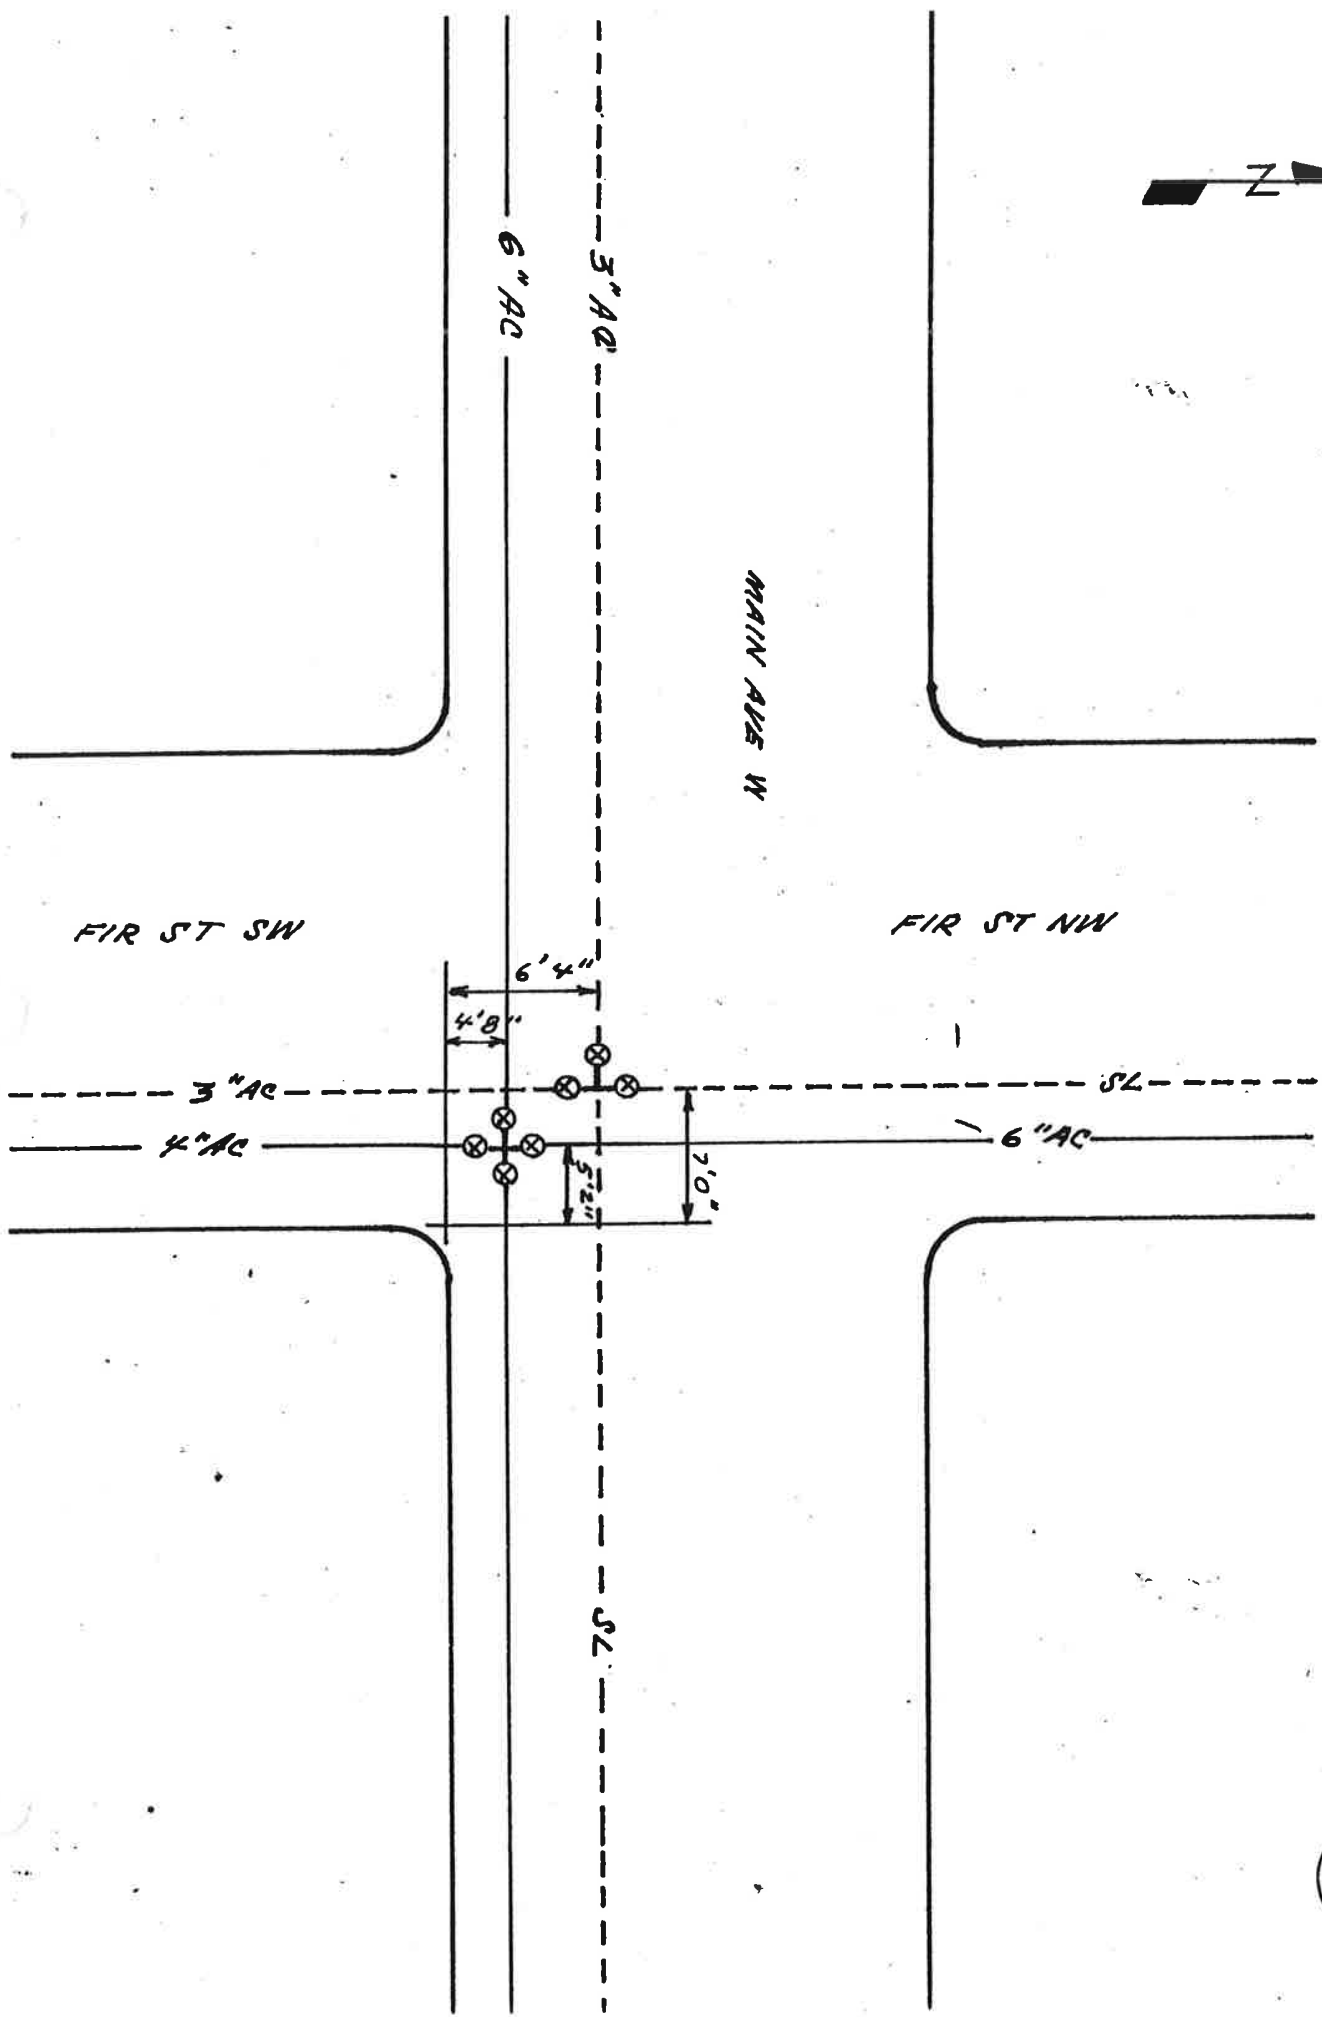


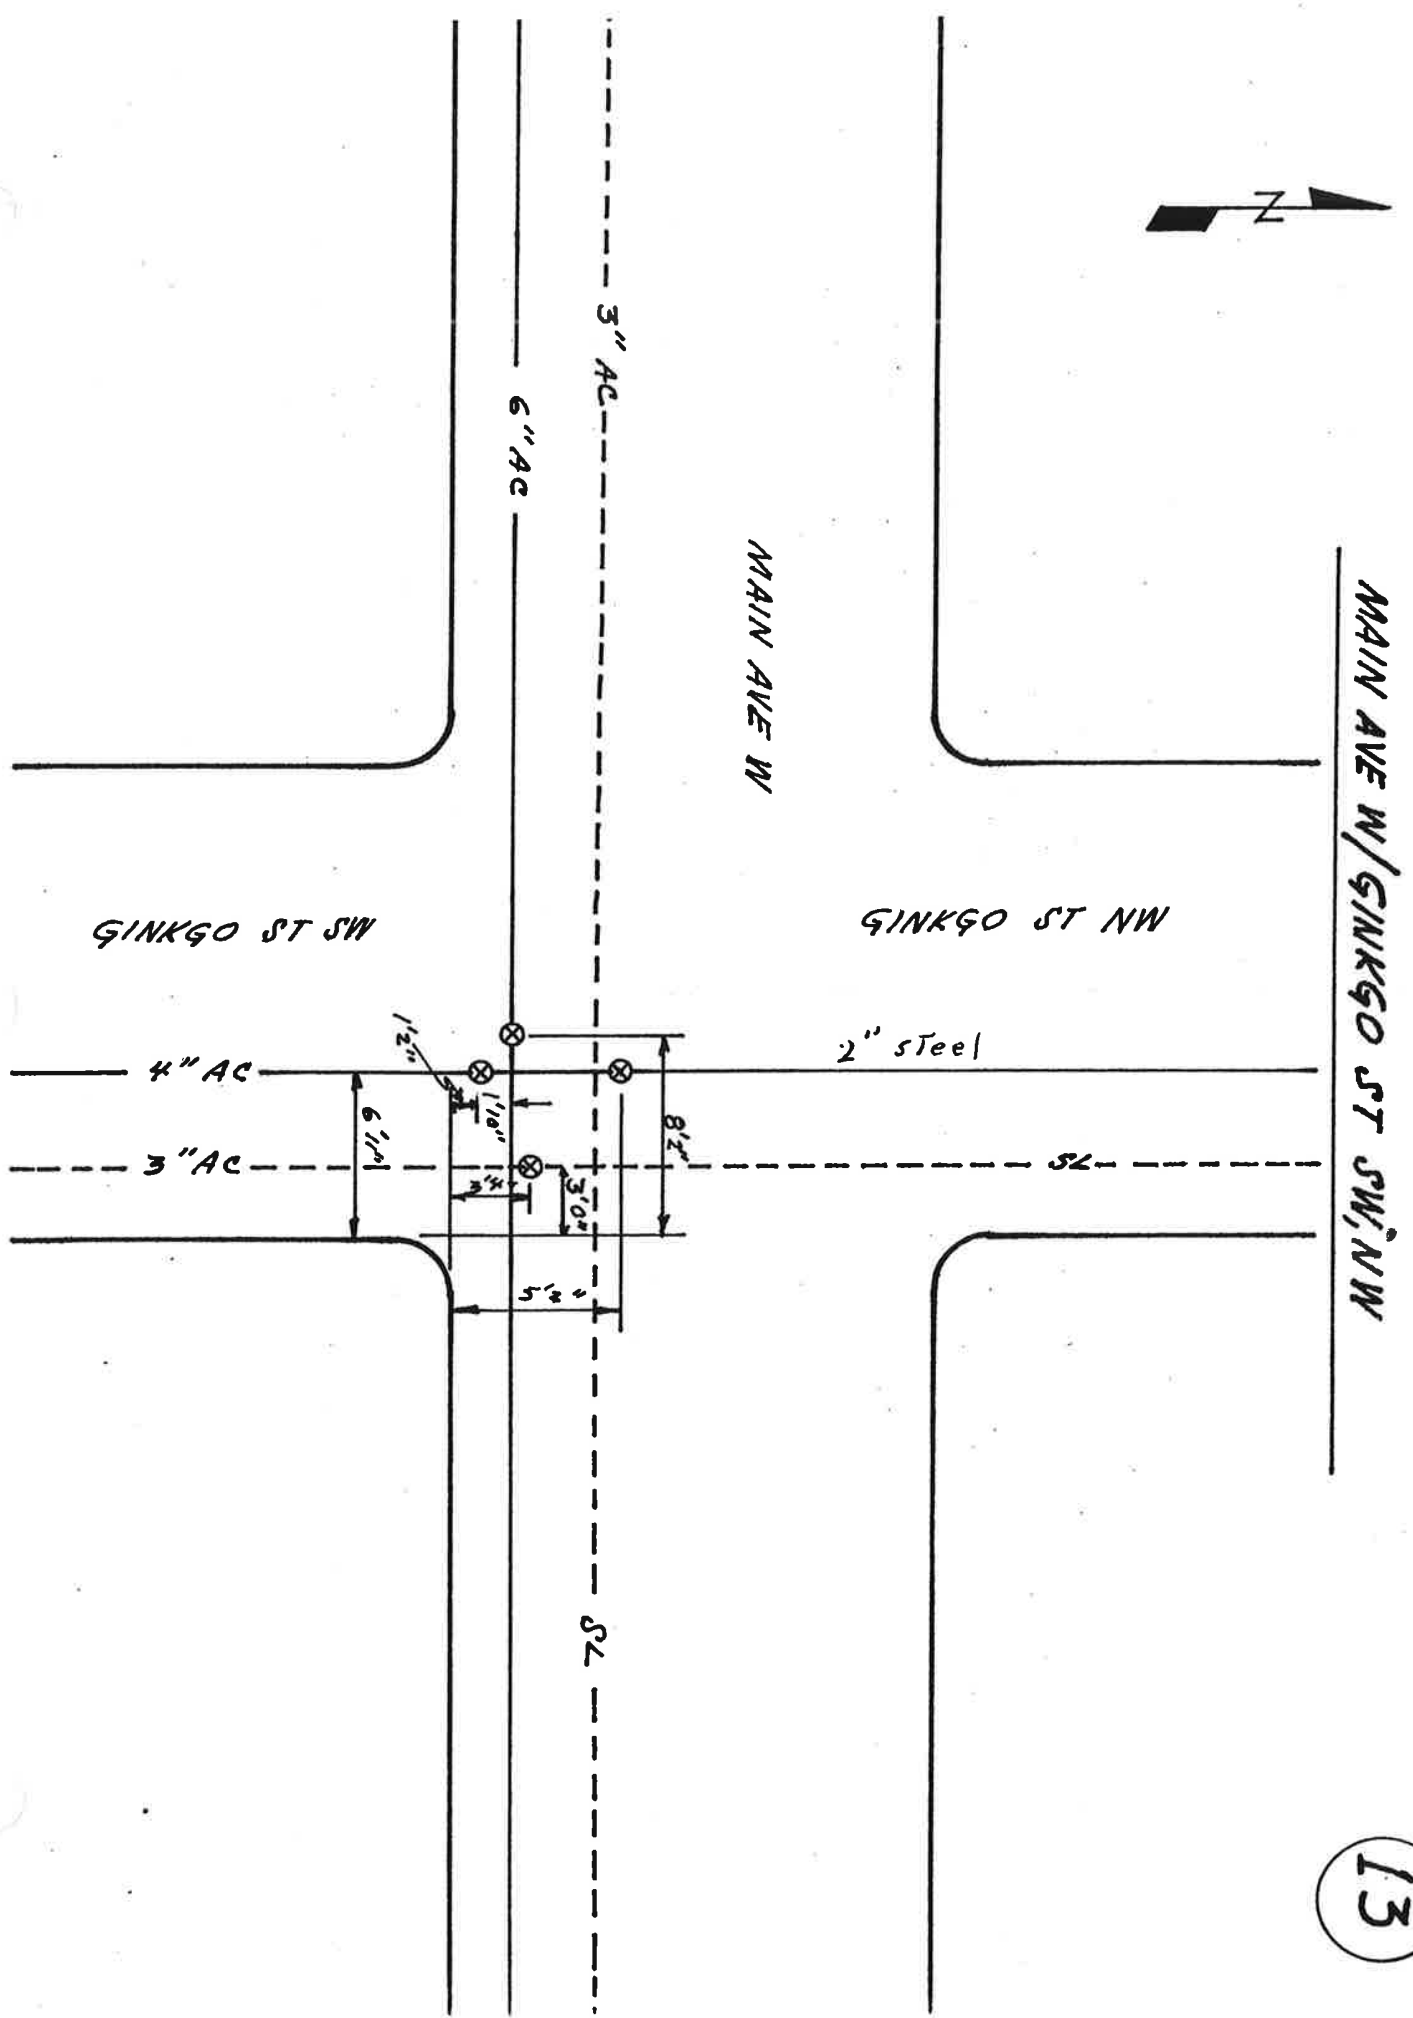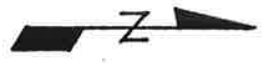


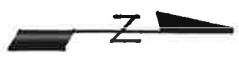

MAIN AVE W / HEMLOCK ST


14

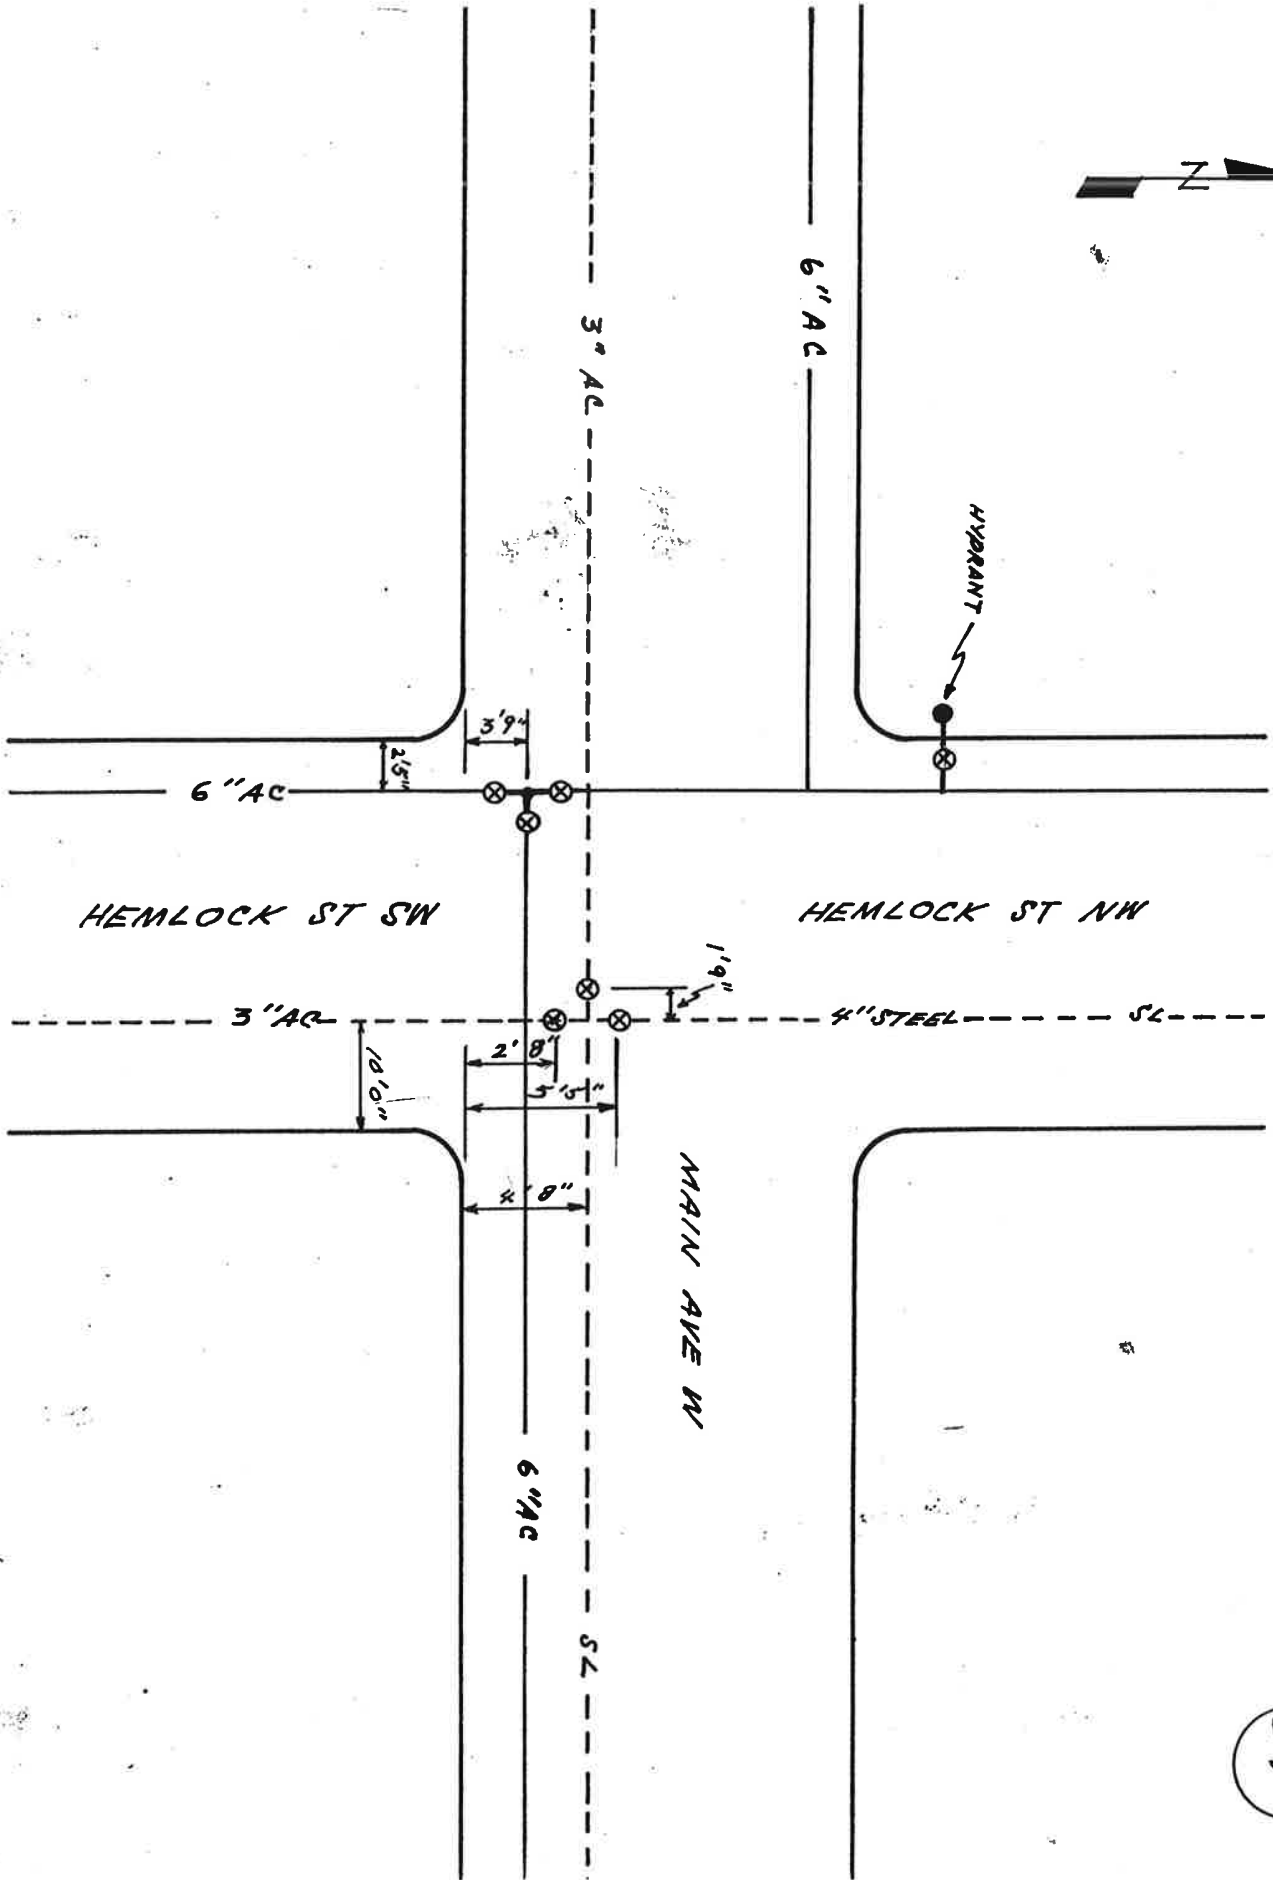

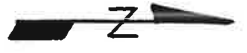

MAIN AVE W / JUNIPER ST SW, NW

15

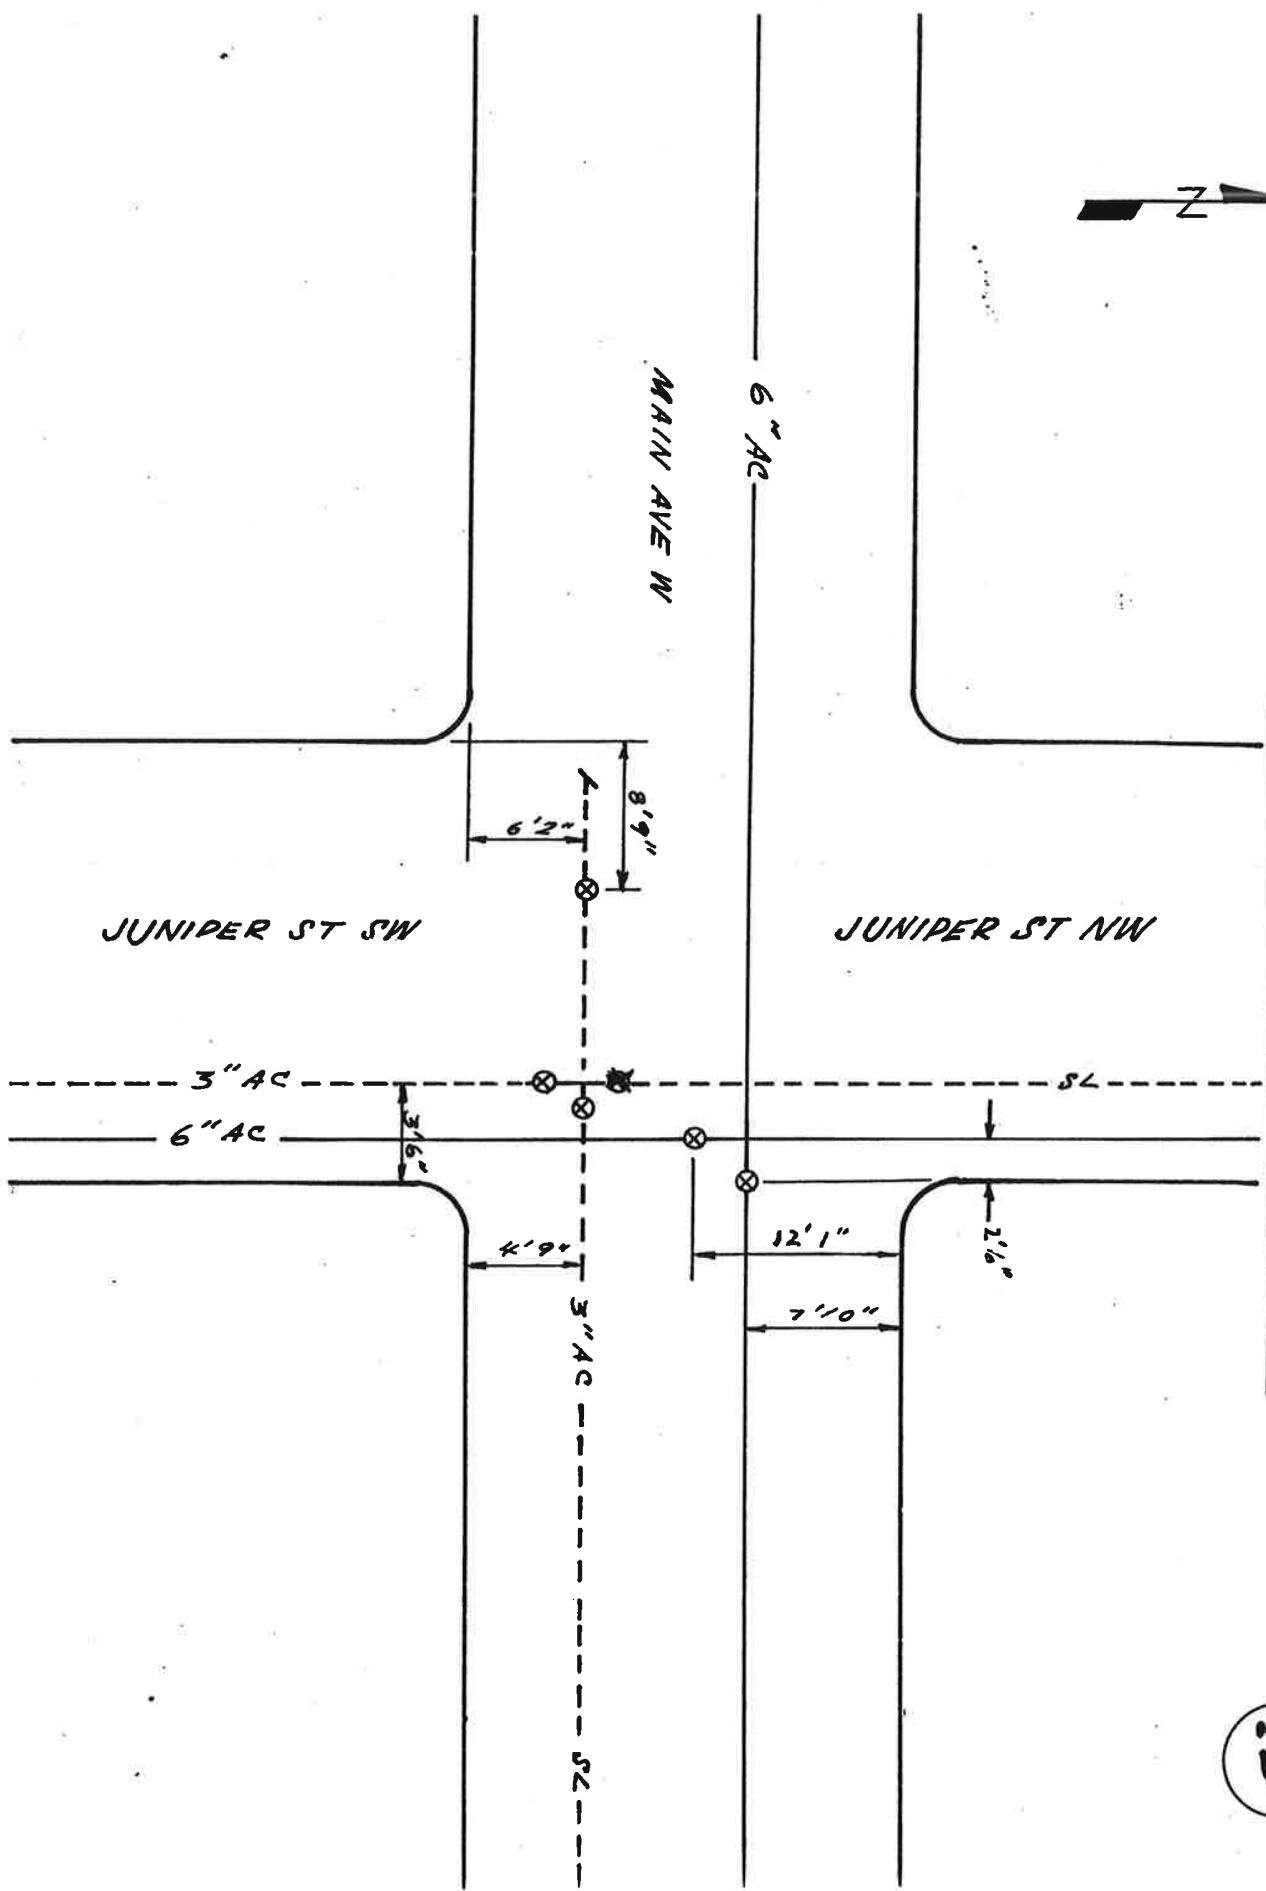

MAIN AVE W

6" AC

JUNIPER ST SW


JUNIPER ST NW

3" AC

6" AC

3" AC


SL

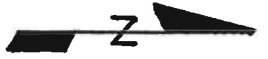

MAIN AVE W / MAPLE ST SW, NW

16

MAPLE ST NW

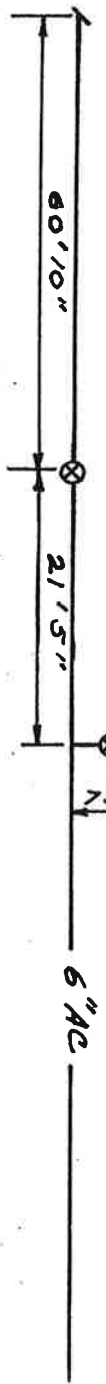


MAIN AVE W



MAPLE ST SW






17

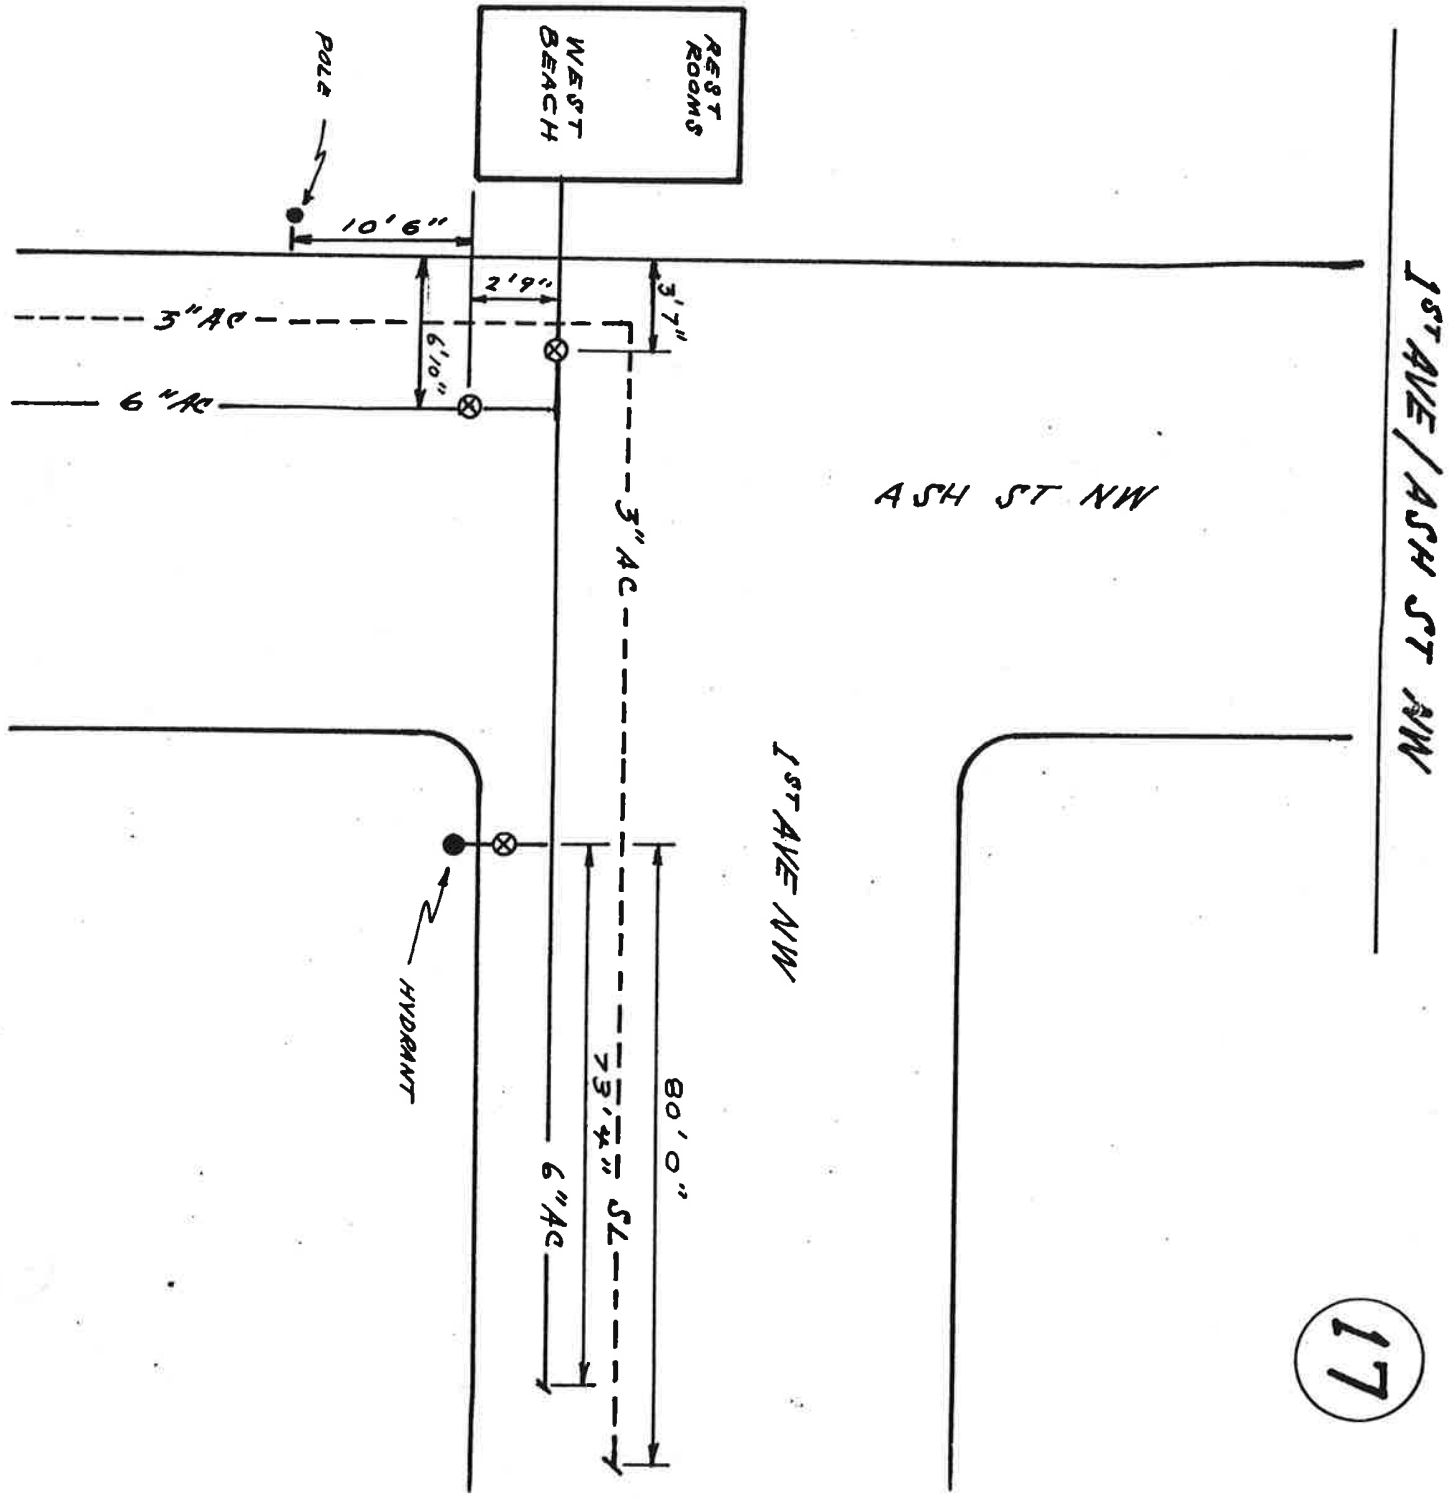

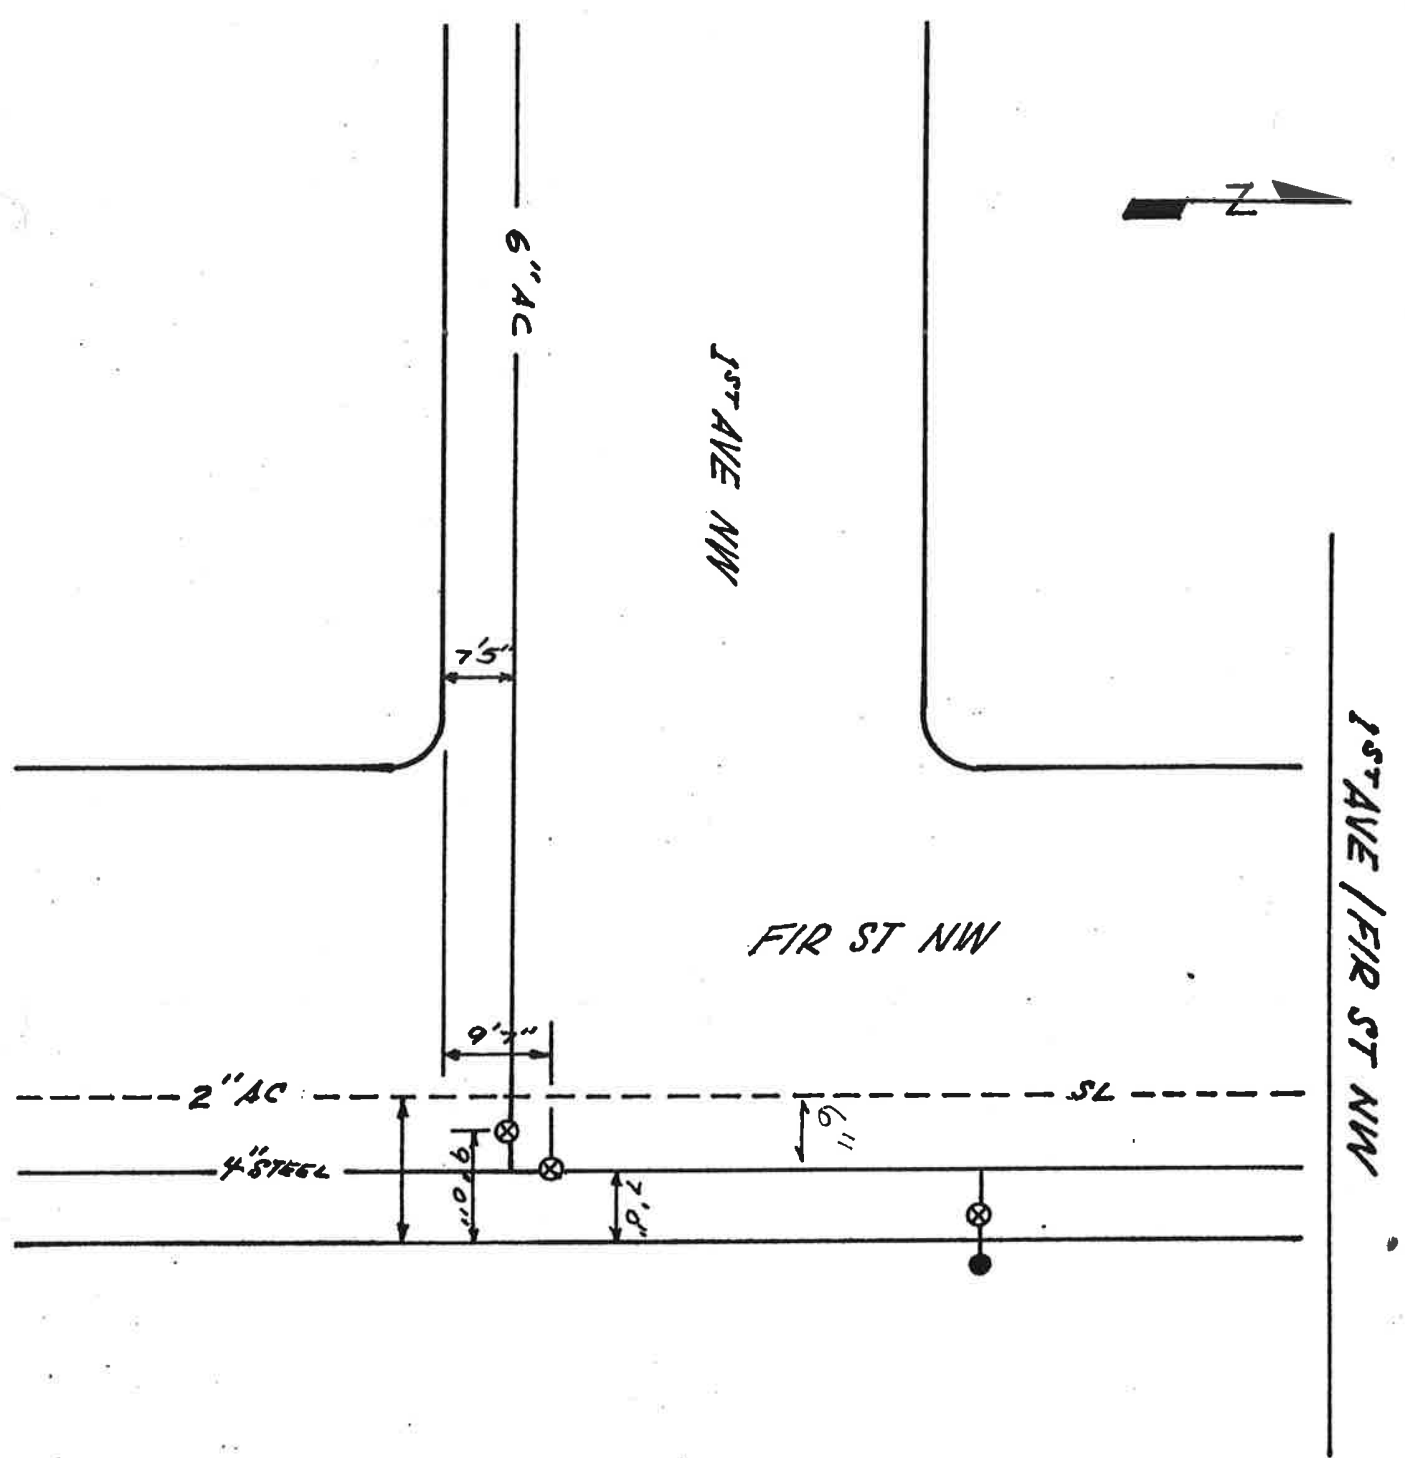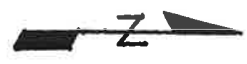

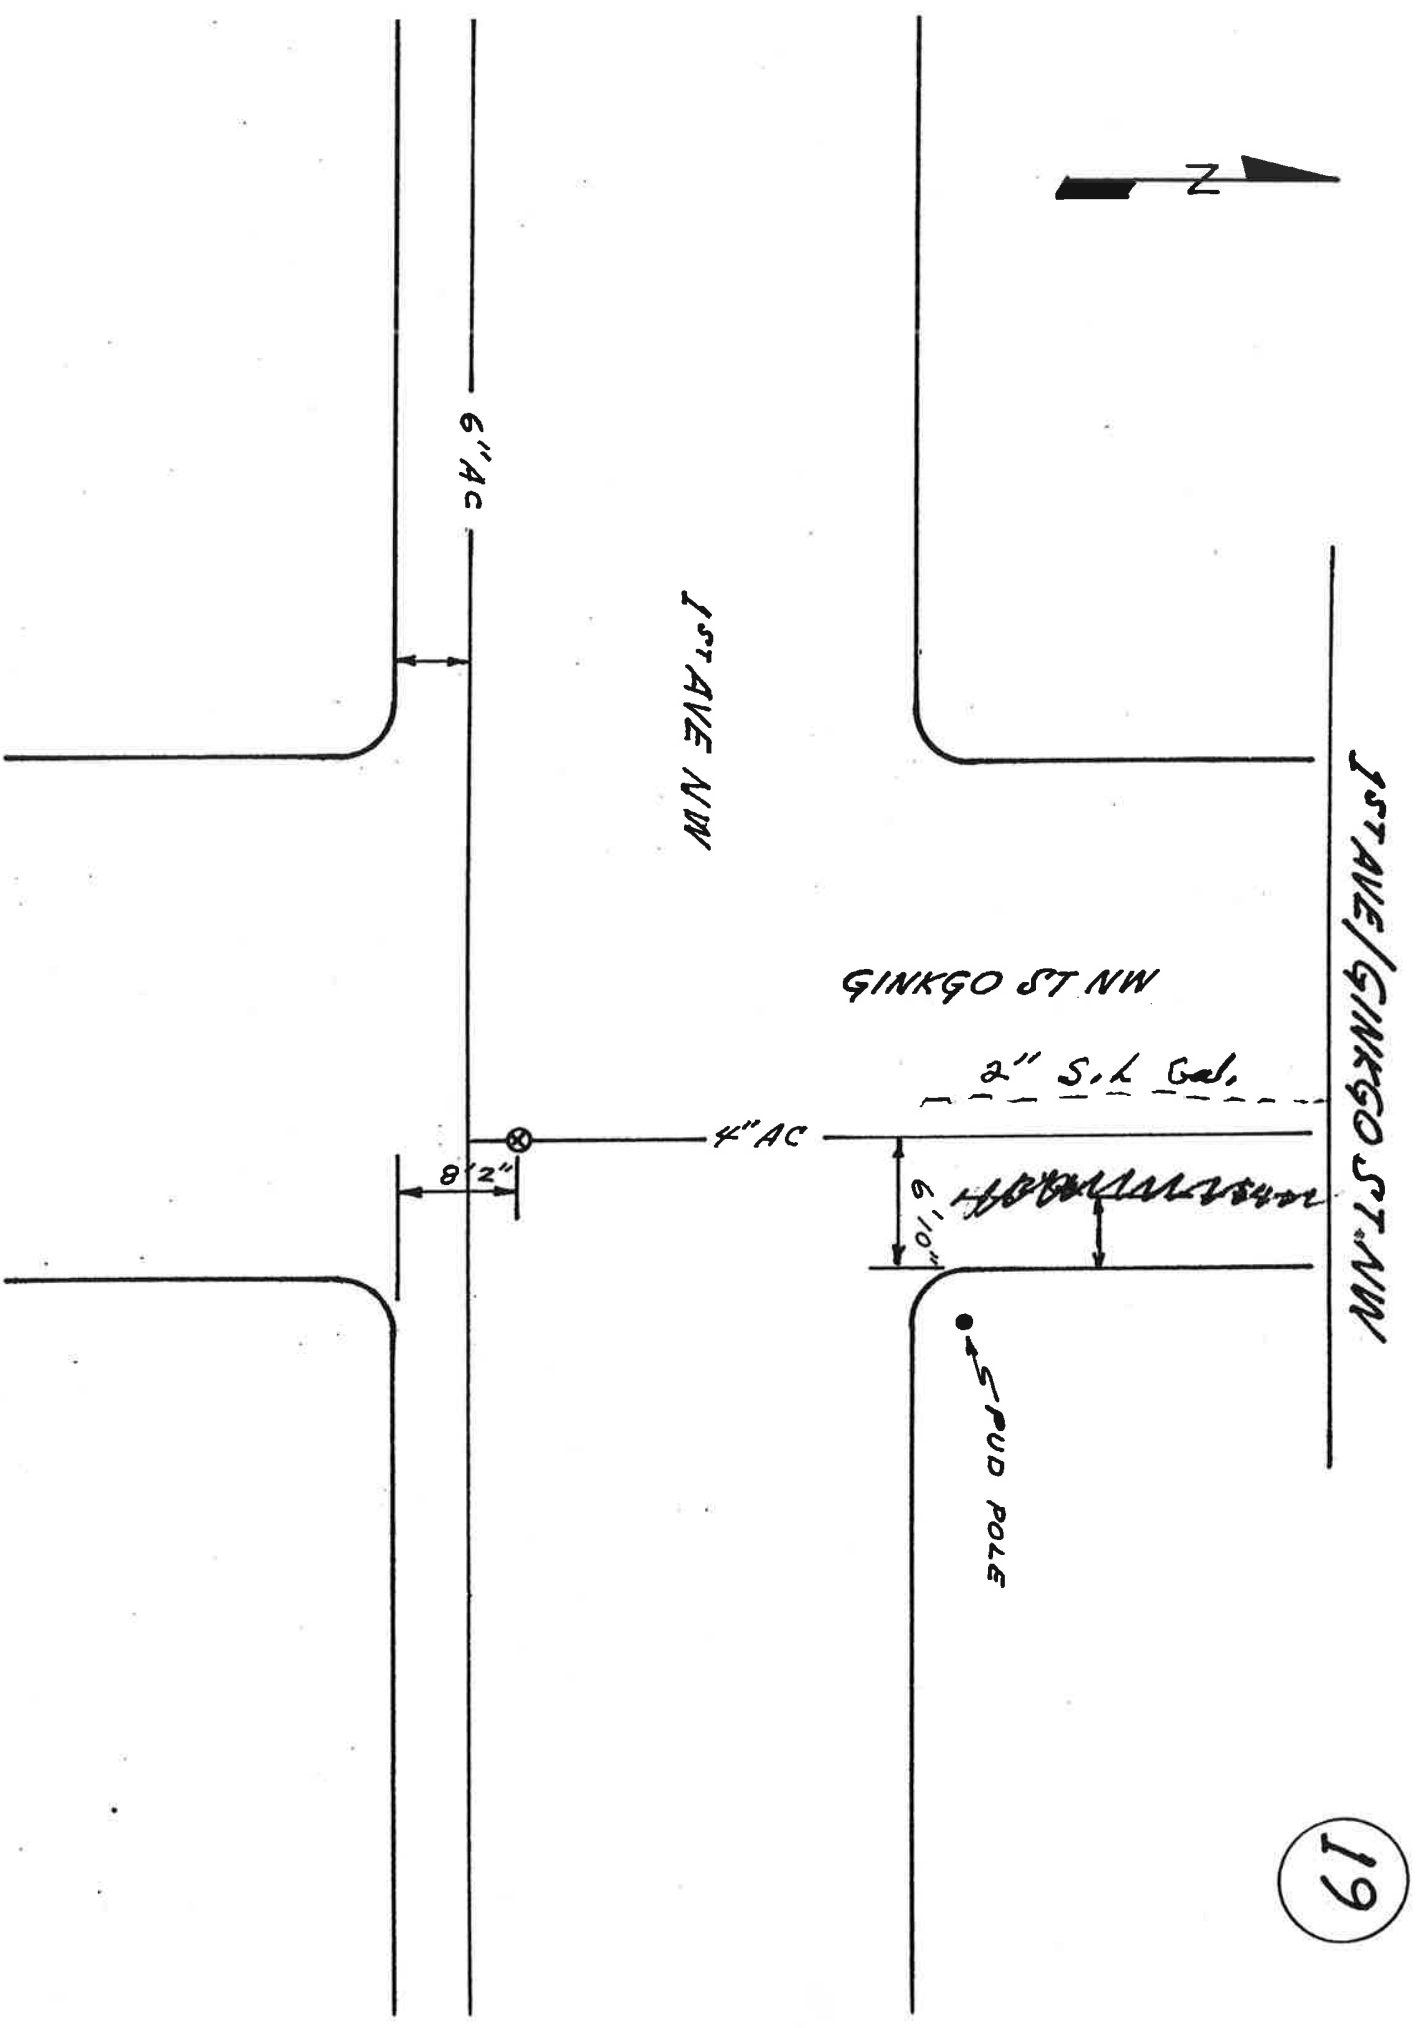



1ST AVE / HEMLOCK ST NW

20

1ST AVE NW

HEMLOCK ST NW


HYDRANT


17"
Flow
Curb

17"

6" AC

6" AC

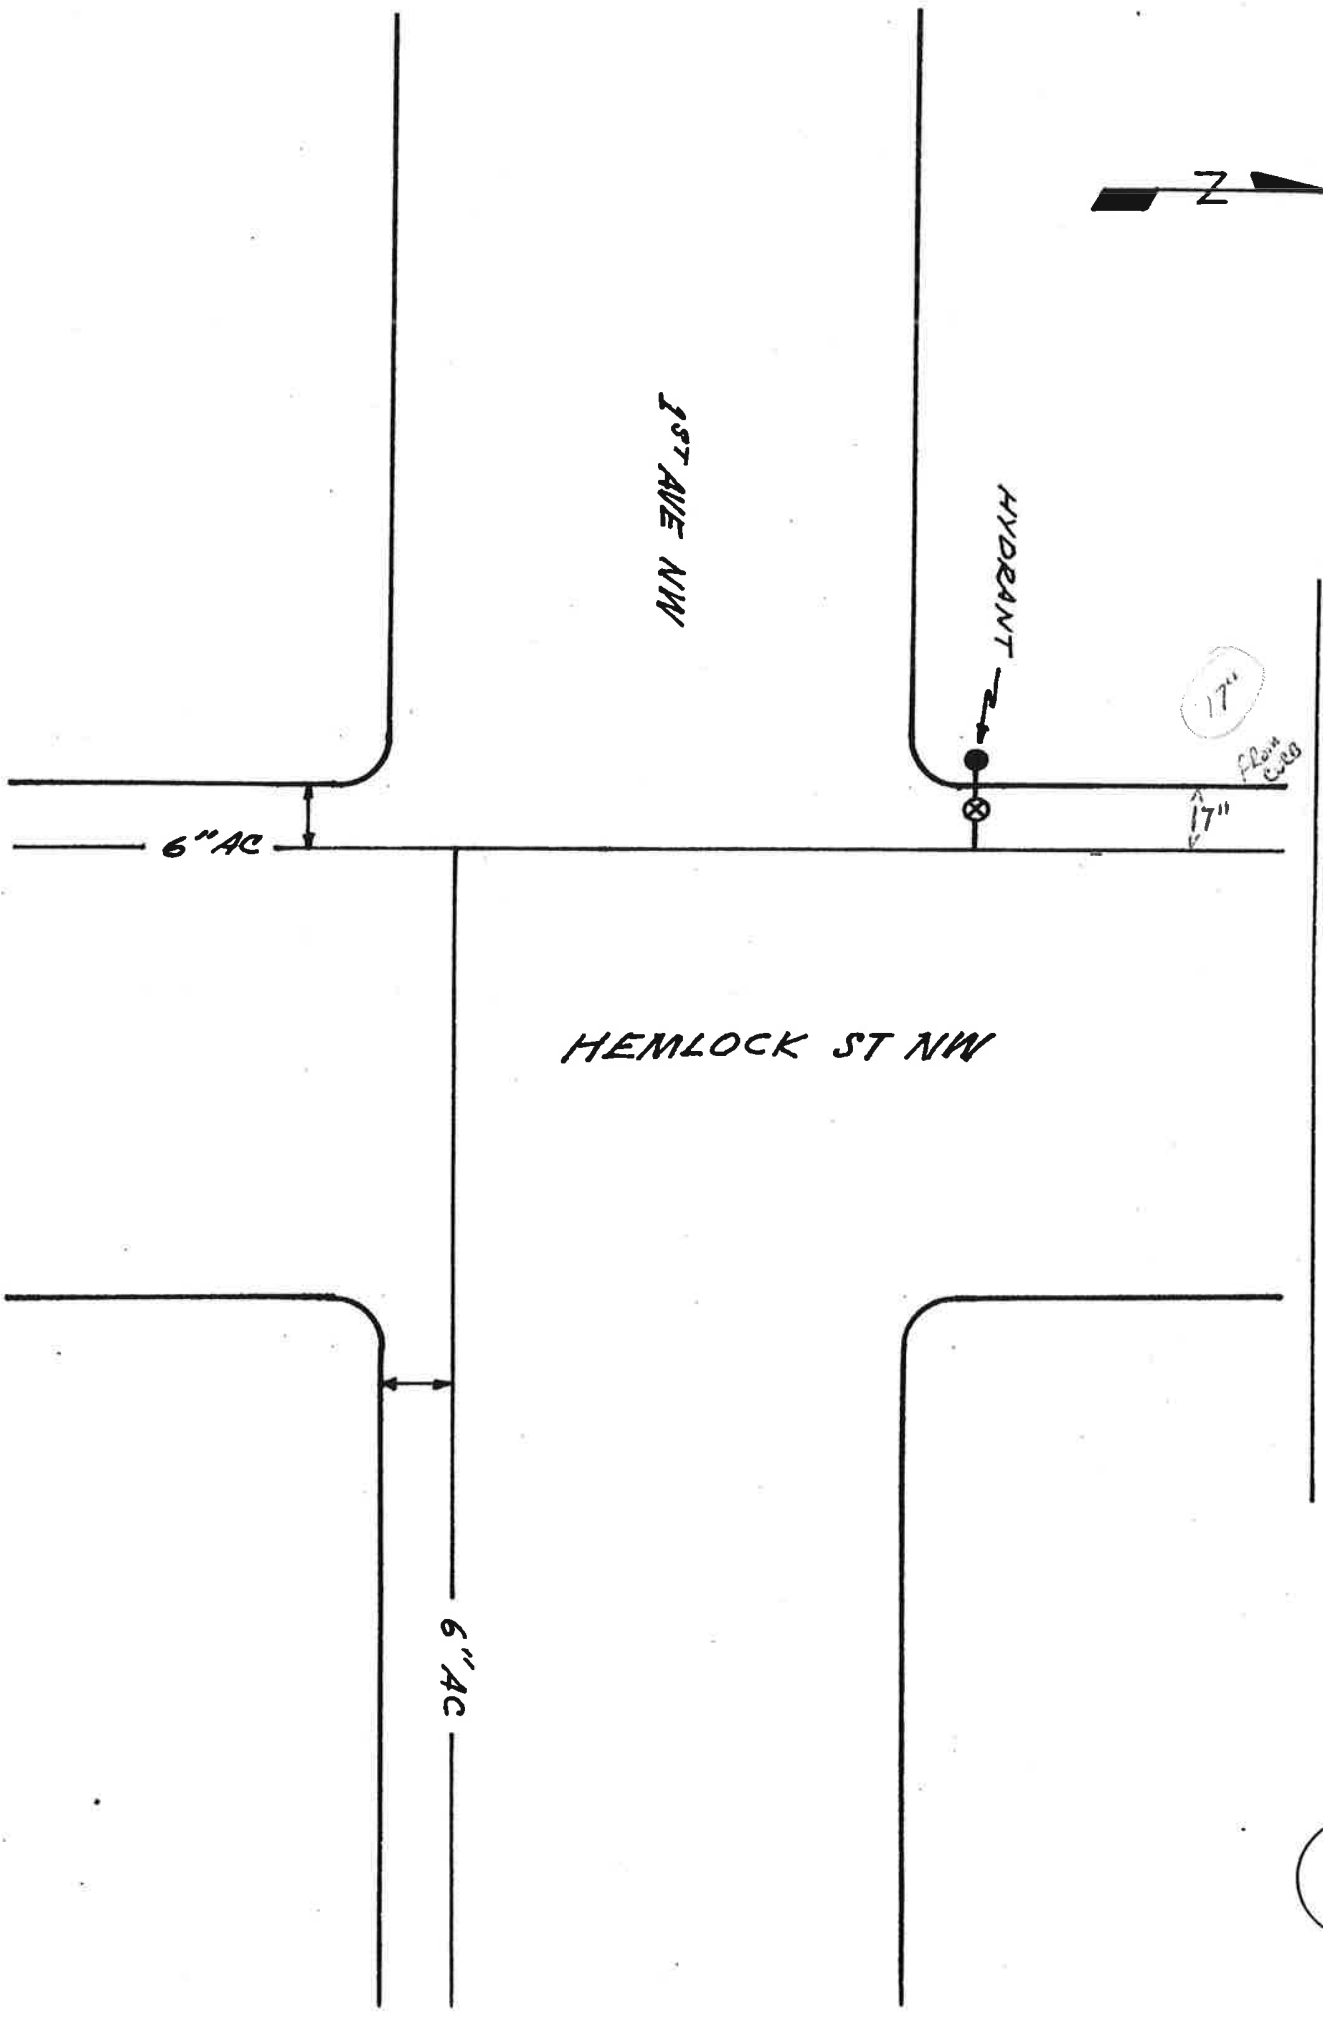

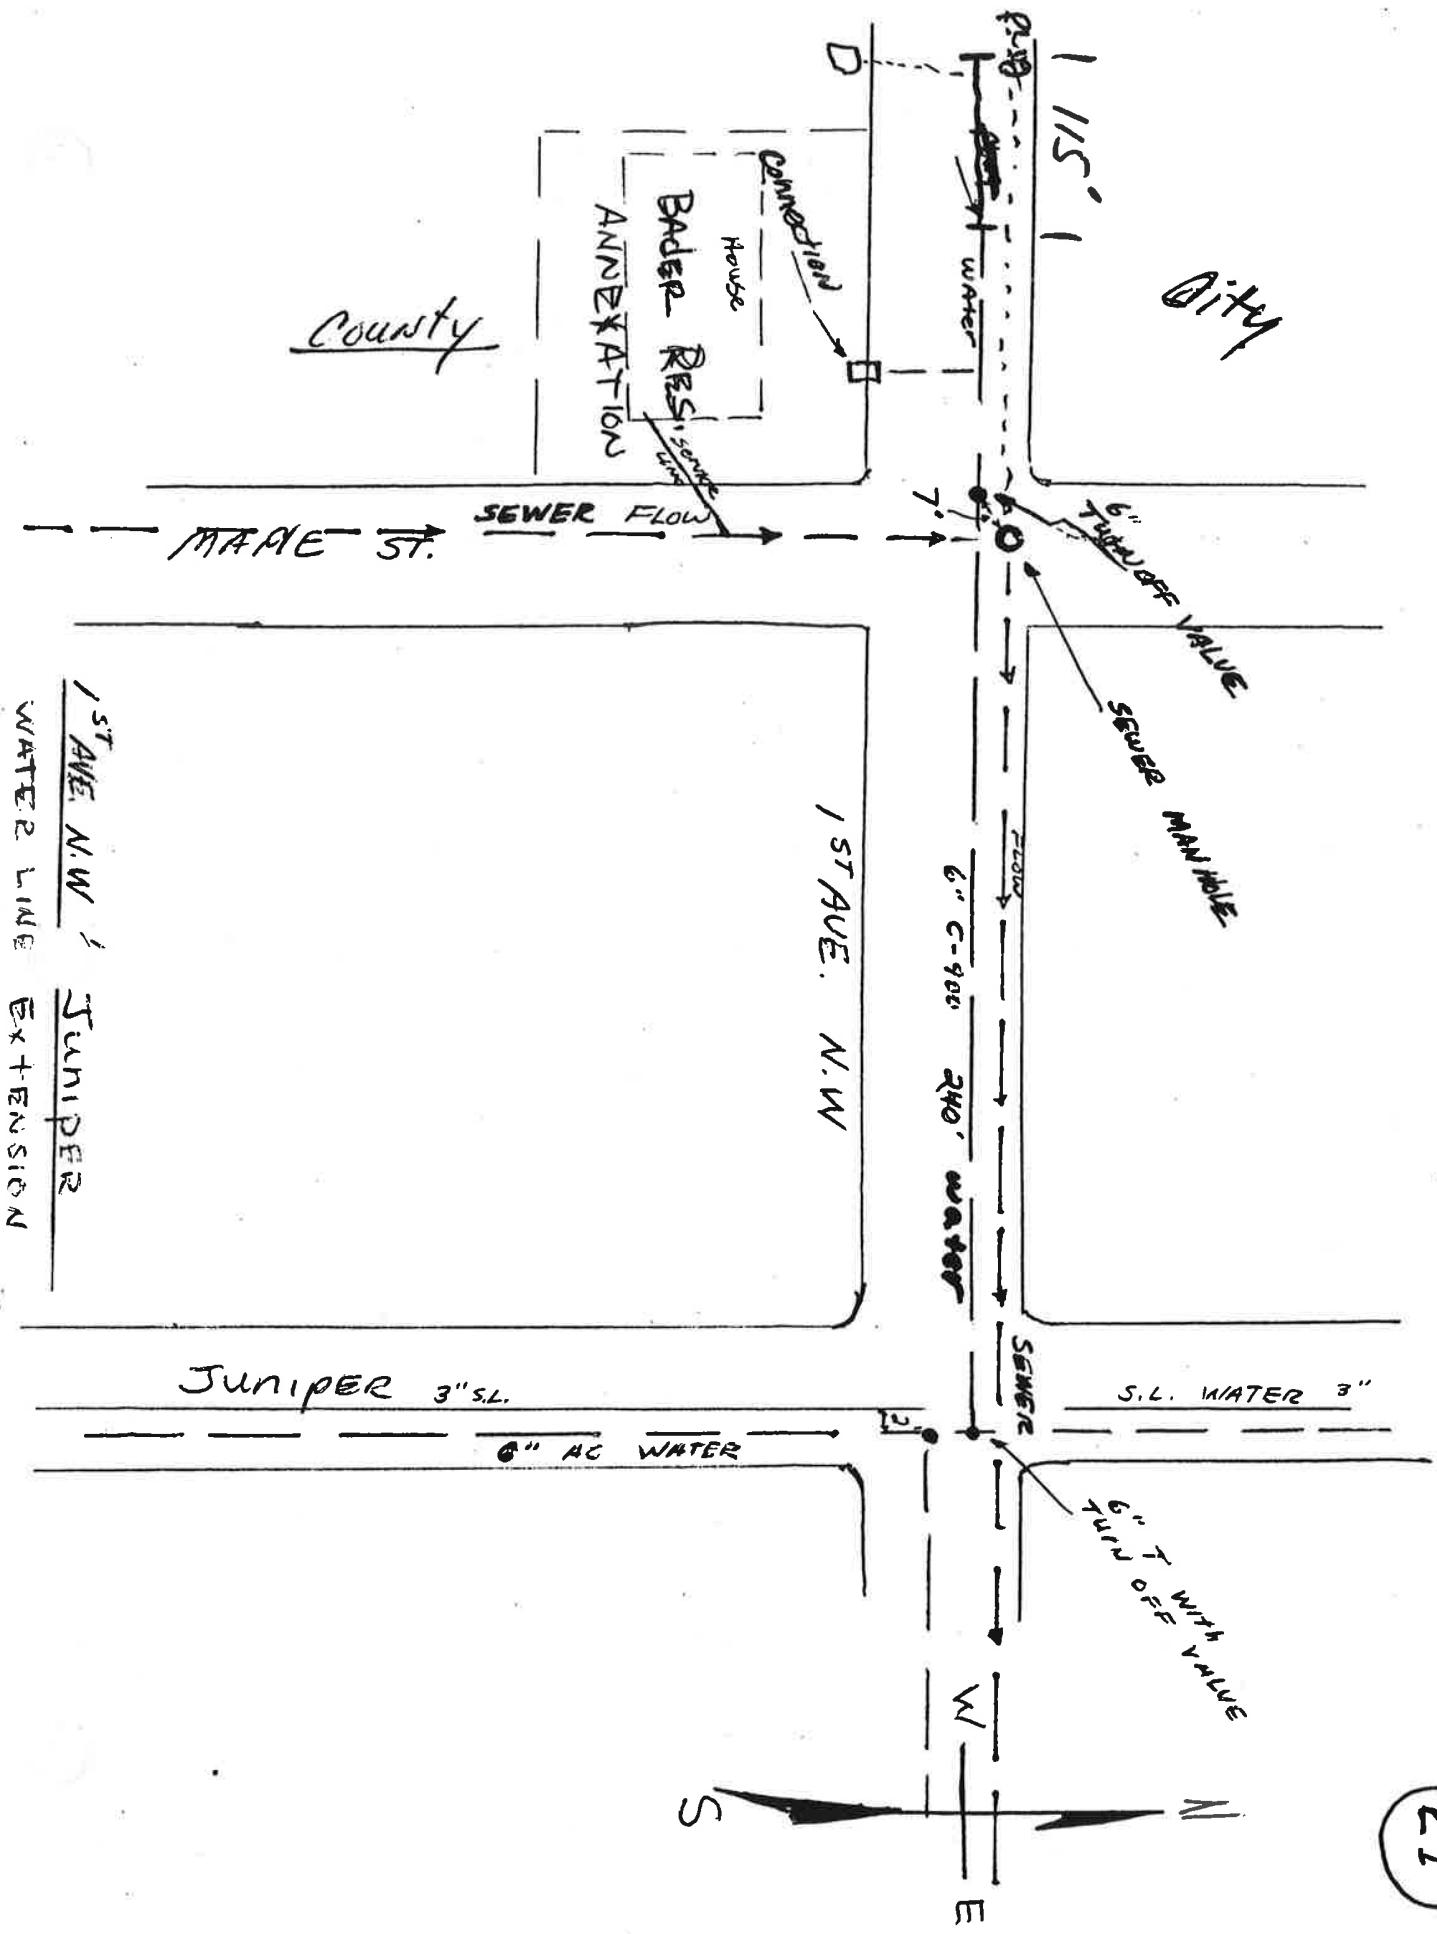

County

City

CONNECTION
 House
 BADER RESIDENCE
 ANDERKATION

MAPLE ST.

SEWER FLOW

6" TURN OFF VALVE

SEWER MANHOLE

1ST AVE. N.W.

6" C-900 240' WATER

1ST AVE. N.W.
 WATER LINE
 EXTENSION
 JUNIPER


JUNIPER 3" S.L.

6" AC WATER

S.L. WATER 3"


6" TURN OFF VALVE WITH VALVE



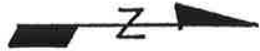


1ST AVE NW / JUNIPER ST N

21

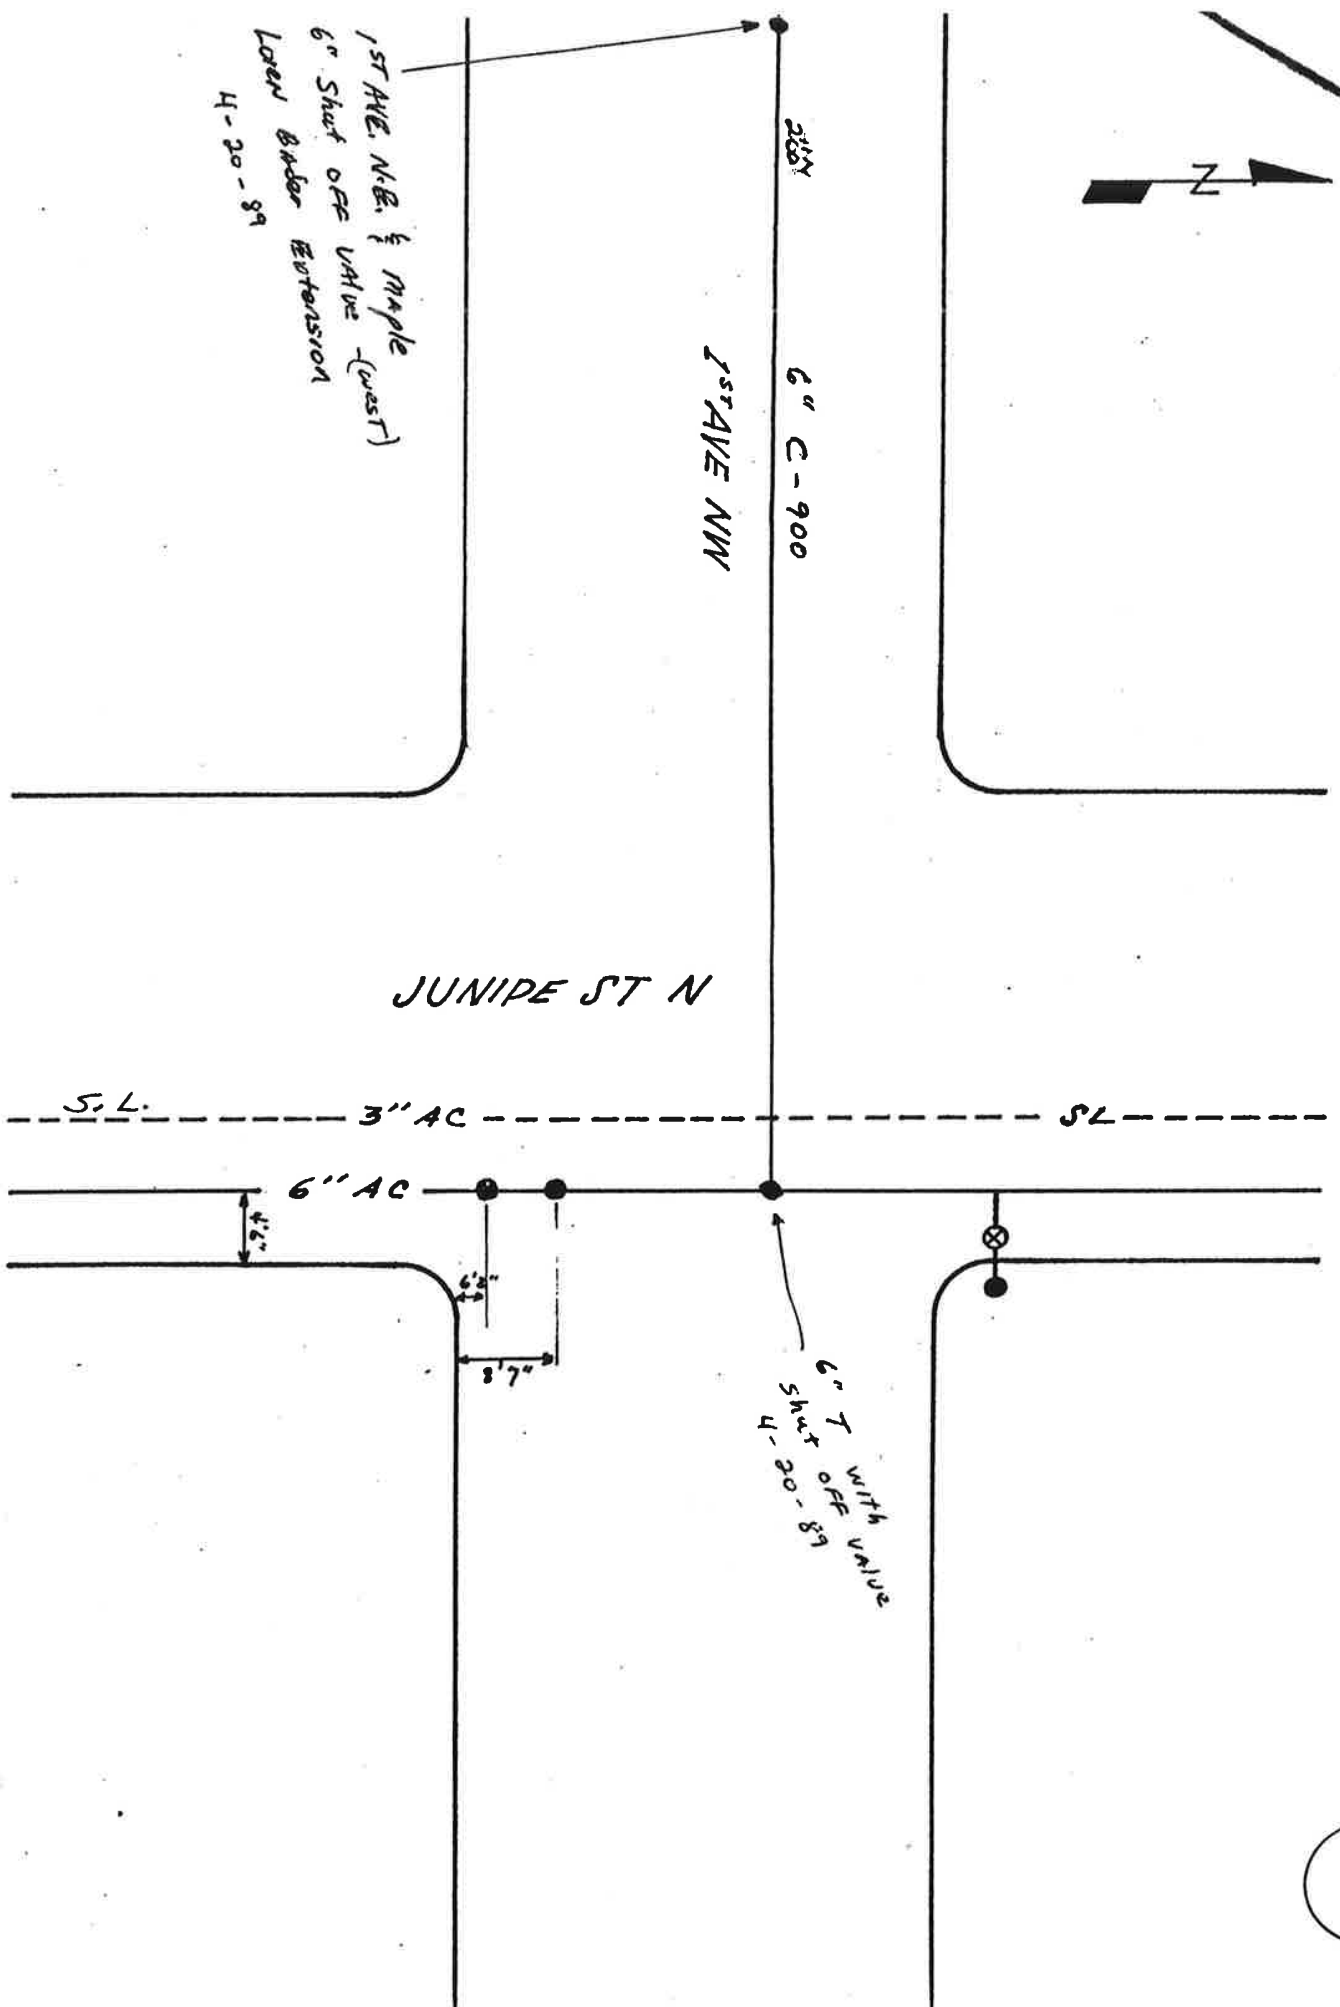




LAKE SHORE DRIVE /
ALLEY BETWEEN FIR & GINKGO ST NW

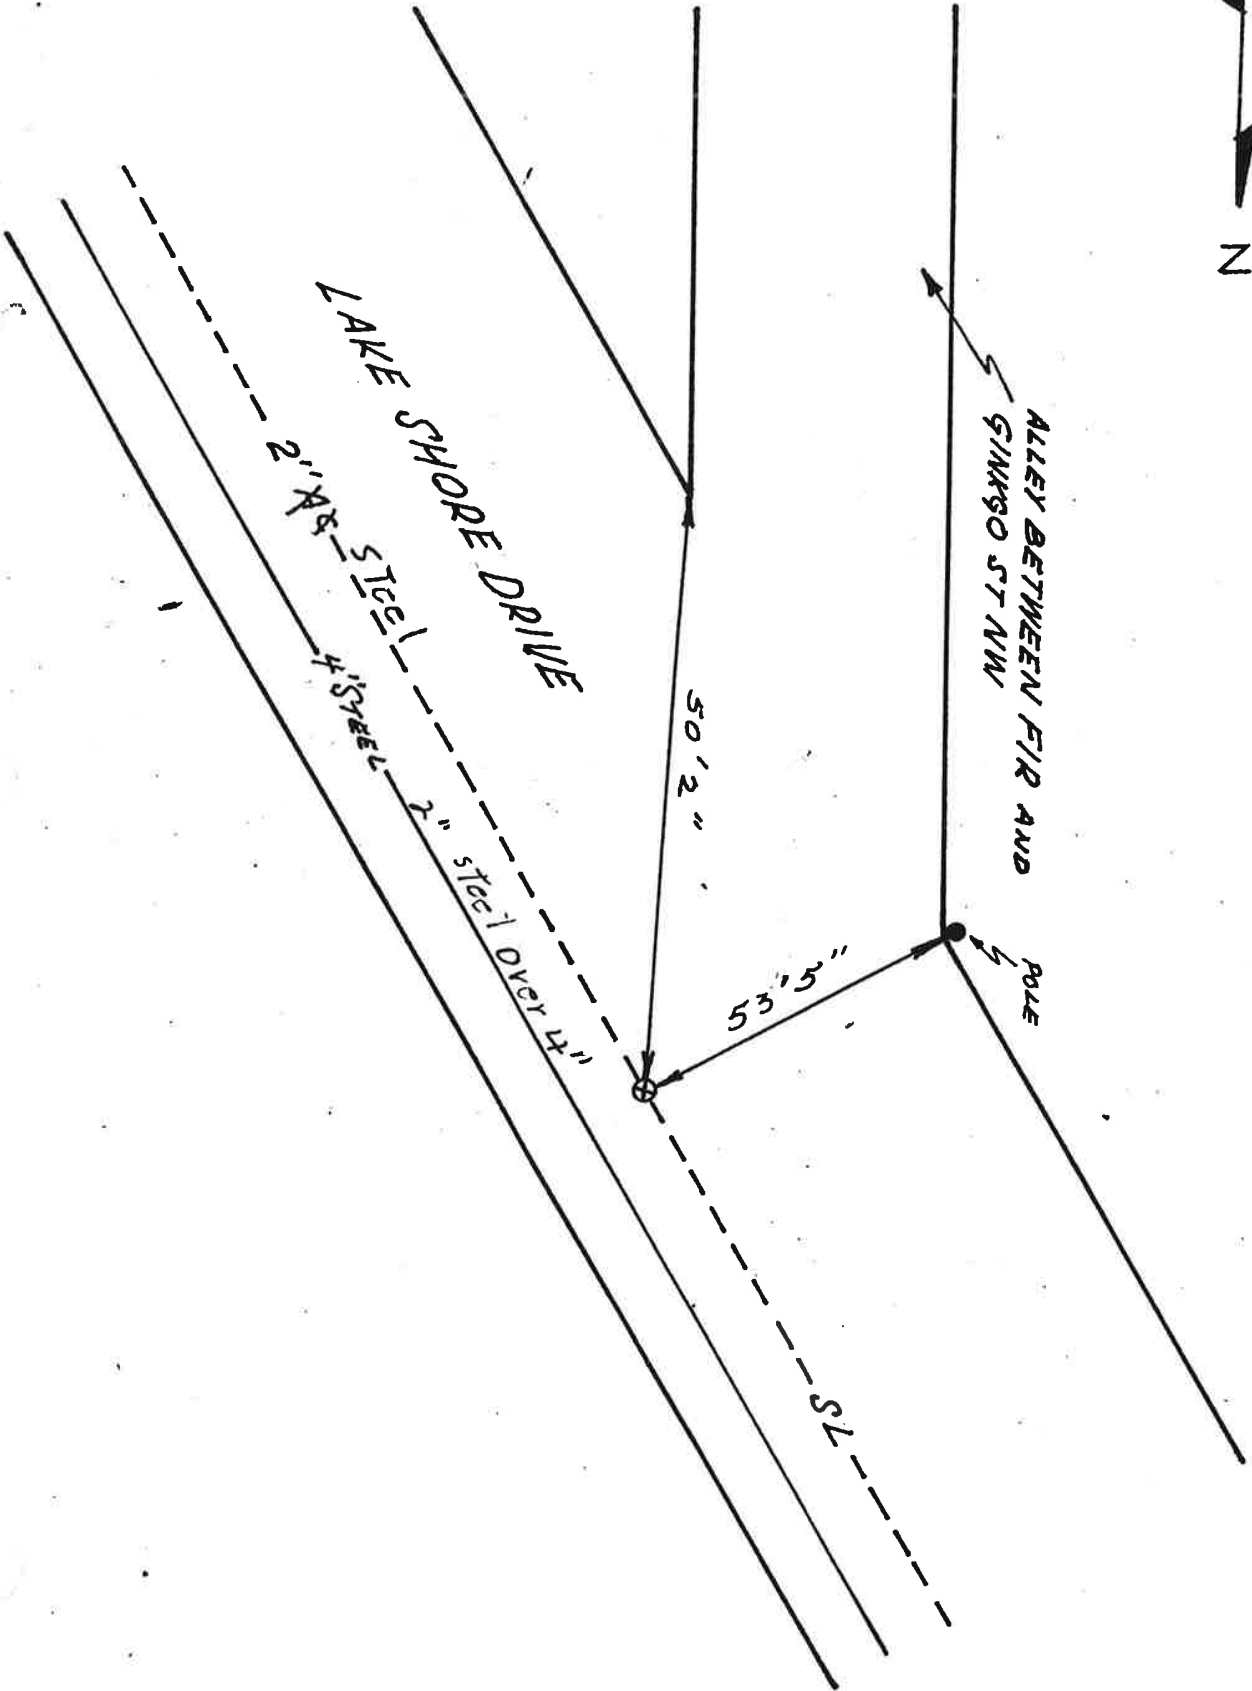

LAKE SHORE DRIVE / 3RD AVE / GINKGO ST NW

23

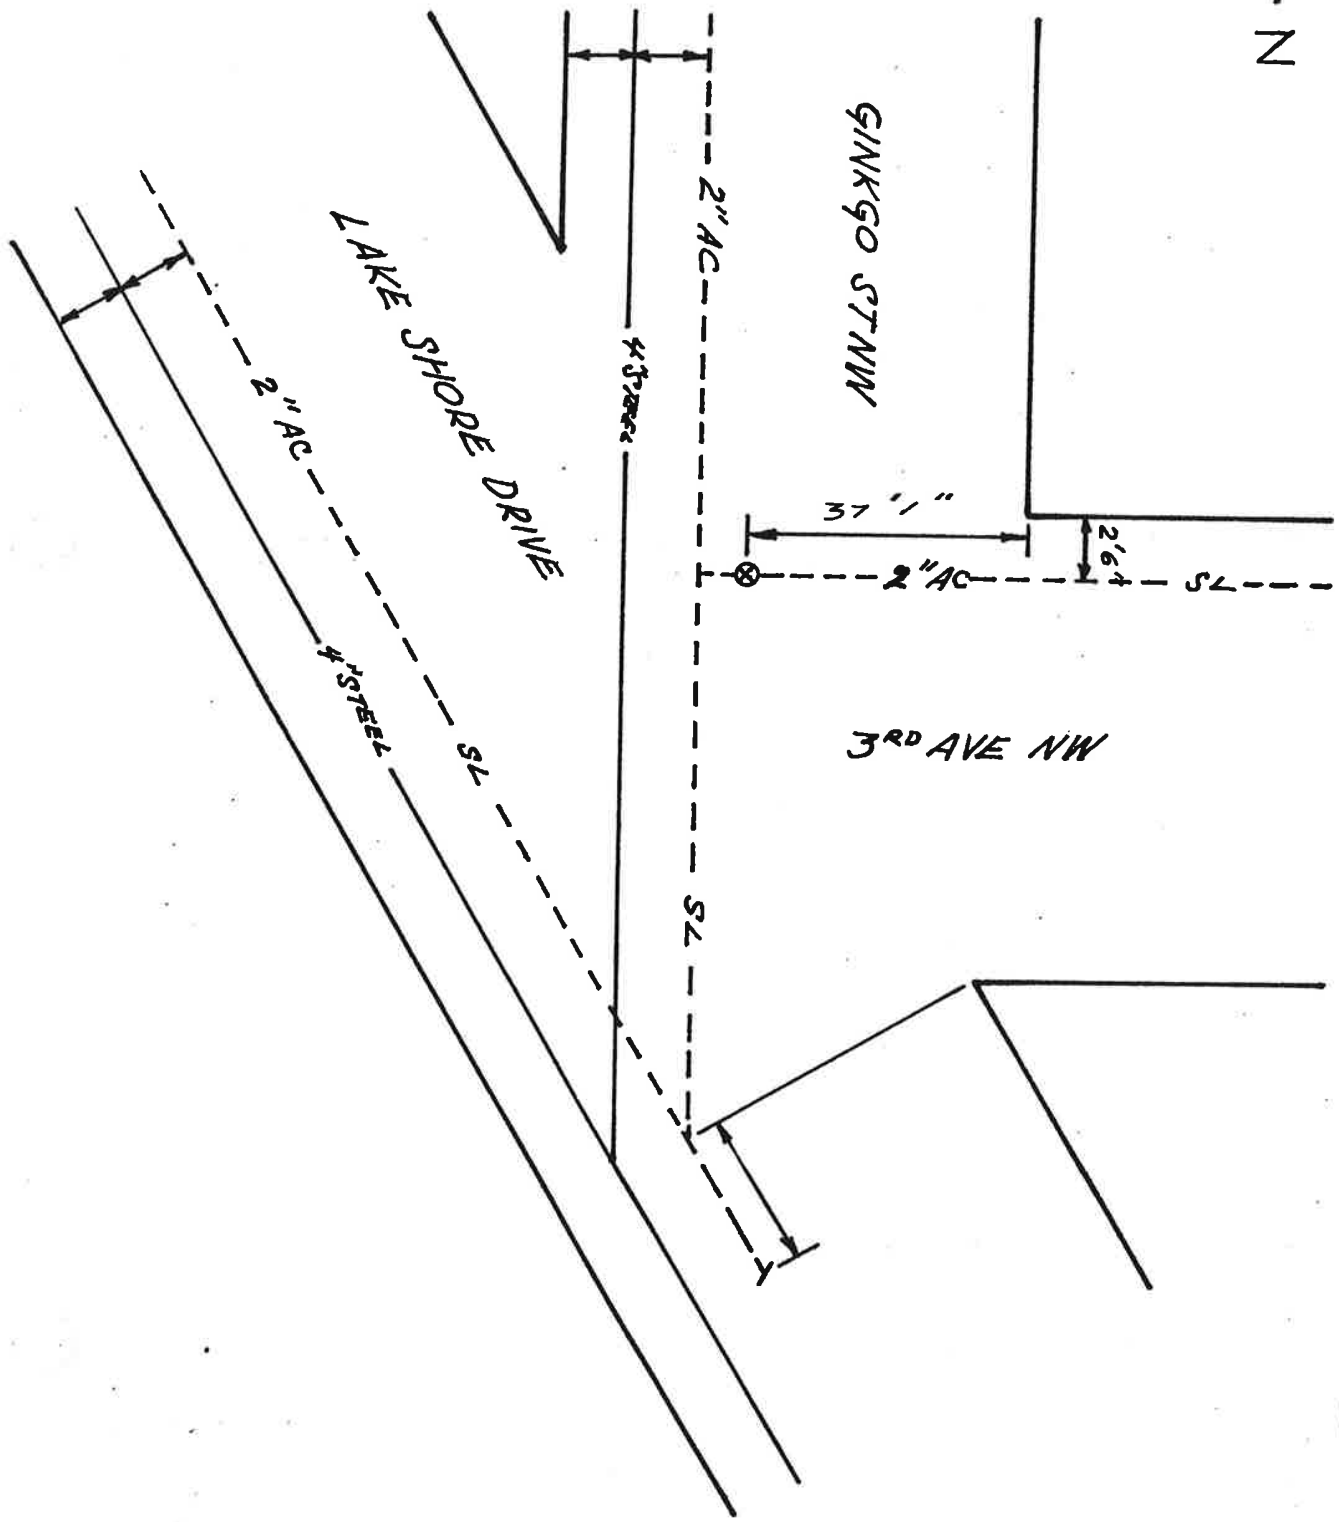

3RD AVE / HEMLOCK ST NW



HYDRANT

3RD AVE NW

8" AC 6" AC

HEMLOCK ST NW

1" COPPER

54

2" AC




10'


2" AC

3' 6" Deep

54

24

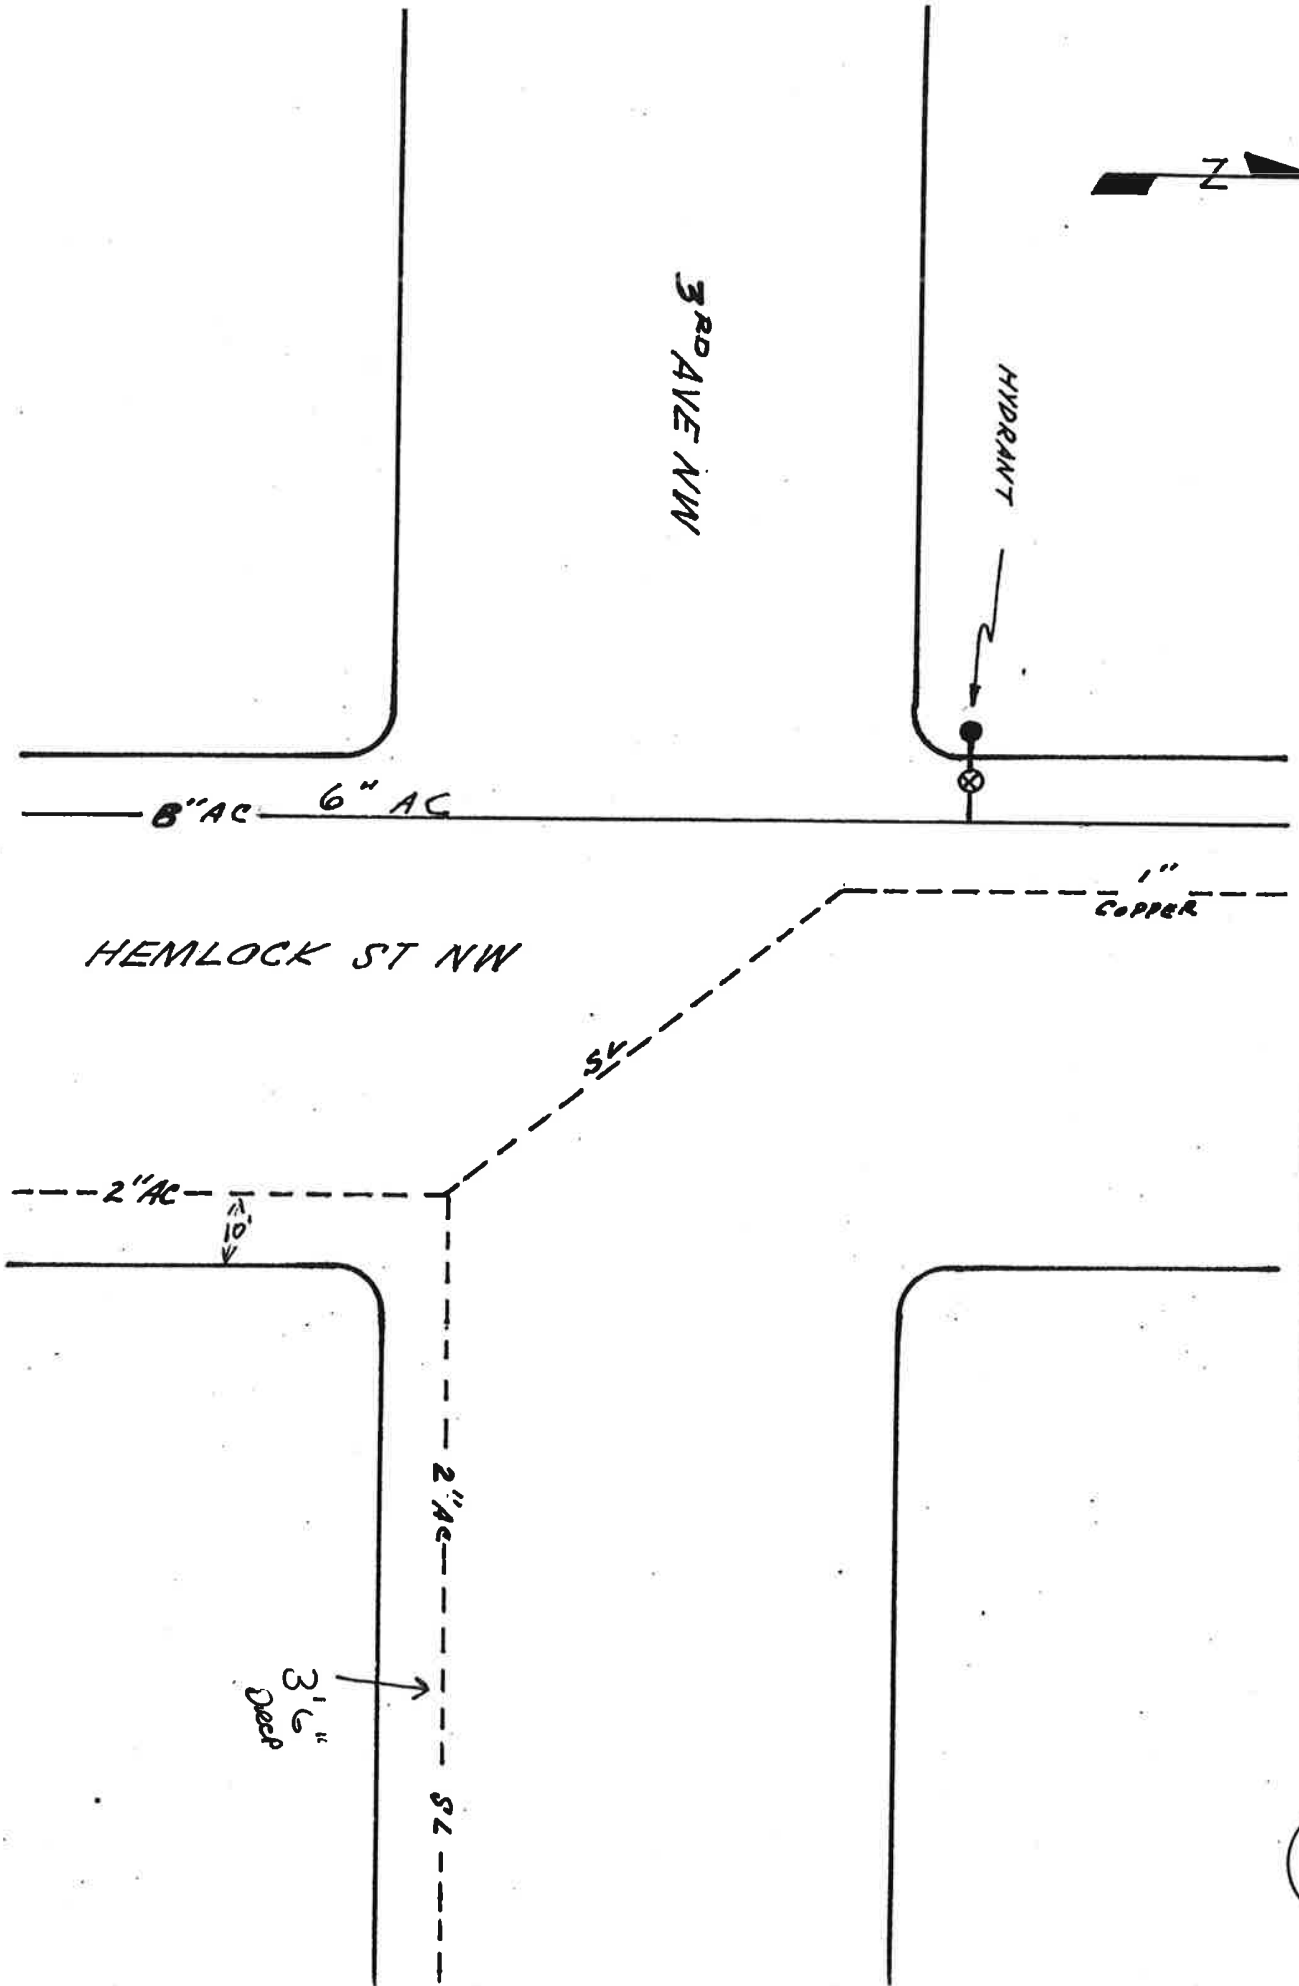


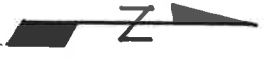

3RD AVE / JUNIPER ST NW



JUNIPER ST NW


3RD AVE NW

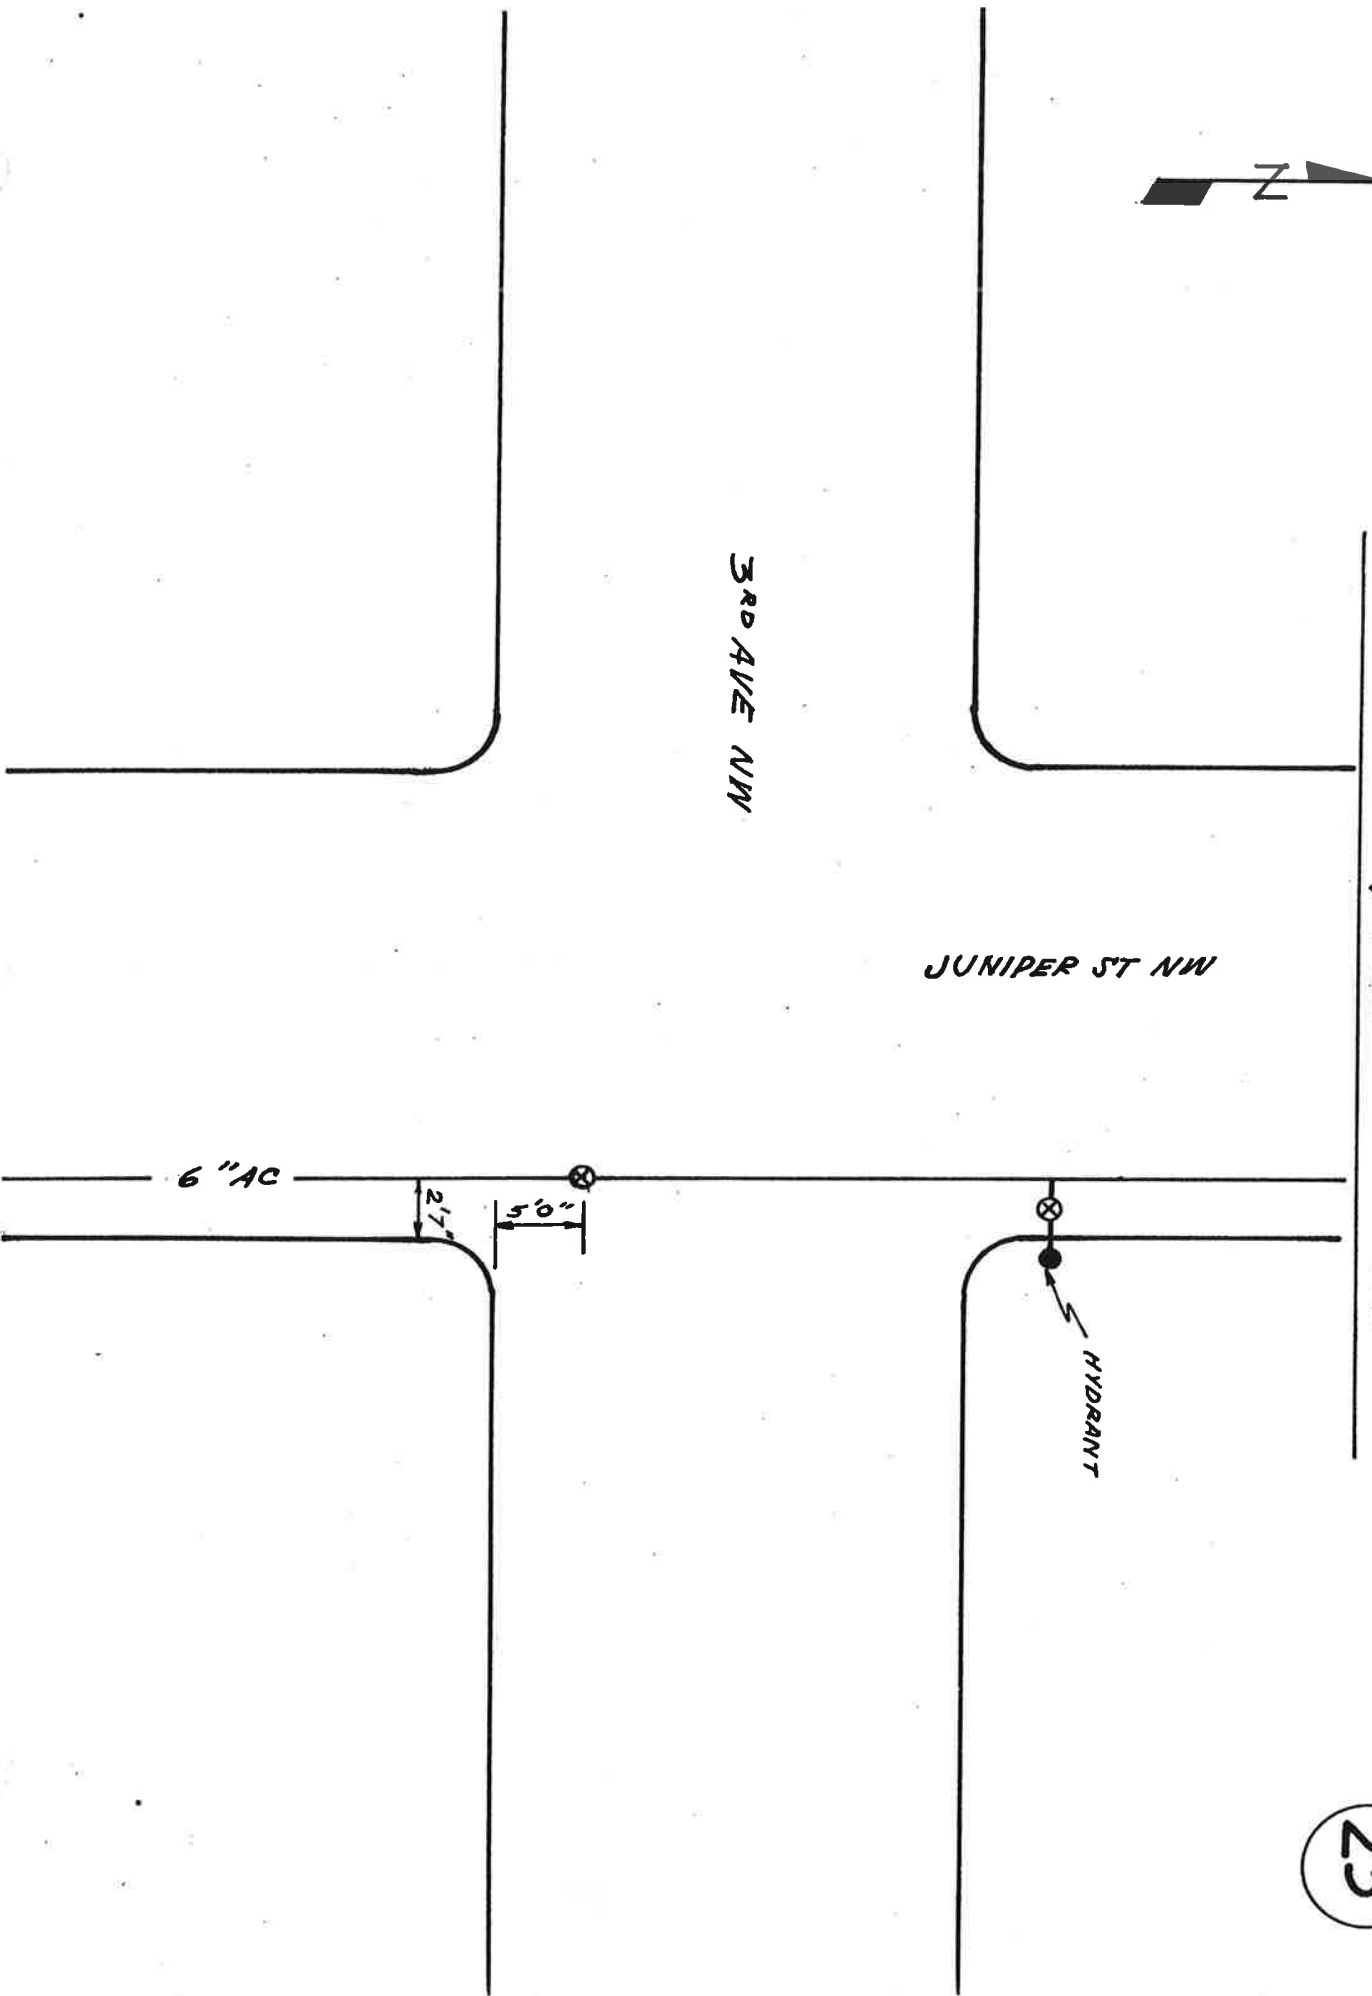

25

LAKE SHORE DRIVE/HEMLOCK ST NW

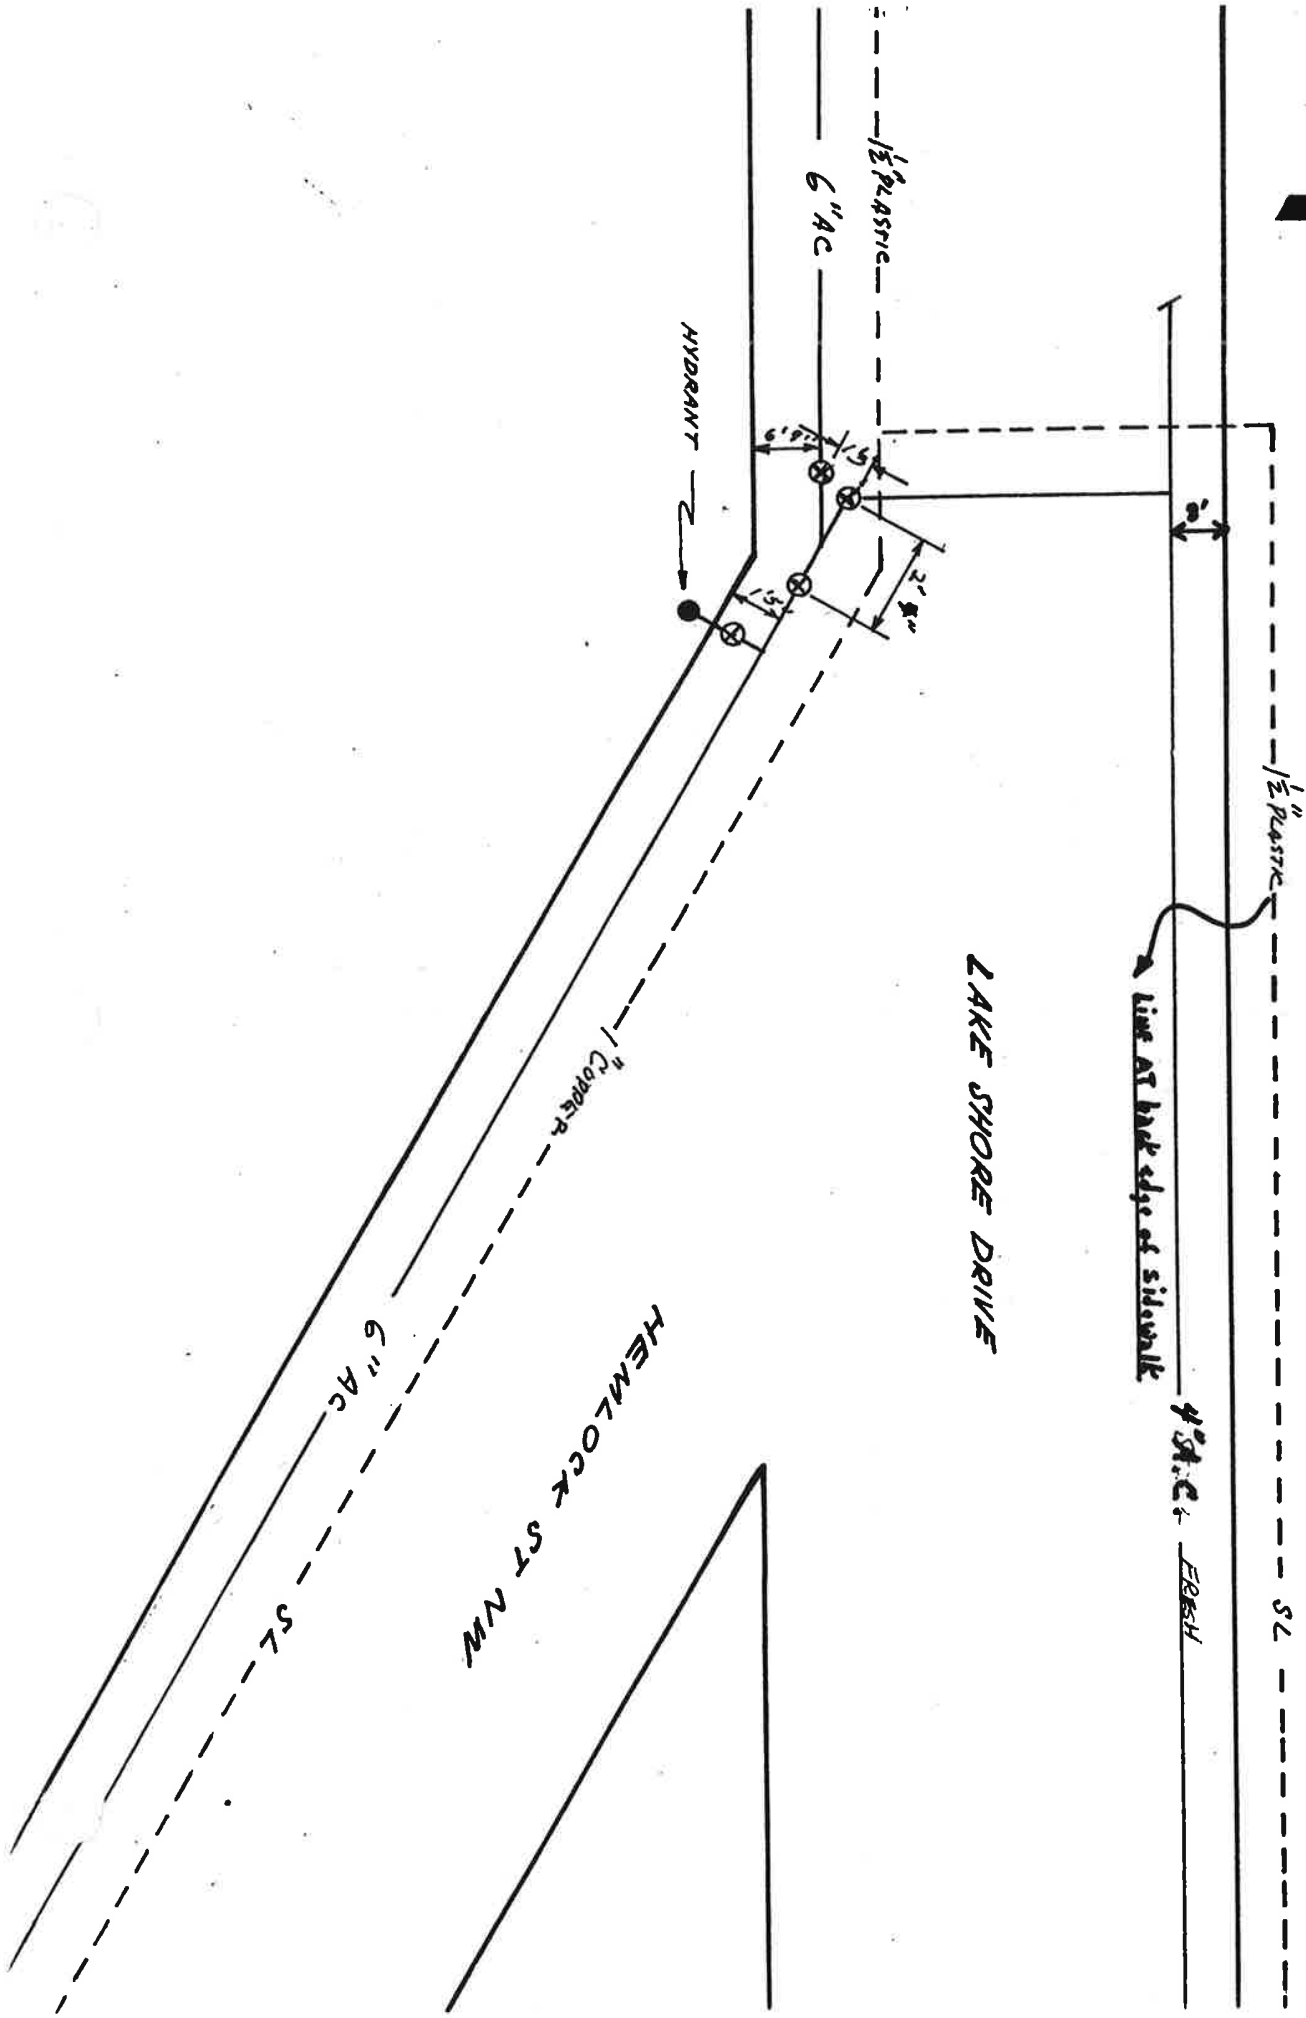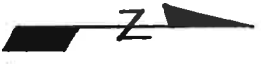

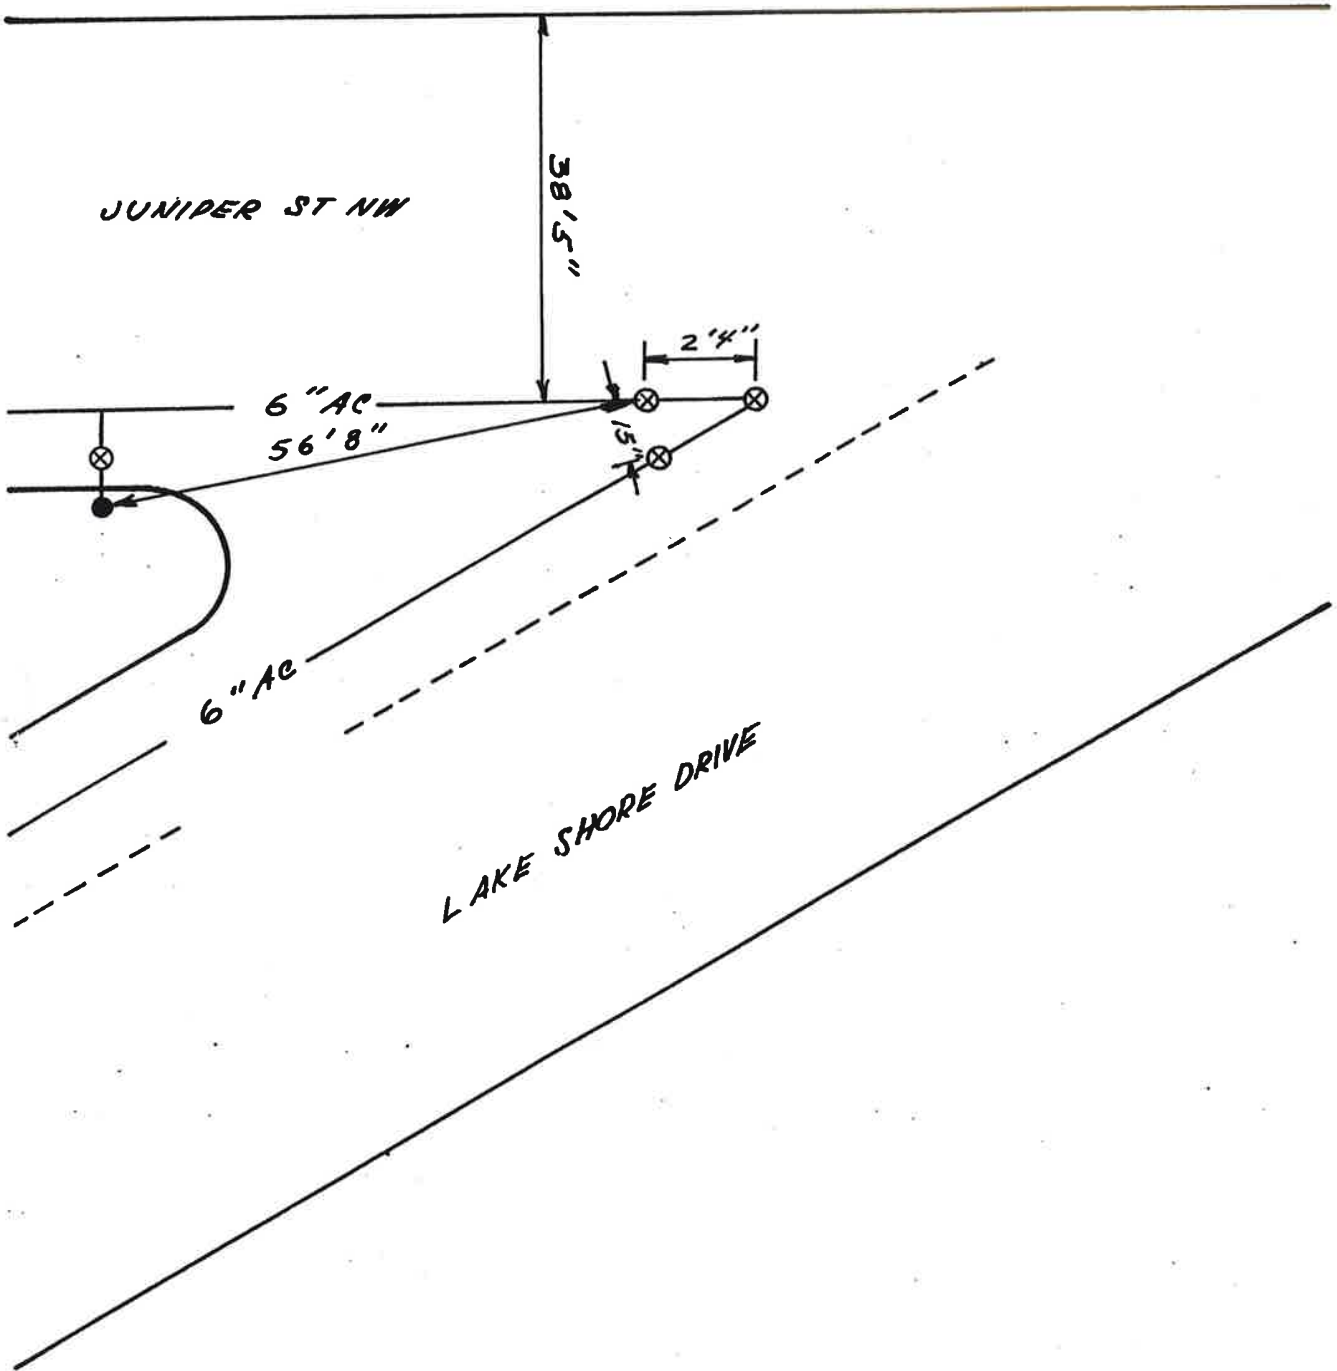

JUNIPER ST NW

38'5"

2'4"


6" AC
56'8"

15'4"


6" AC

LAKE SHORE DRIVE

LAKE SHORE DRIVE / JUNIPER ST NW

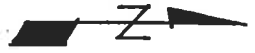

2ND AVE SE / DIVISION ST

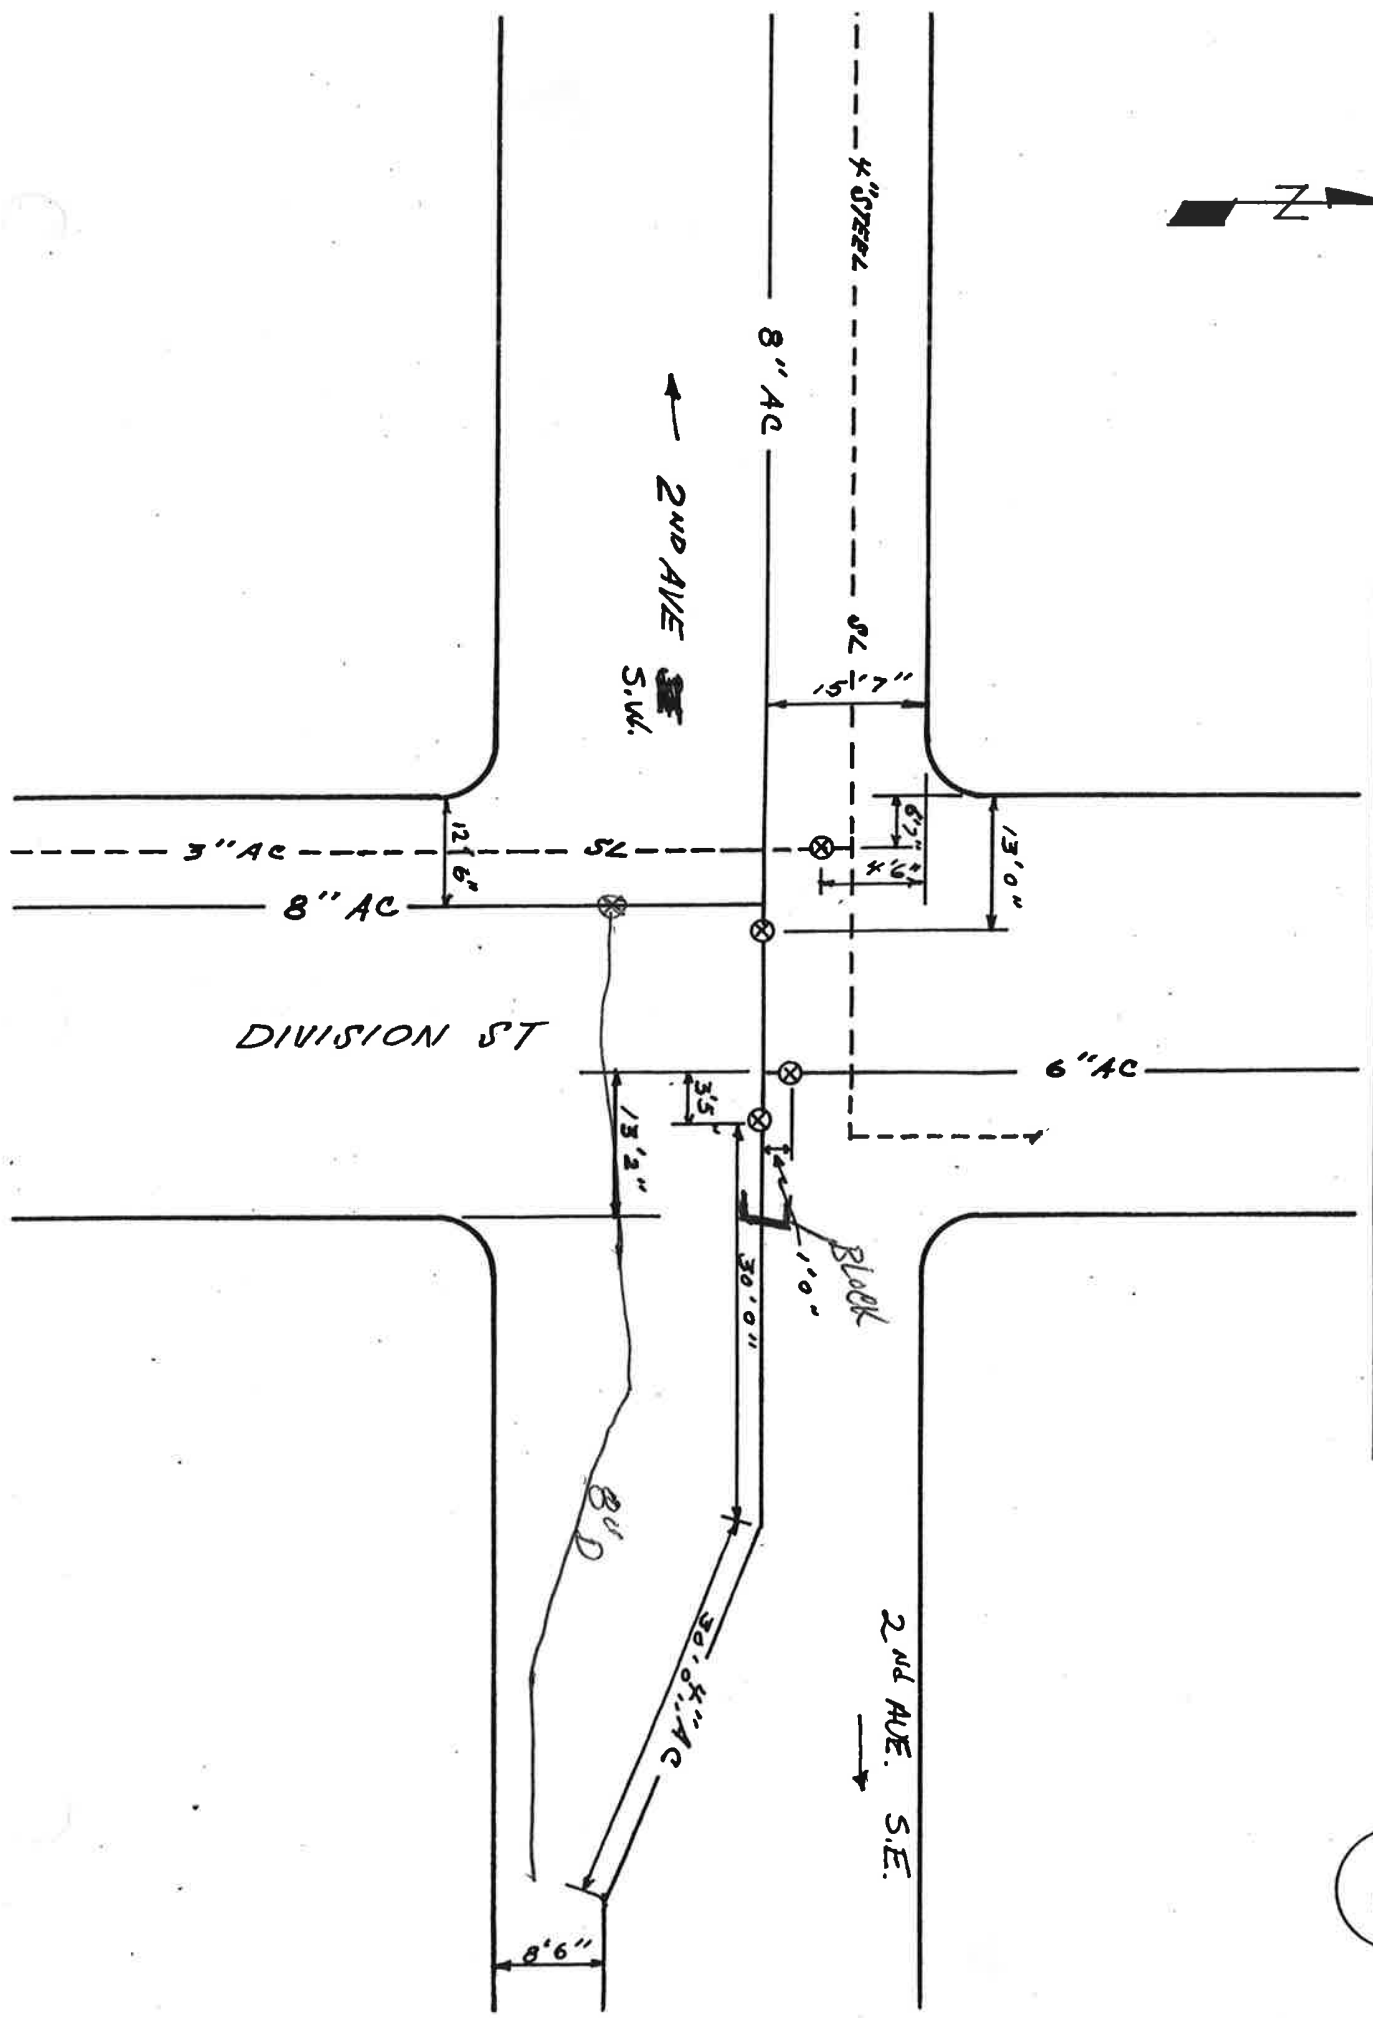


2ND AVE SW / ALLEY BETWEEN DIVISION ST / ASH ST SW


29




ALLEY BETWEEN
DIVISION / ASH

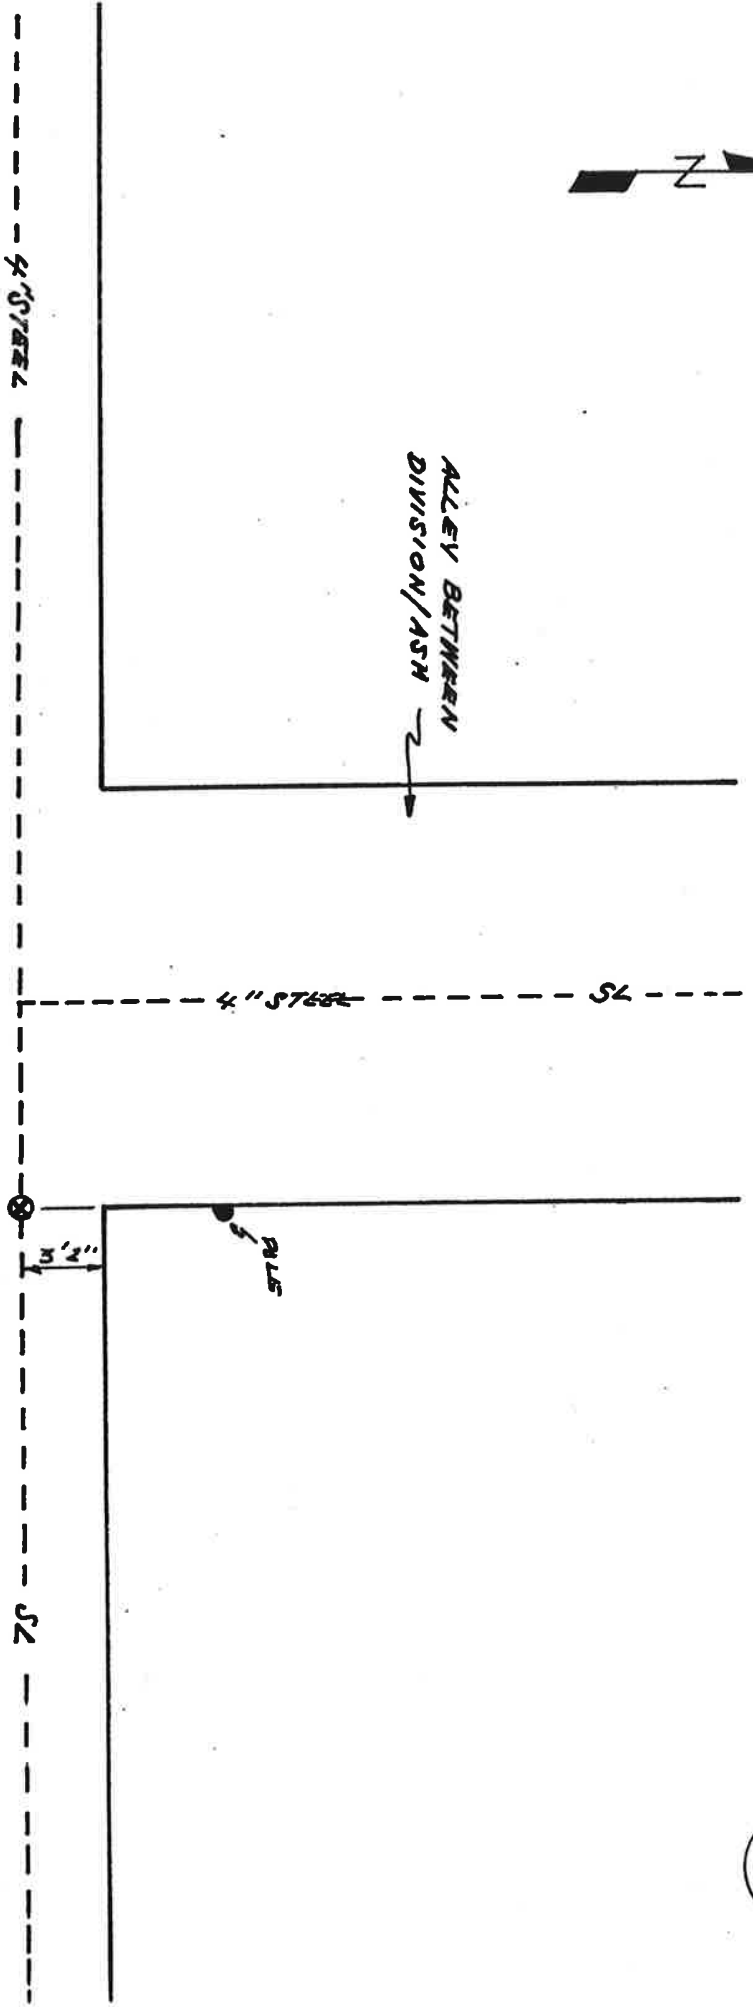

2ND AVE SW

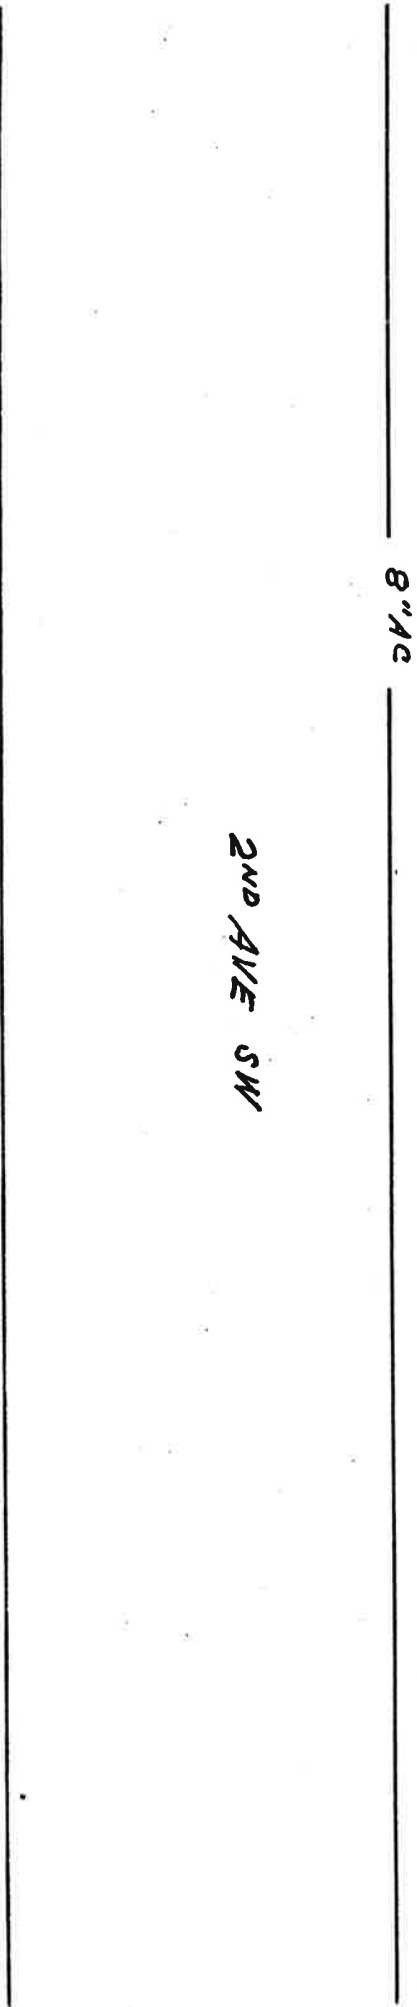

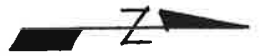

2ND AVE / ASH ST SW

30

HYDRANT

4" AC

ASH ST SW

4" STEEL

8" AC

2ND AVE SW


15' 6"


5' 6"

4' 4"

14' 5"

SL

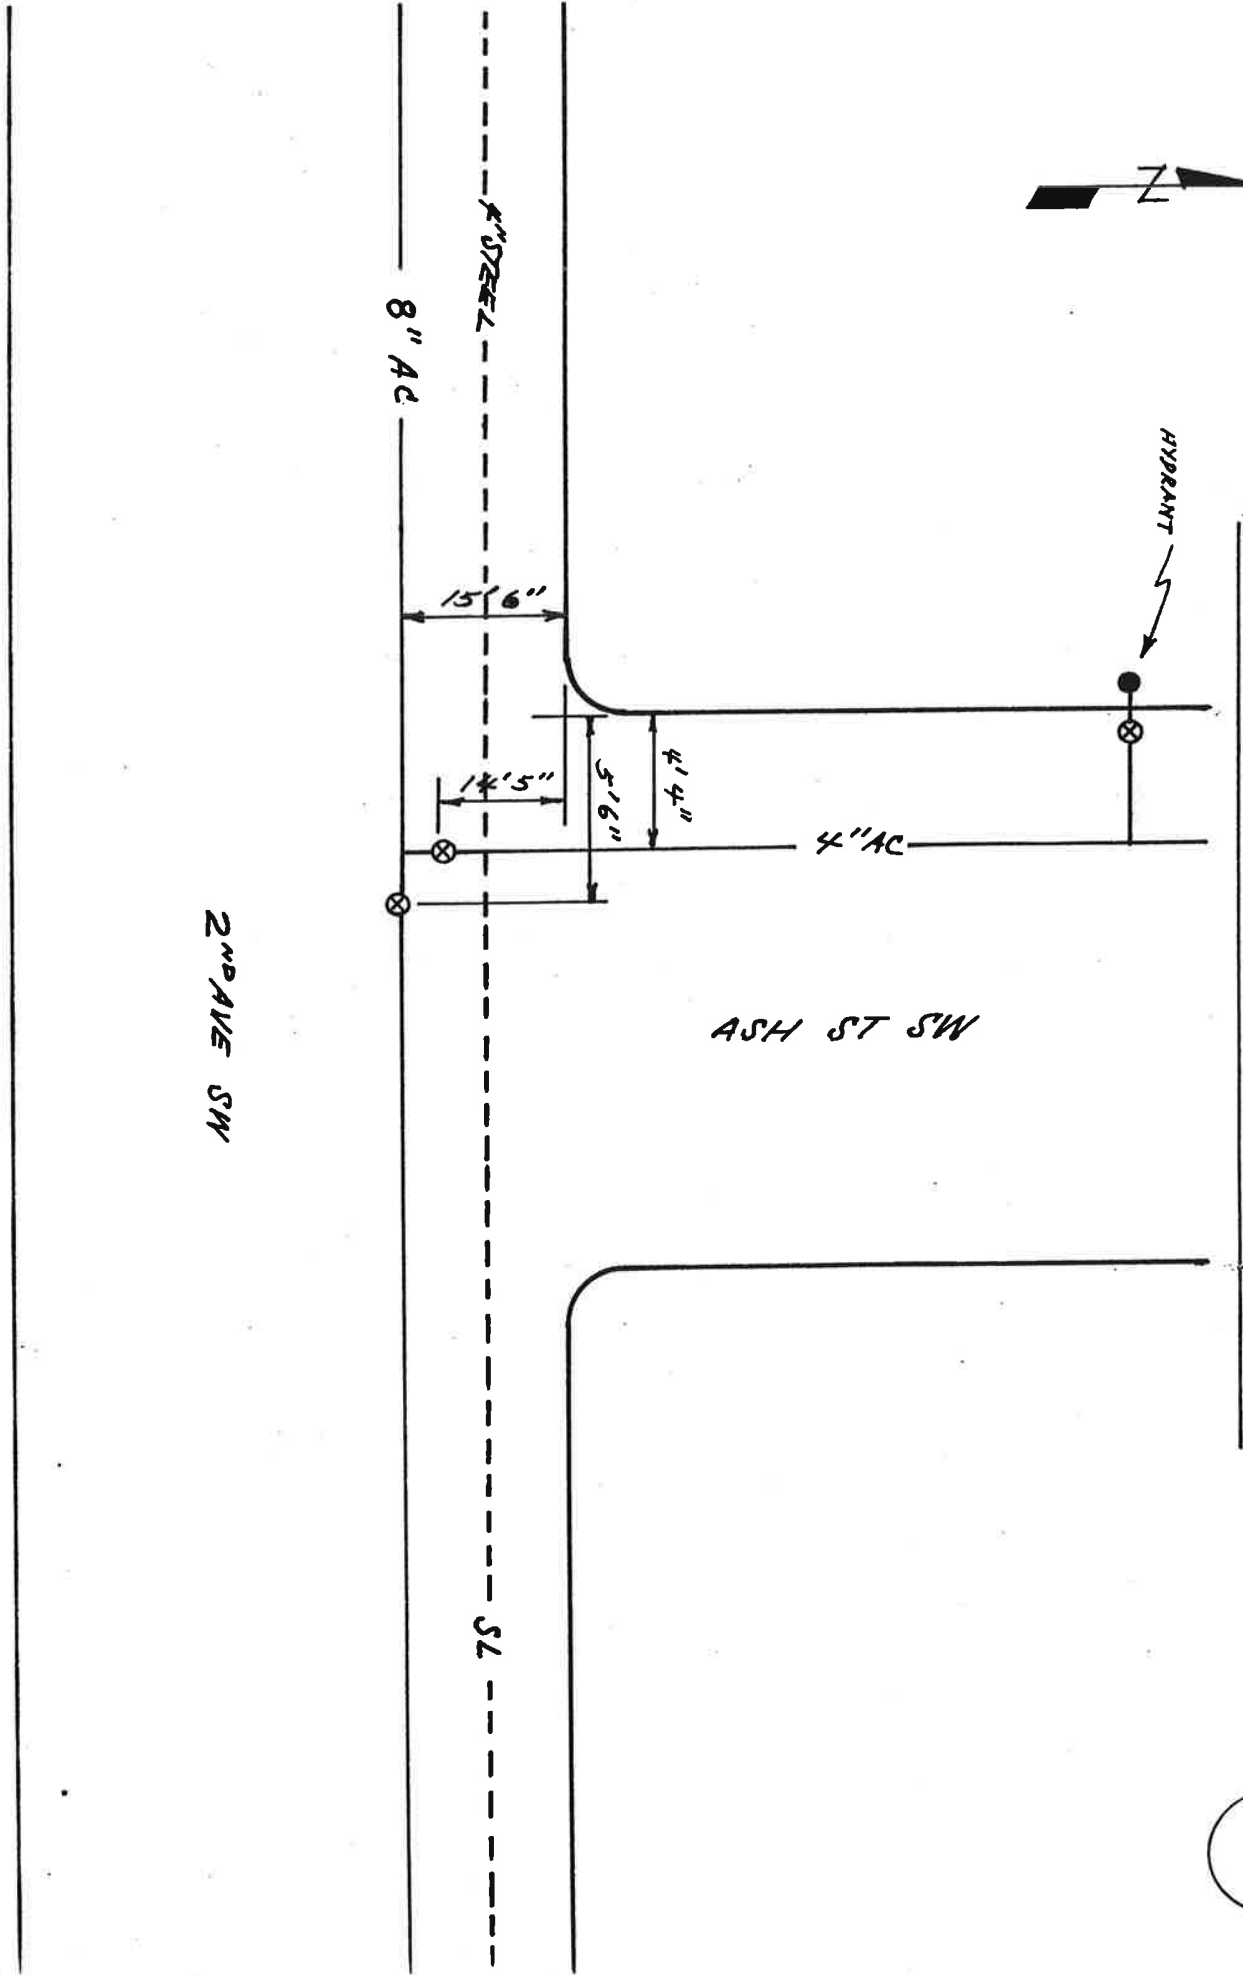

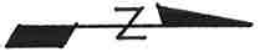

2ND AVE SW / ALLEY BETWEEN ASH / BIRCH SW


ALLEY BETWEEN ASH / BIRCH



4" STEEL

4" STEEL


4" STEEL

2ND AVE SW

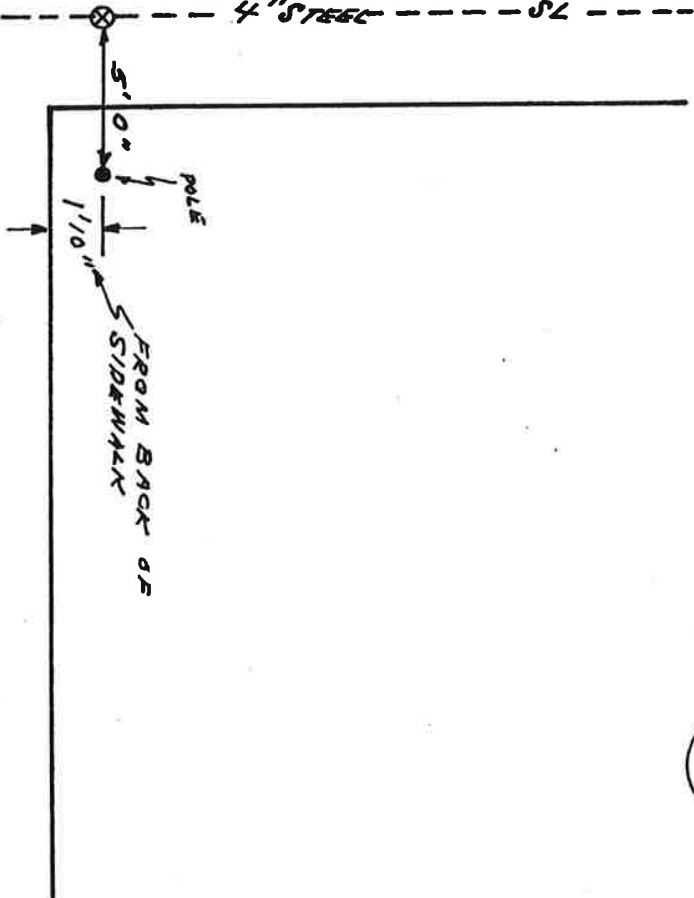

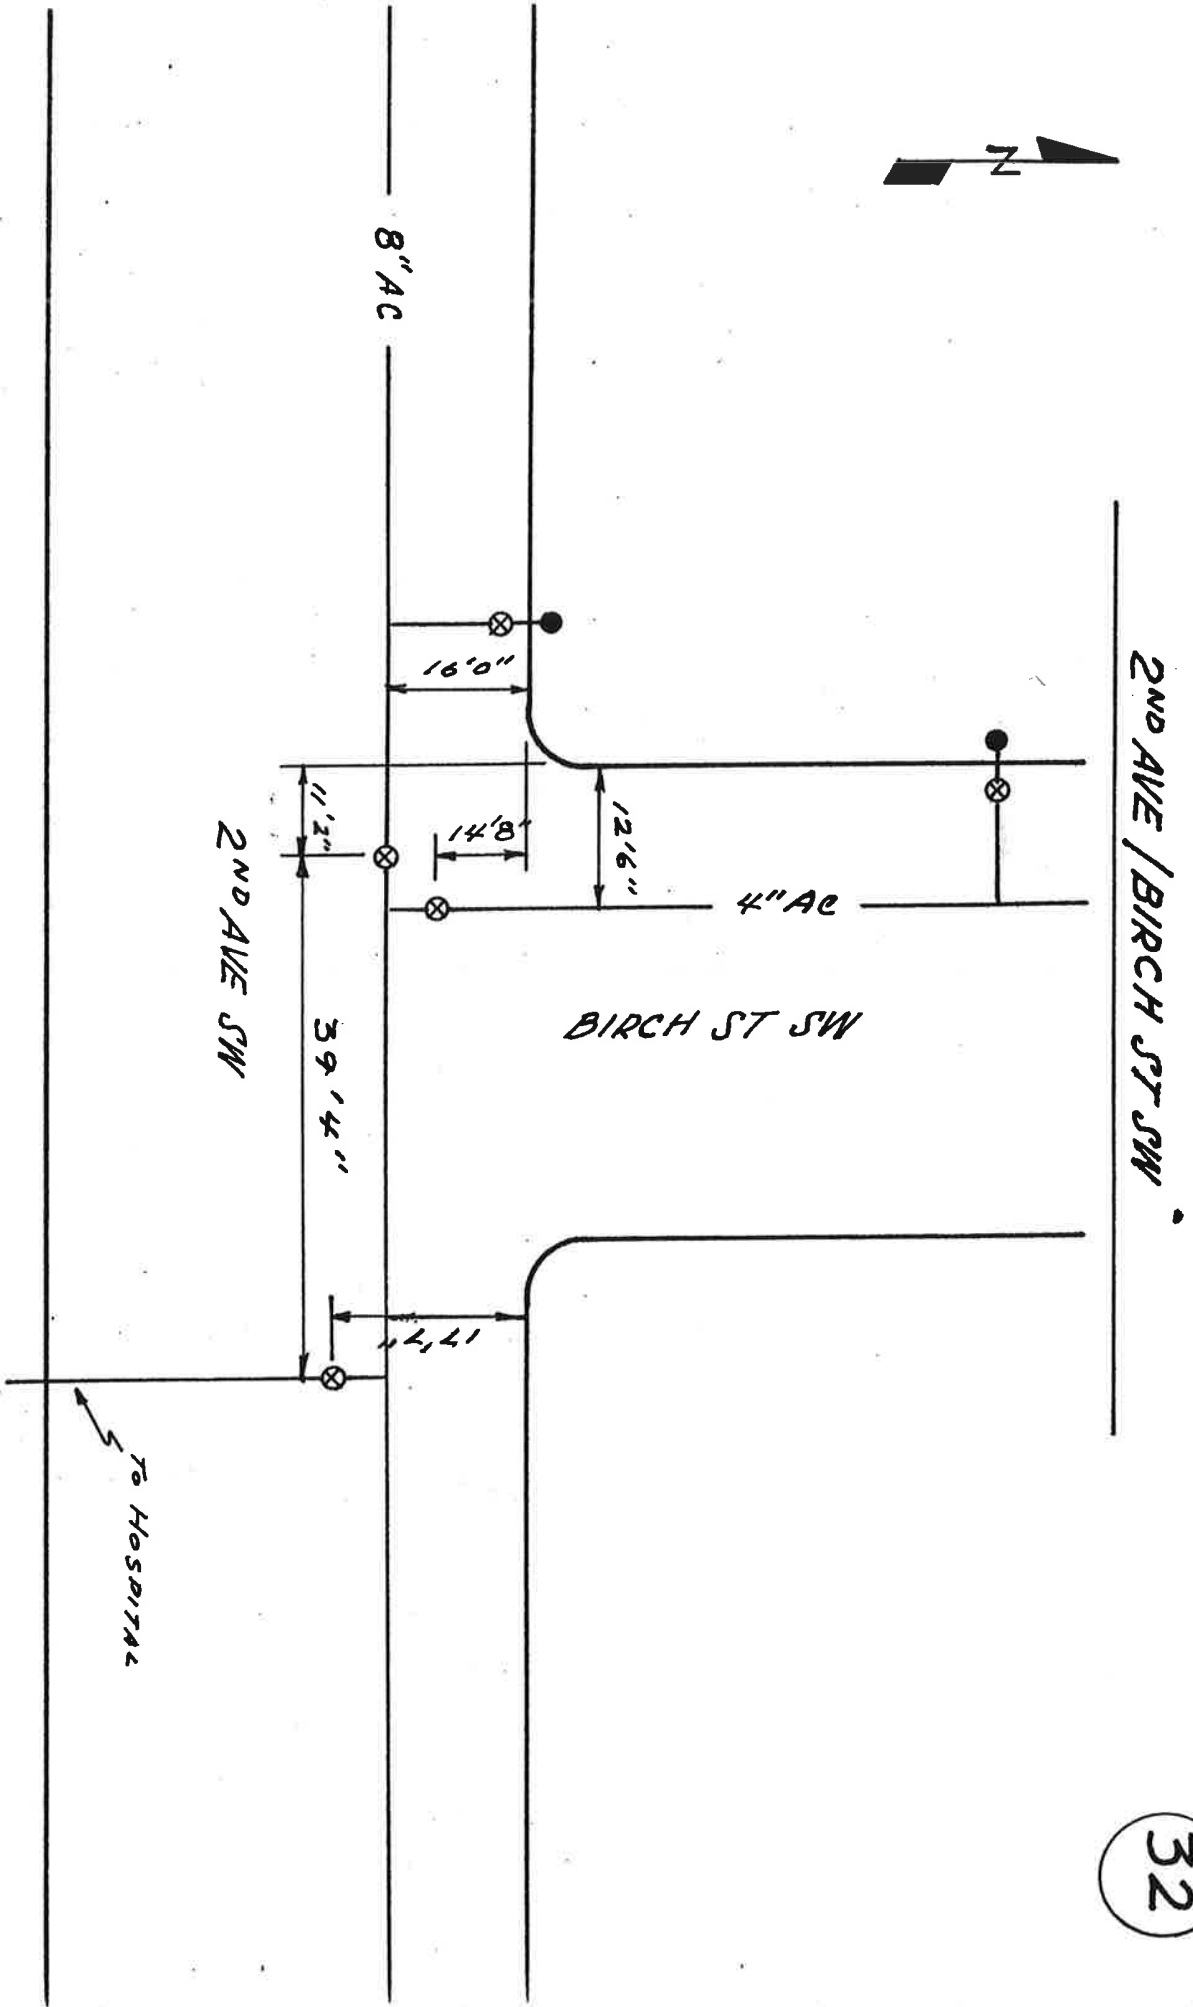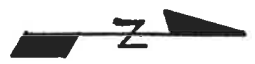



2ND AVE / CHERRY ST SW

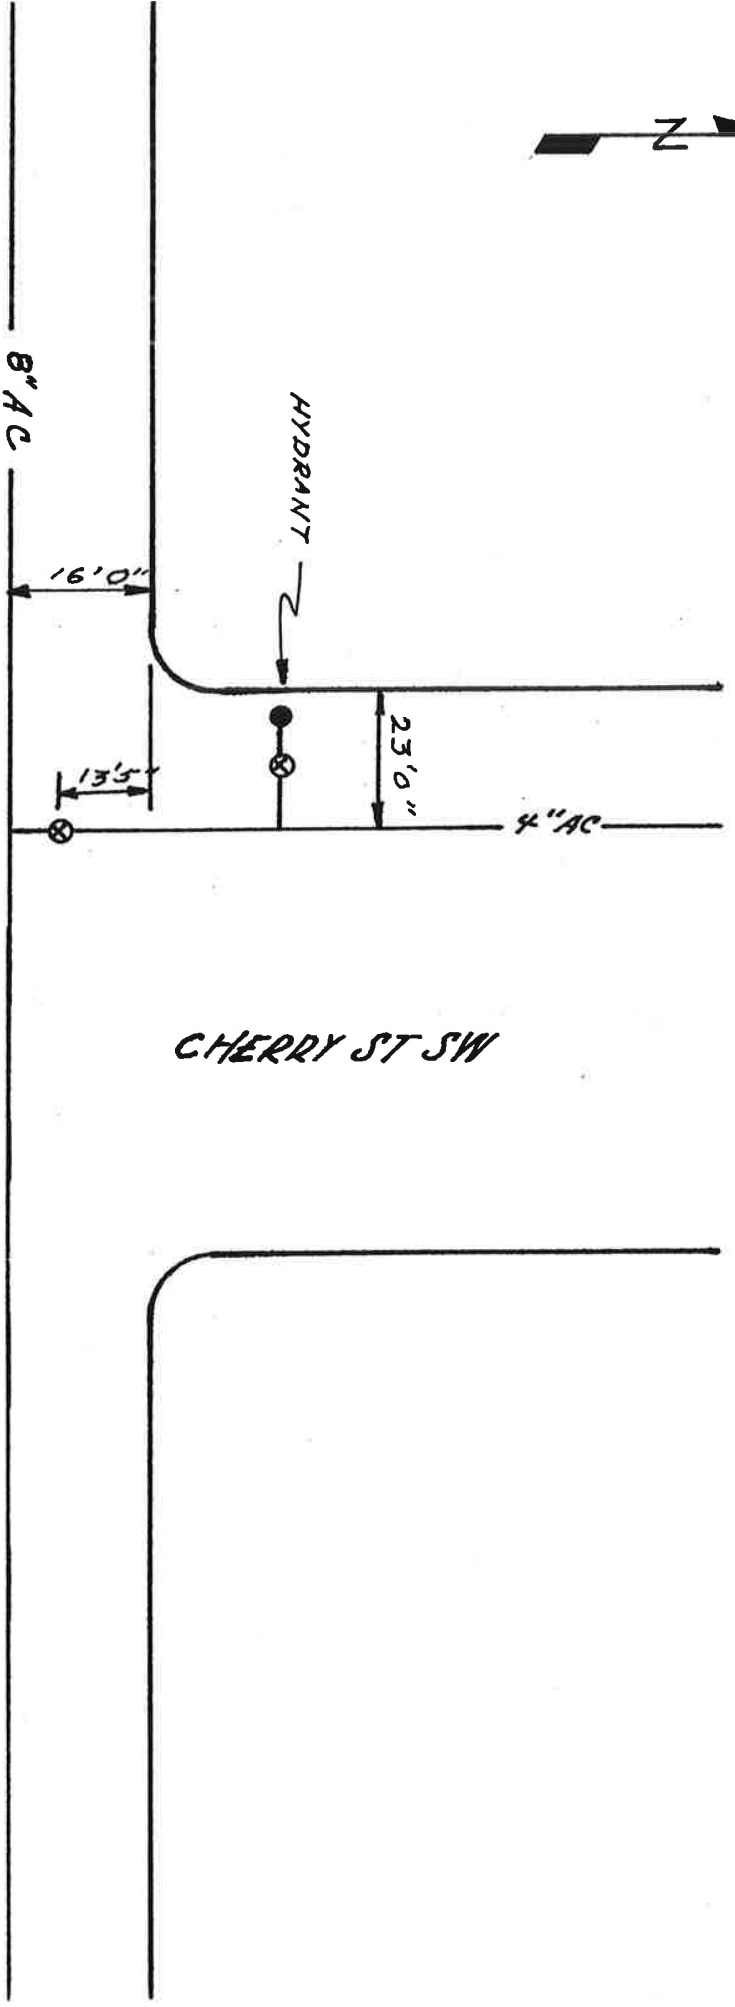



2ND AVE SW

2ND AVE / DOGWOOD ST SW

34

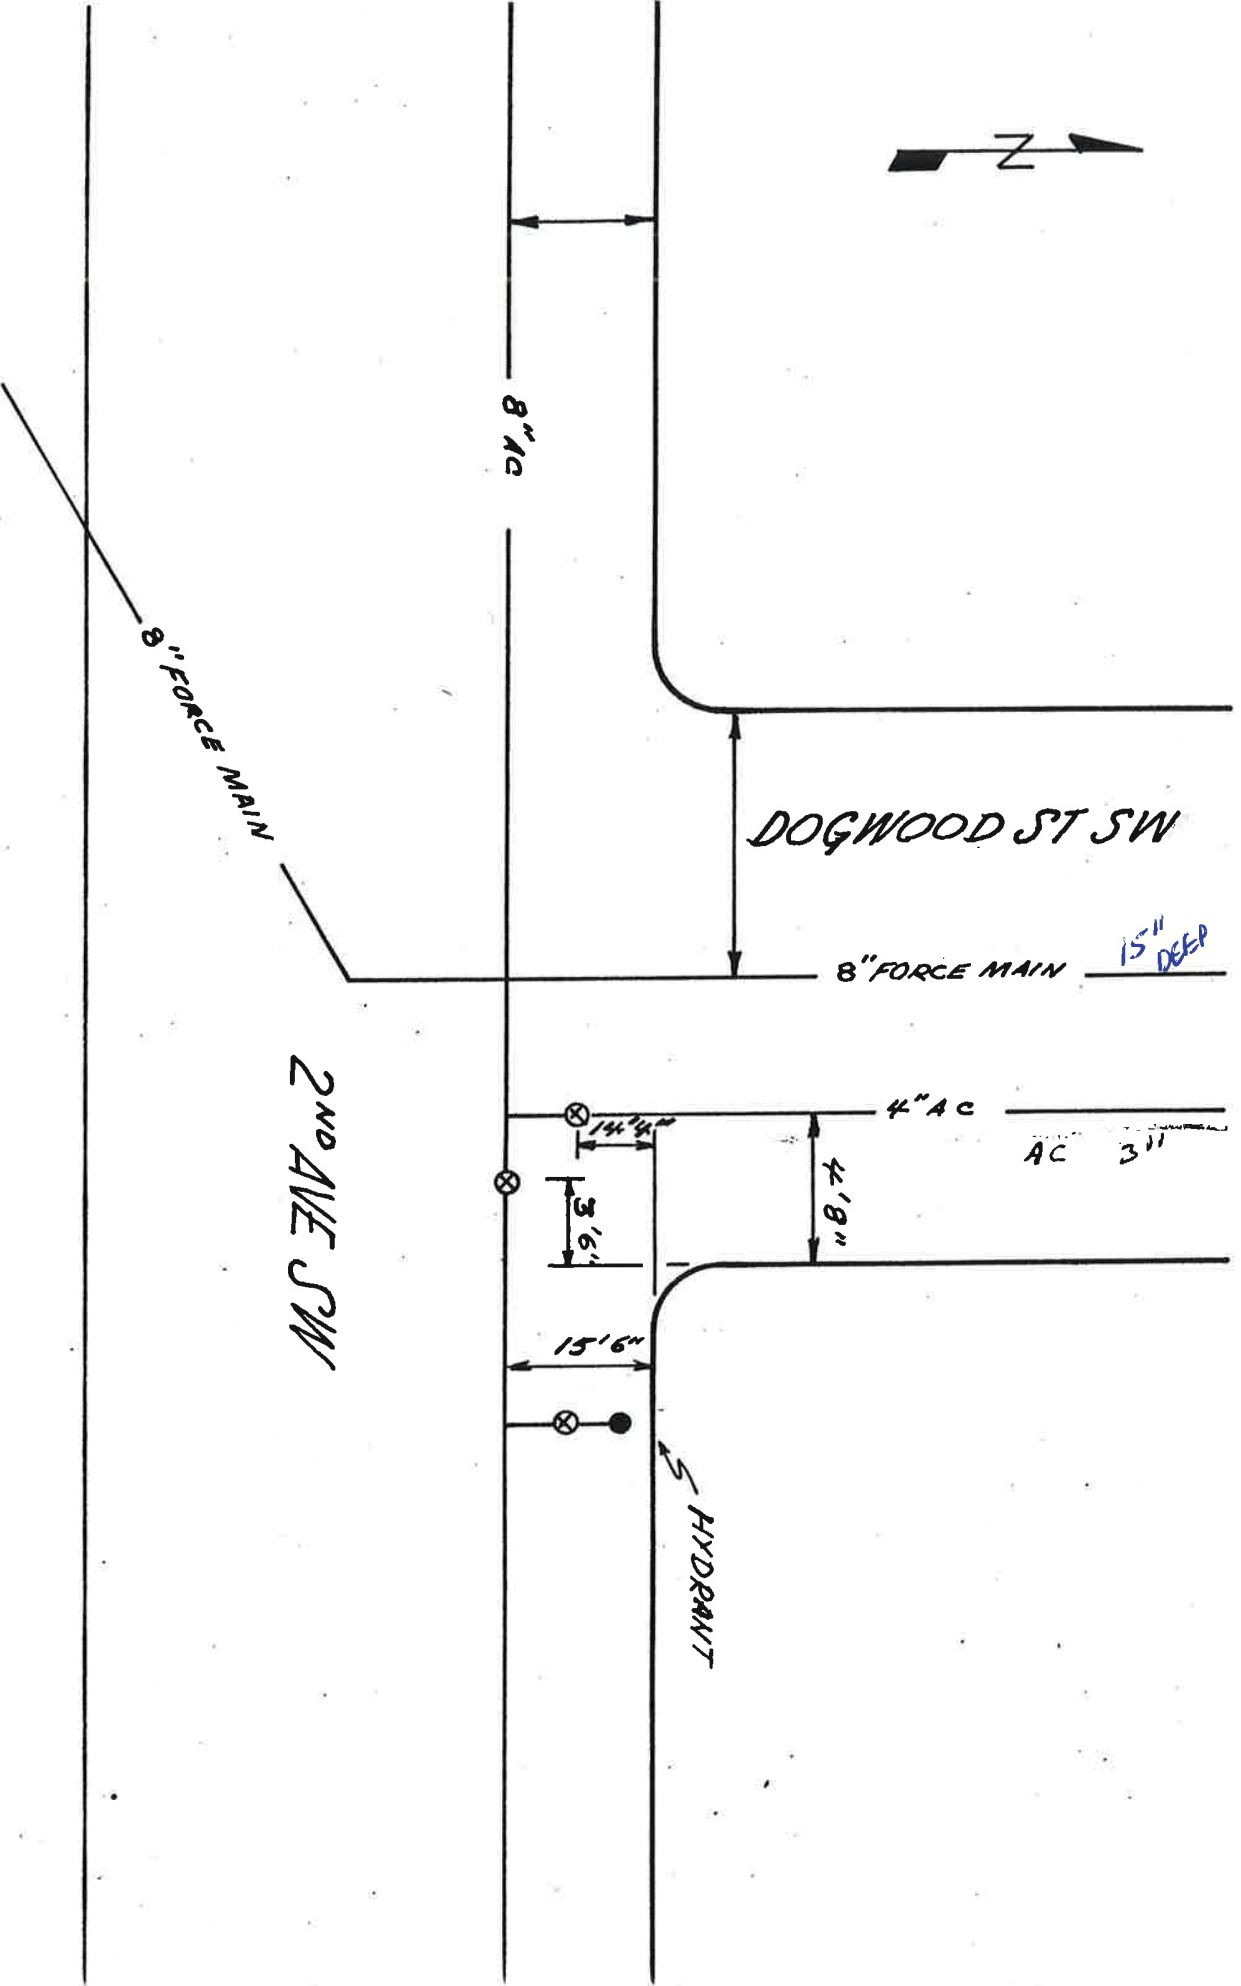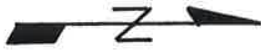


2ND AVE / EVERGREEN ST SW

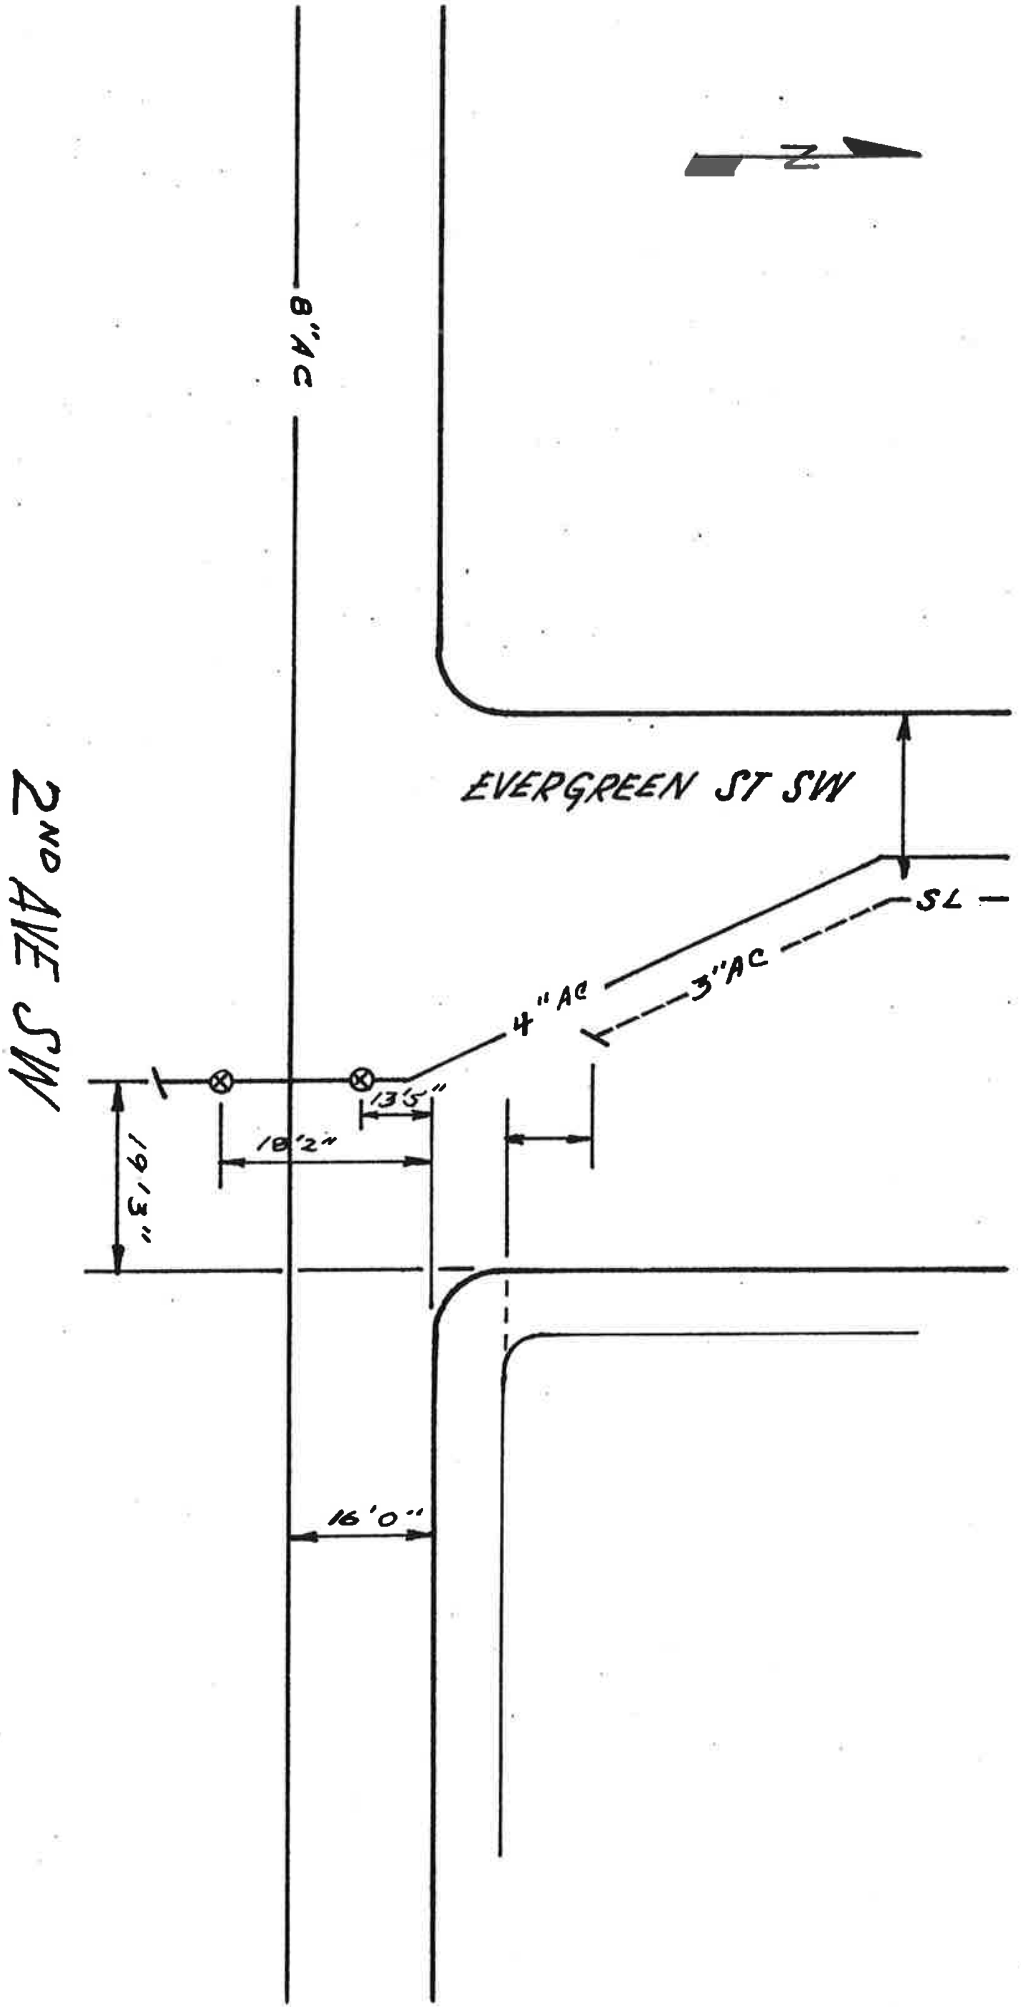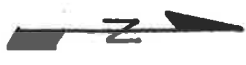

2ND AVE / FIR ST SW

36

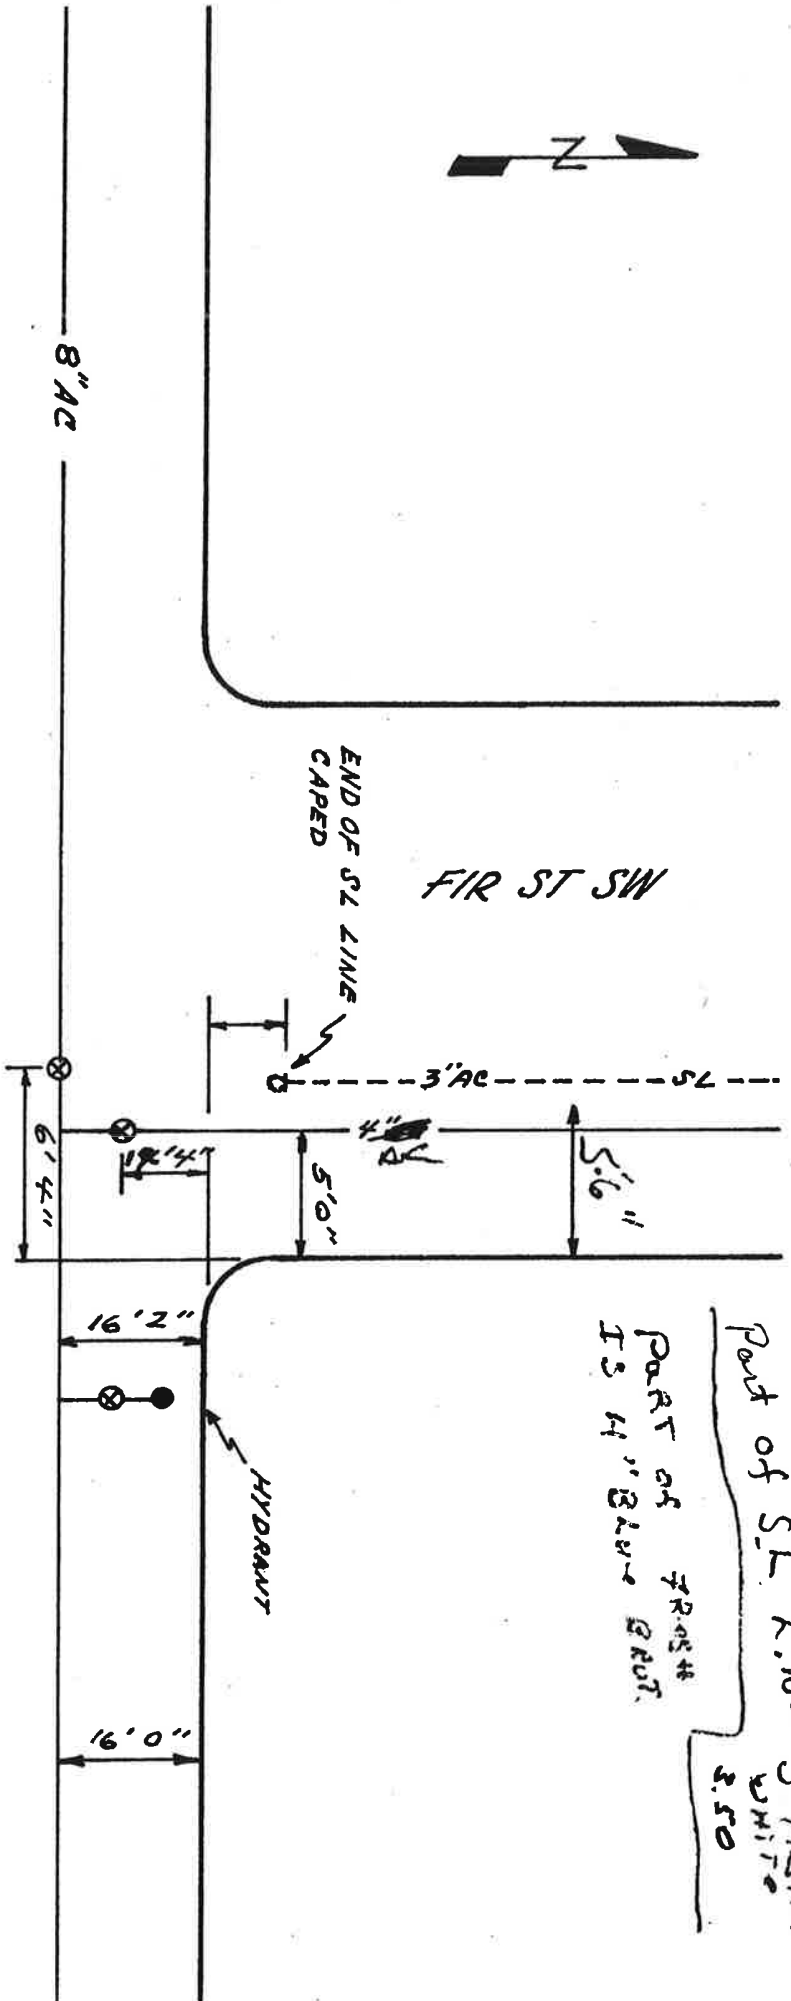

2ND AVE SW




2ND AVE SW / GINKGO ST

GINKGO ST NW

GINKGO ST SW


2ND AVE SW

8" AC

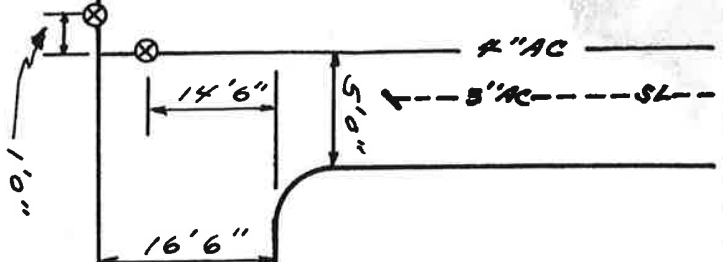


2ND AVE / HEMLOCK ST SW

38

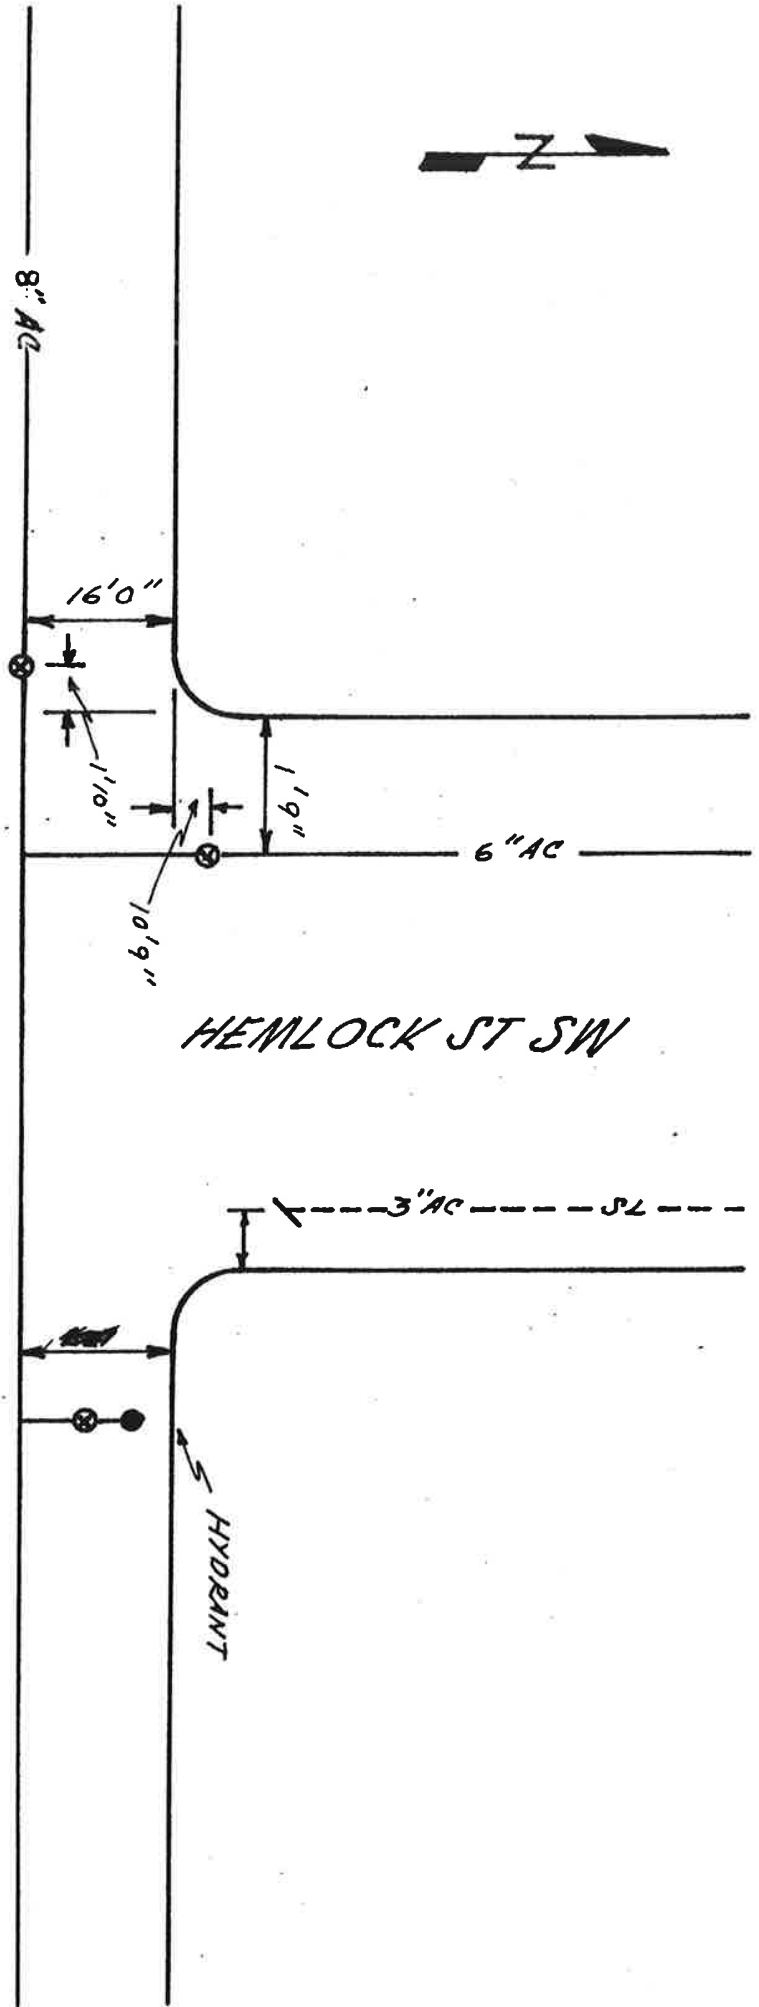


2ND AVE SW

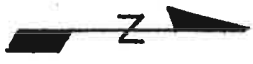


2ND AVE / JUNIPER ST SW

JUNIPER ST SW

2ND AVE SW

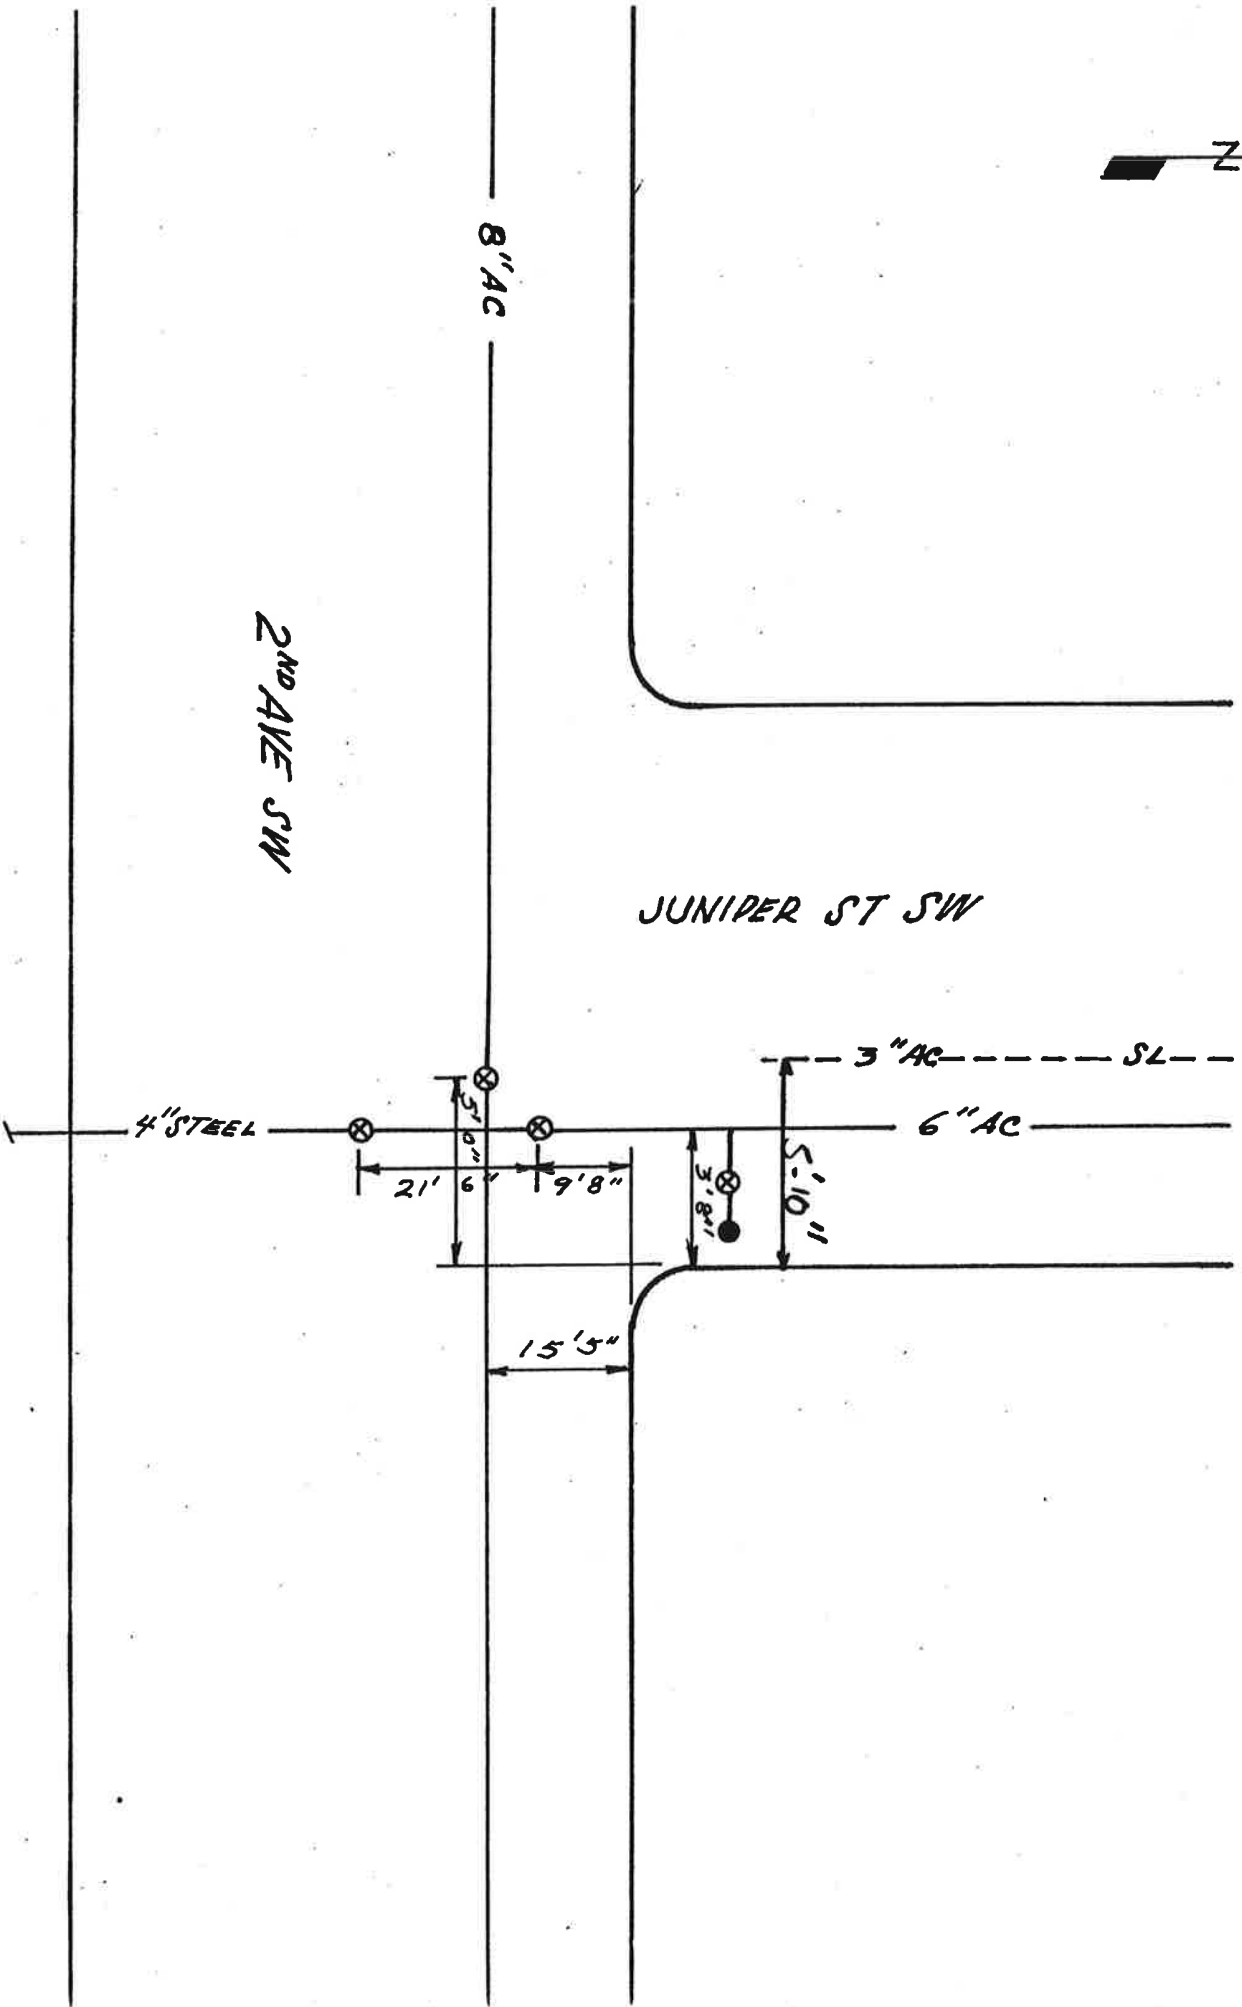

2ND AVE / MAPLE ST SW

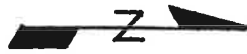

8" AC

2ND AVE SW

WELL HOUSE
NO. 3

FLOW METER


MAPLE ST SW


2" PLASTIC

10' 0"

16' 9"

40

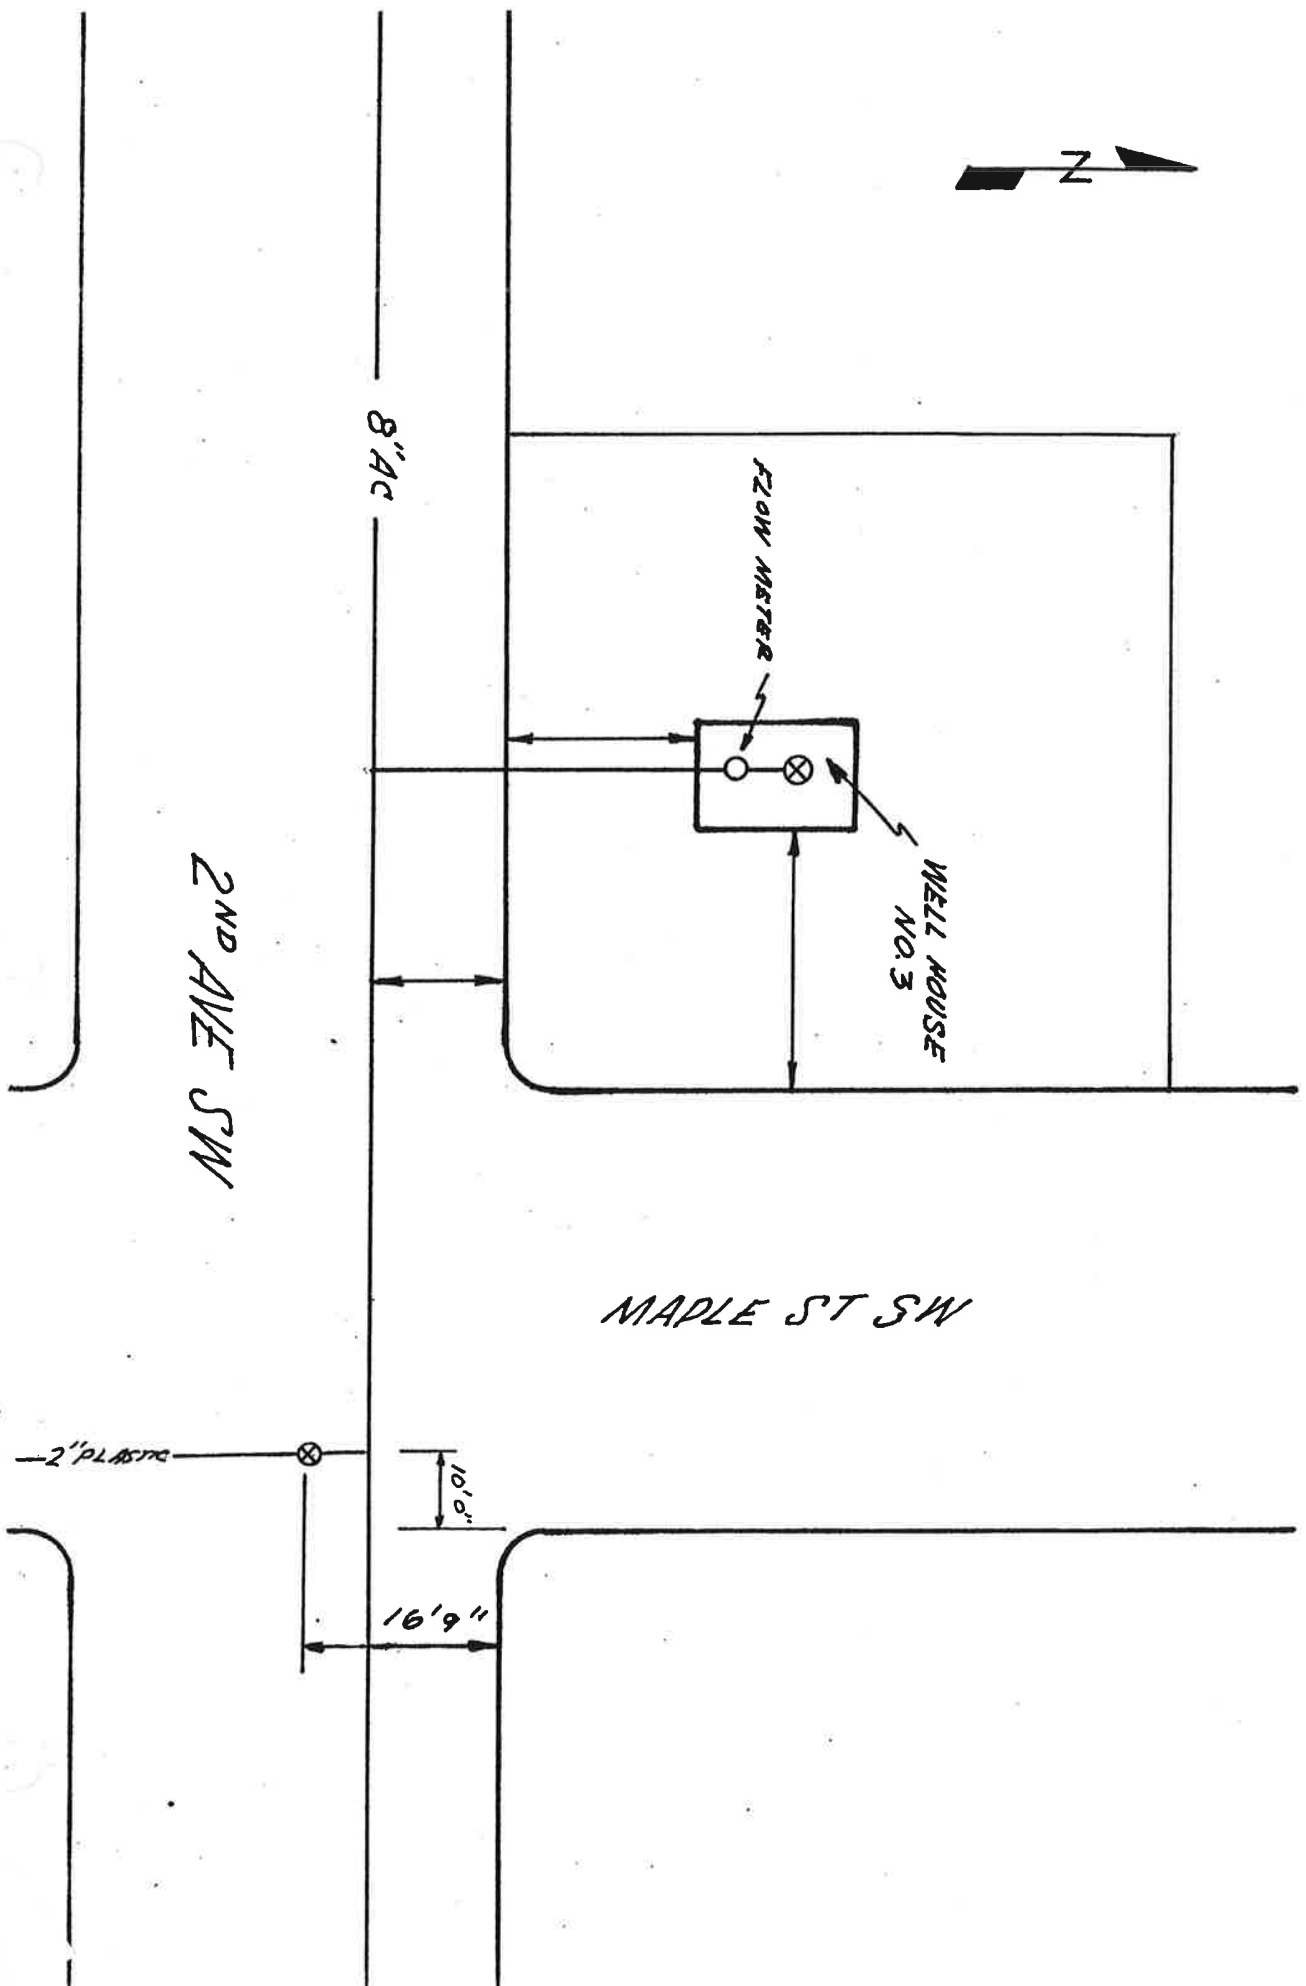


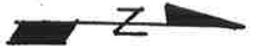


MAIN AVE E / DIVISION ST. NE ^{NW}

DIVISION ST. N

MAIN AVE. E.

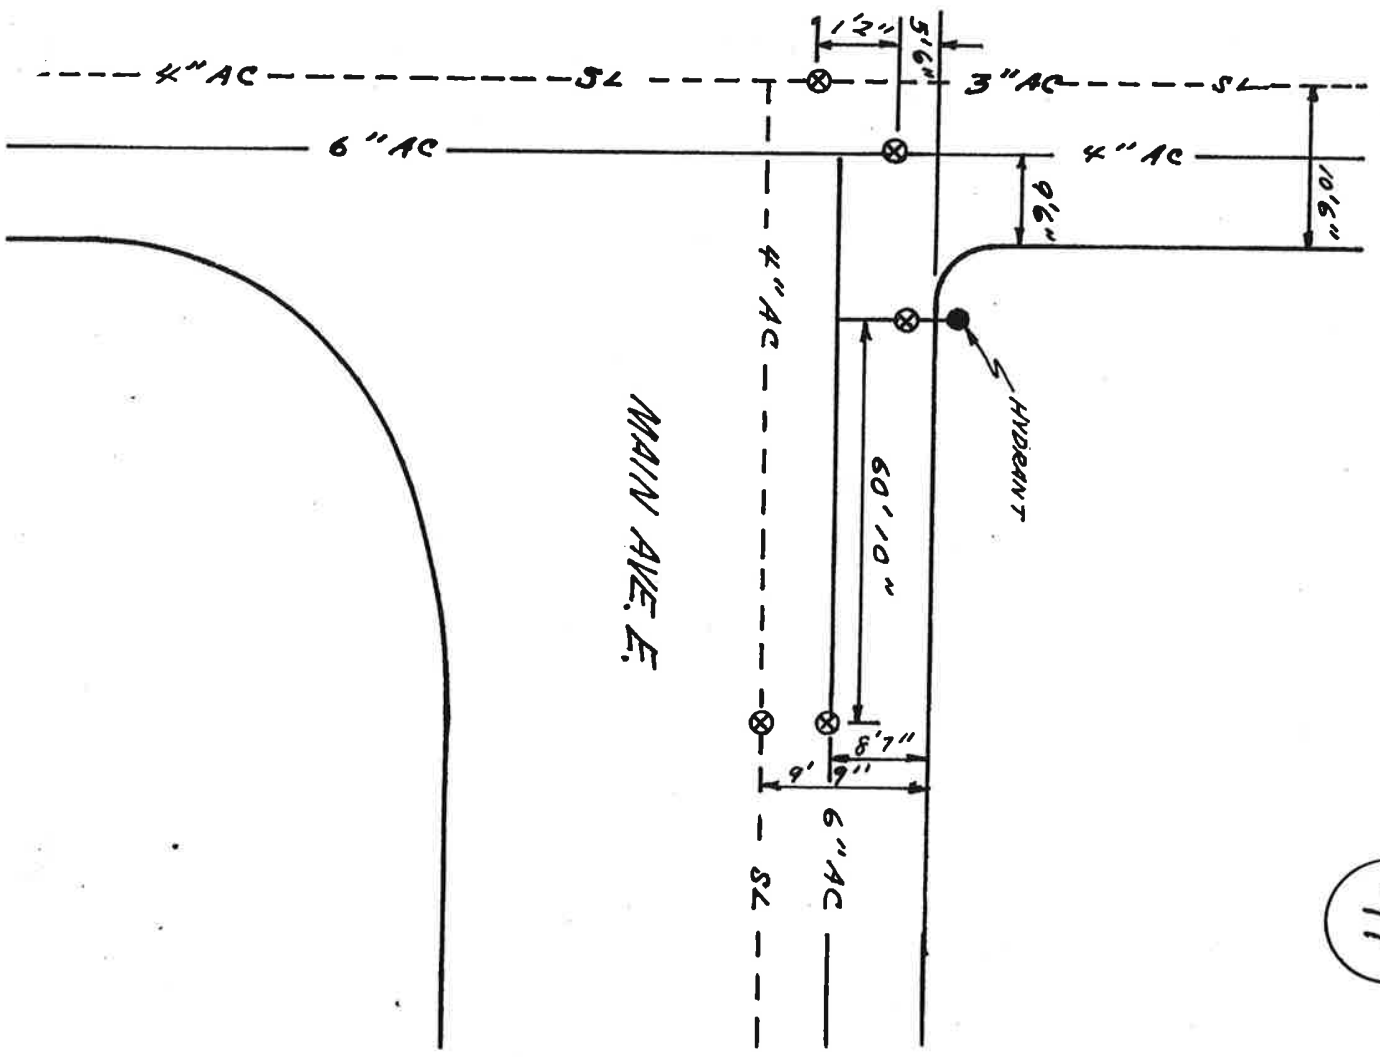


41

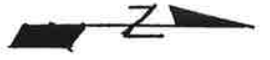


MAIN AVE E / ASTER ST NE

ASTER ST NE

MAIN AVE E

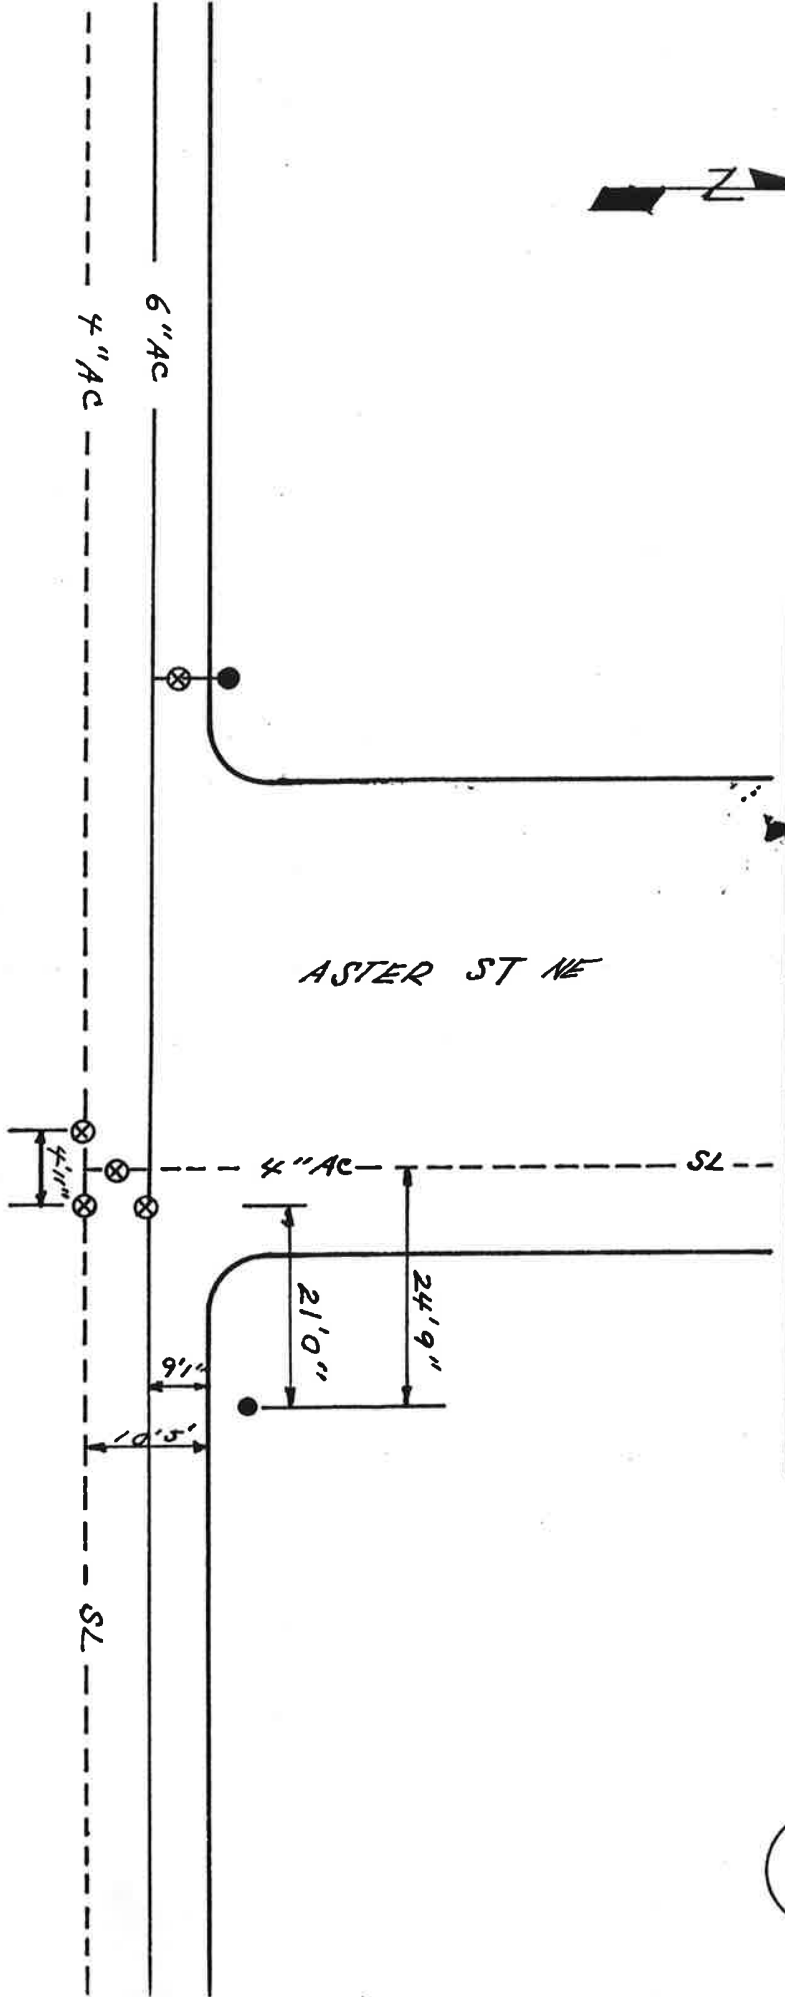


42

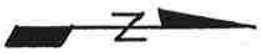

MAIN AVE E / WHERE BUTTERCUP ST NE SHOULD BE

43

210
E MAIN

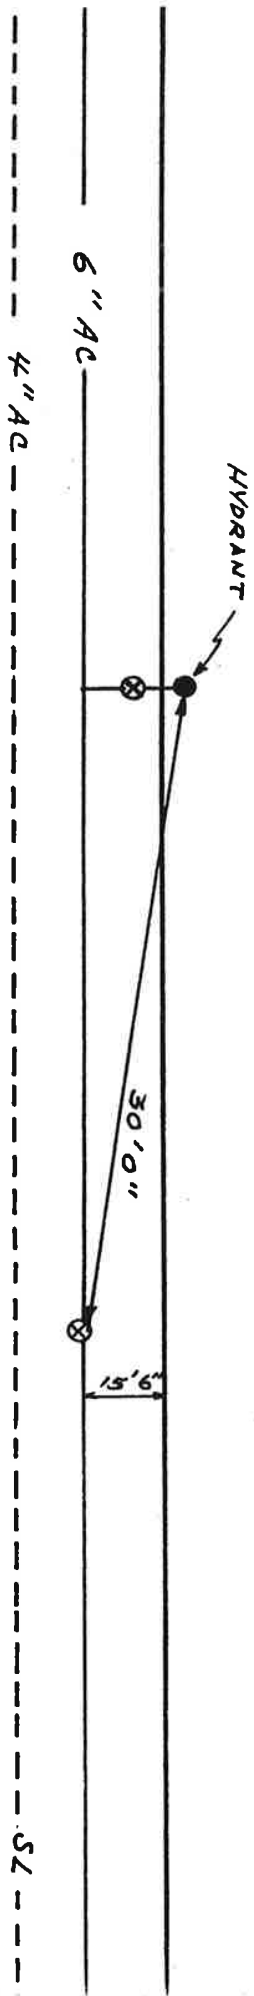


MAIN AVE E



CANNA ST SE

CANNA ST NE

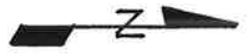

MAIN AVE E / CANNA ST, DAISY ST

328 MAIN AVE E
HARDWARE

6" AC

4" AC

S.L. DRAIN VALVE

MAIN AVE E

2'10"


4'2"

S.L.

DAISY ST NE

DAISY ST SE

44

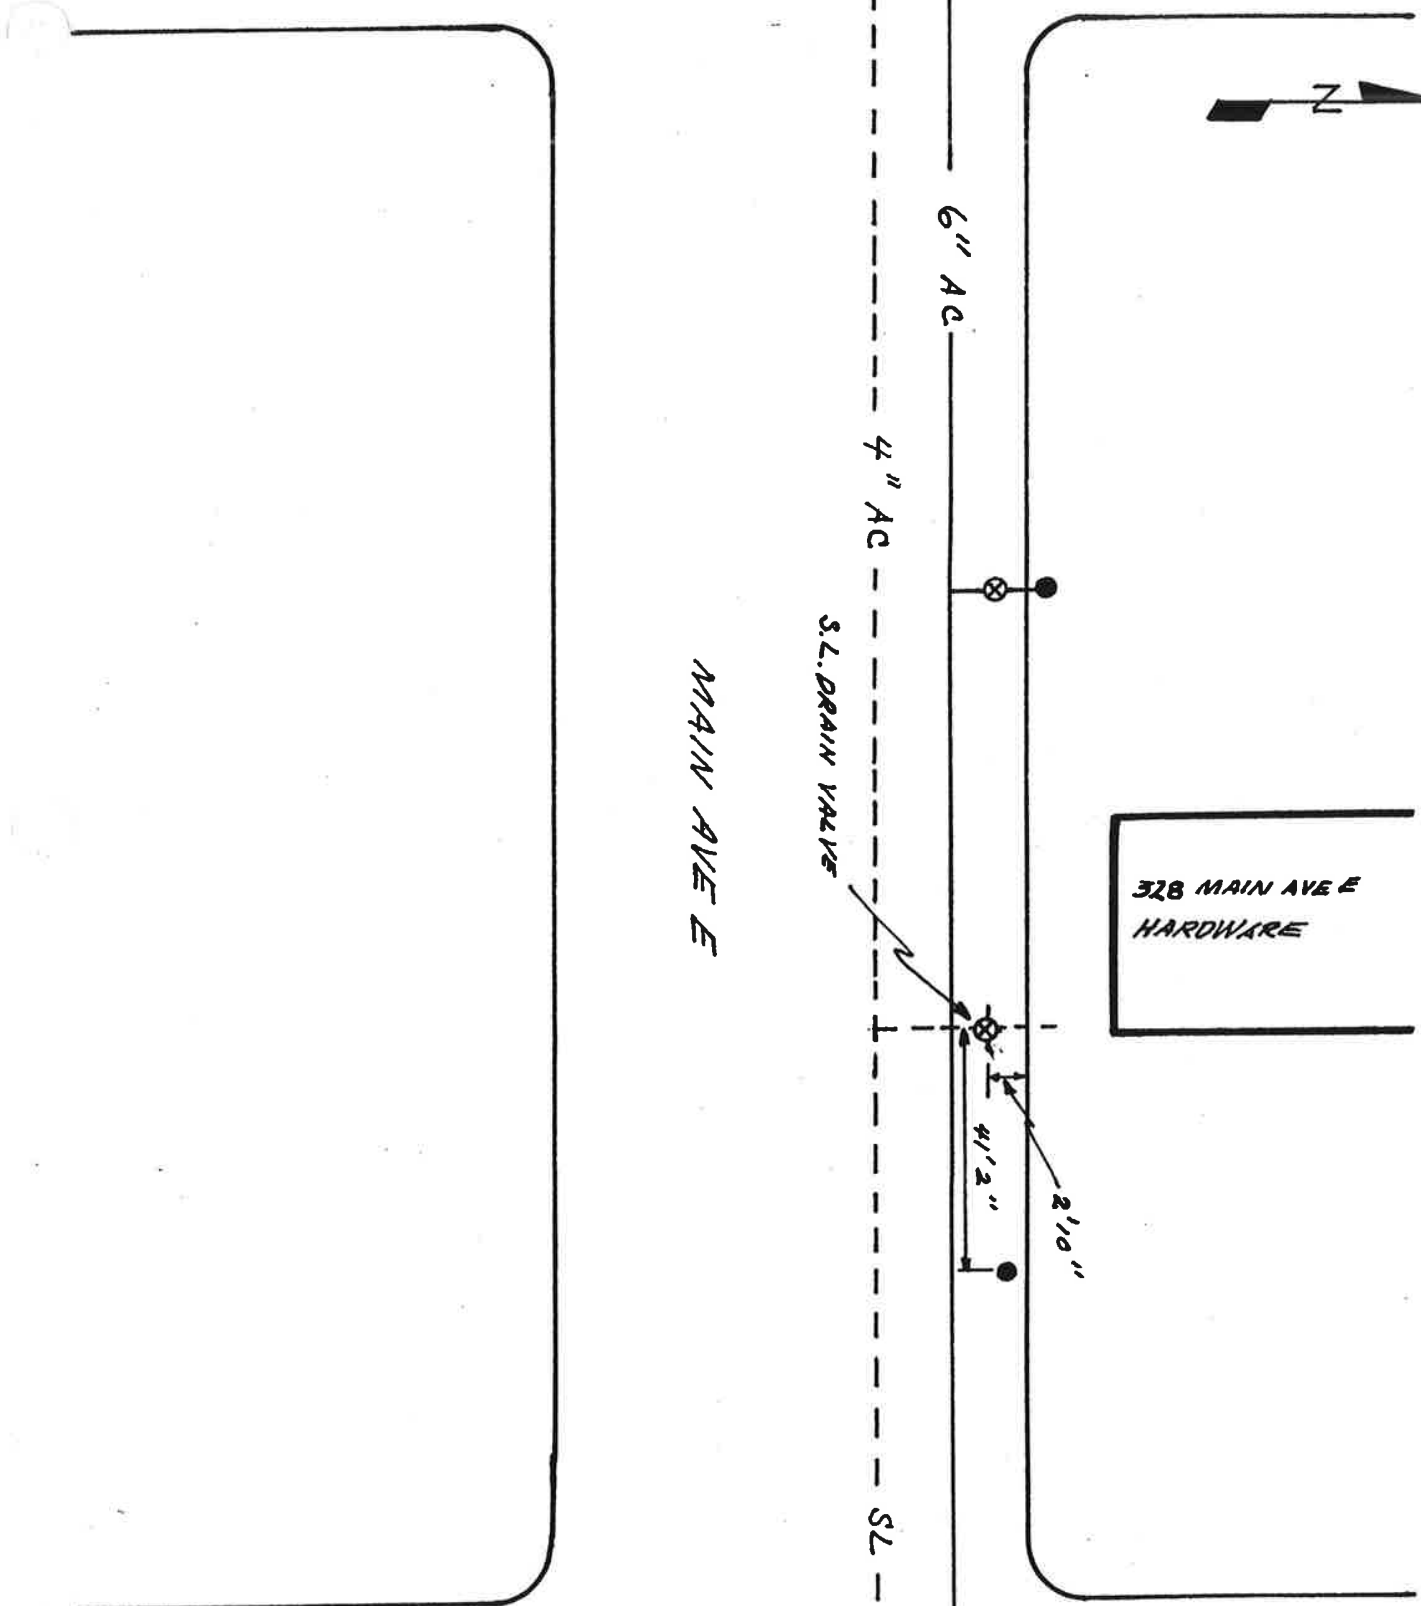


4-27-84
Check measurements

10" x 2" PVC cap

N.

Main Wains

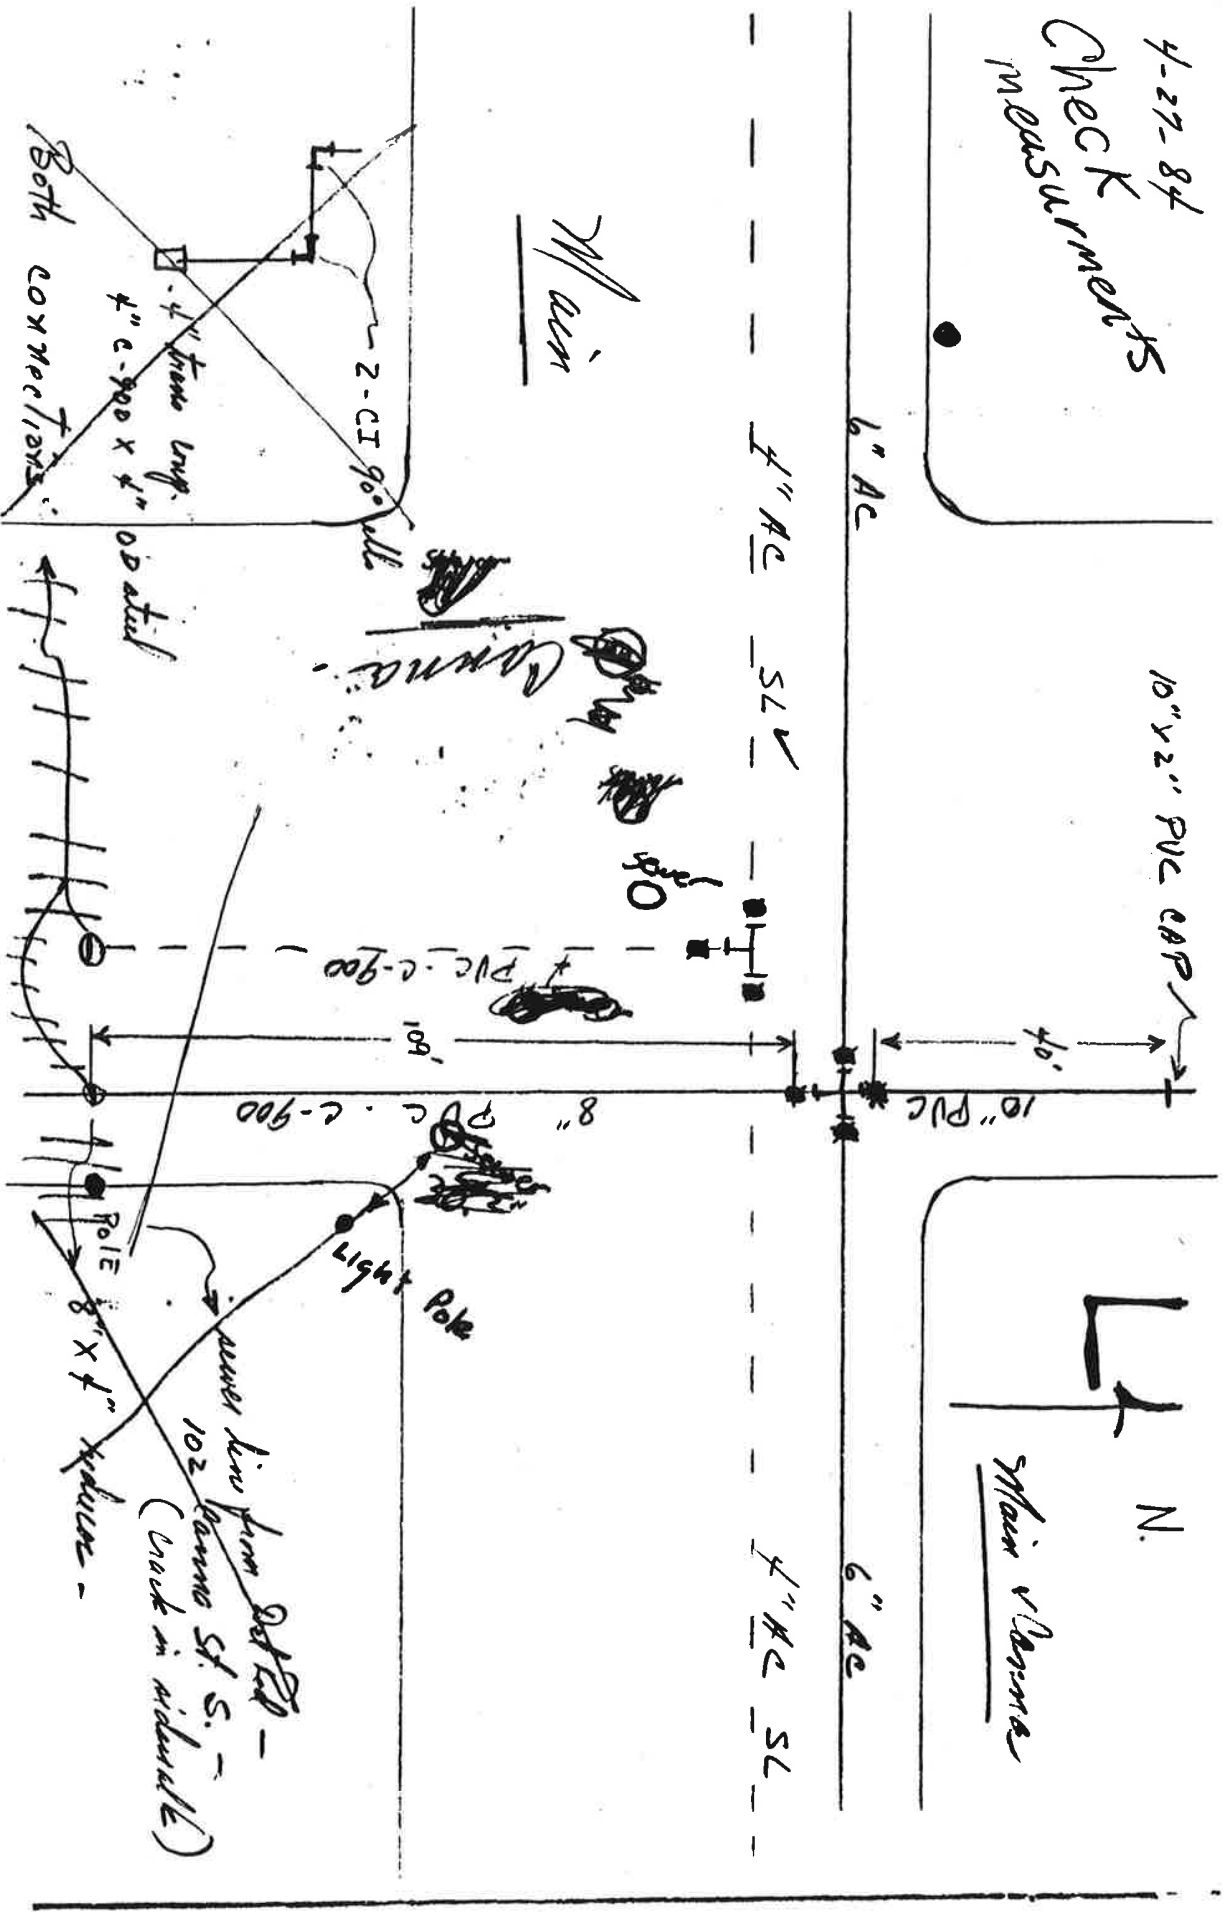

Main

Both connections

4" x 4" iron pipe
4" c-900 x 4"

2-CI 90° ell

OD tail



8" PVC c-900


8" PVC c-900

Light Pole


Power line from 102 Paines St. S.
(back in sidewalk)


Pole
8" x 4" poles

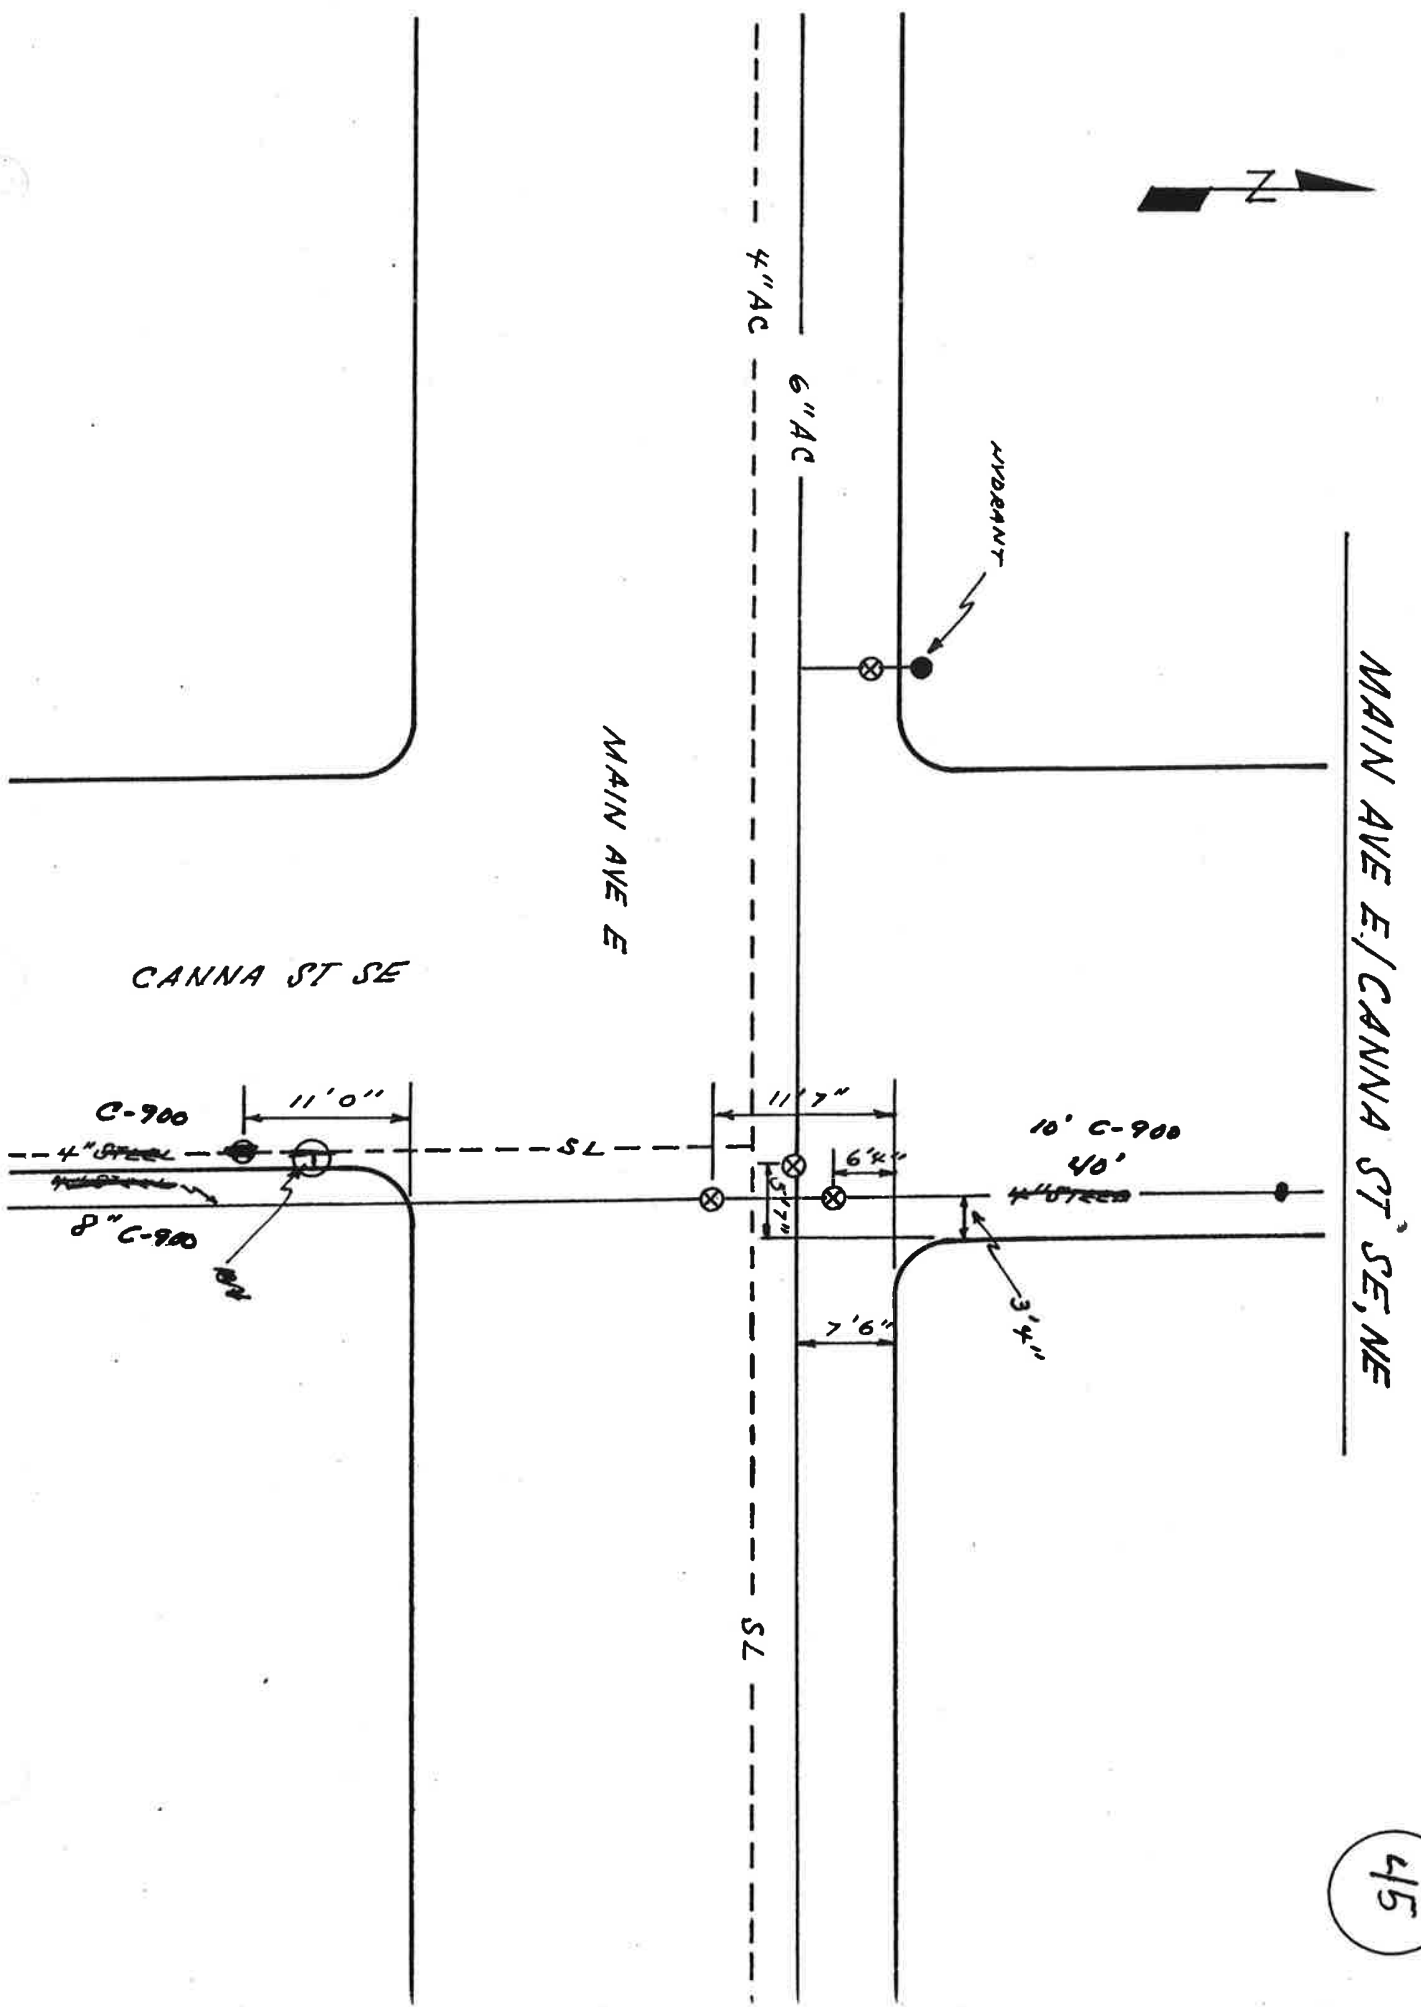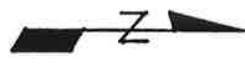

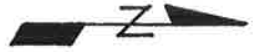

MAIN AVE E / DAISY ST SE, NE

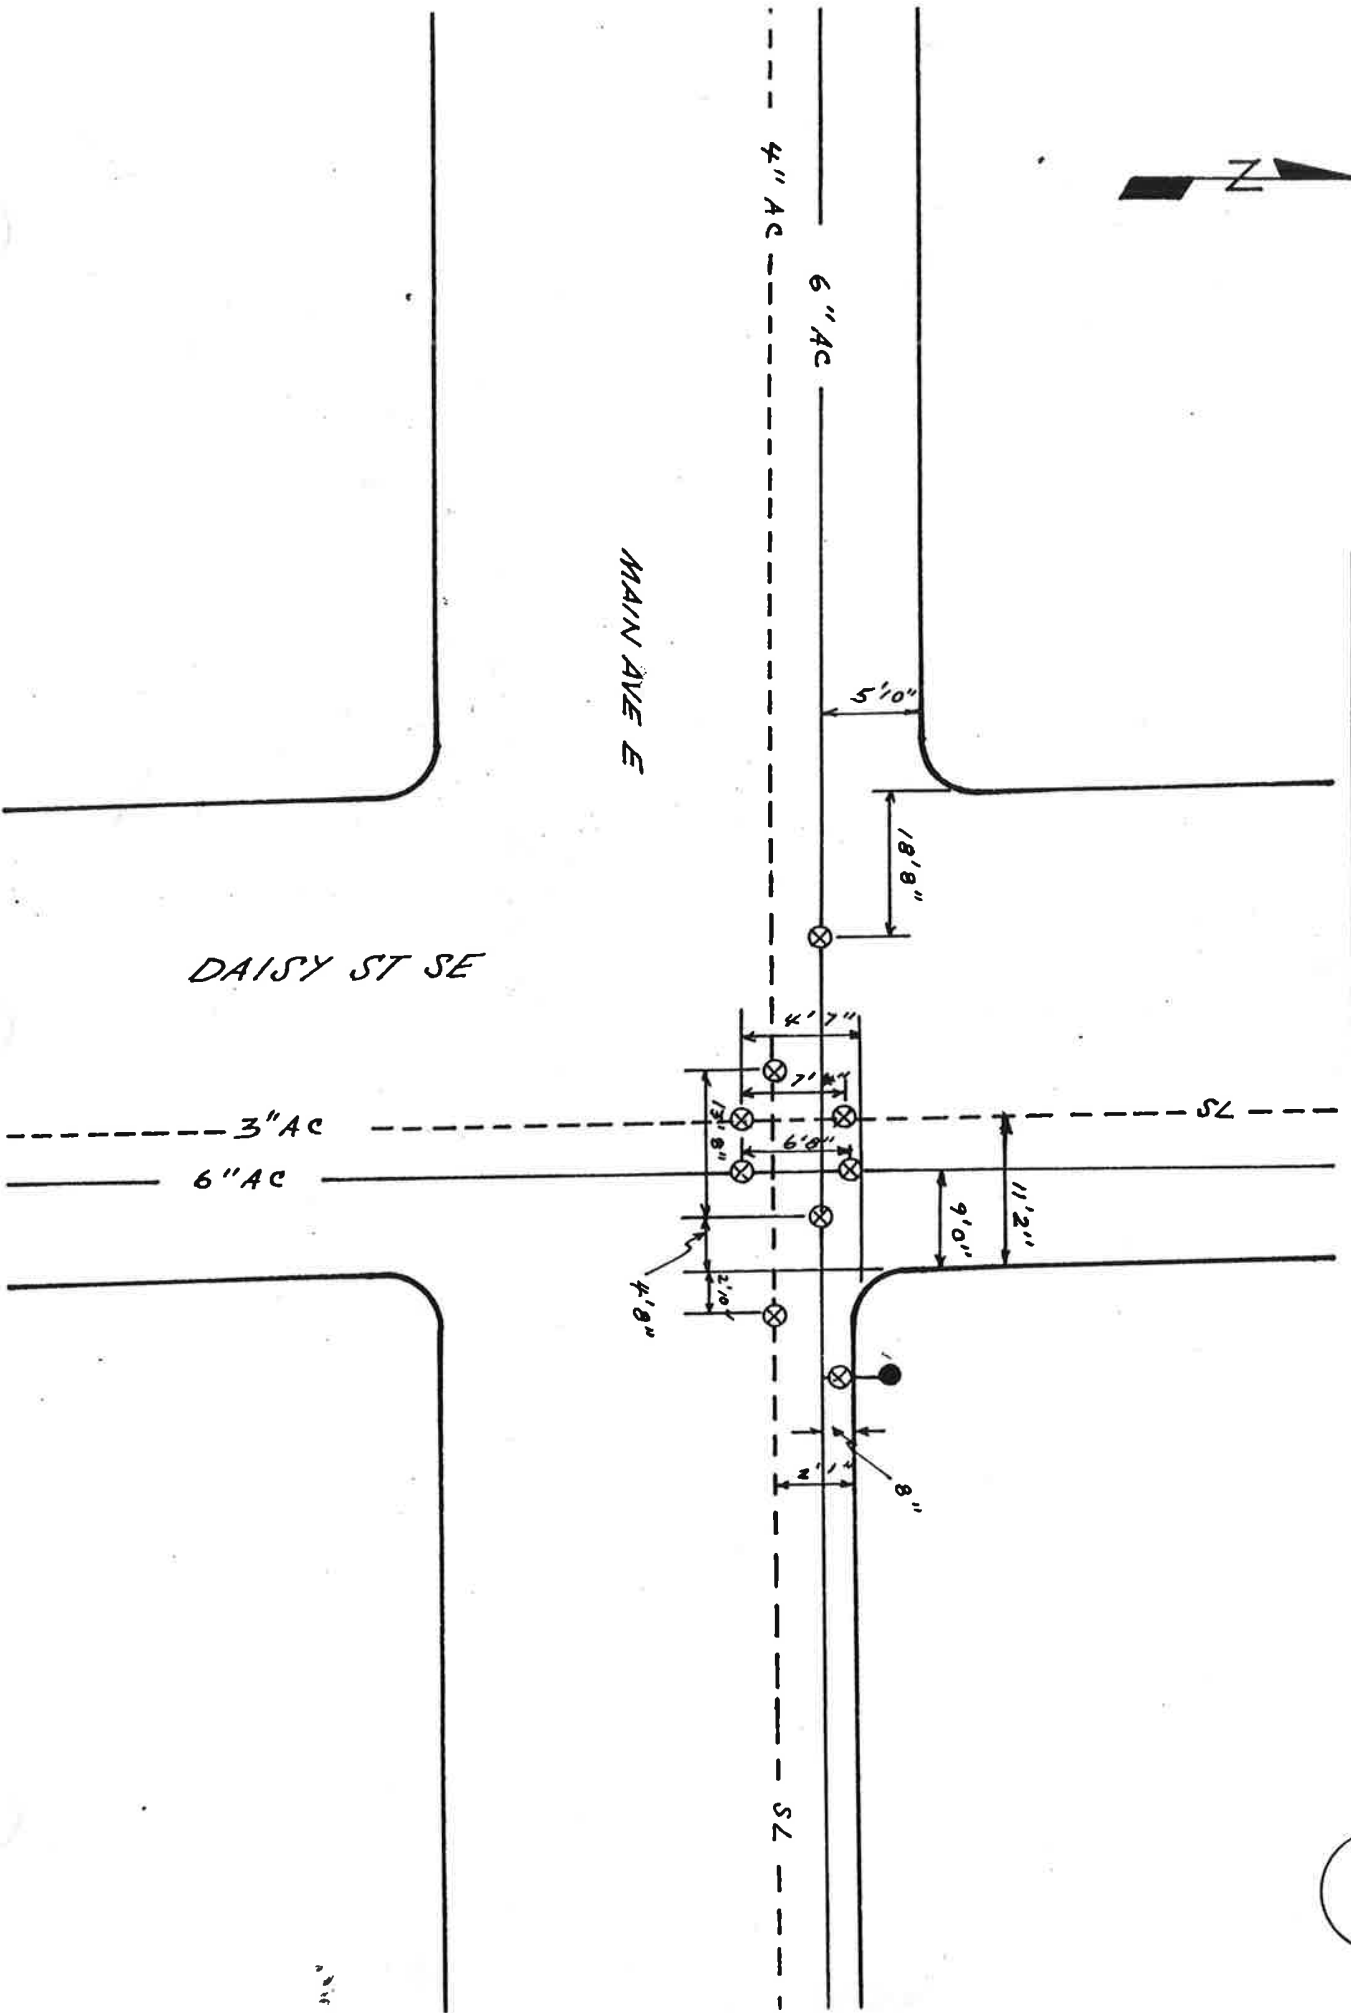

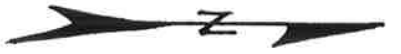


MAIN AVE. E / ELDER ST. S.E.

477

MAIN AVE. EAST

ELDER ST. S.E.

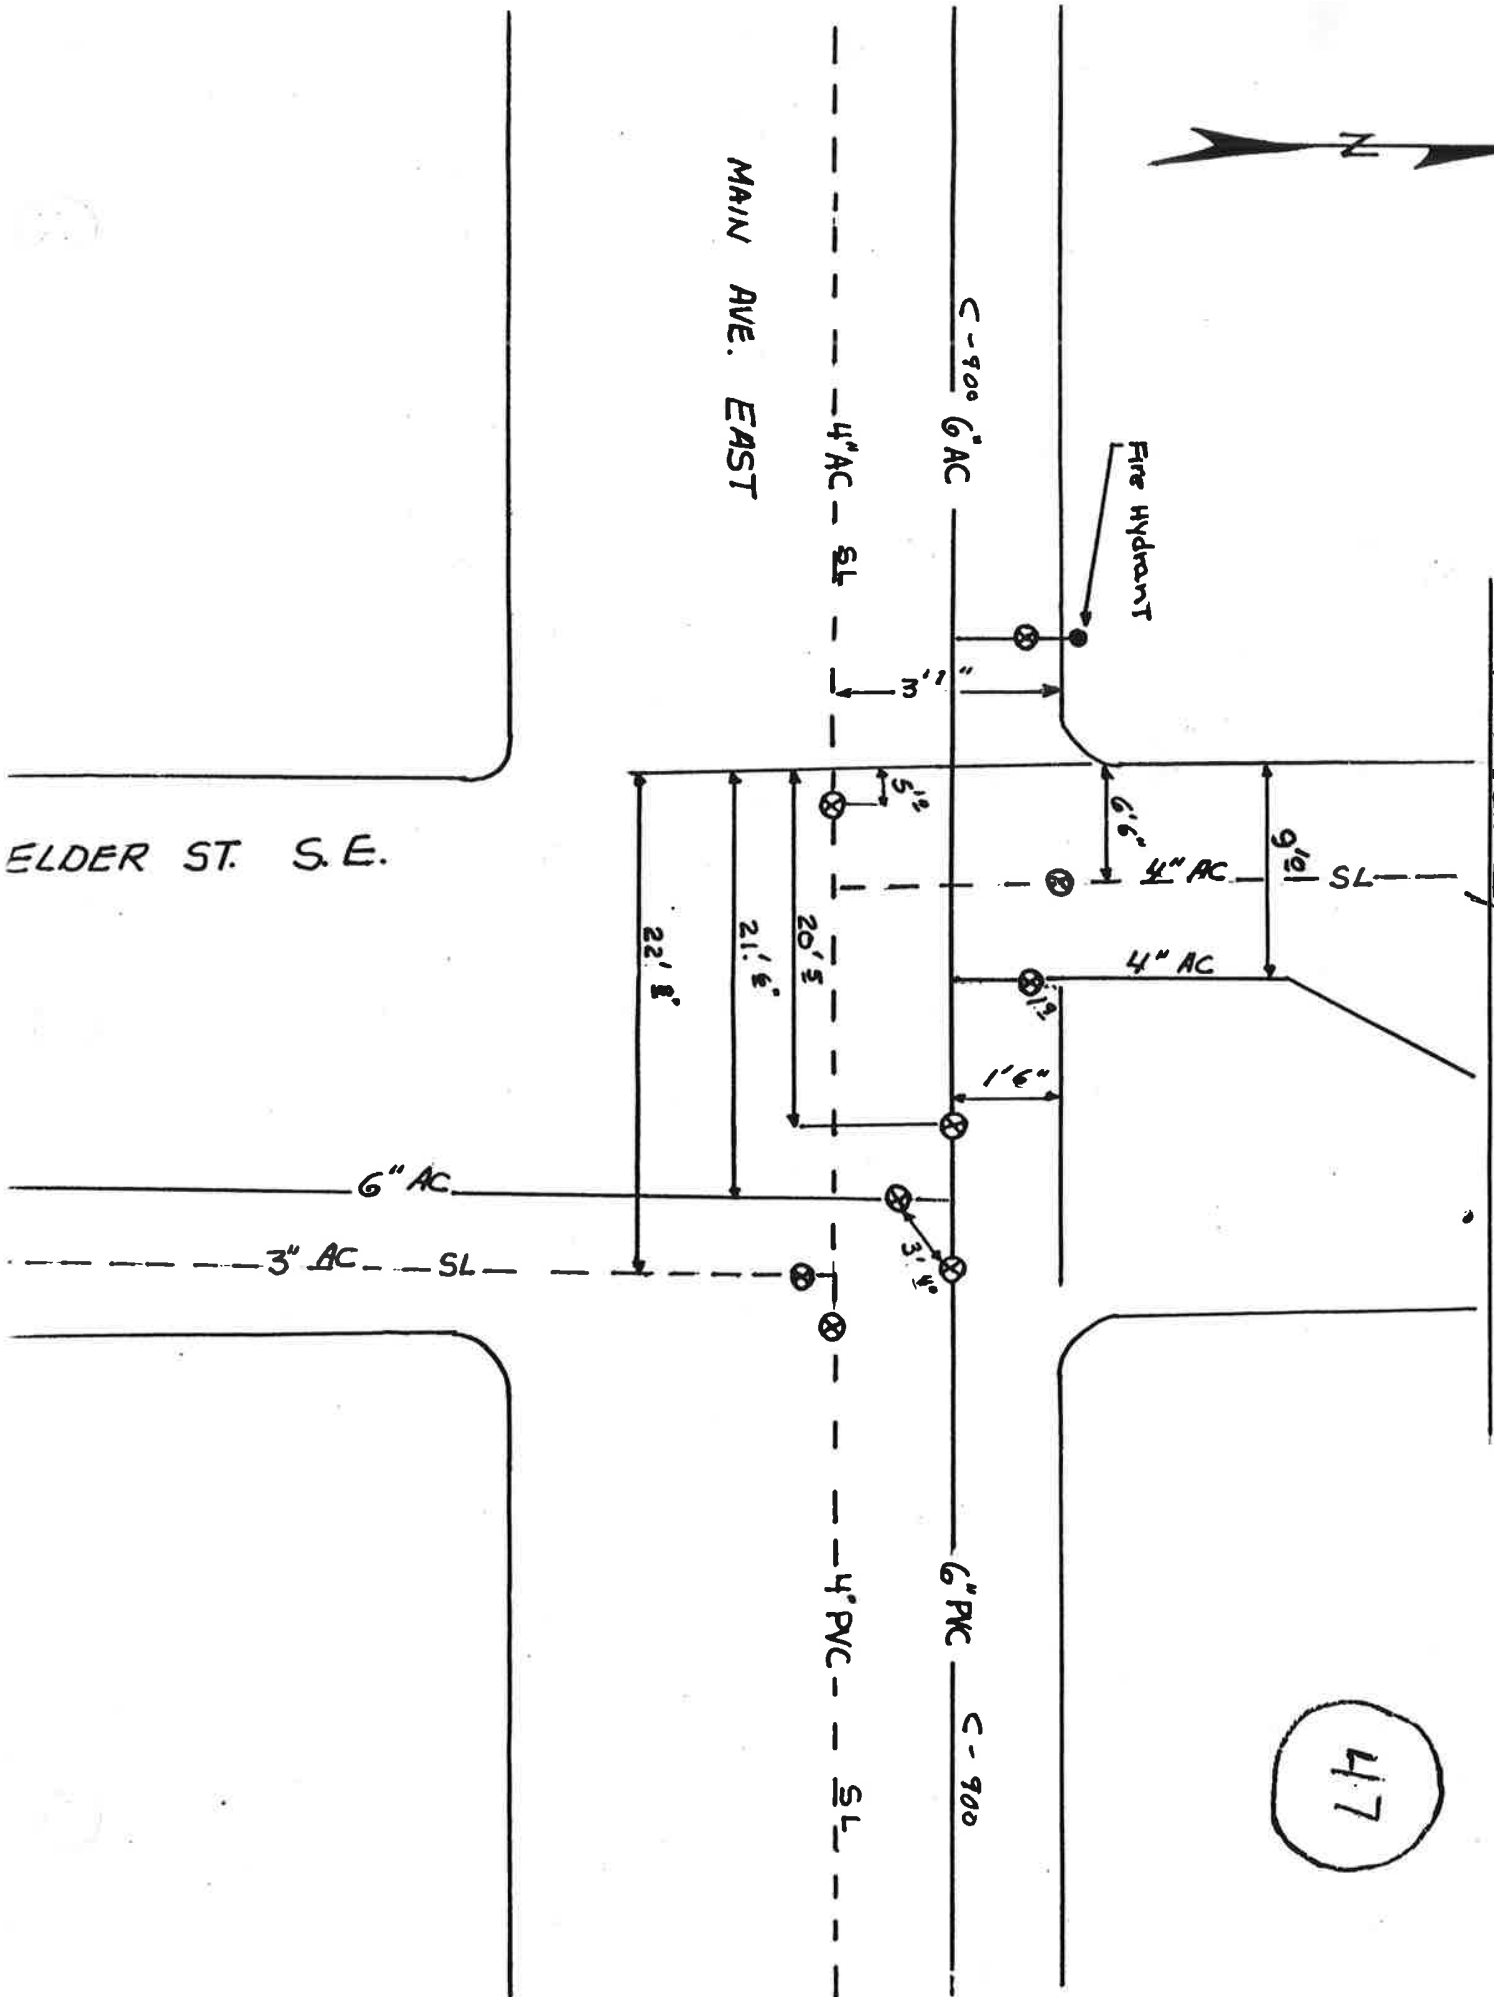


O-V-B

8" A.G.

FERN NORTH

48

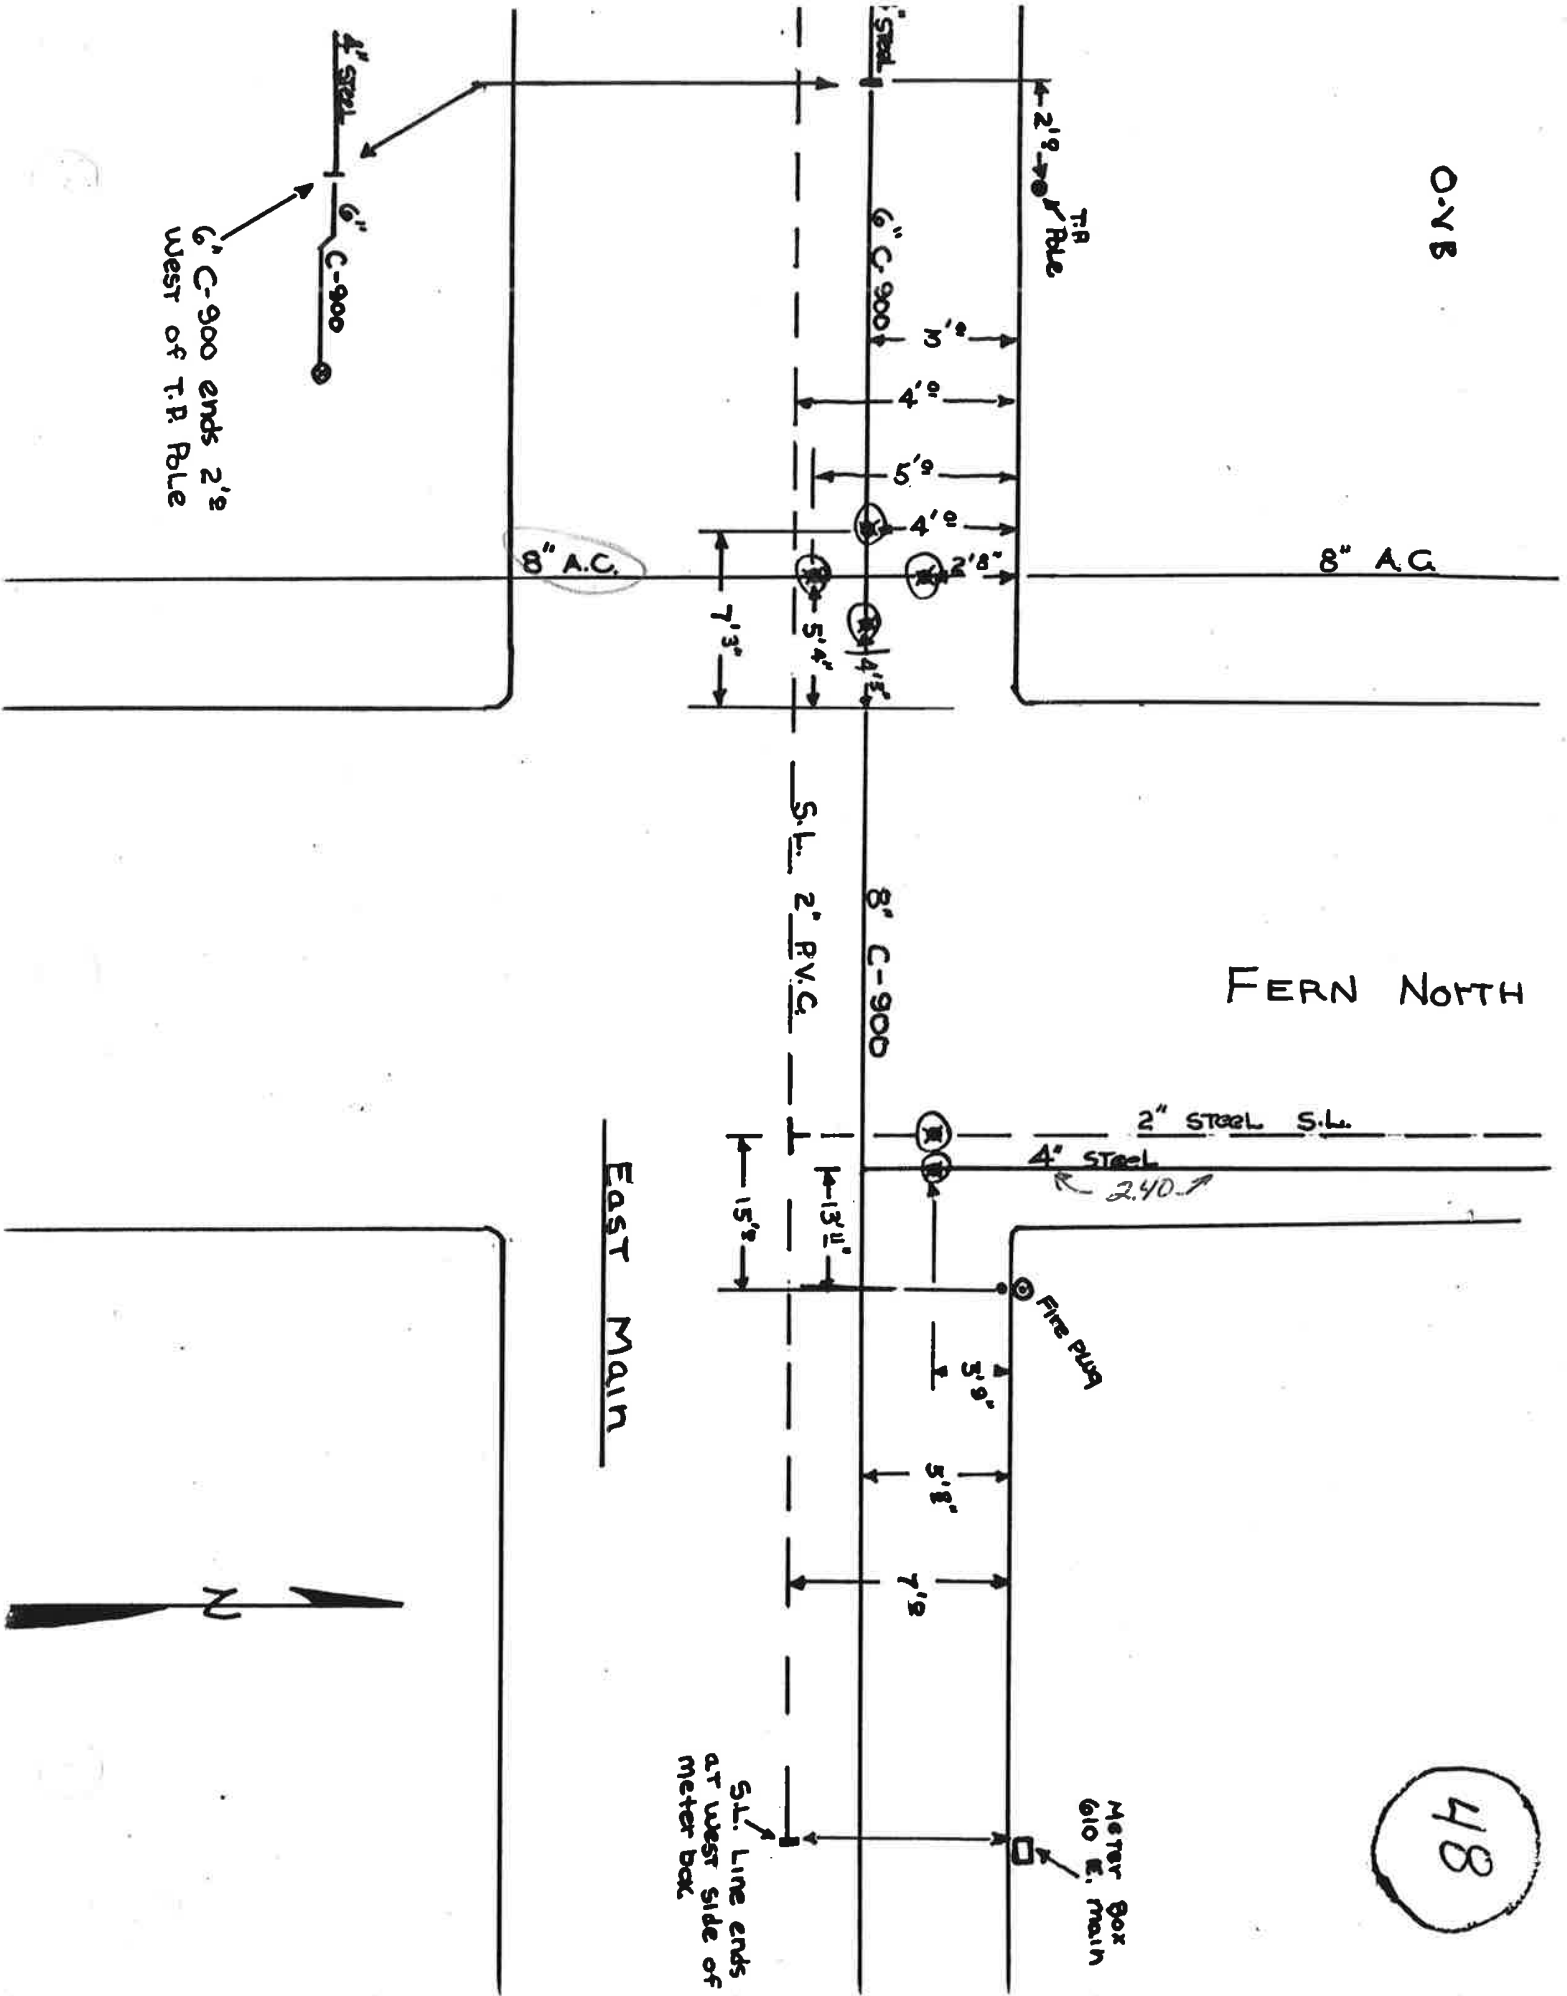

4" Steel
6" C-900
6" C-900 ends 2'9"
west of T.R. Pole

8" A.C.

S.L. 2" P.V.C.

8" C-900

2" steel S.L.


4" steel


Fire Plug


Meter Box
610 E. Main

EAST MAIN

S.L. Line ends
at west side of
meter box

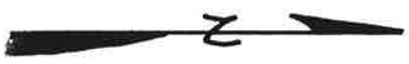

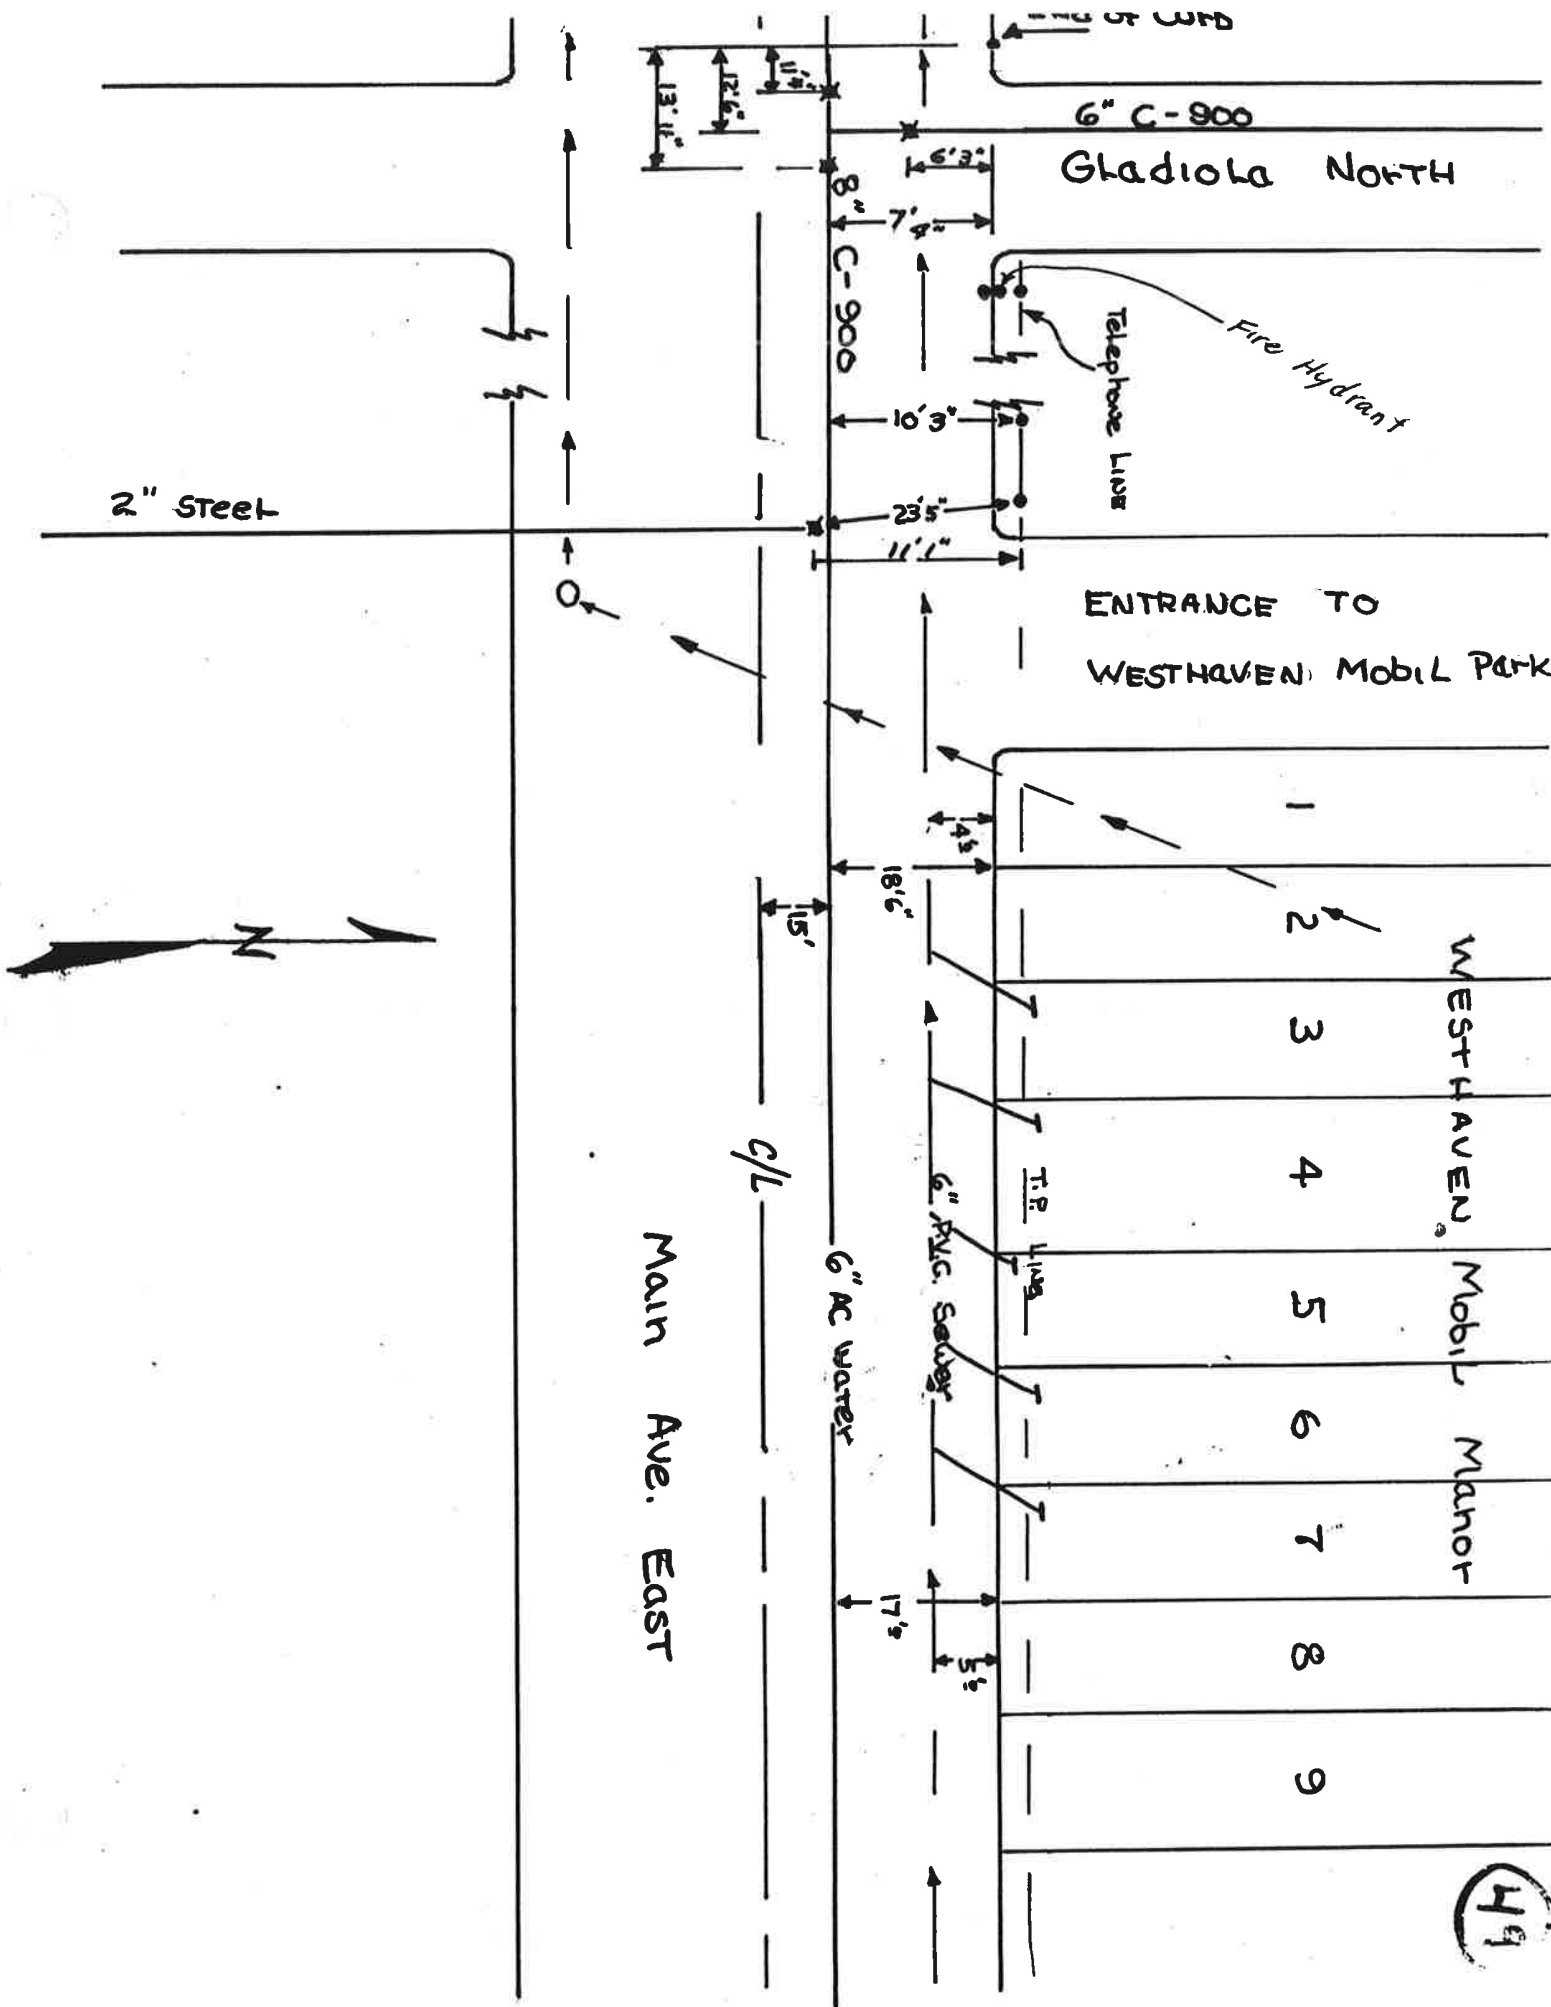

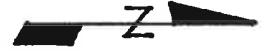

1ST AVE / CANNA ST NE

PARK

LIFT STATION #1
2" P.A.S.

DRAIN

CANNA ST NE

18' 4"

24' 6"
13' 2"


RESTROOMS


POWER POLE

1ST AVE NE

4" PLASTIC


8" AC

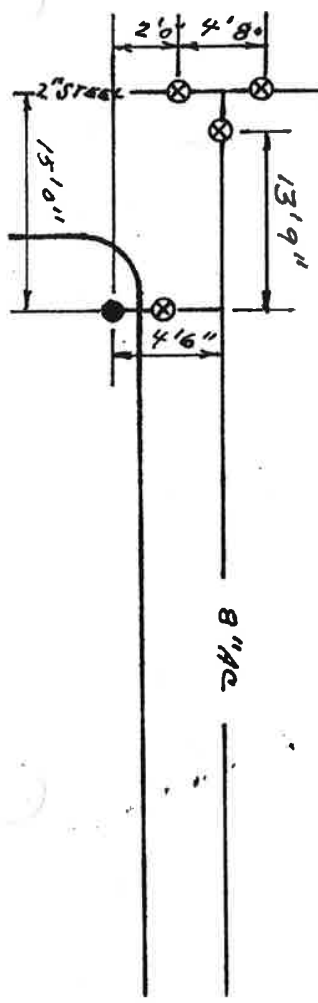

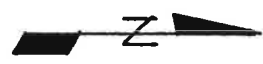


1ST AVE NE / ALLEY THROUGH PARK

U.S.B.R. PUMP

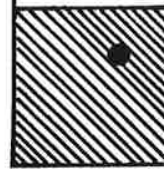


2" STEEL

1ST AVE NE

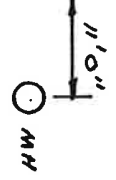



8" AC

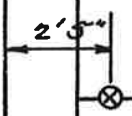

ALLEY BETWEEN
CANNON/DANBY NE

B-N-B

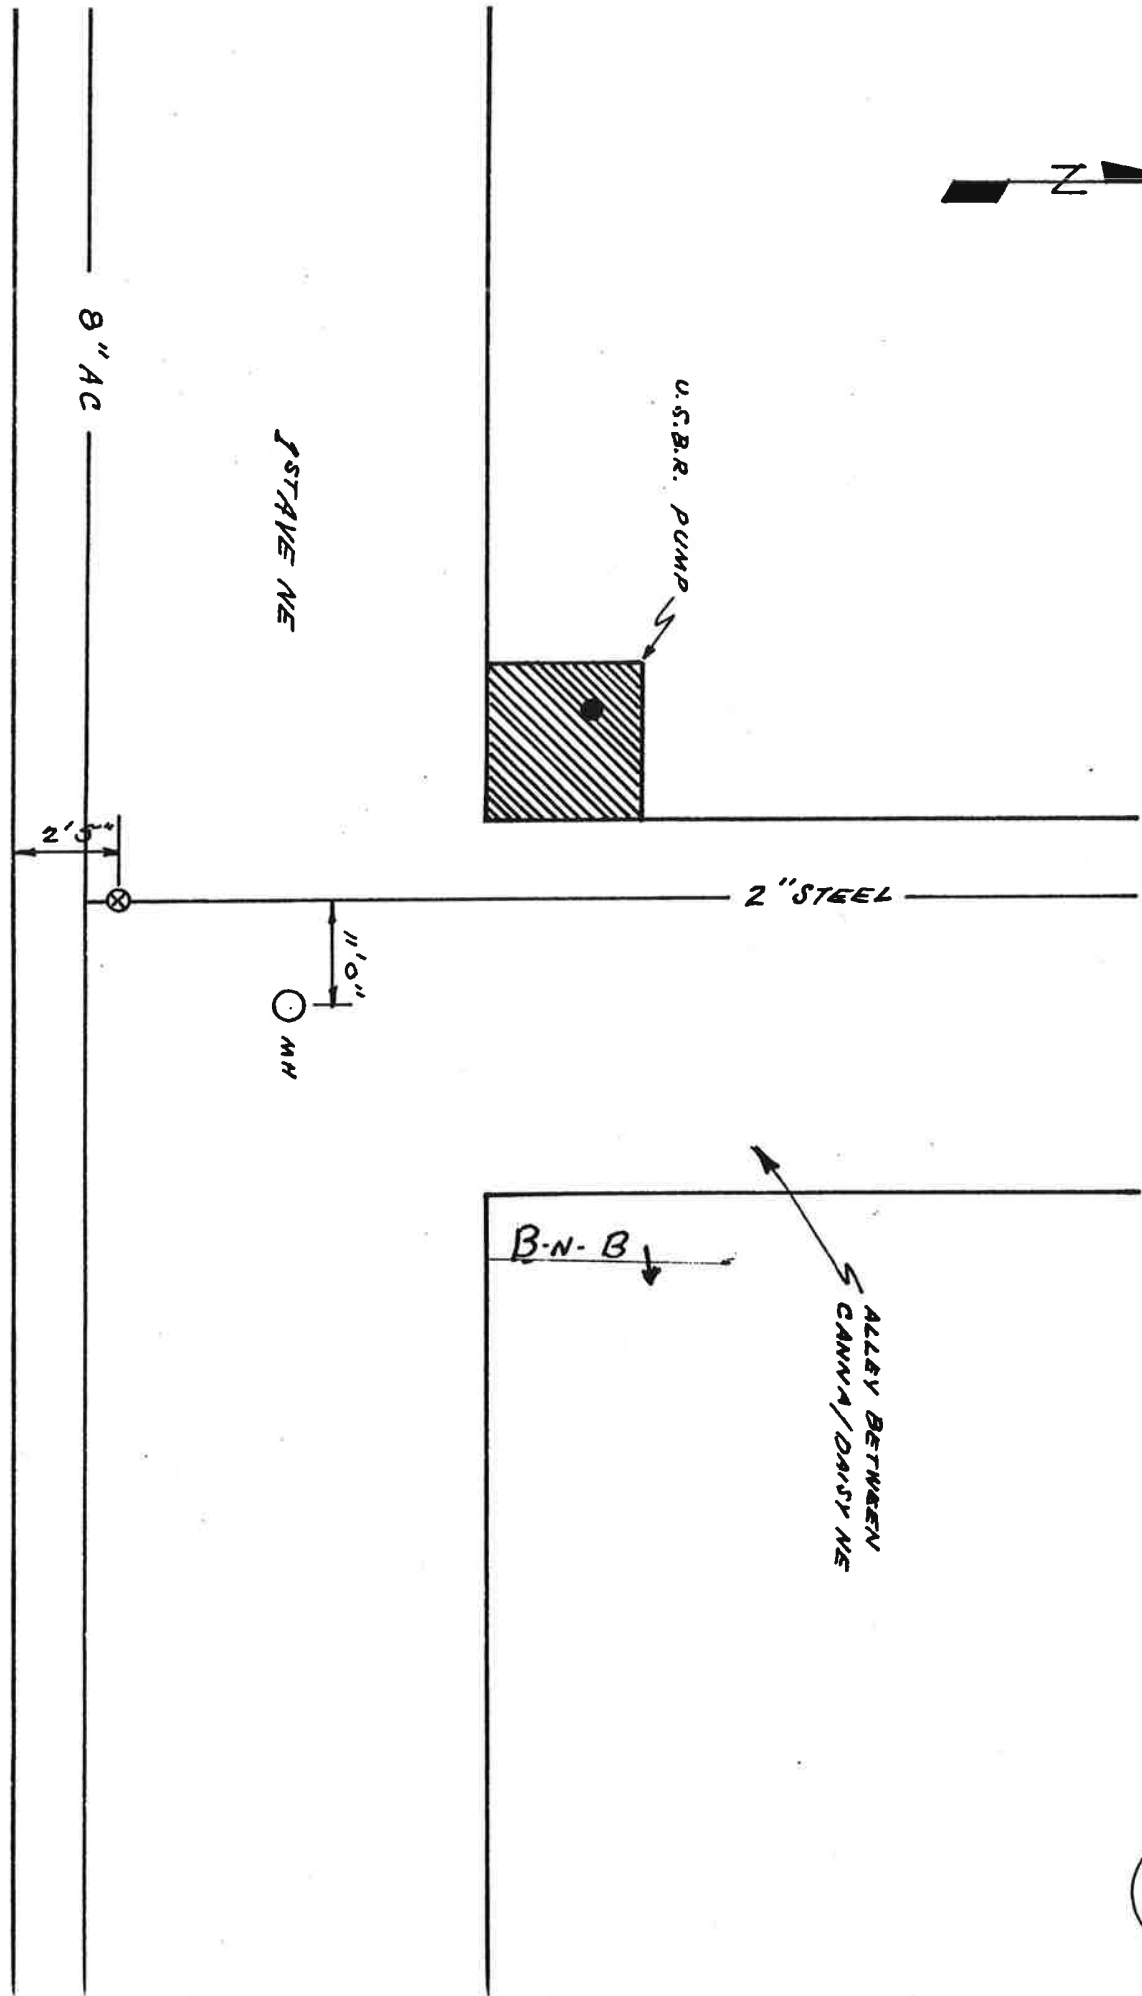

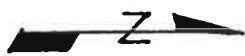

1ST AVE / DAISY ST NE

52

1ST AVE NE

DAISY ST NE

8" AC

1" COPPER
SL

1" COPPER

4" AC SL

6" AC

11' 0"

7' 6"

5' 8"

4' 3"

4' 3"

2' 1"


3" AC


6" AC

SL



HYDRANT

ALLEY NORTH OF MAIN AVE E

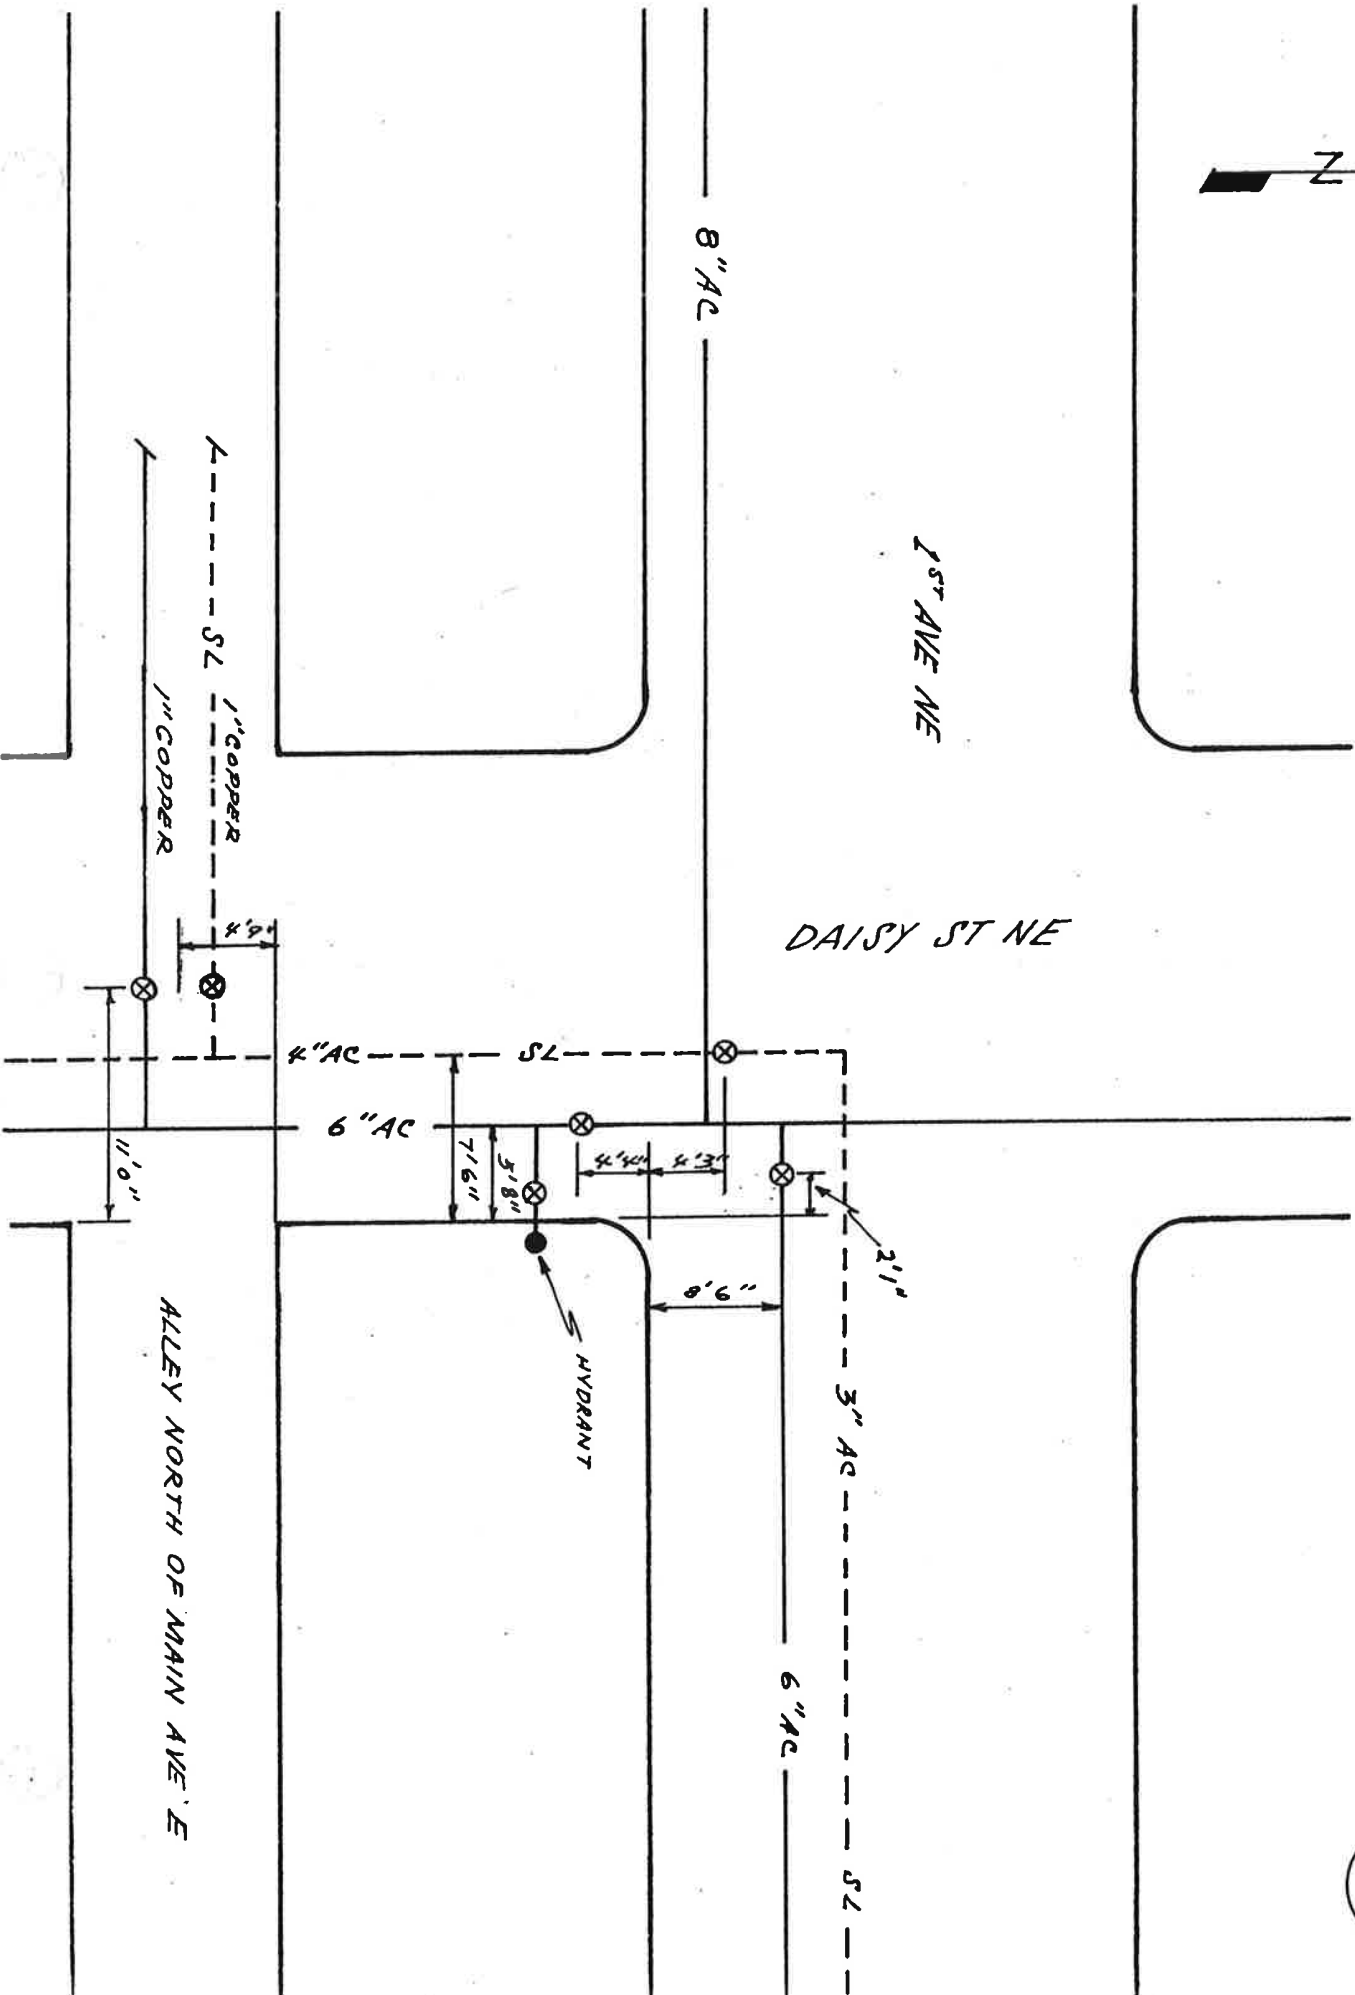


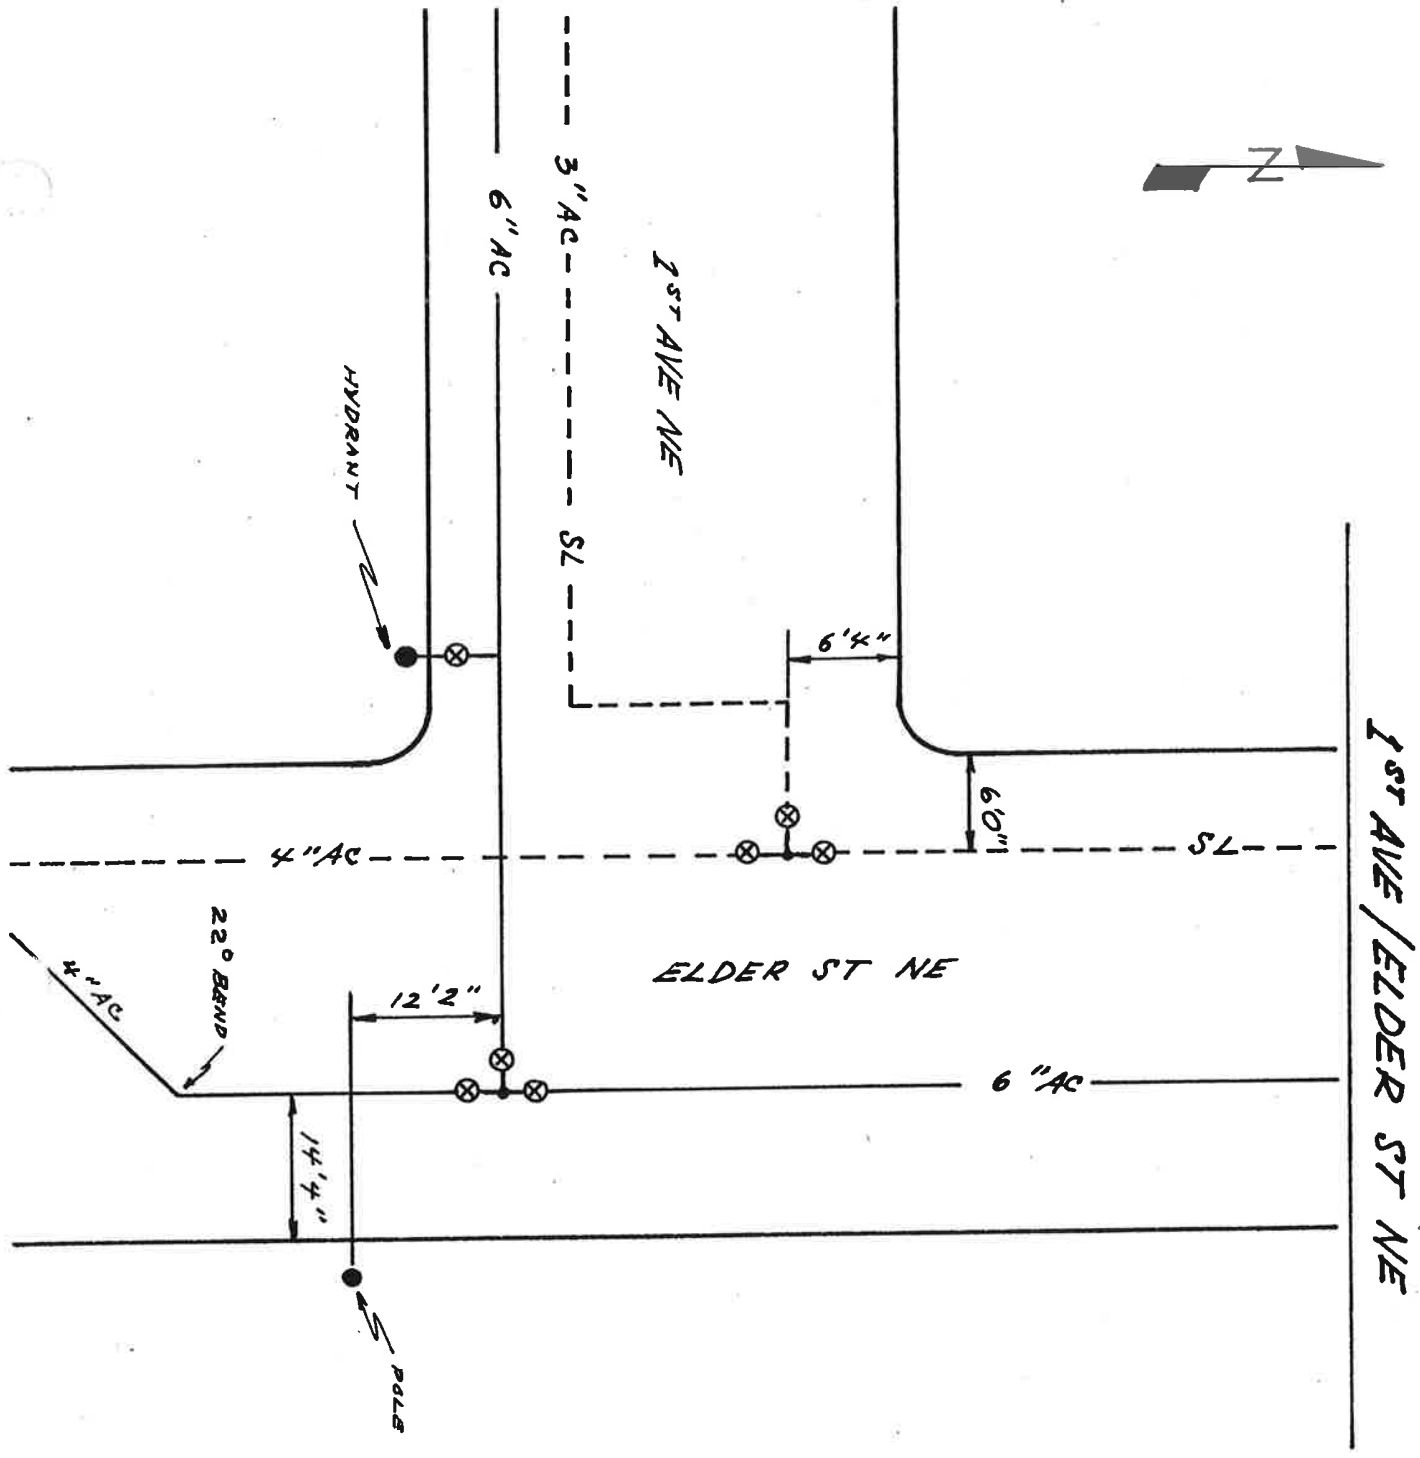

53

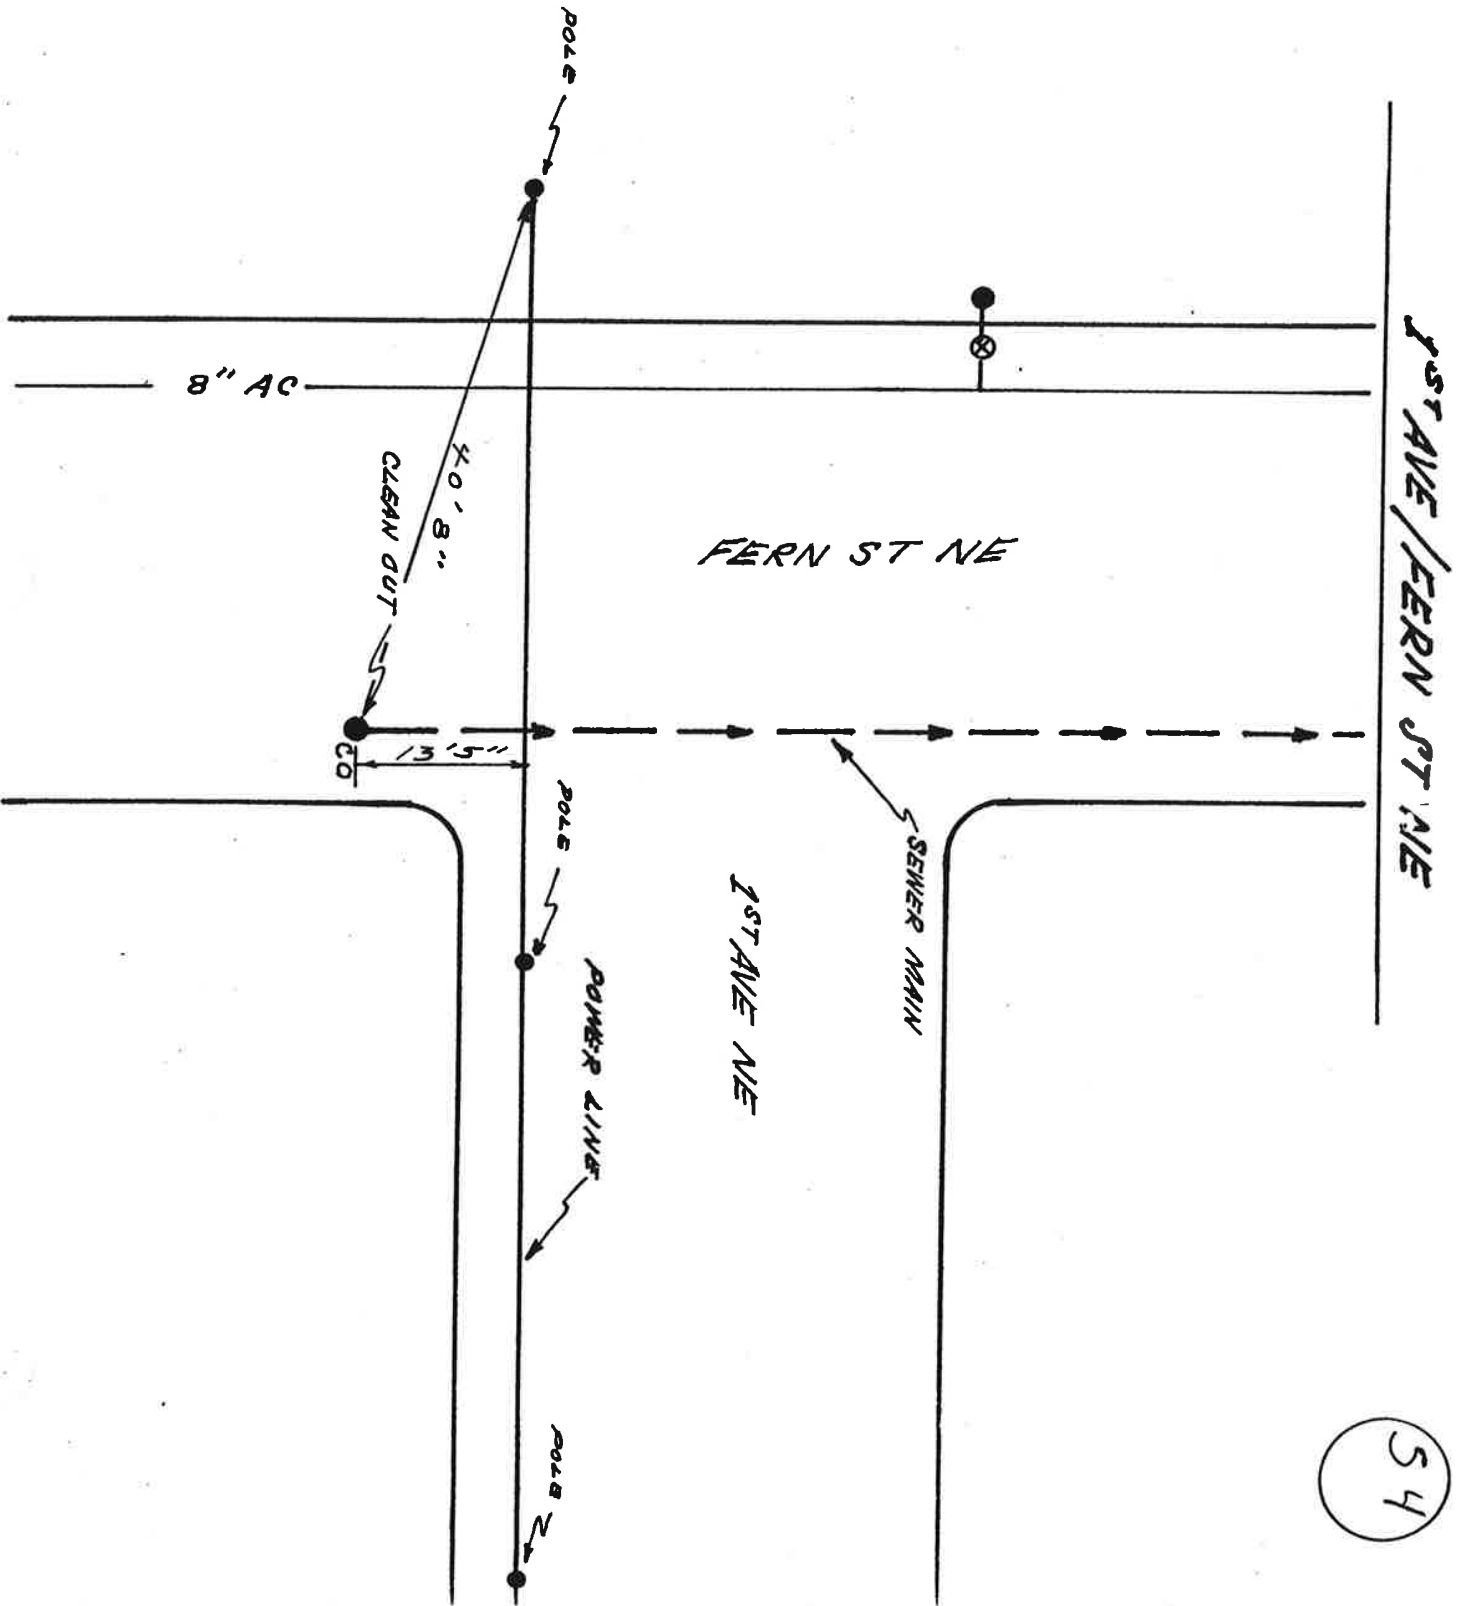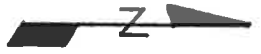


54

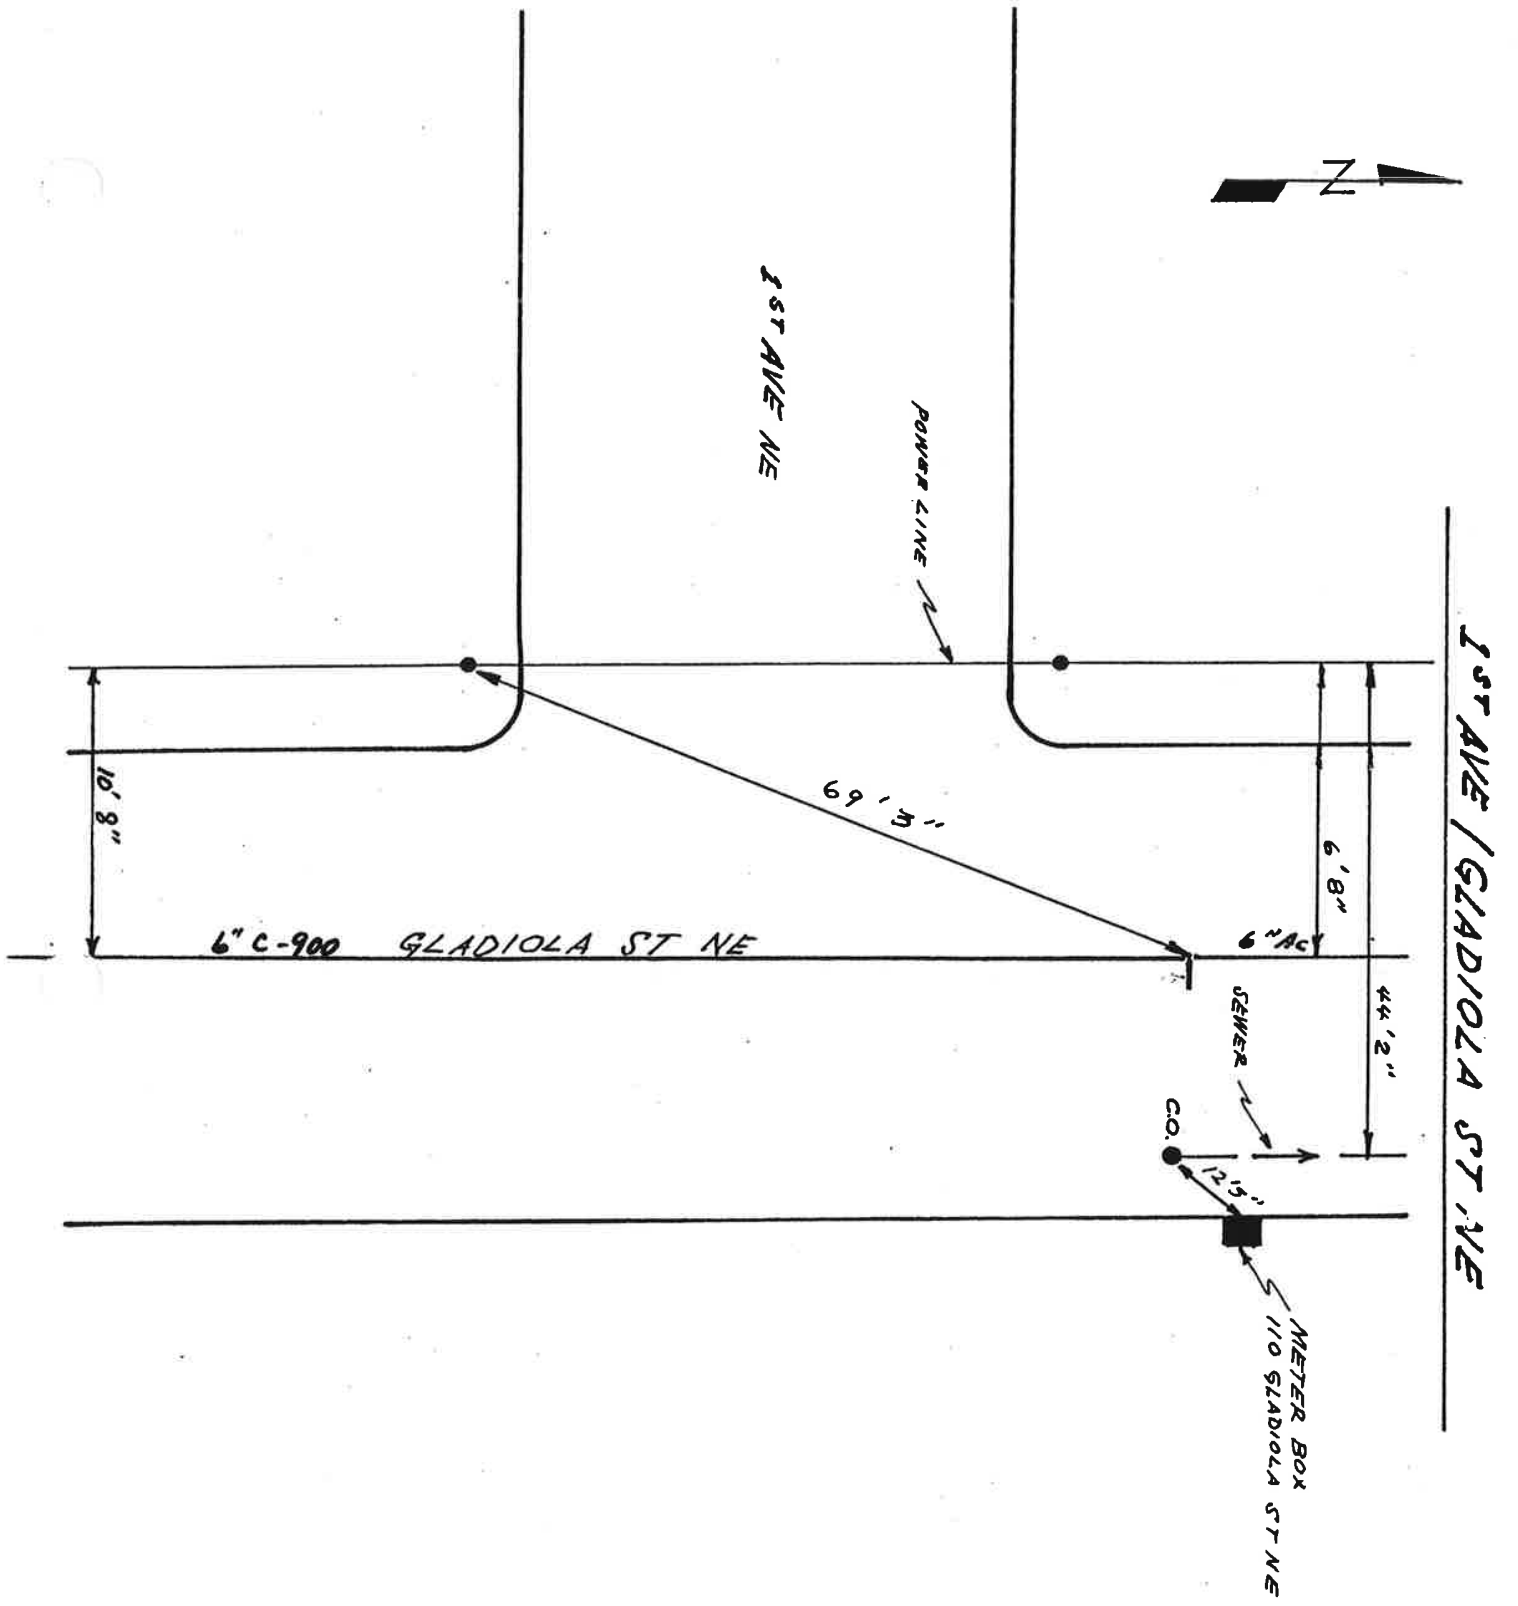




2ND AVE / DAISY ST NE

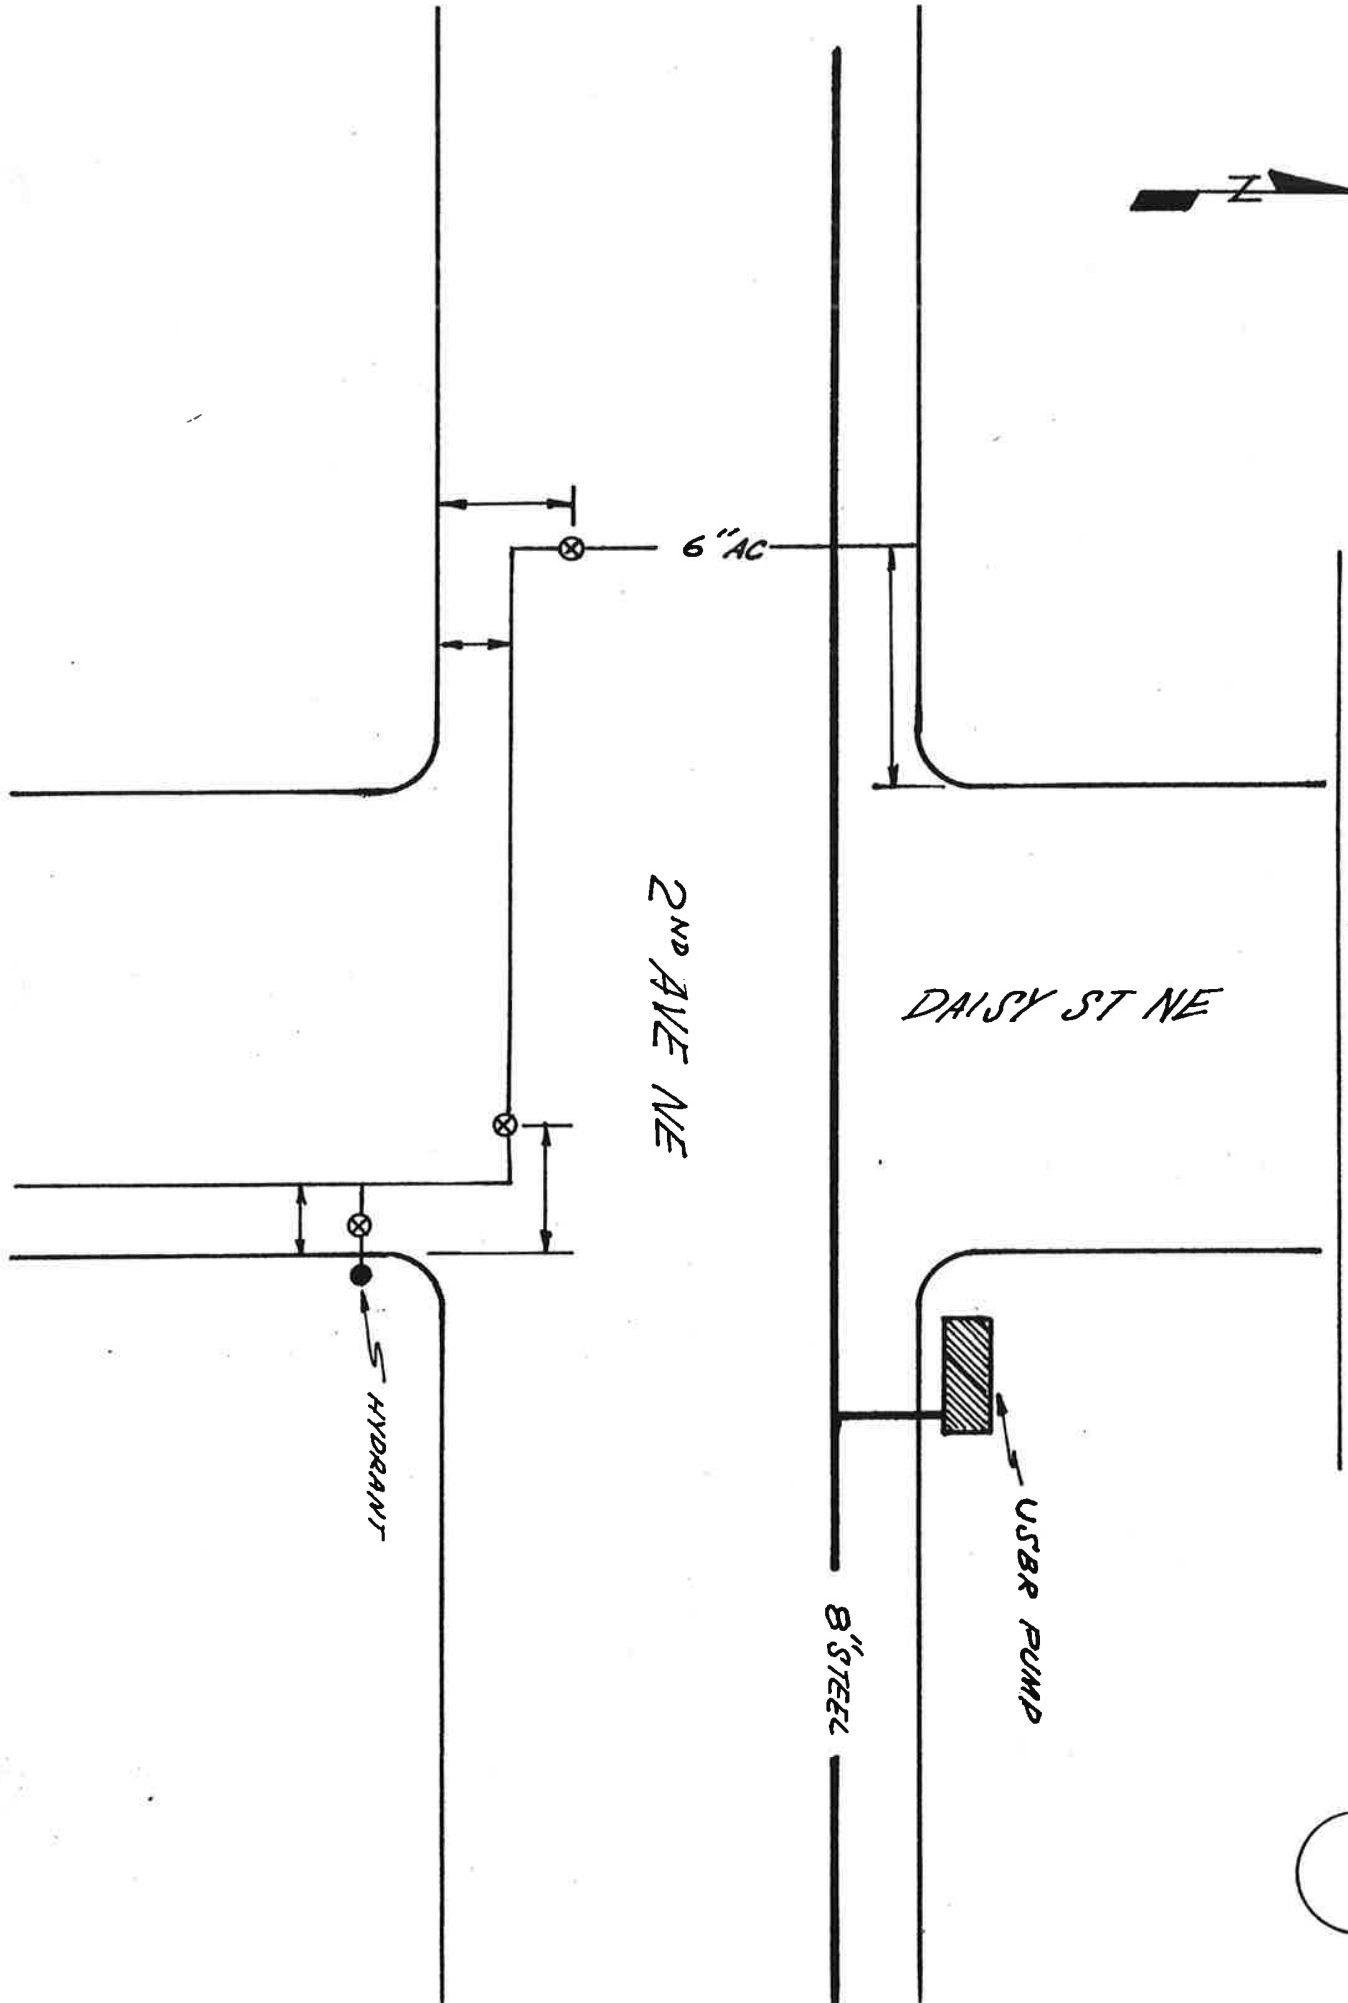



56

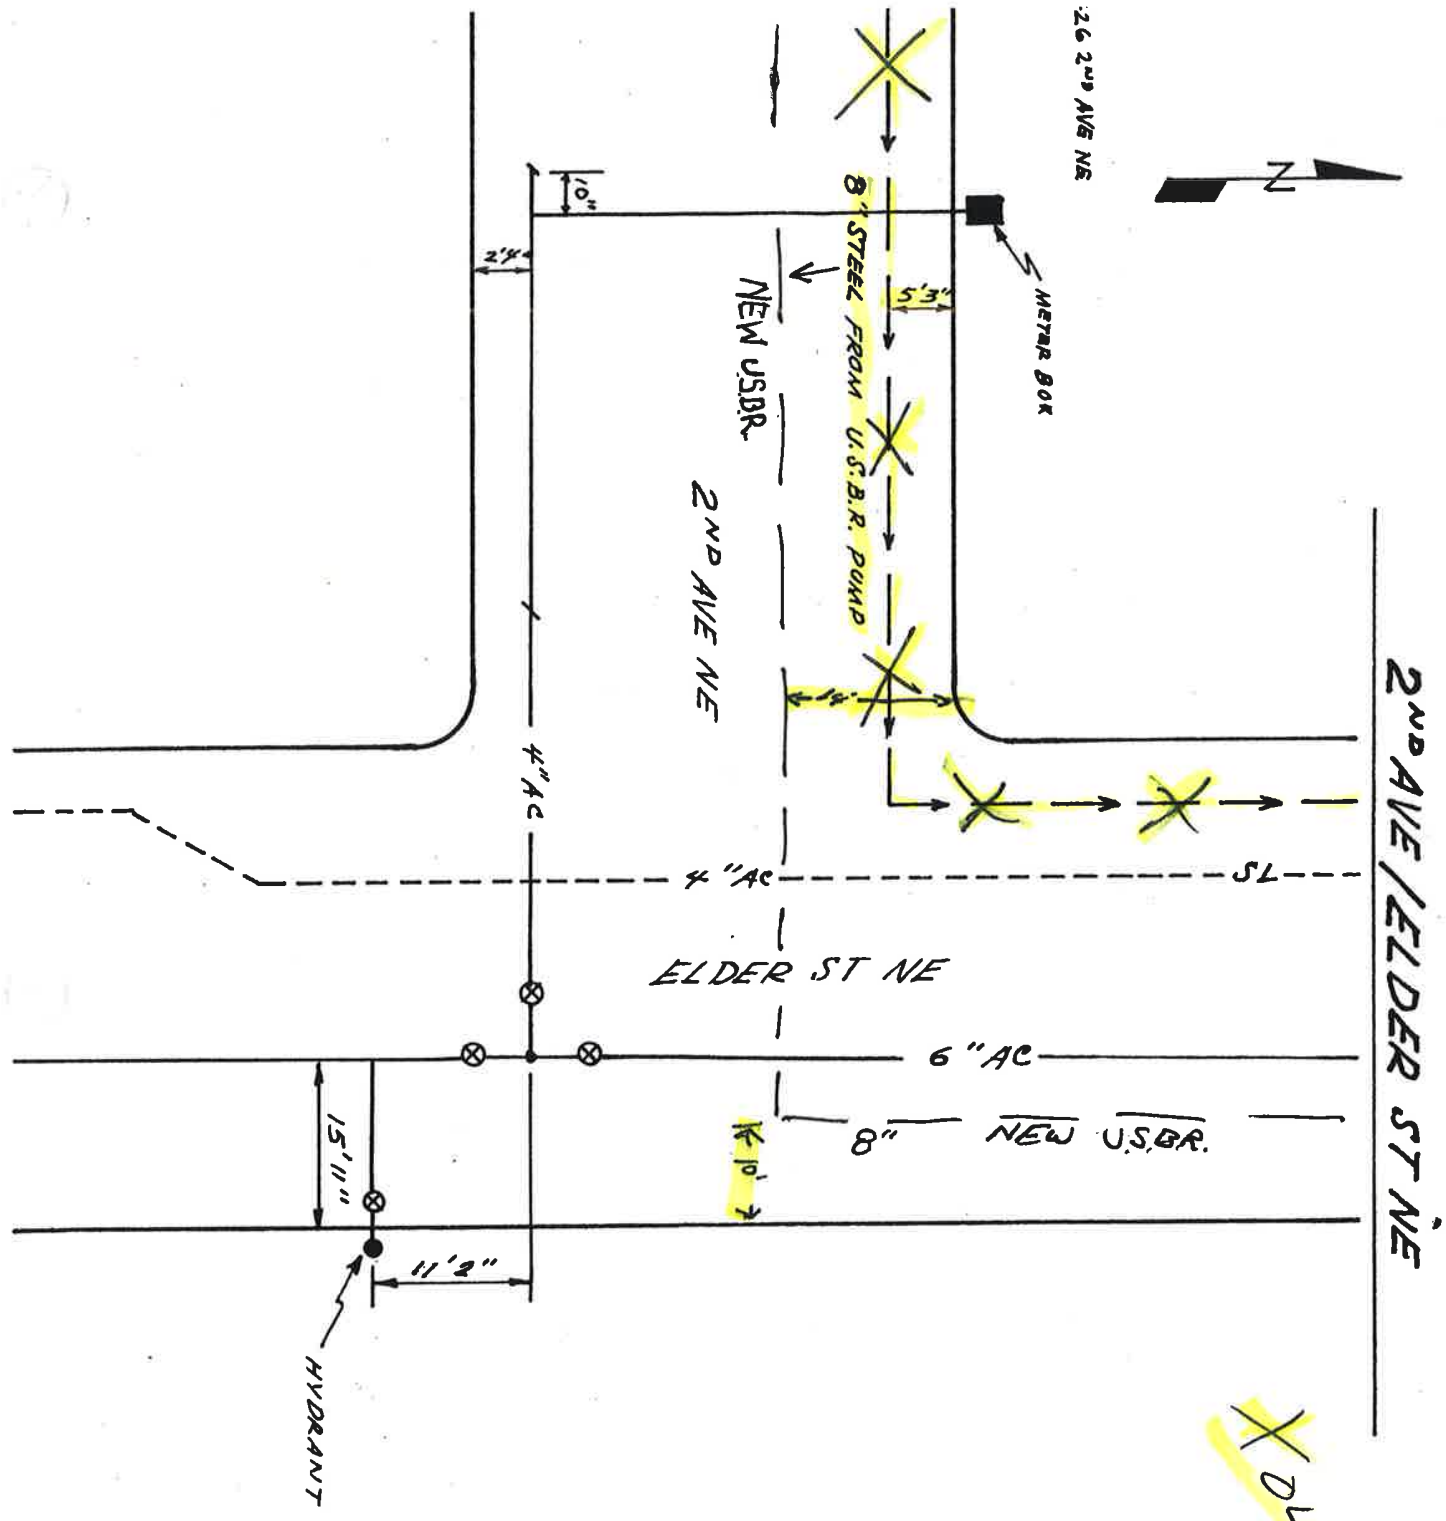



X DP

U.S. Bd of Reclamation

CHARLIE
Williams
754 0260
398-4124

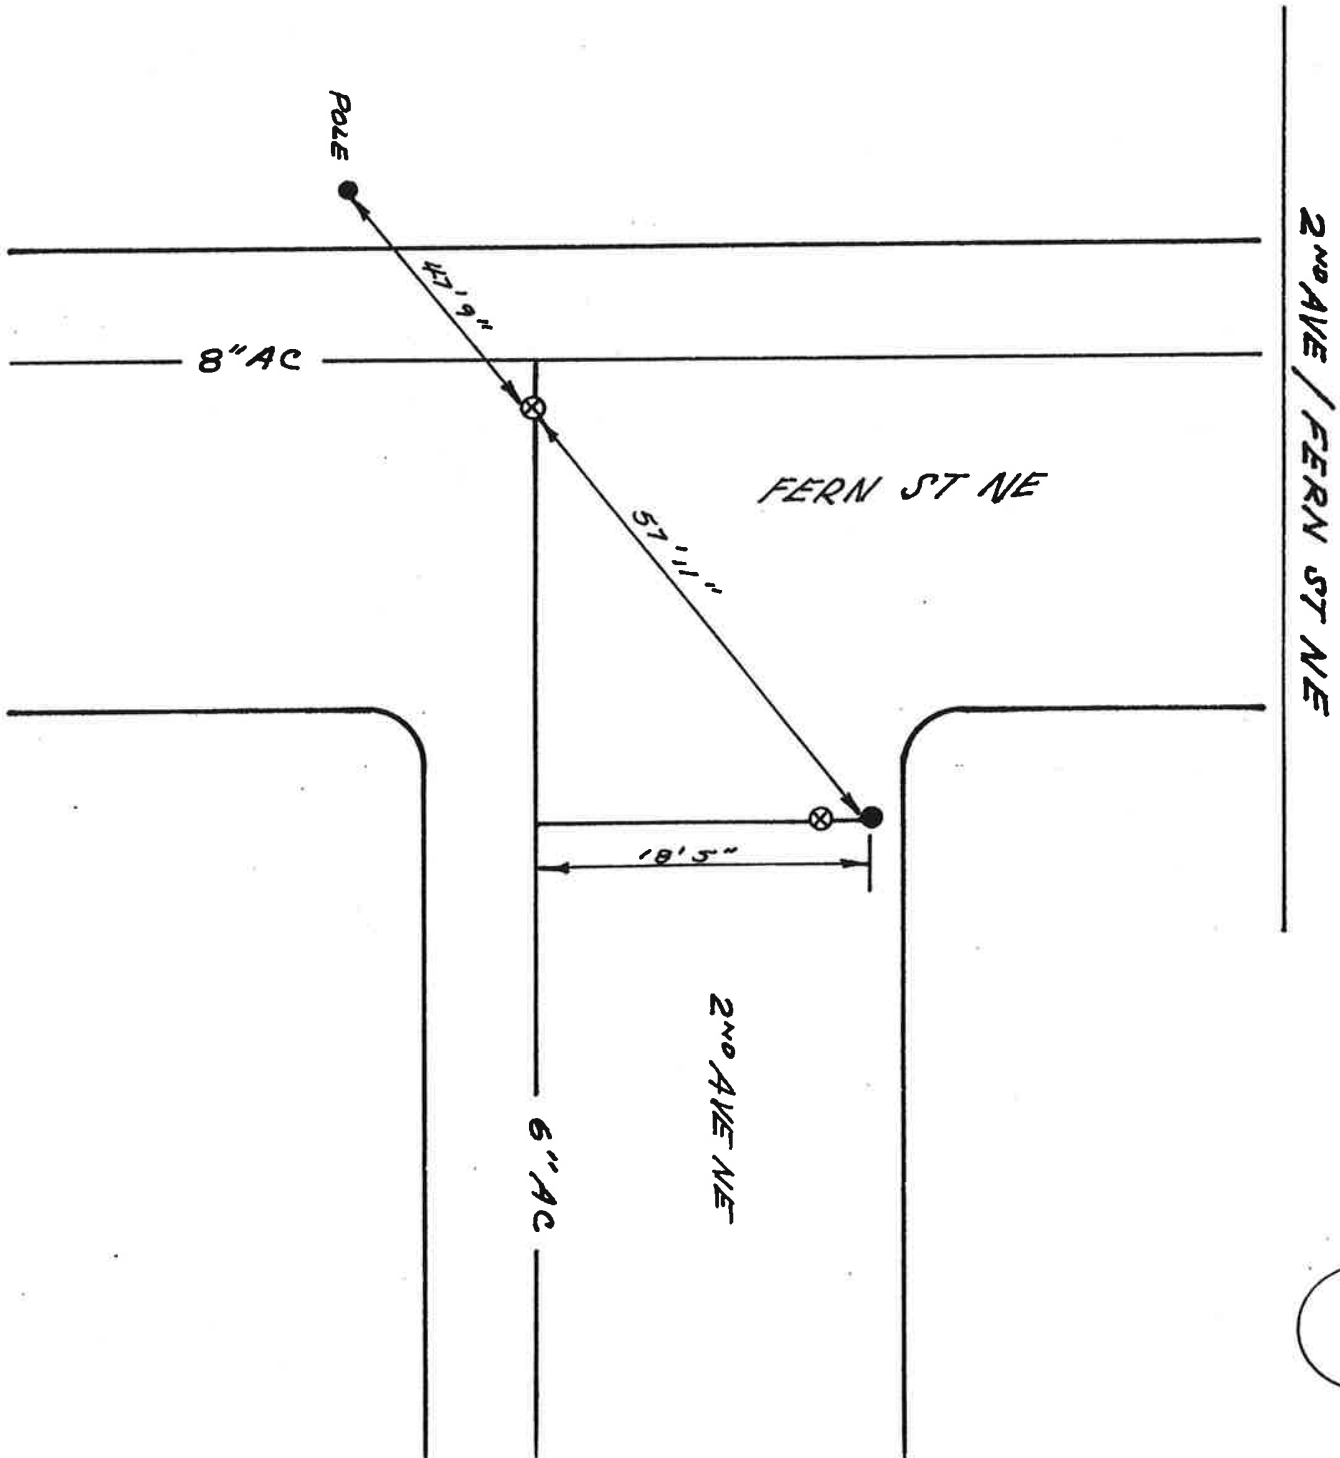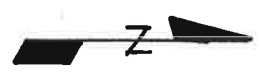


58

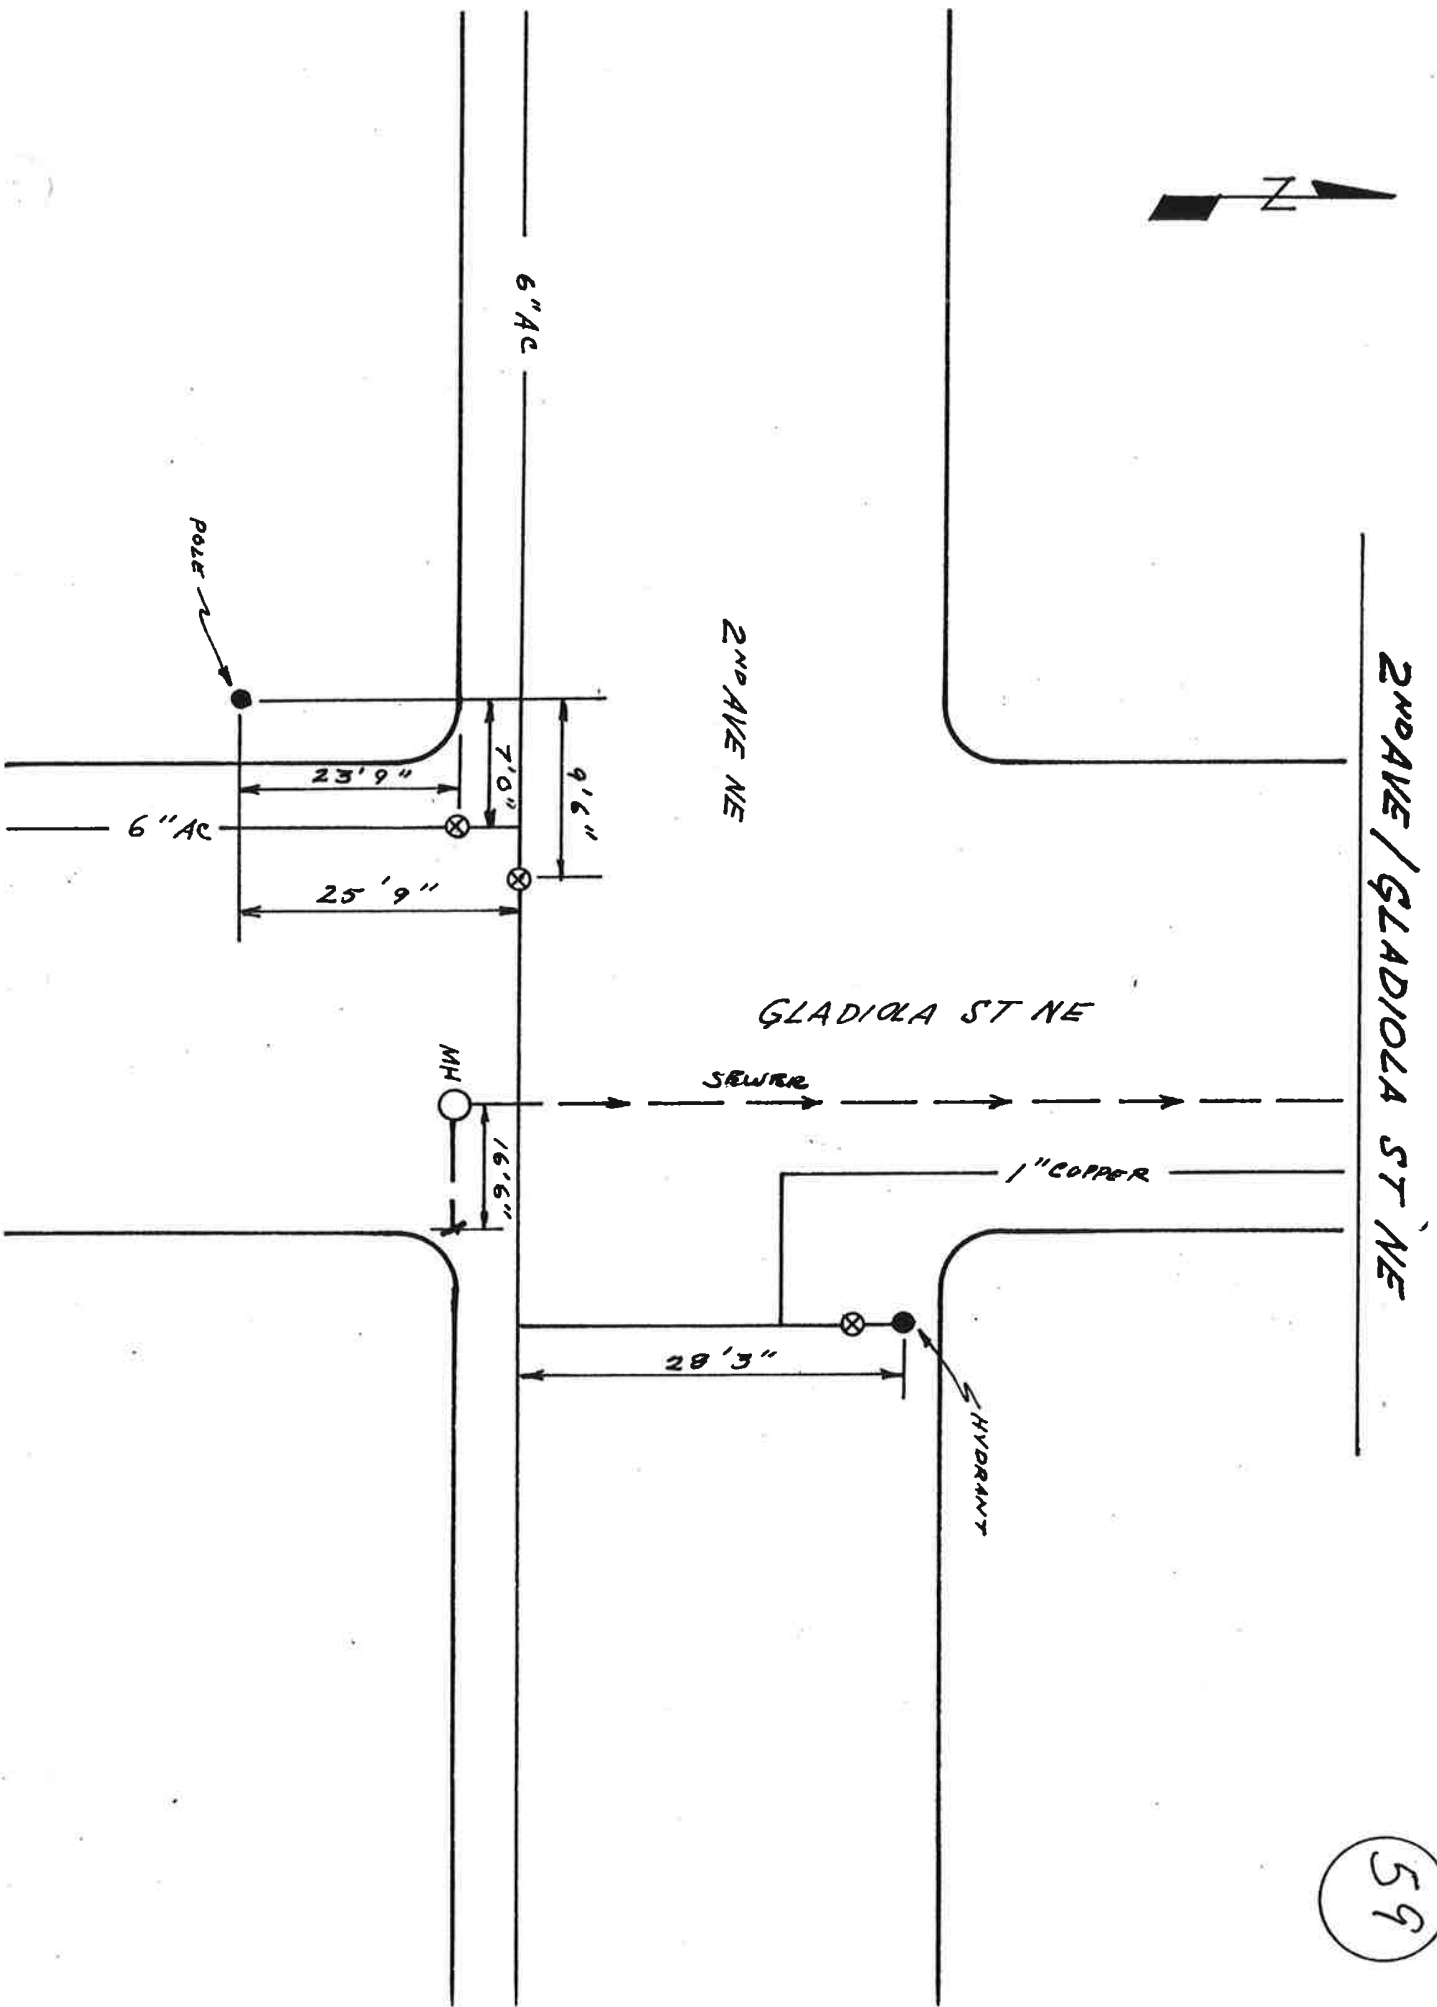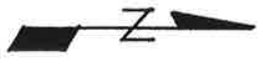


59

2ND AVE / BETWEEN GLADIOLA AND HOLLY NE

60

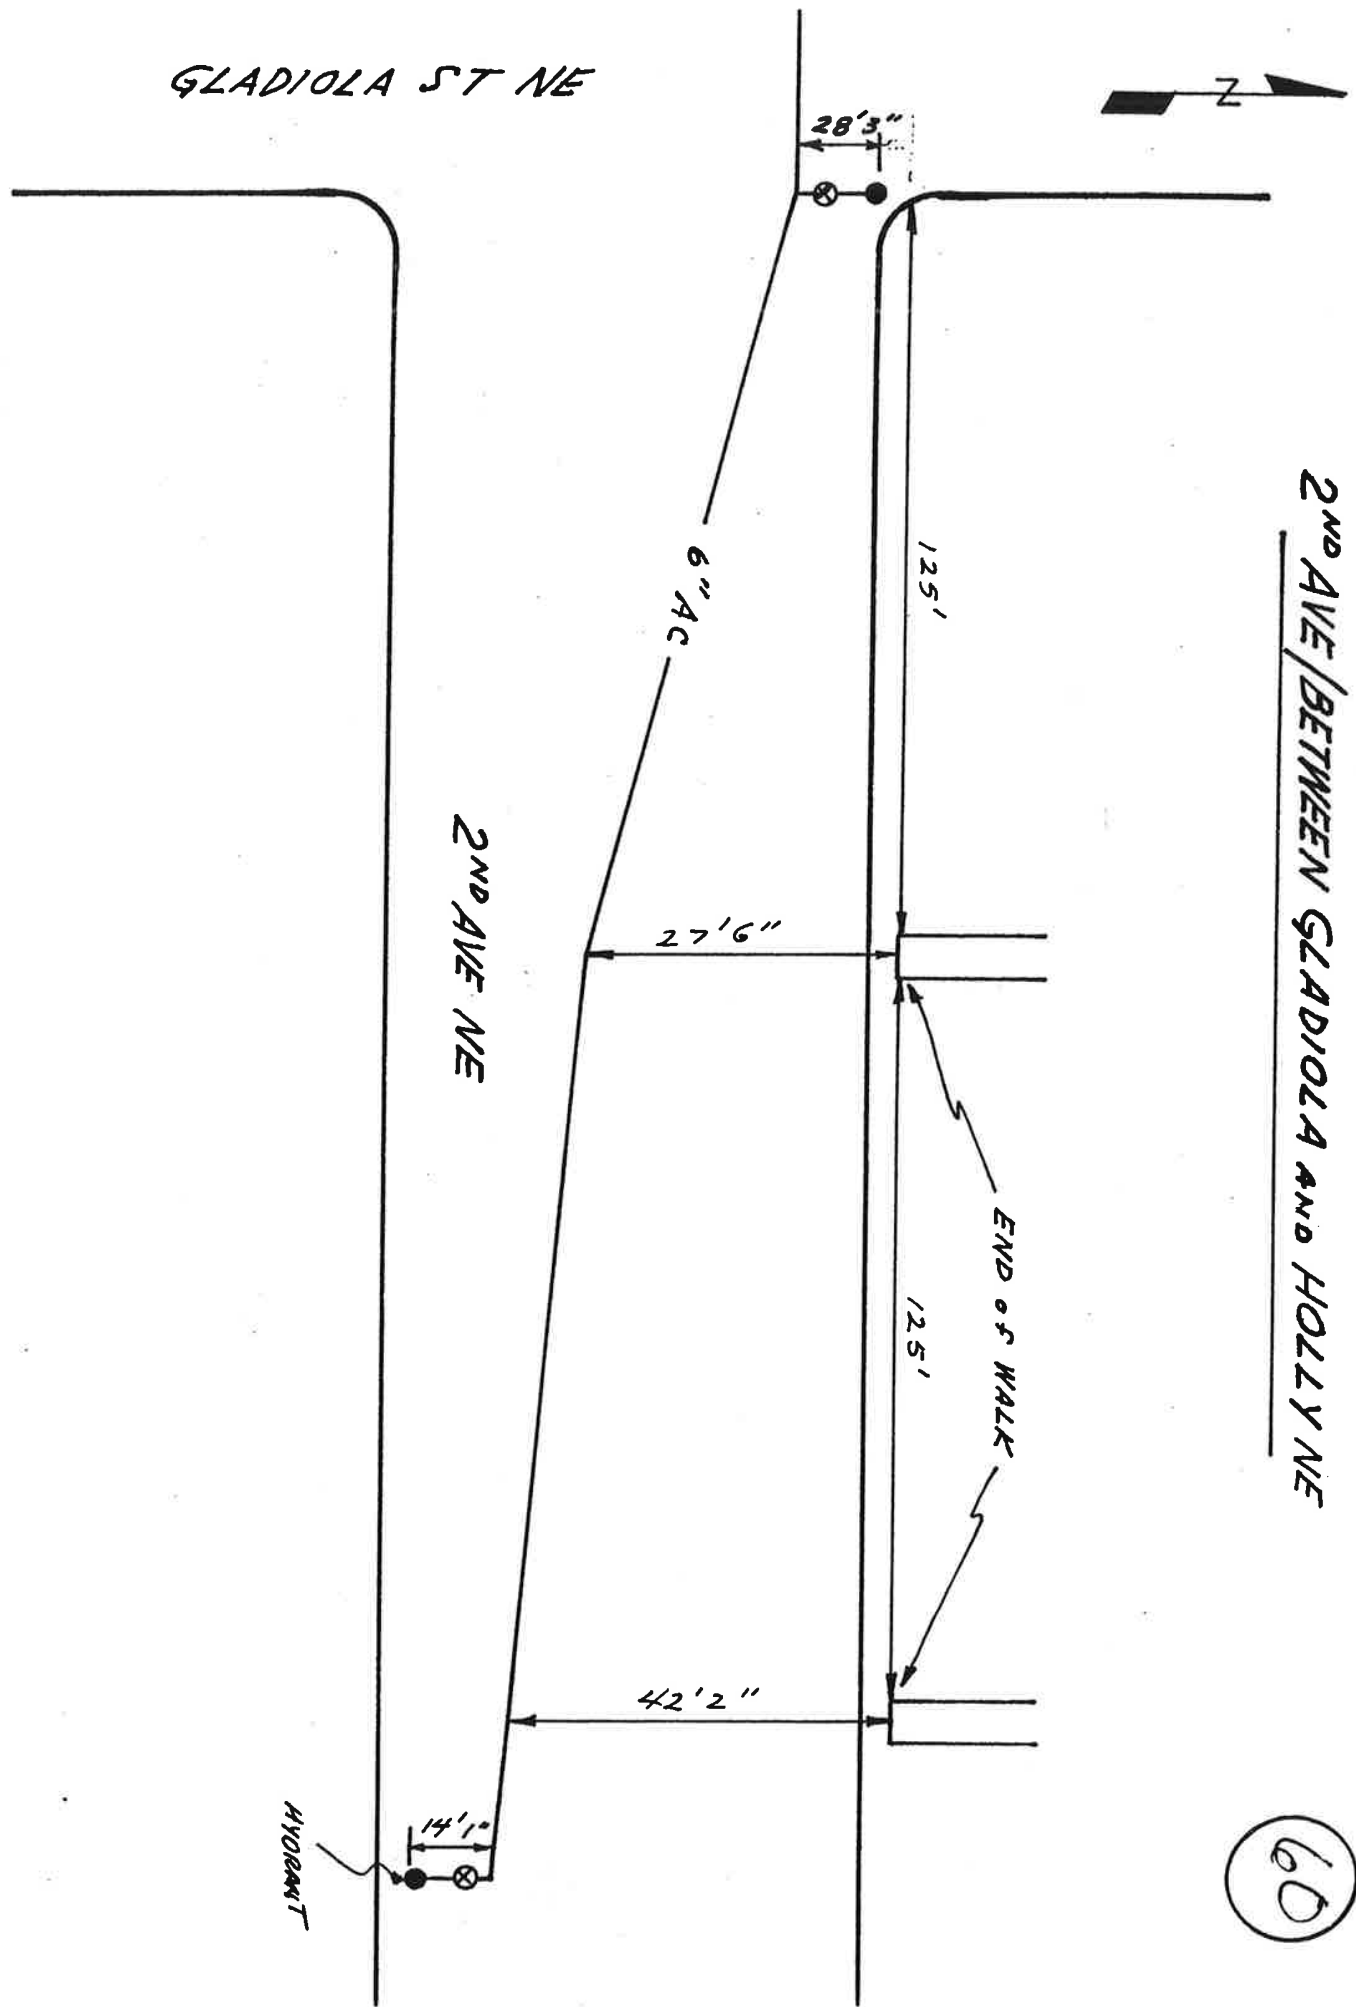

GLADIOLA ST NE

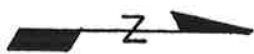

28'3"

6" AC

125'

2ND AVE NE

27'6"

END OF WALK

125'

42'2"

HYDRANT




14'1"



2ND AVE / IRIS ST NE


2ND AVE. NE.

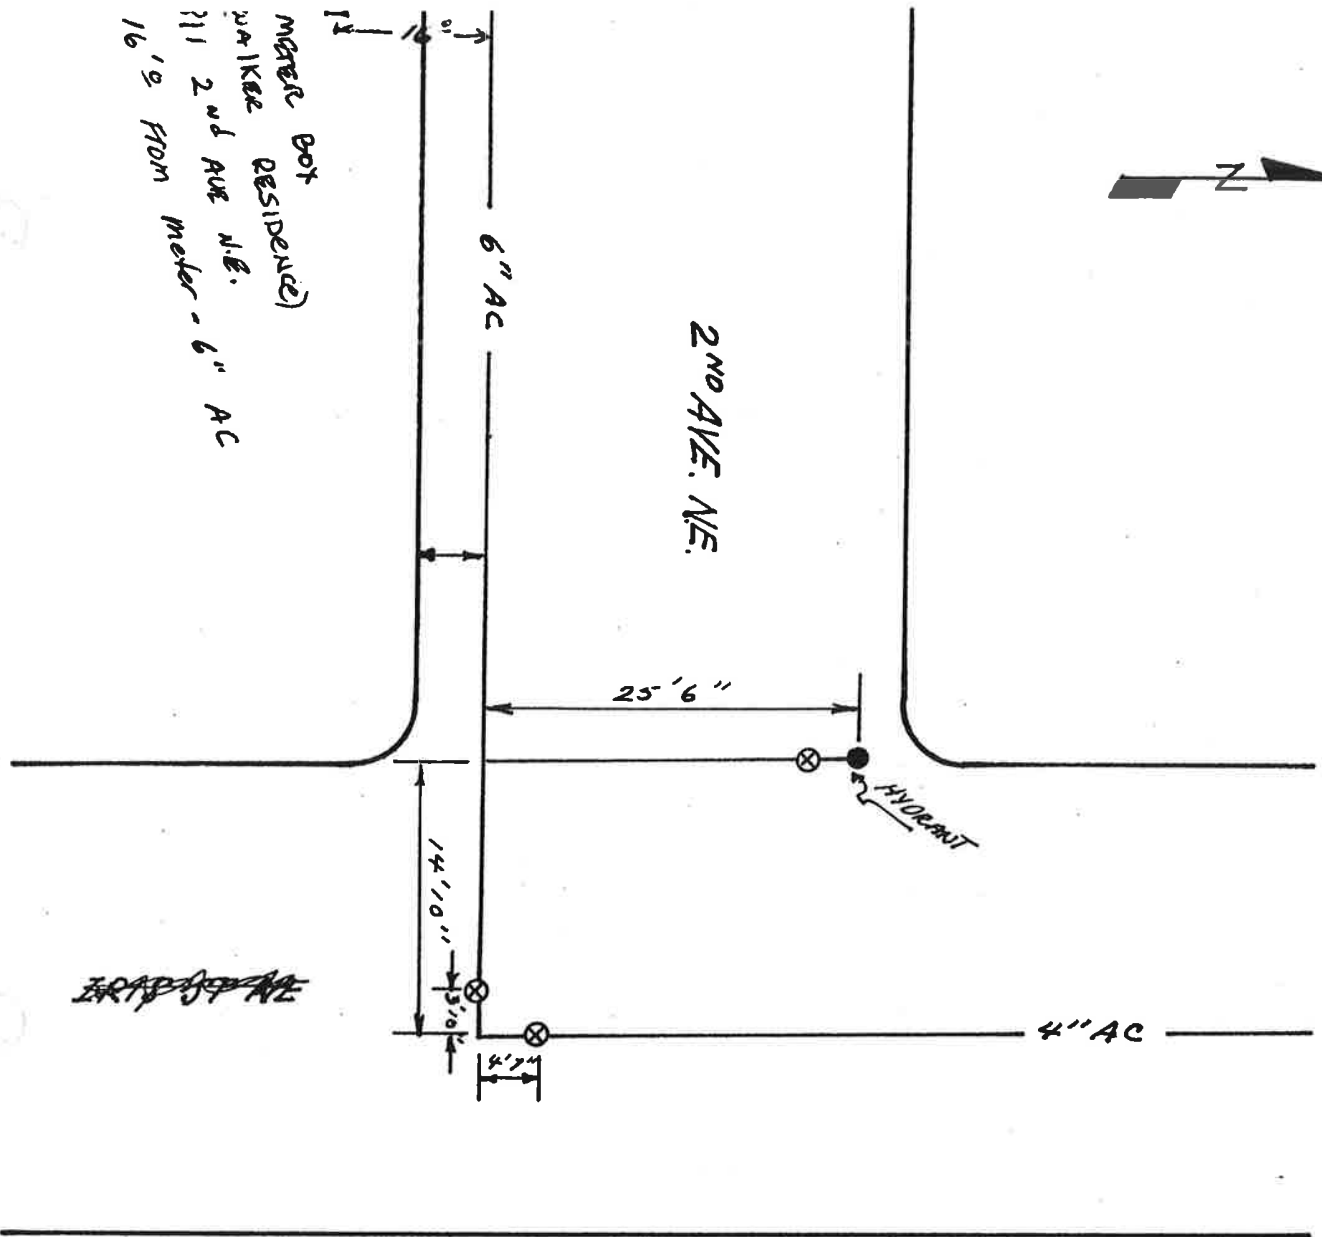



METER BOT
(RESIDENCE)
211 2ND AVE N.E.
16'9" FROM
METER - 6" AC

~~IRIS ST NE~~

EAST LAKE NORTH

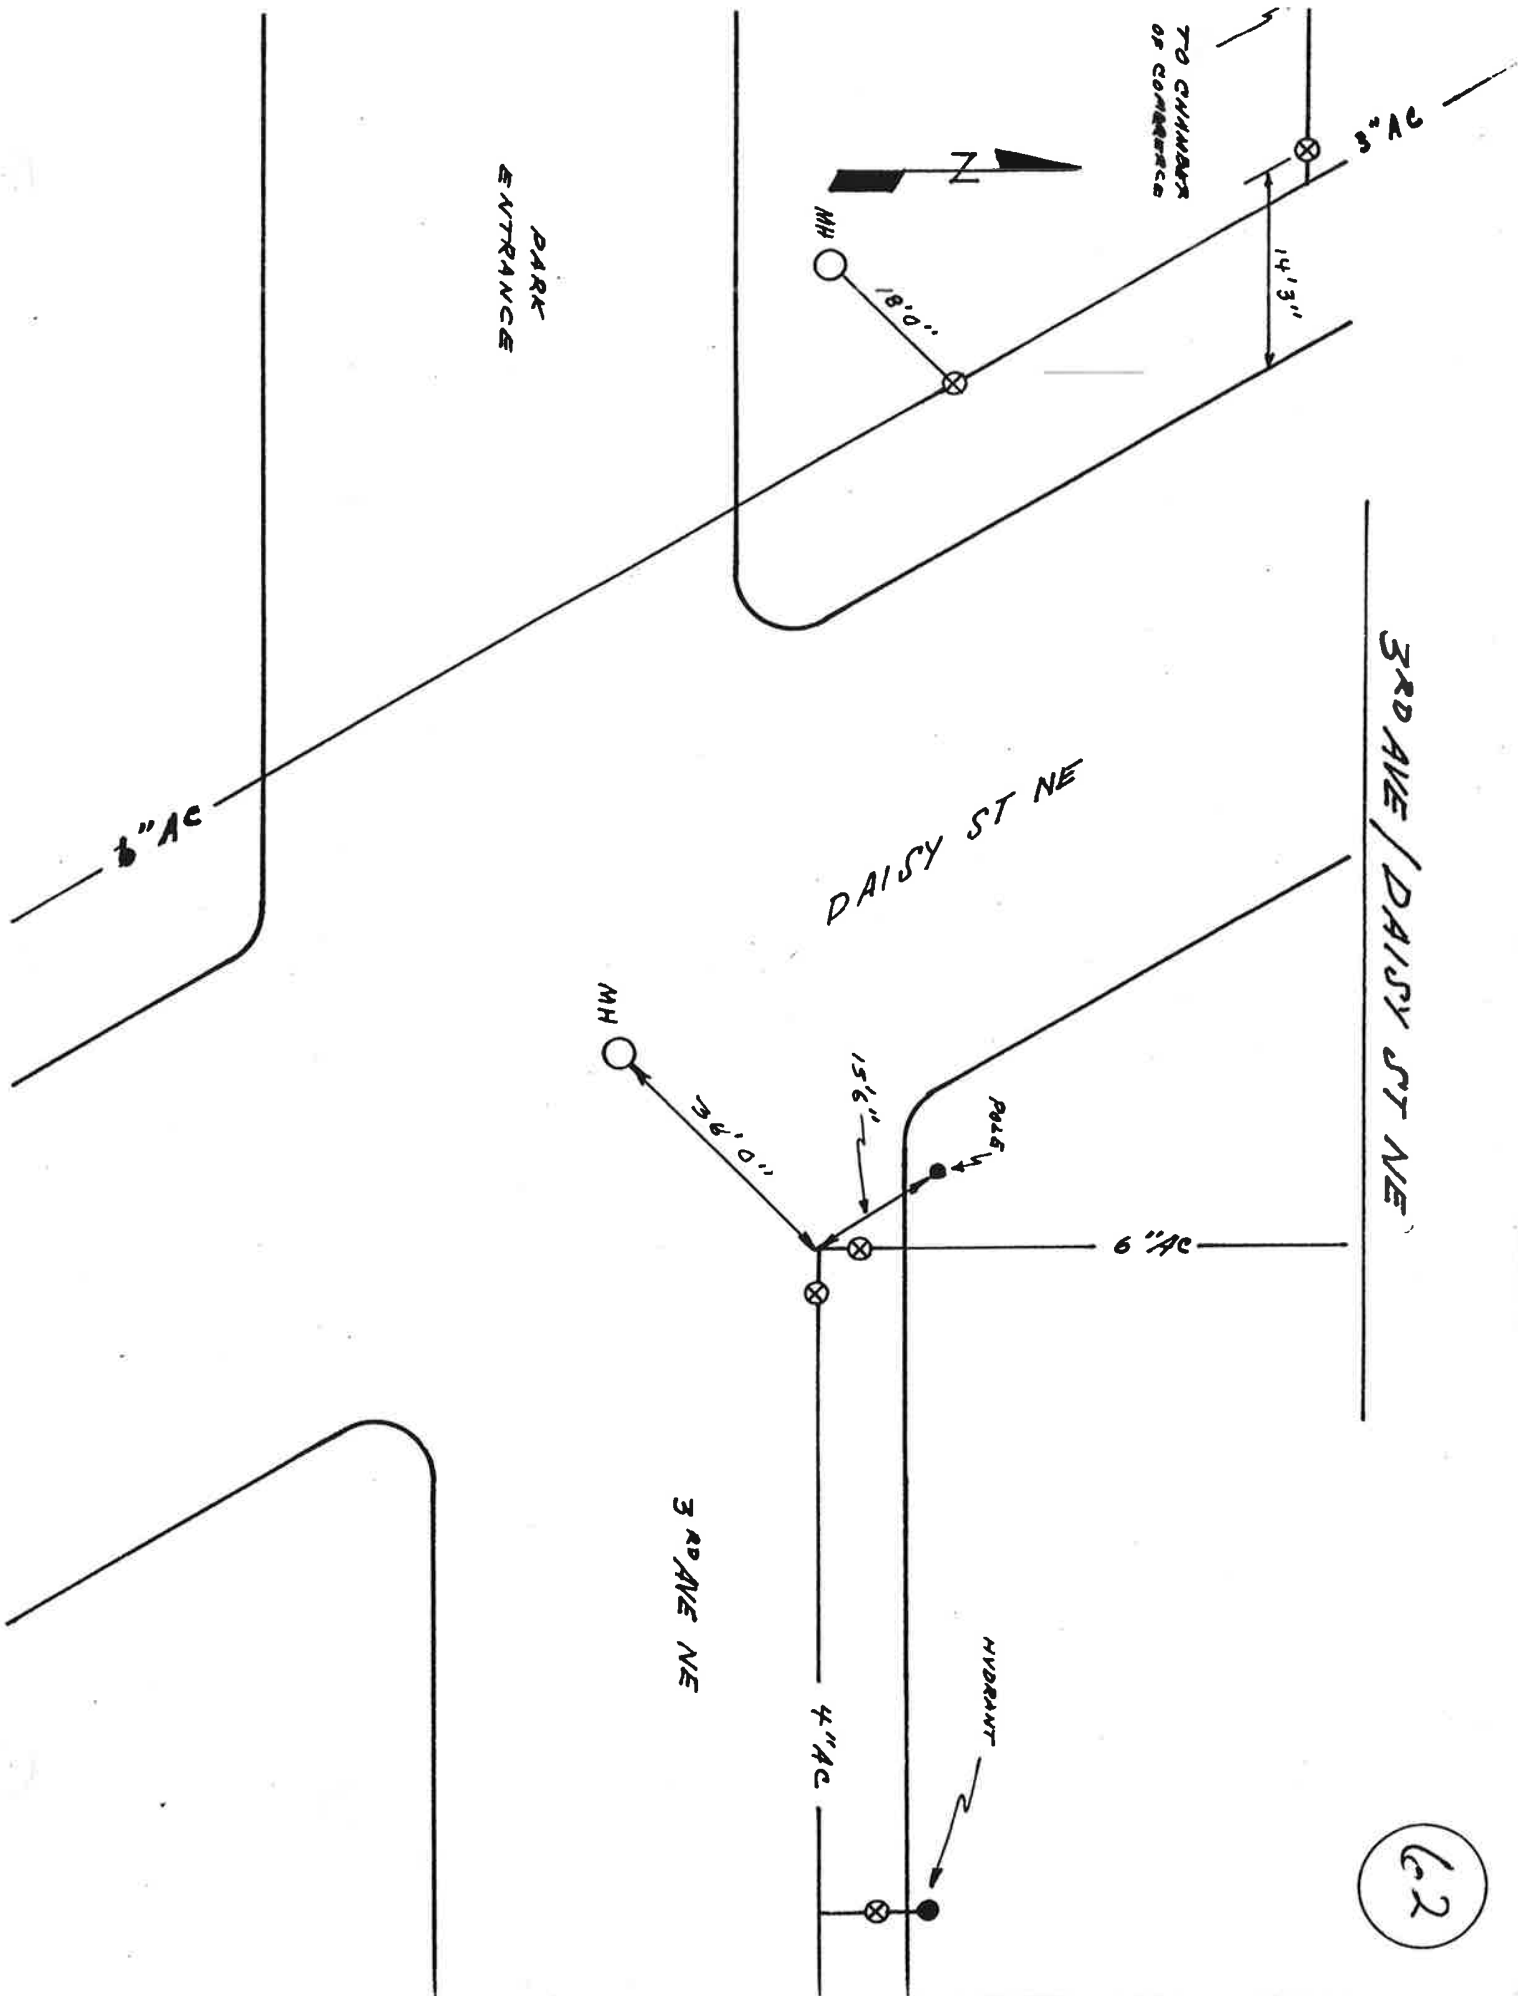

62

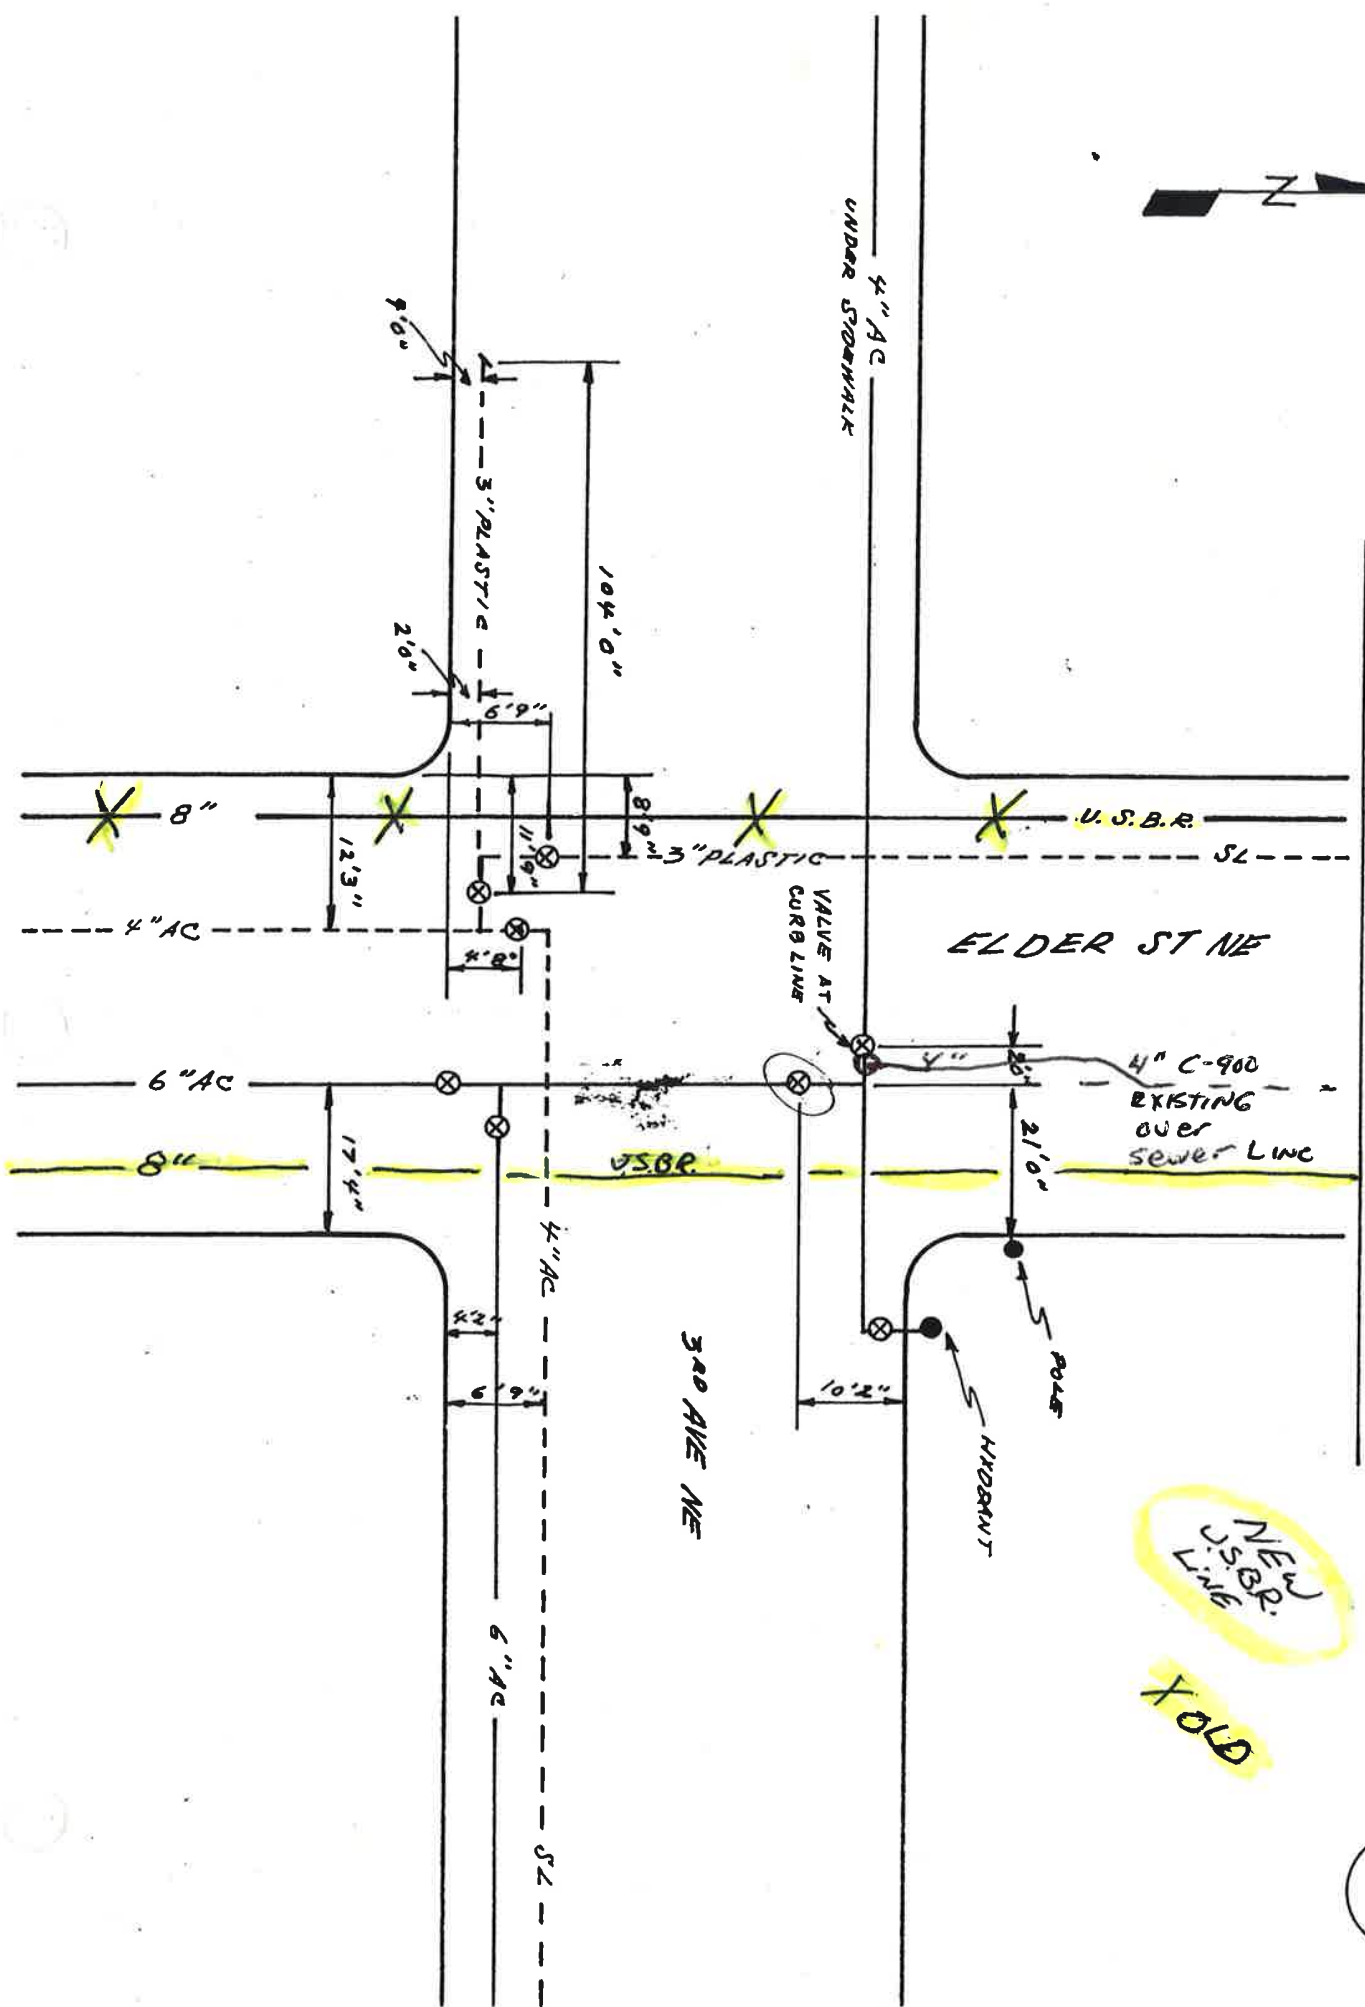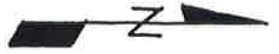

3RD AVE / ELDER ST NE

NEW
U.S.B.R.
LINE

X OLD


63





3RD AVE / FERN ST NE

FERN ST NE


3RD AVE NE

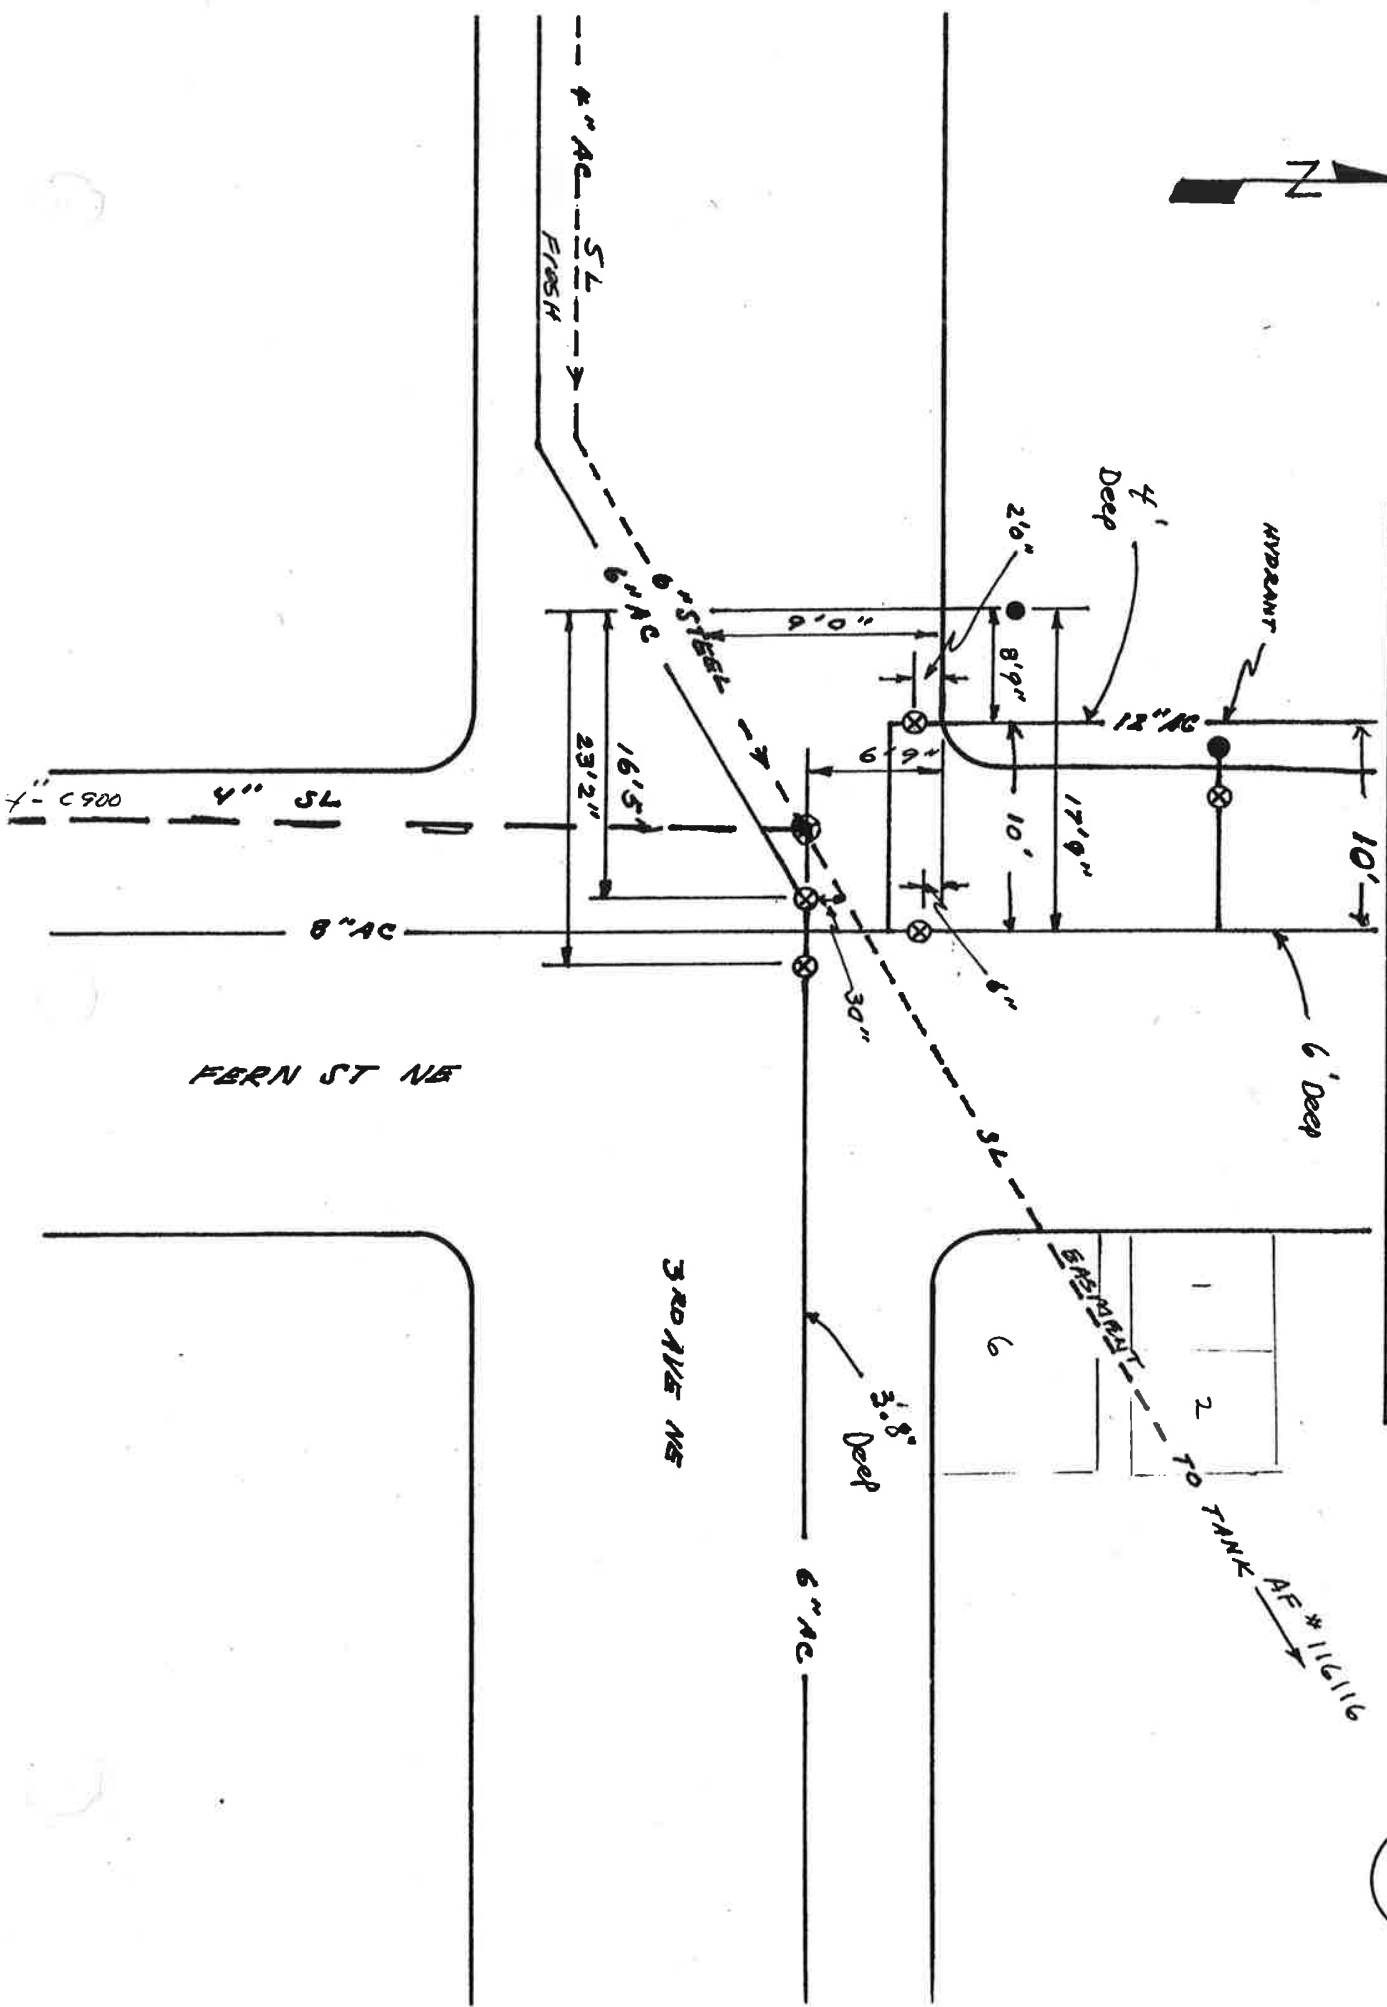



64

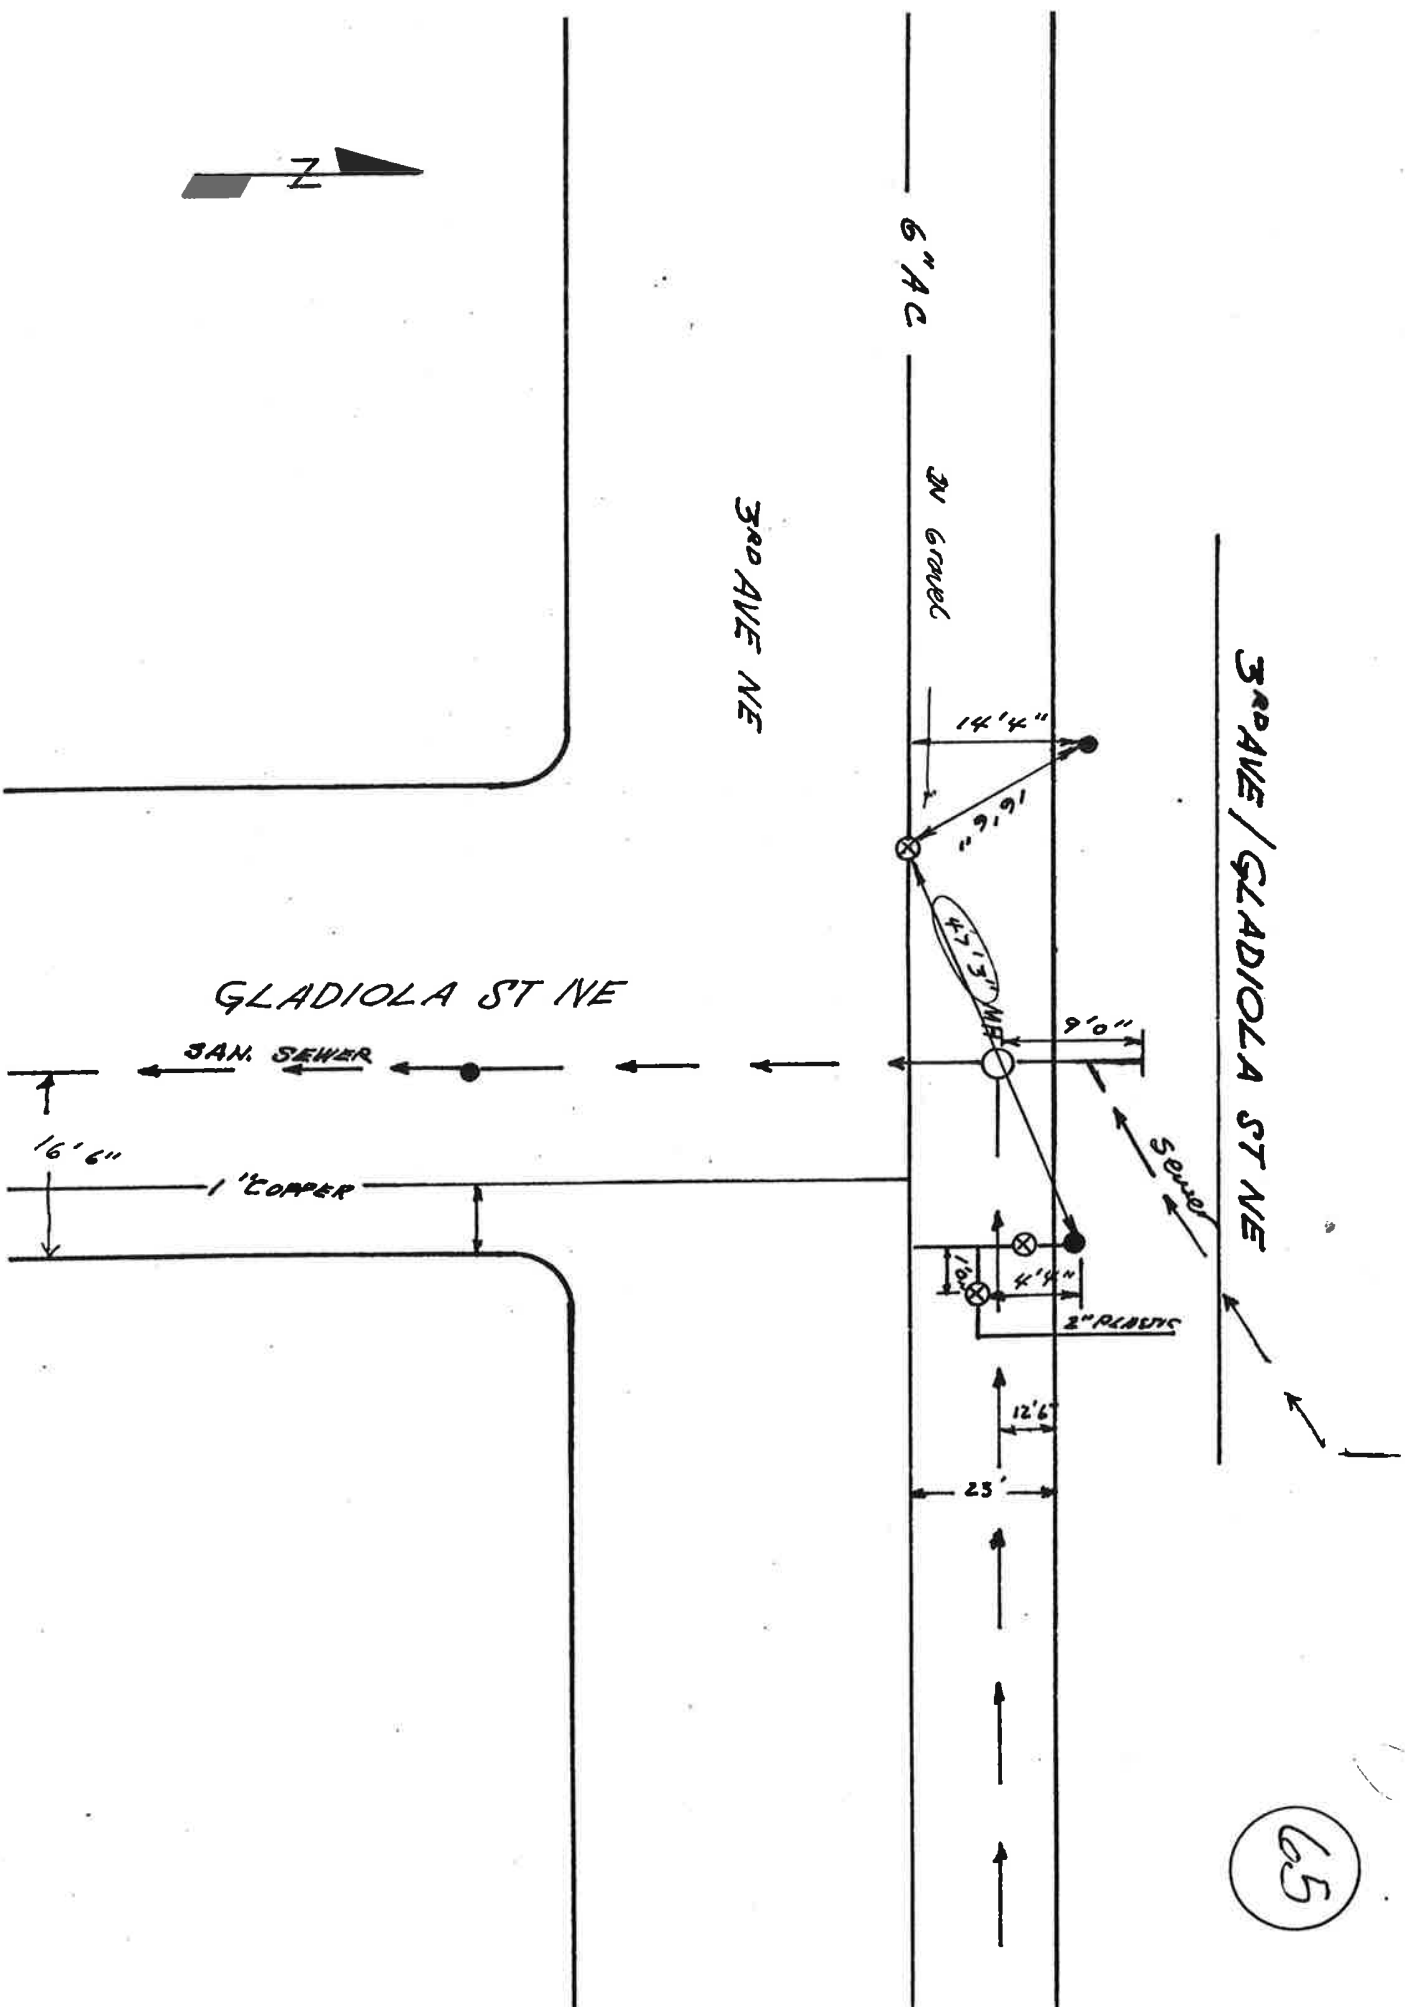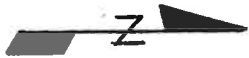


65


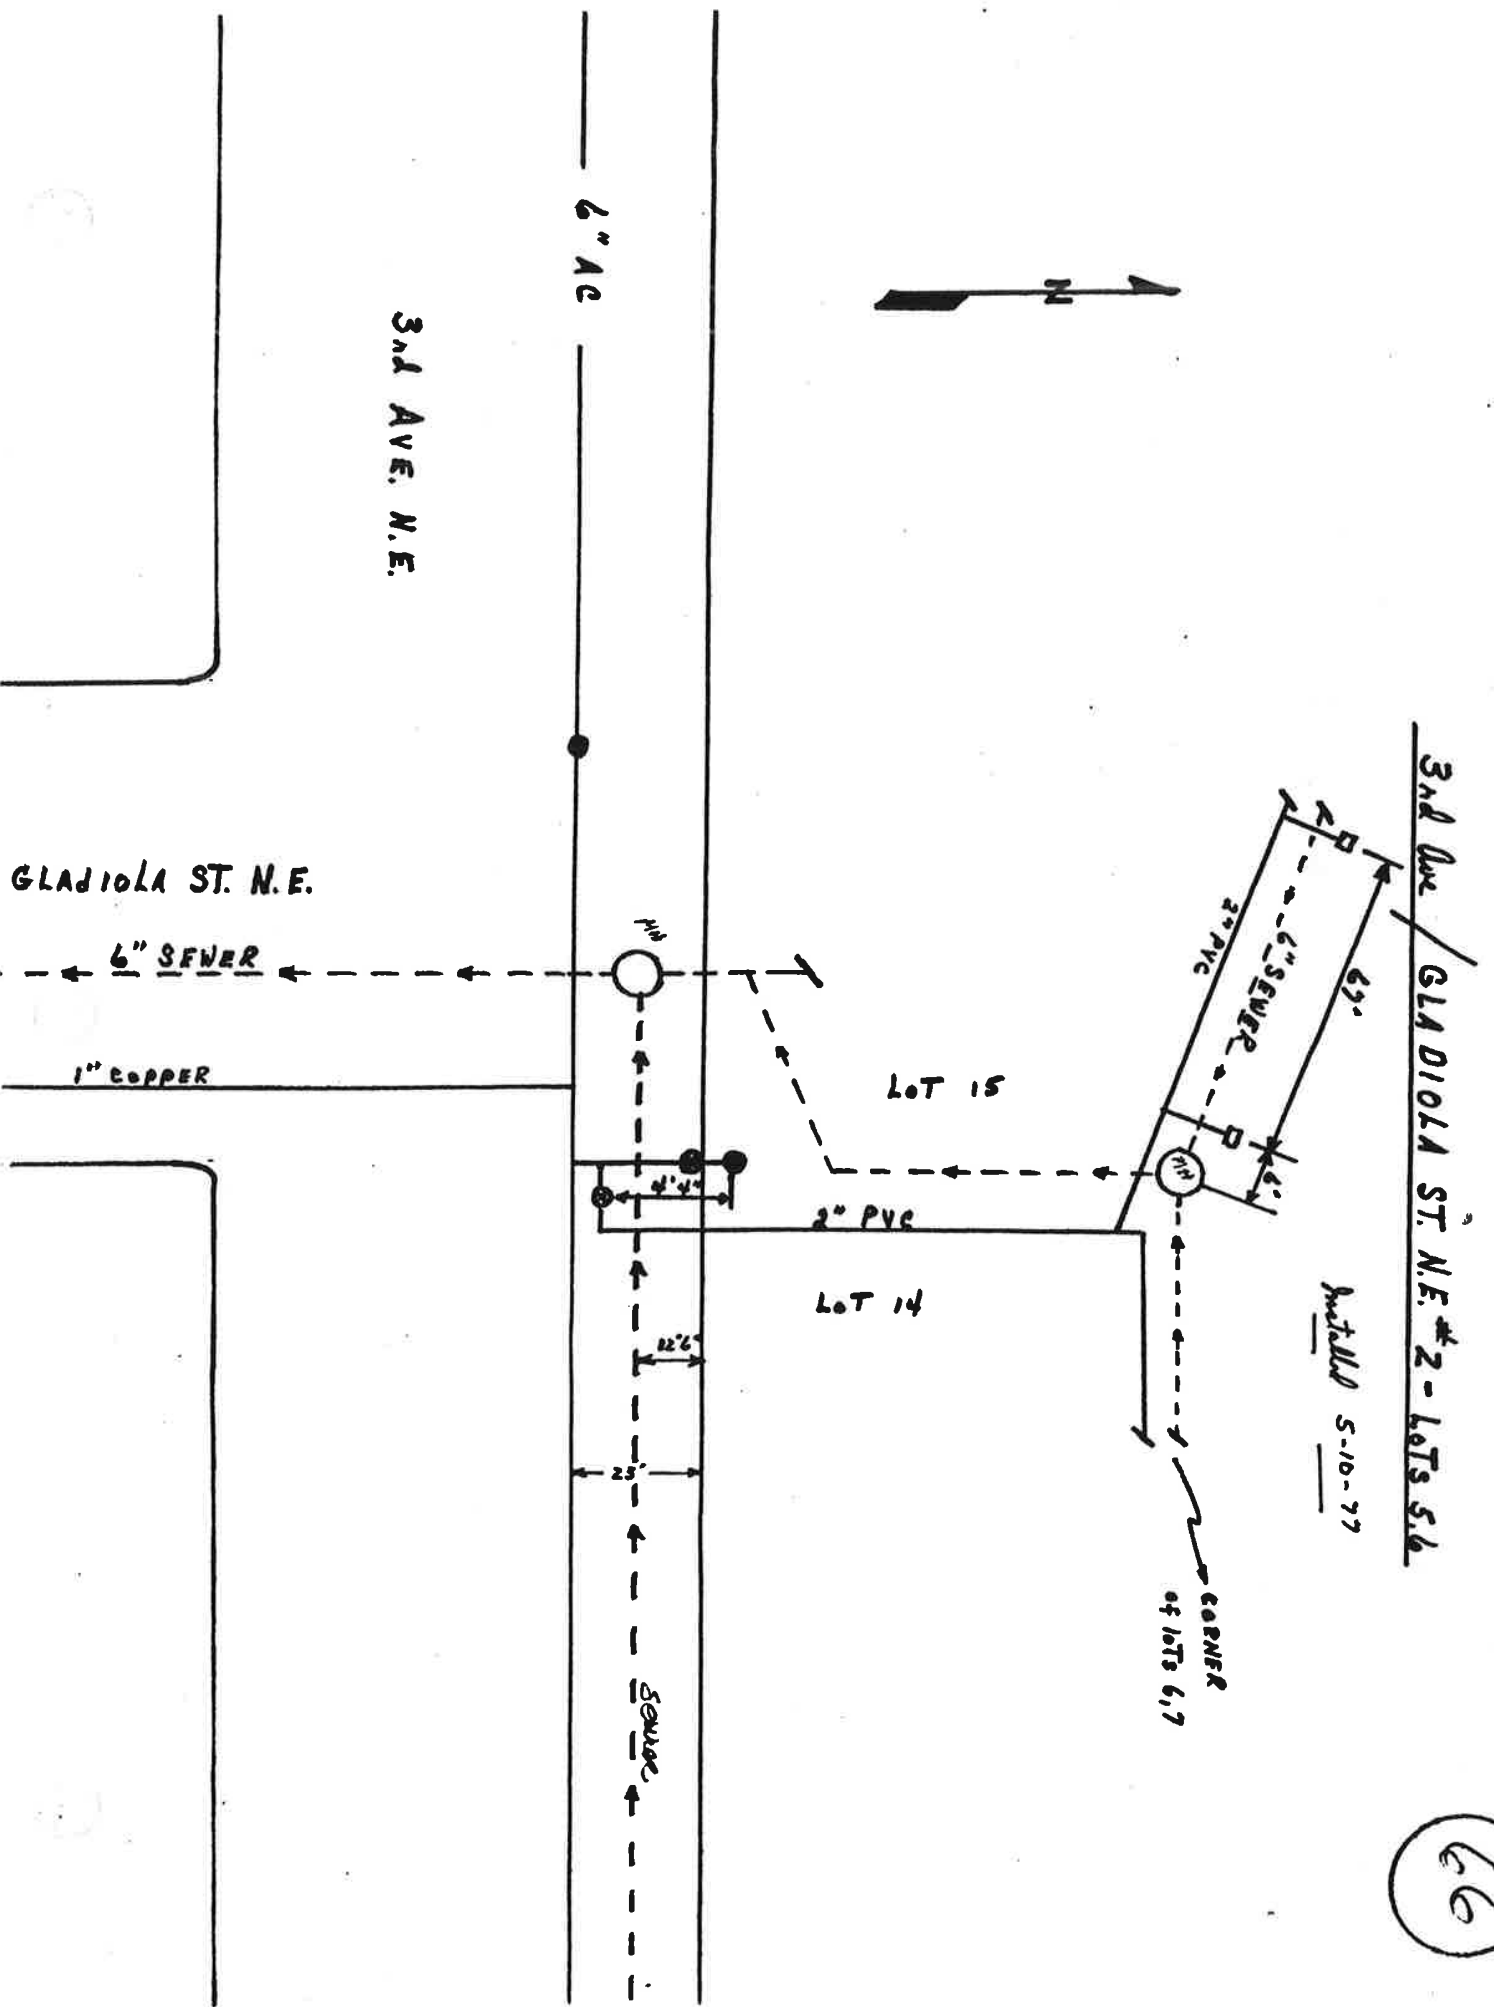


66

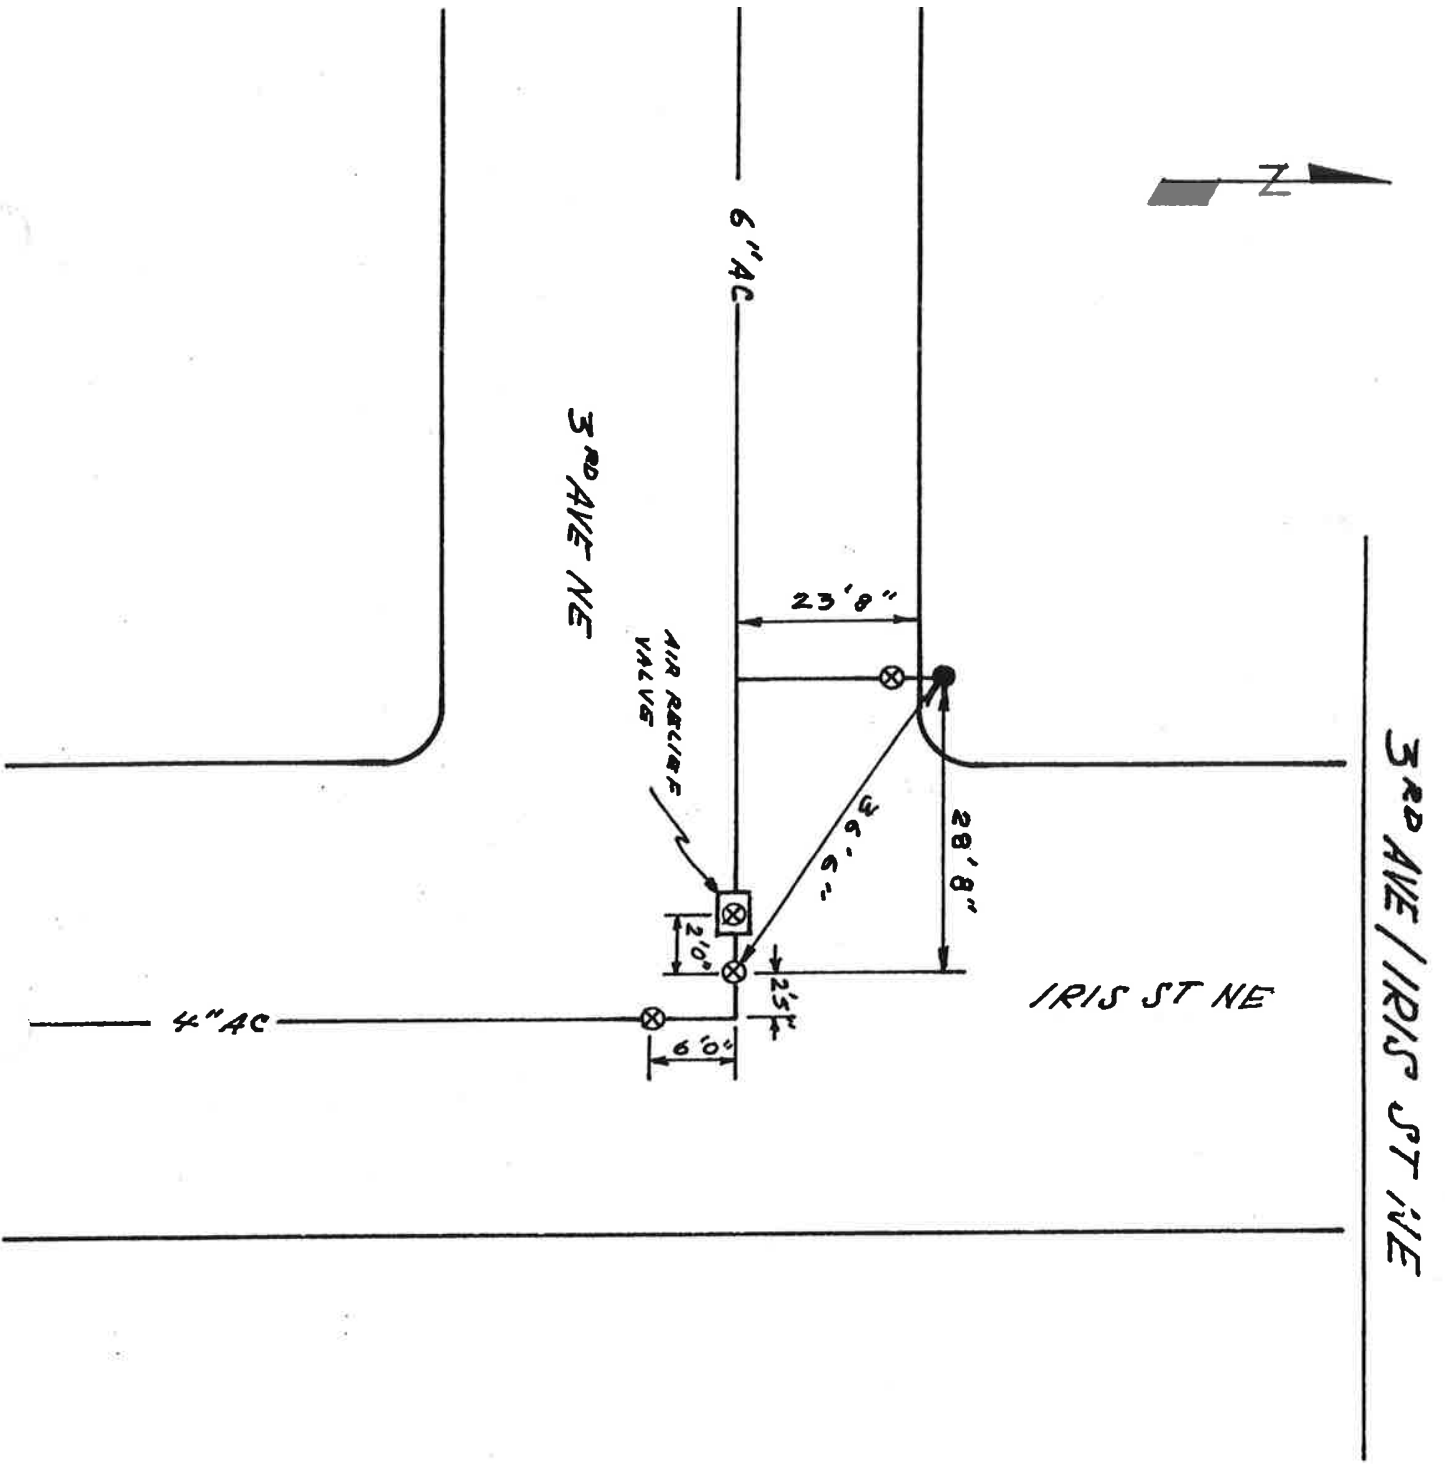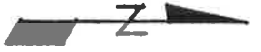


67

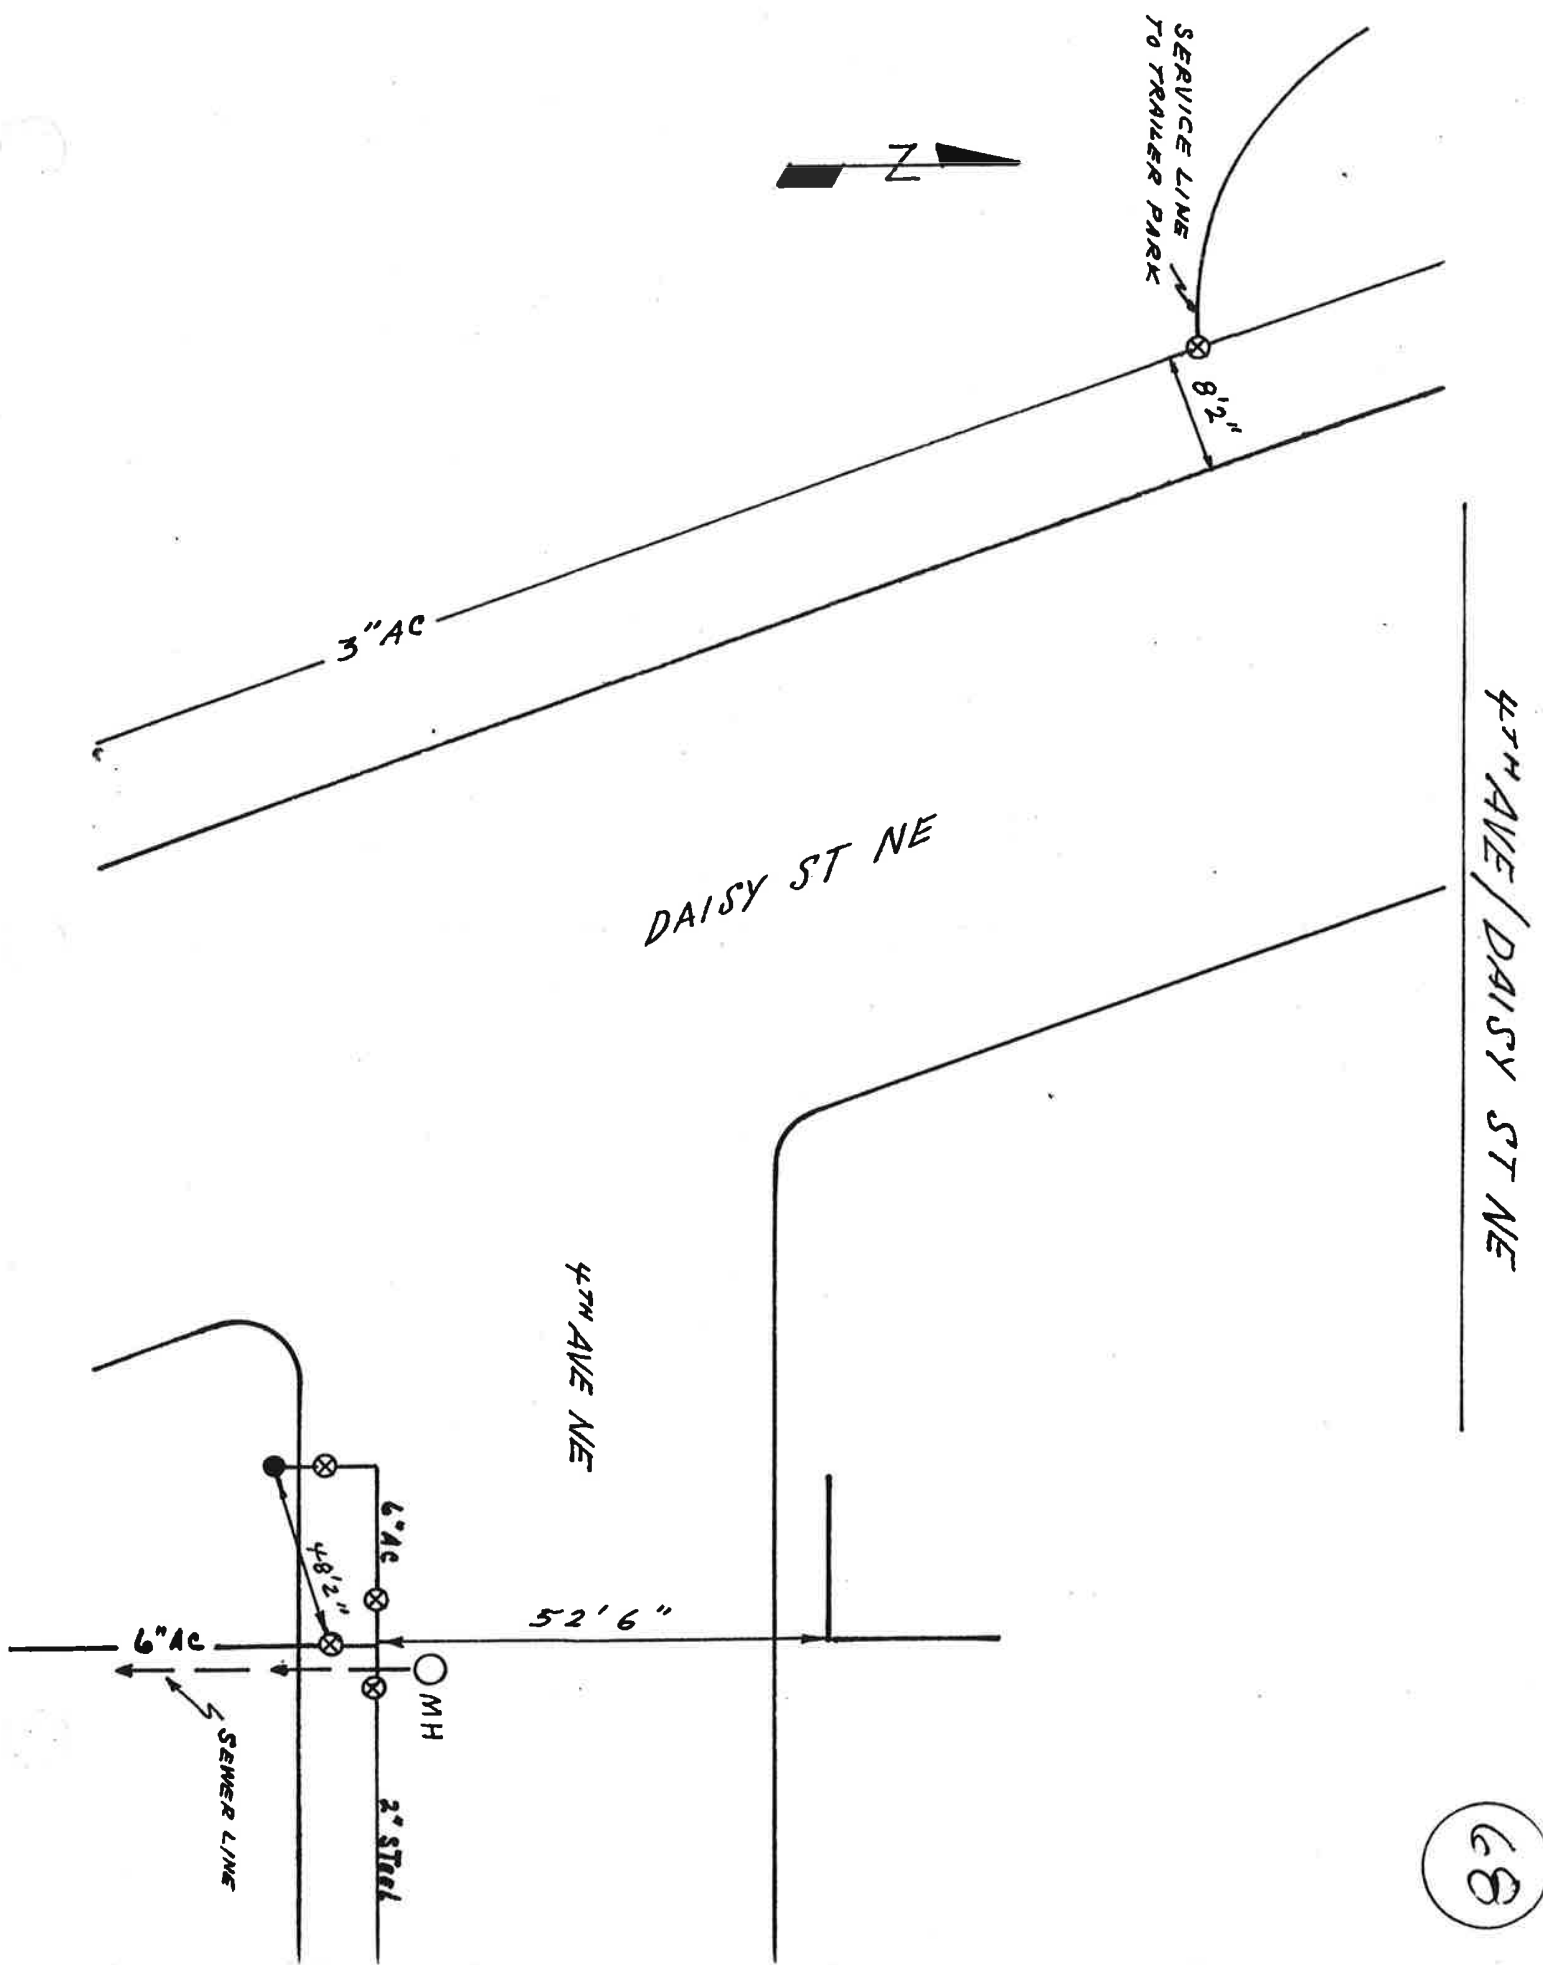

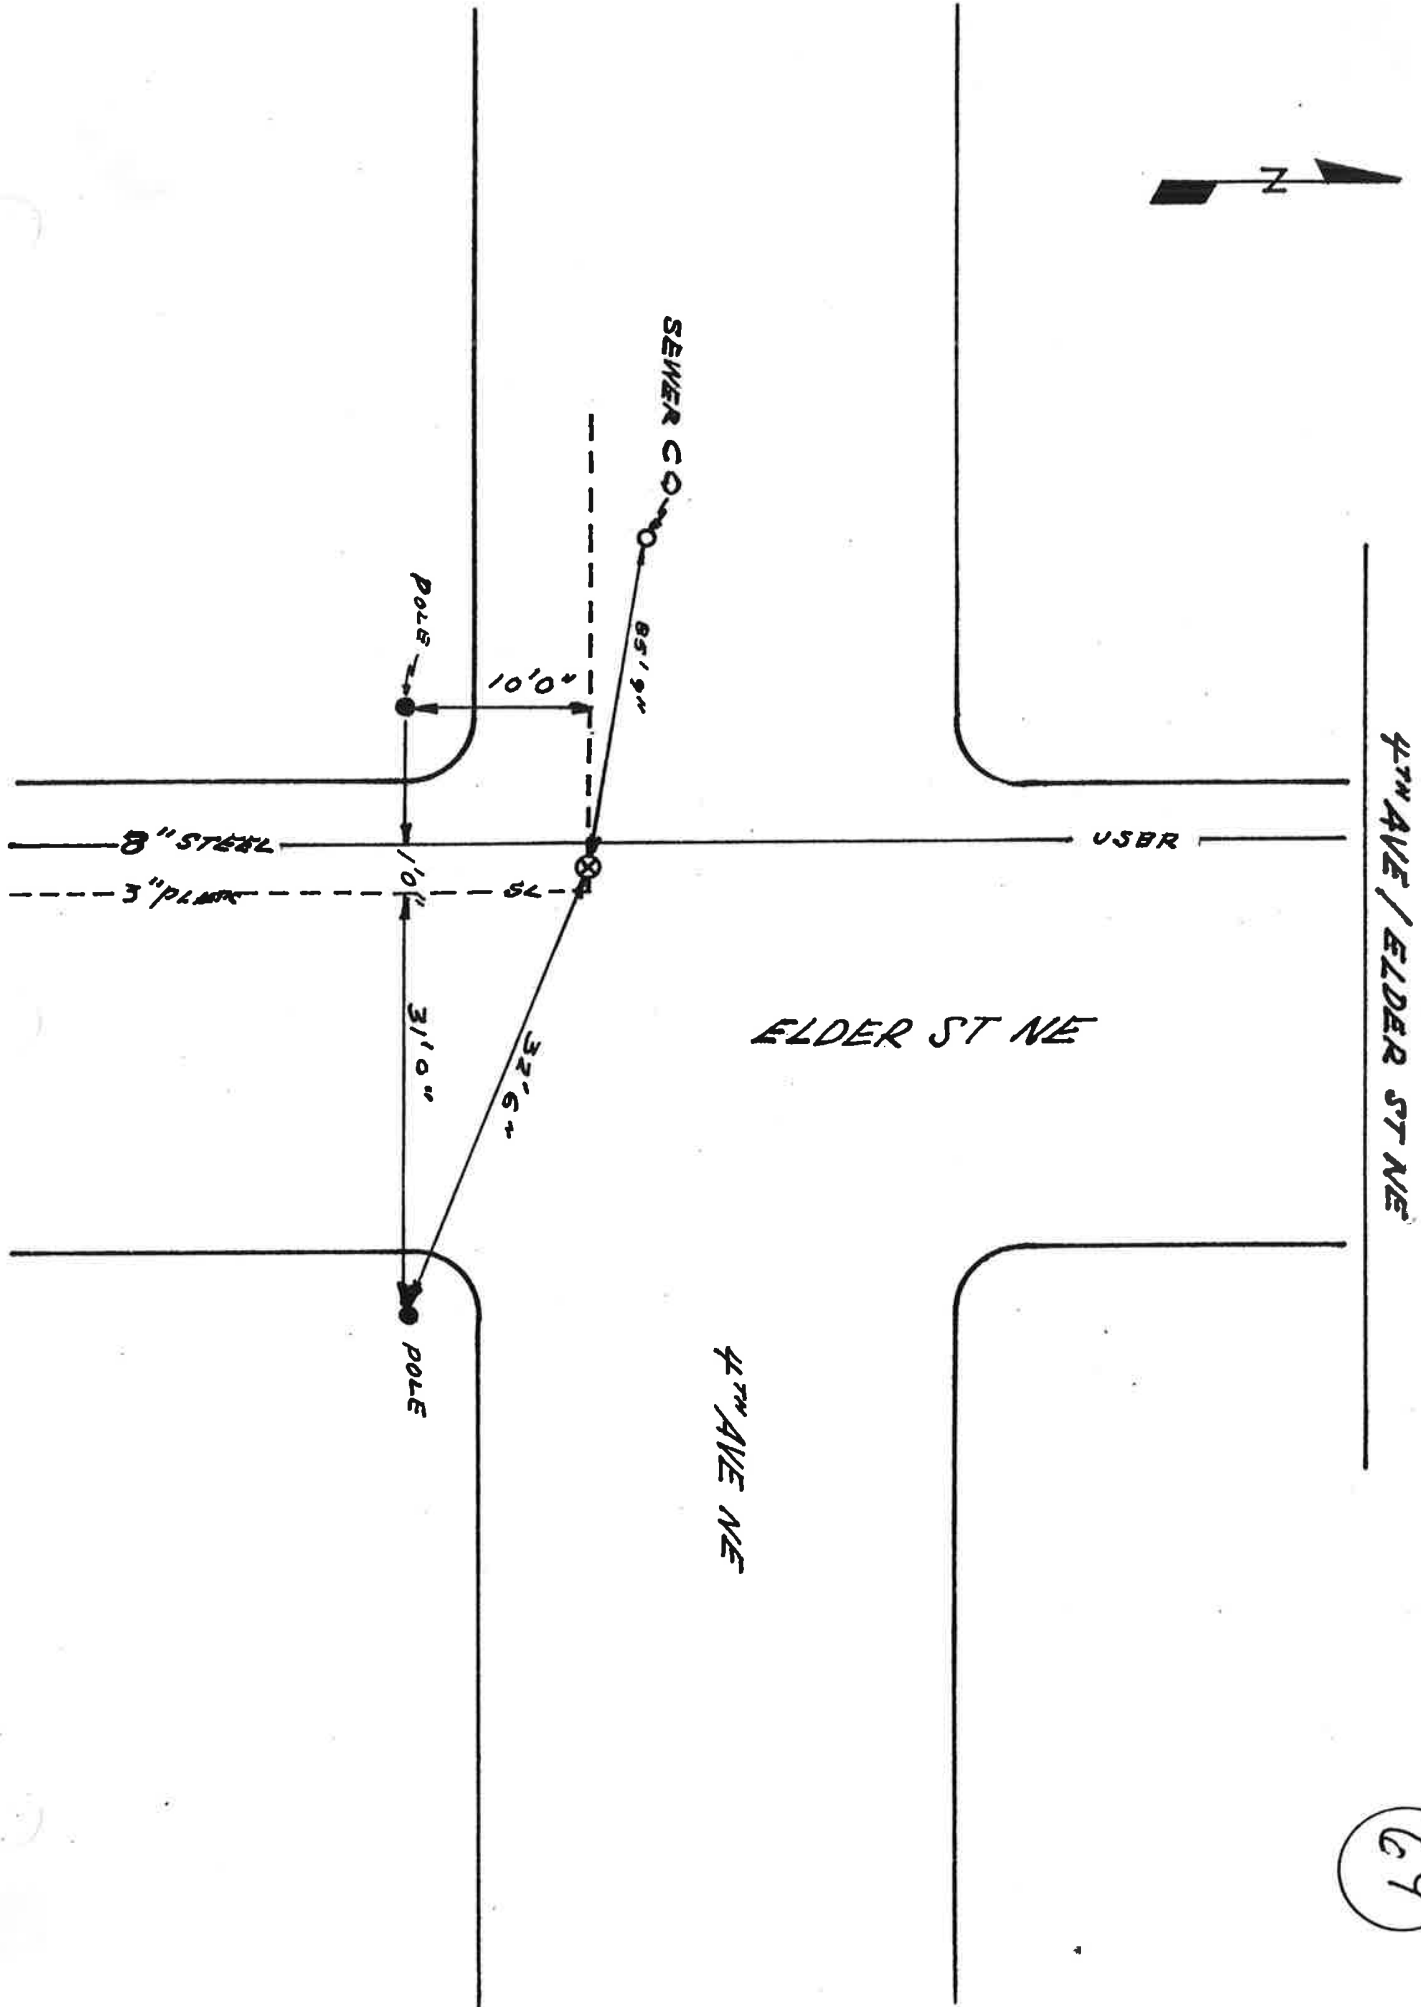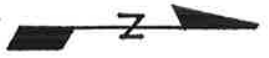

69

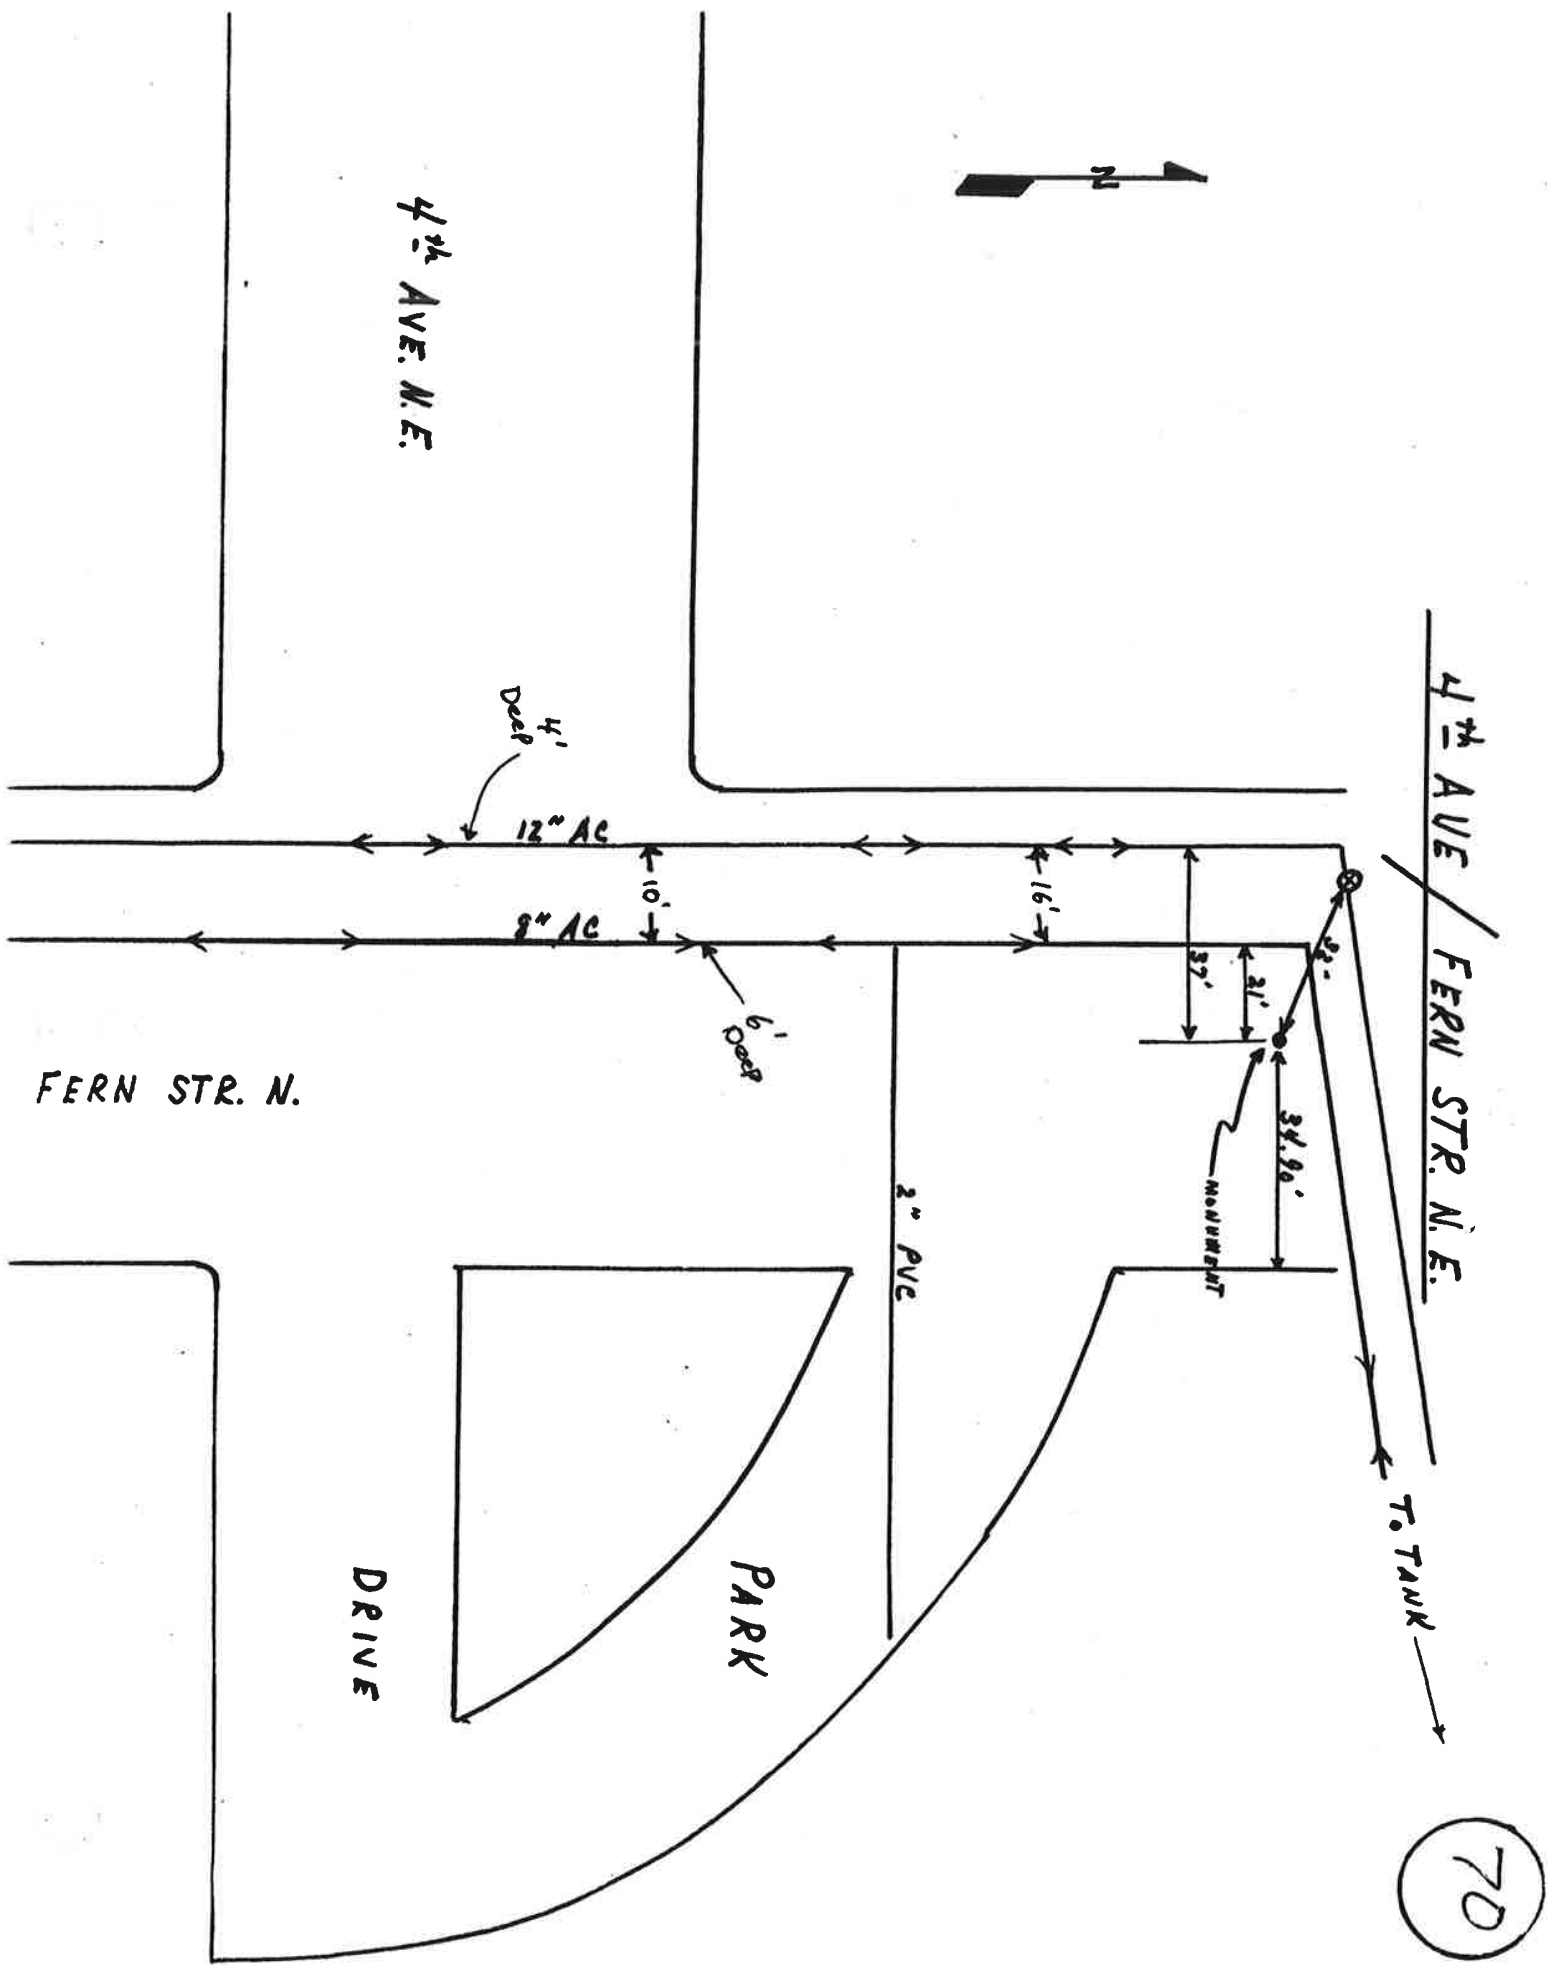

4th AVE. N.E.

4th AVE / FERN STR. N.E.

4' Deep

12" AC

8" AC

6' Deep

FERN STR. N.

2" PVC

MOVEMENT

TO TANK


DRIVE


PARK

70



ENTRANCE TO TRAILER PARK / DAISY ST NE

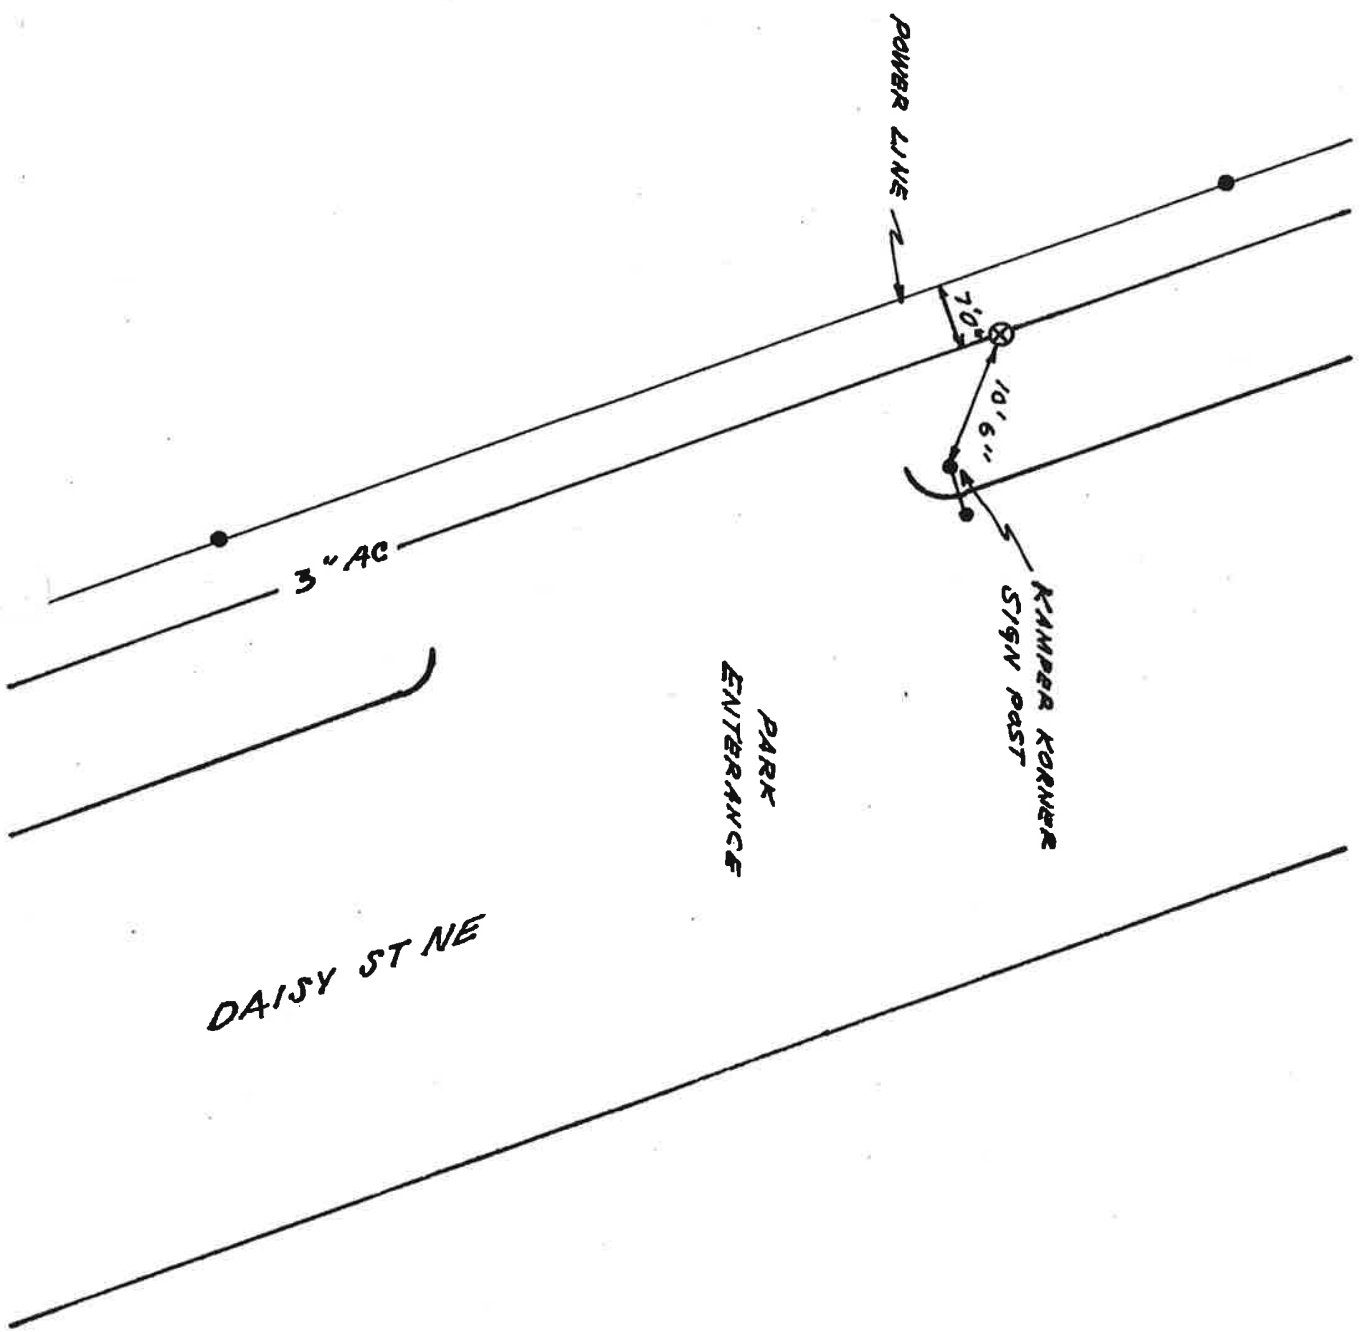

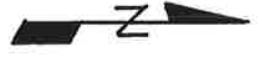


1ST AVE SE


1ST AVE / FERN ST SE


8" AC

FERN ST SE

72

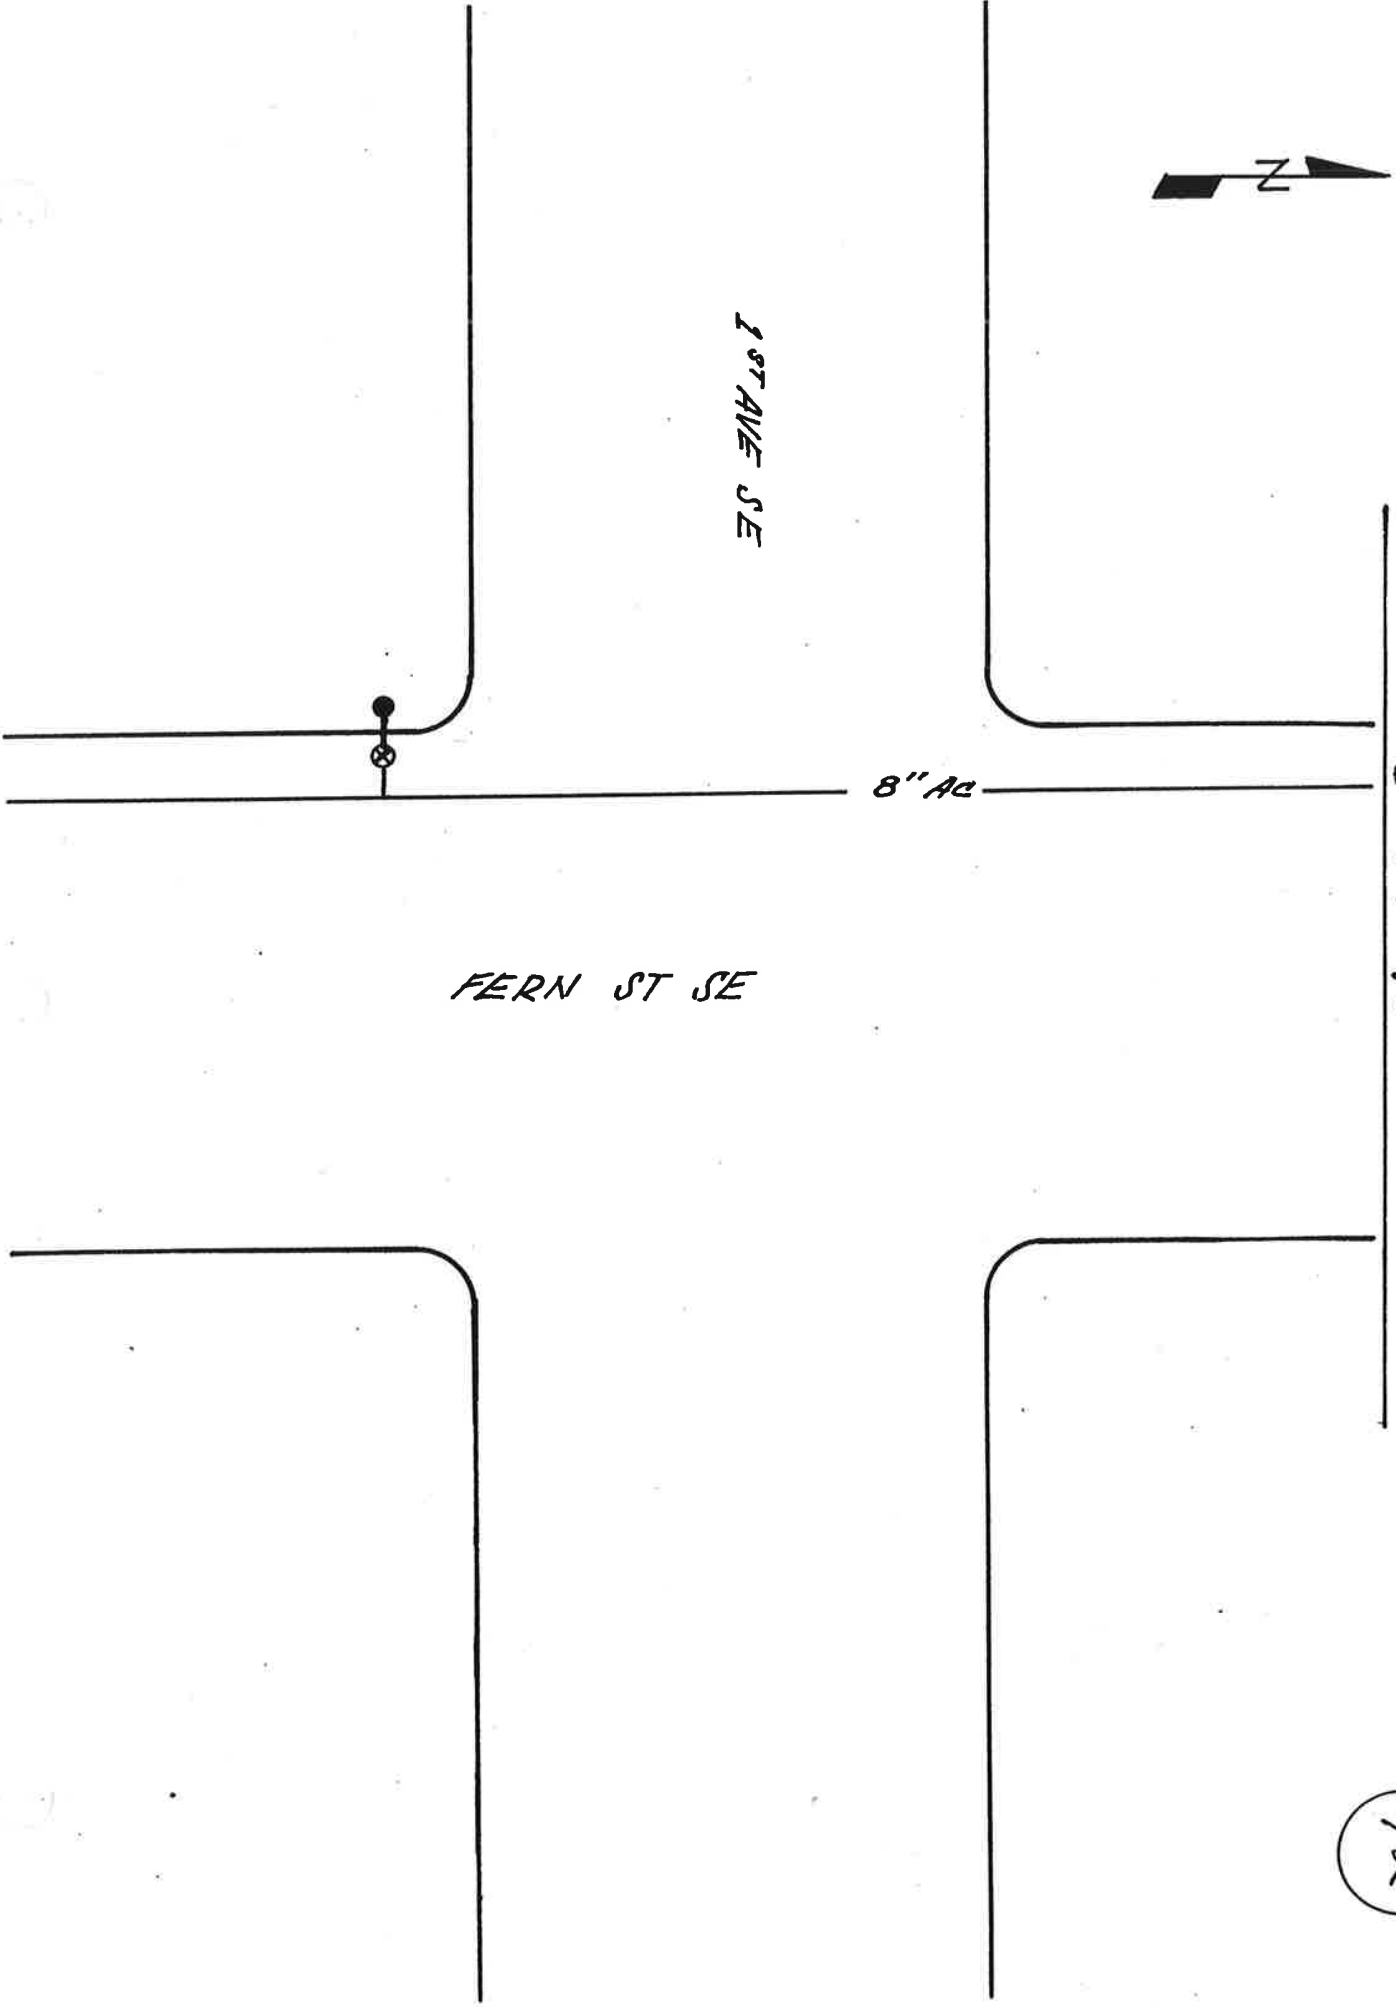


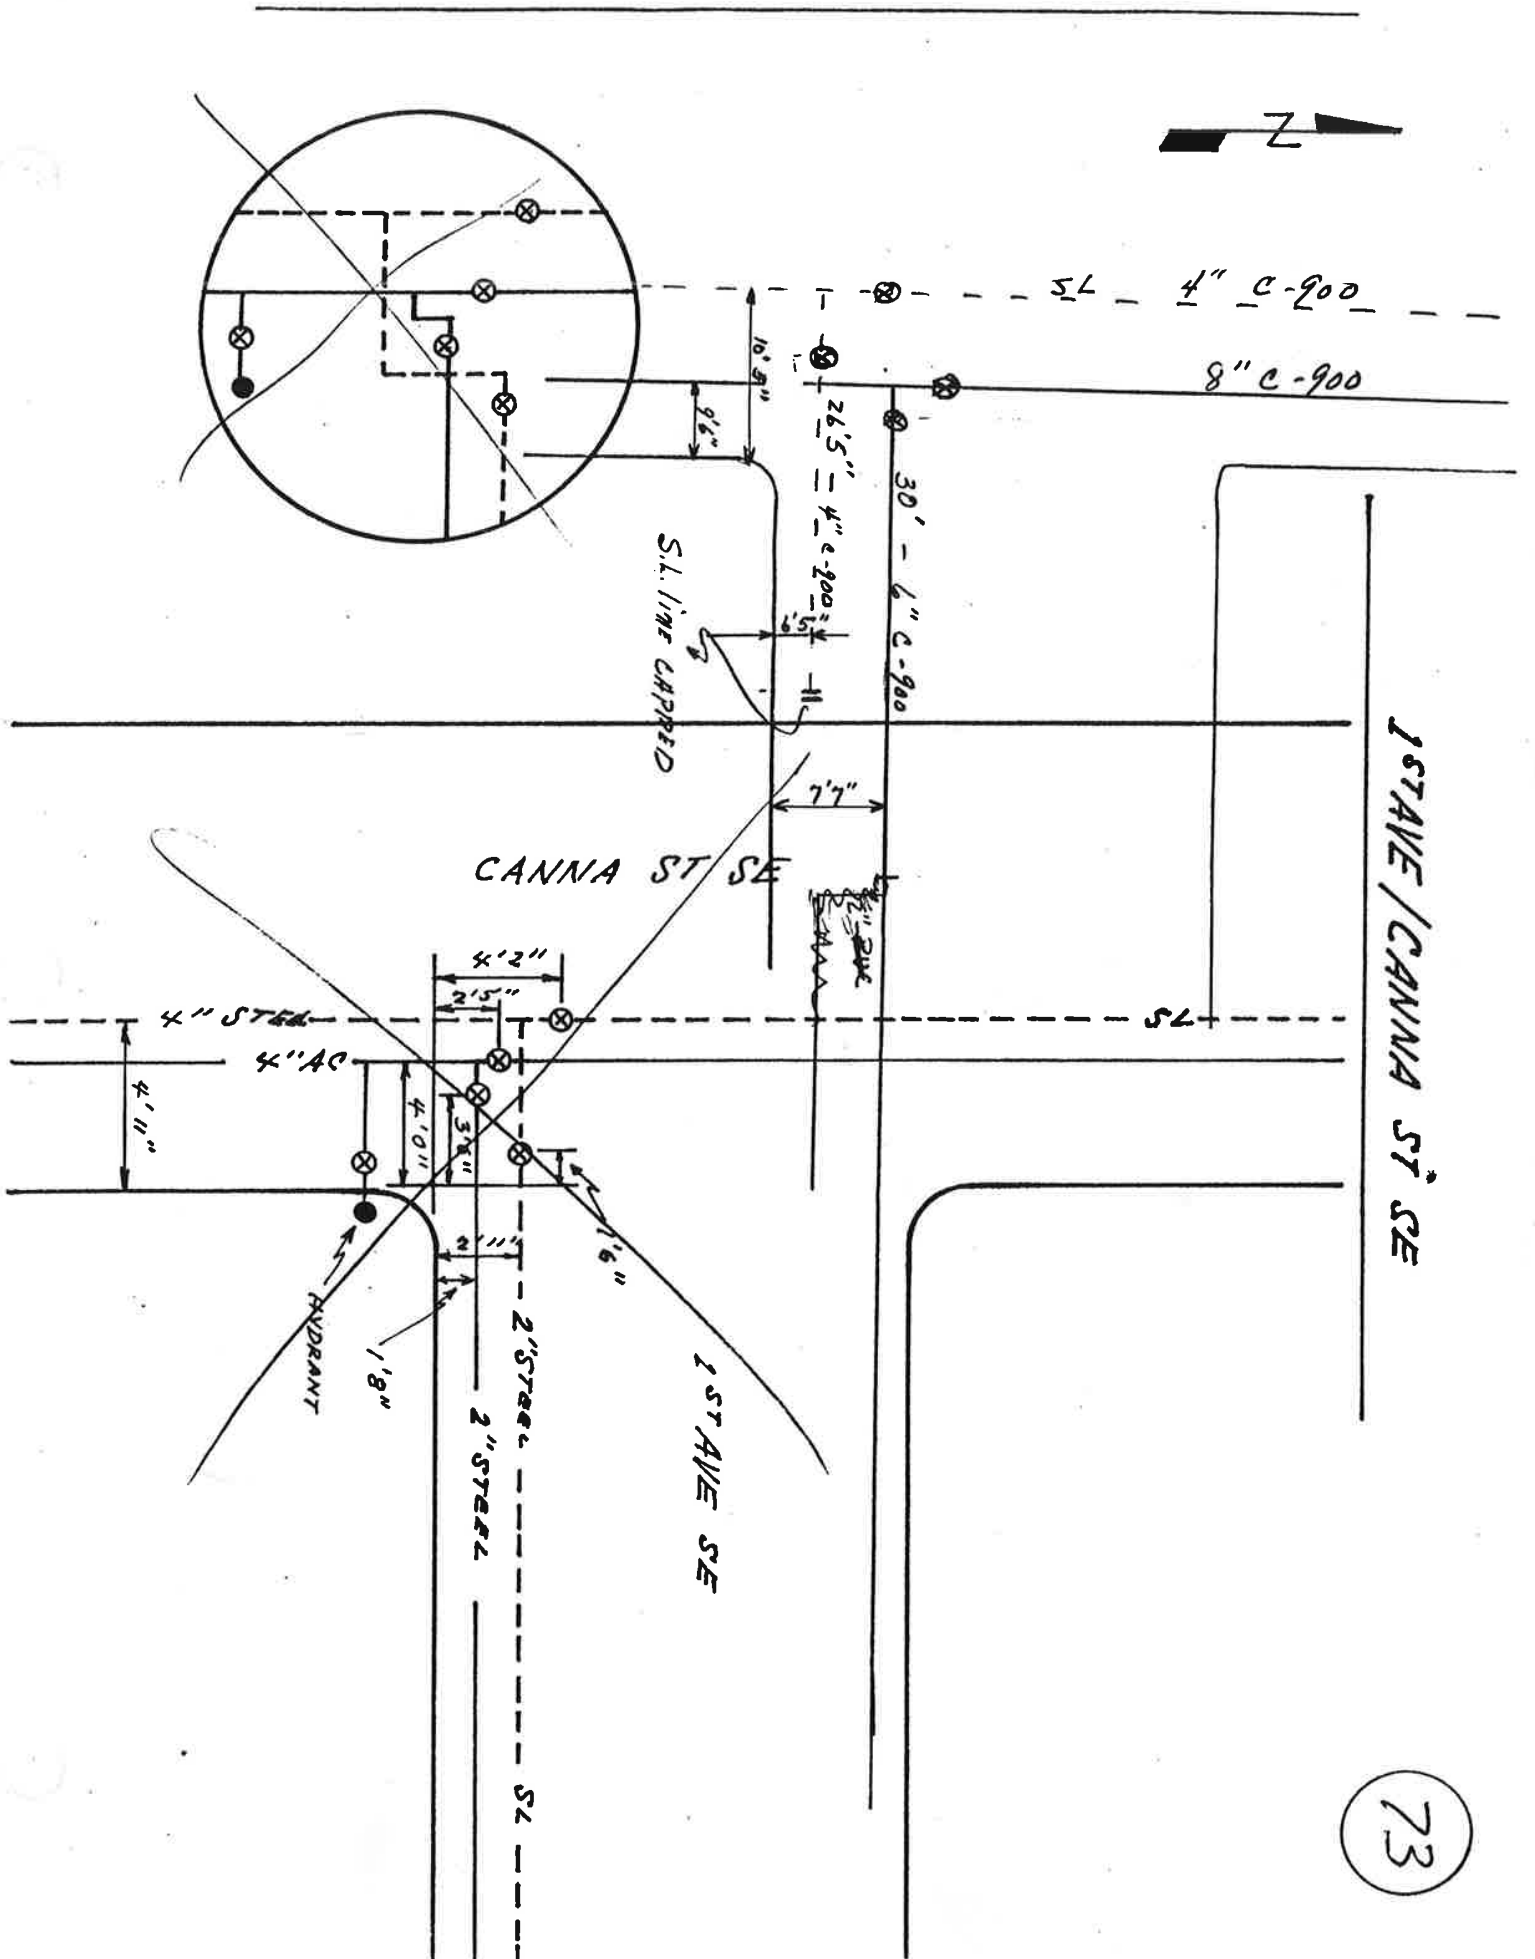

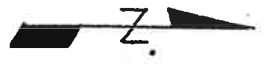

1ST AVE / DAISY ST SE

74

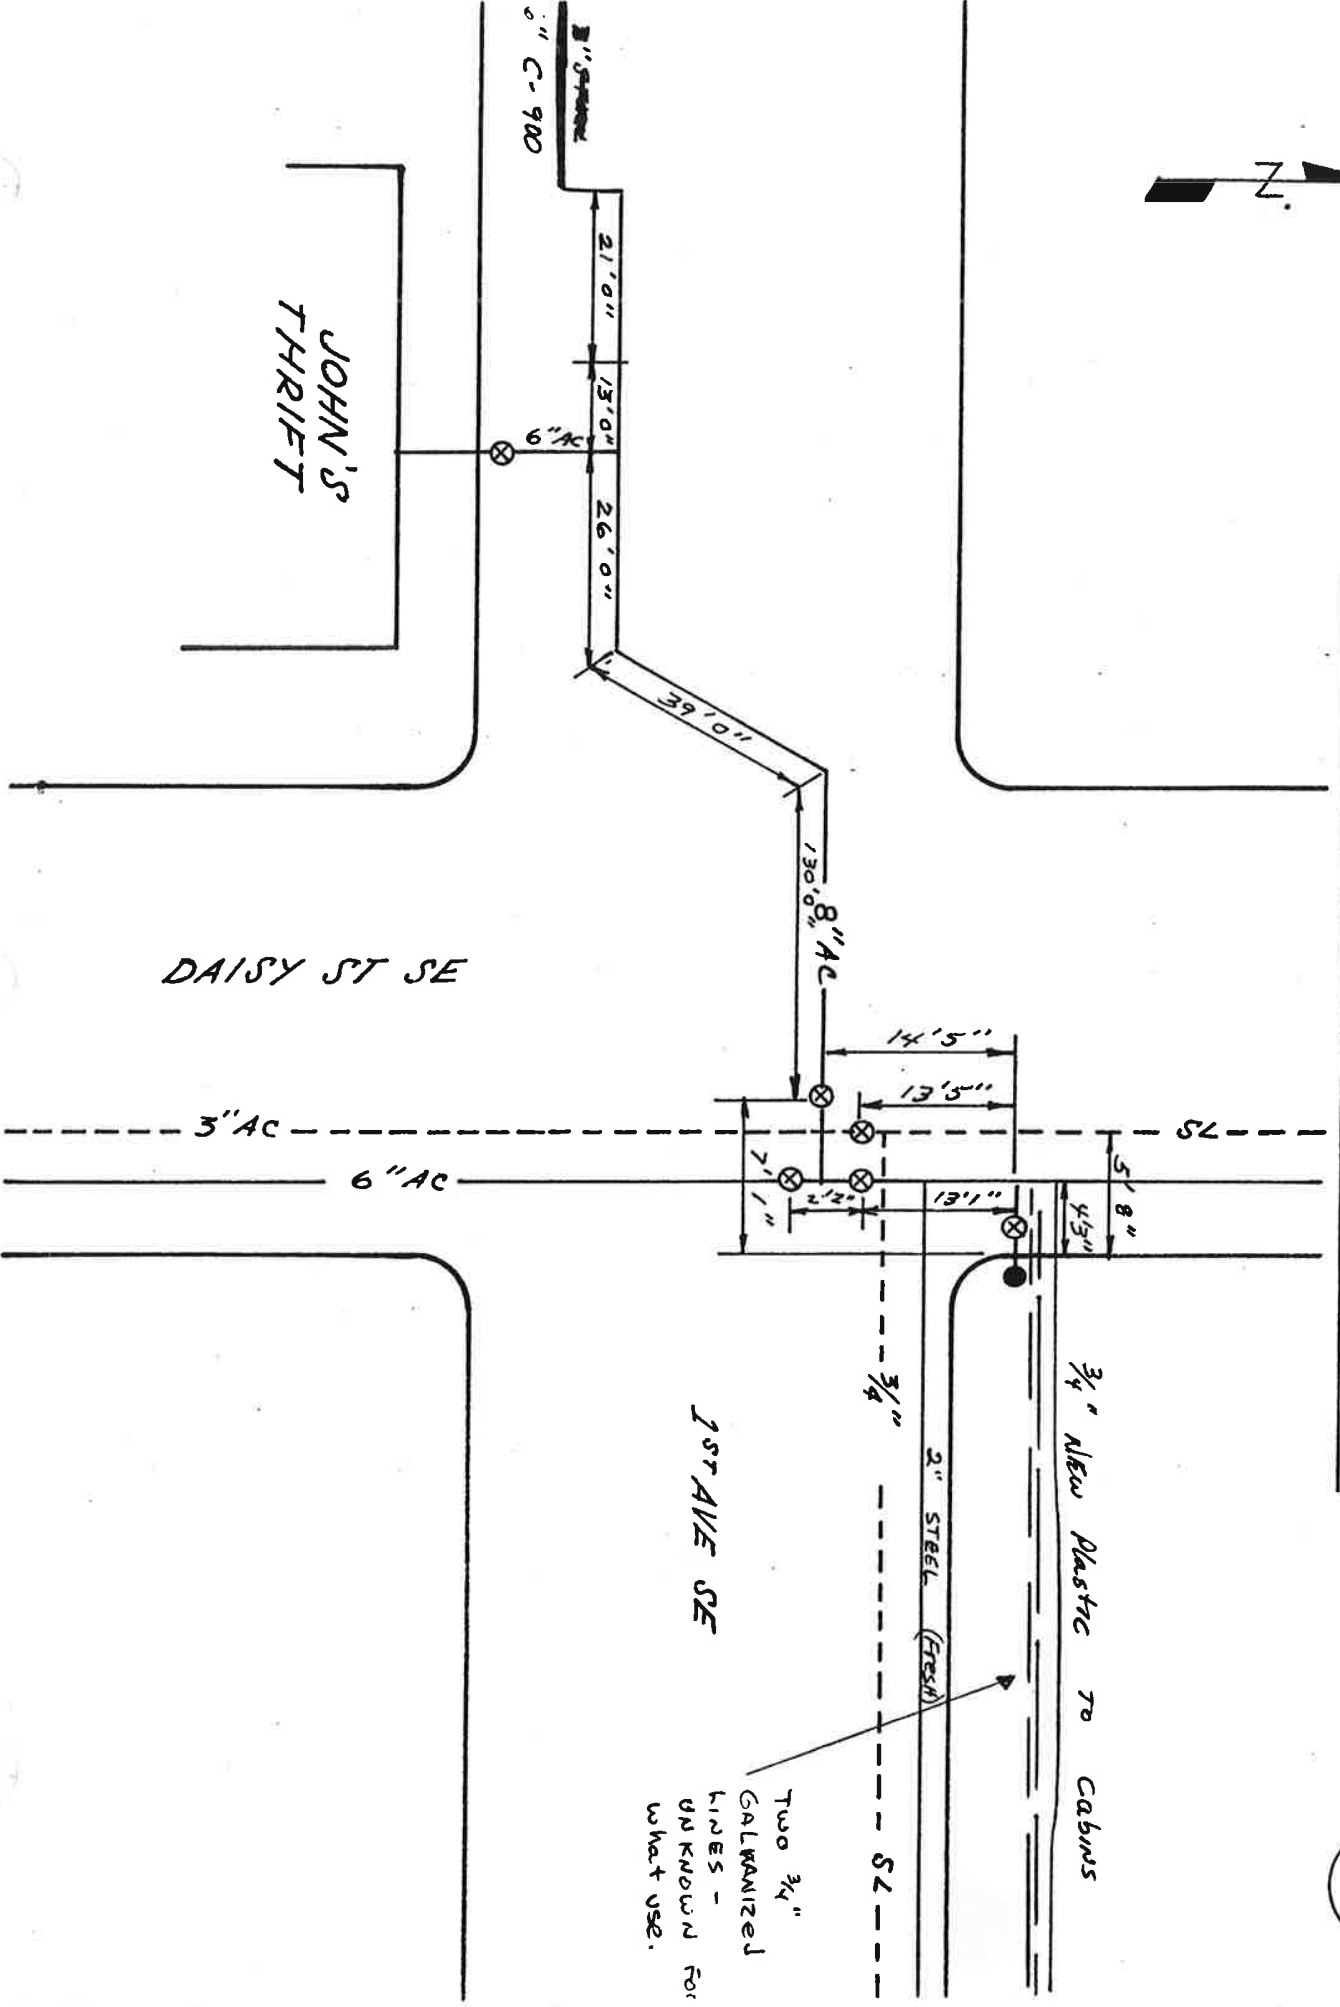

JOHN'S THRIFT

DAISY ST SE

1ST AVE SE

3/4" New Plastic to Cabins

2" STEEL (FRESH)

3/4"

S2

Two 3/4" GALVANIZED LINES - UNKNOWN FOR WHAT USE.

8" WATER
6" C-900

21'0"

13'0"

26'0"

39'0"

130'0"

8" AC

14'5"

13'5"

13'1"

5'8"


4'5"

7'1"

2'2"


3" AC


6" AC

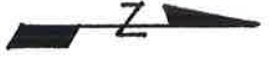

1st AVE / ELDER ST SE

75

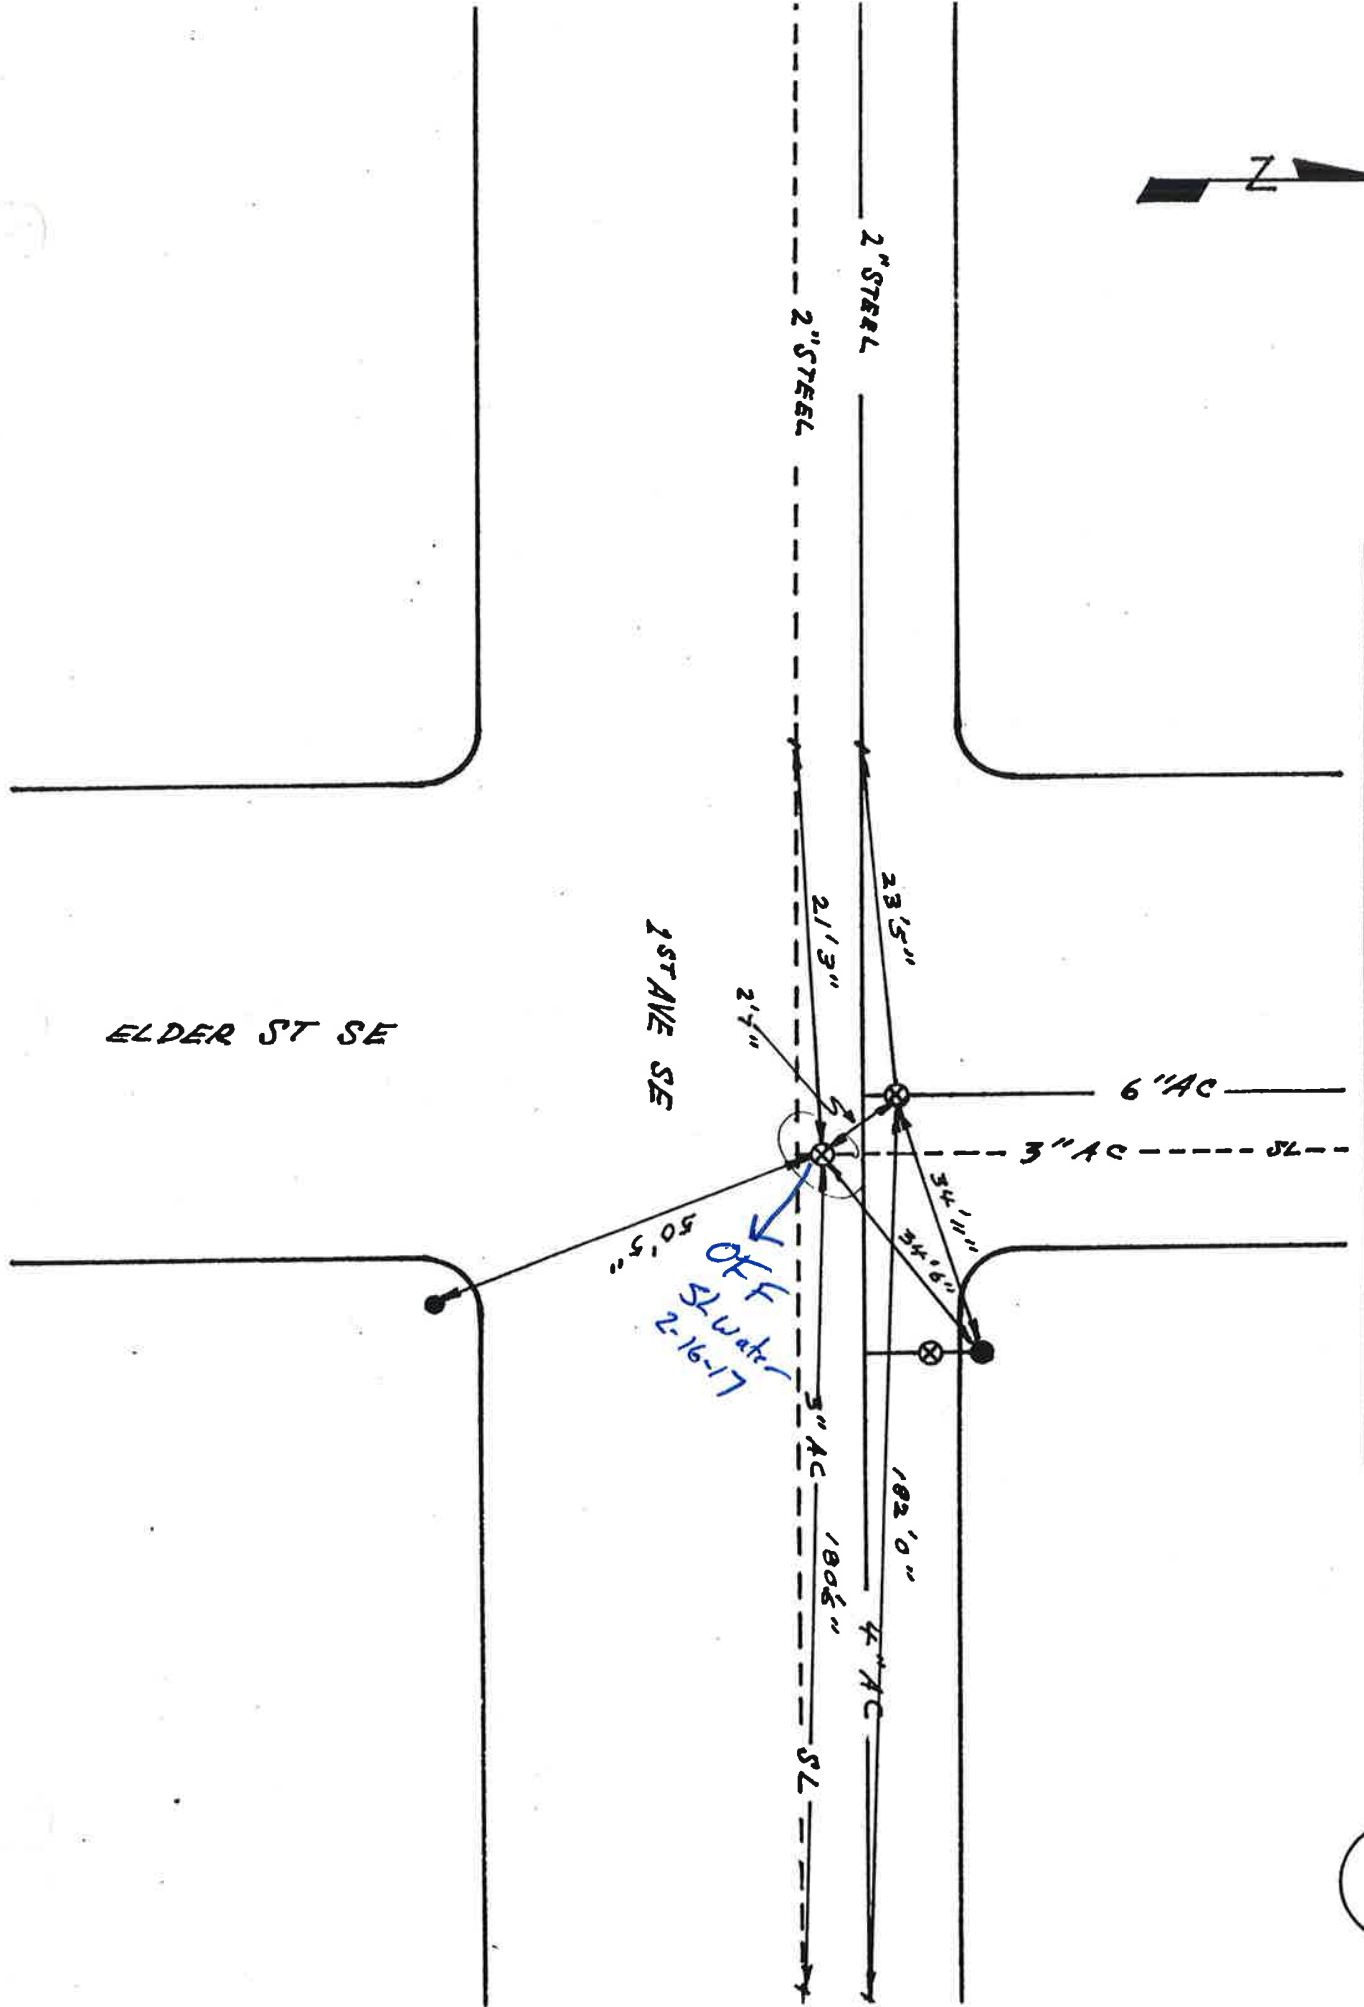

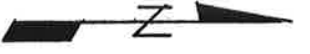

2ND AVE / ASTER ST SE

76

2ND AVE SE

4" AC

8' 6"




2' 0" 7' 1"

2" GALV

8' 6"

ASTER ST SE

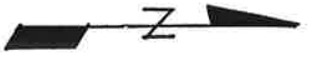

2ND AVE / BUTTERCUP ST SE

77

2ND AVE SE


2" STEEL

±0.6'

BUTTERCUP ST SE


END OF LINE
219 2ND AVE SE


METER BOX

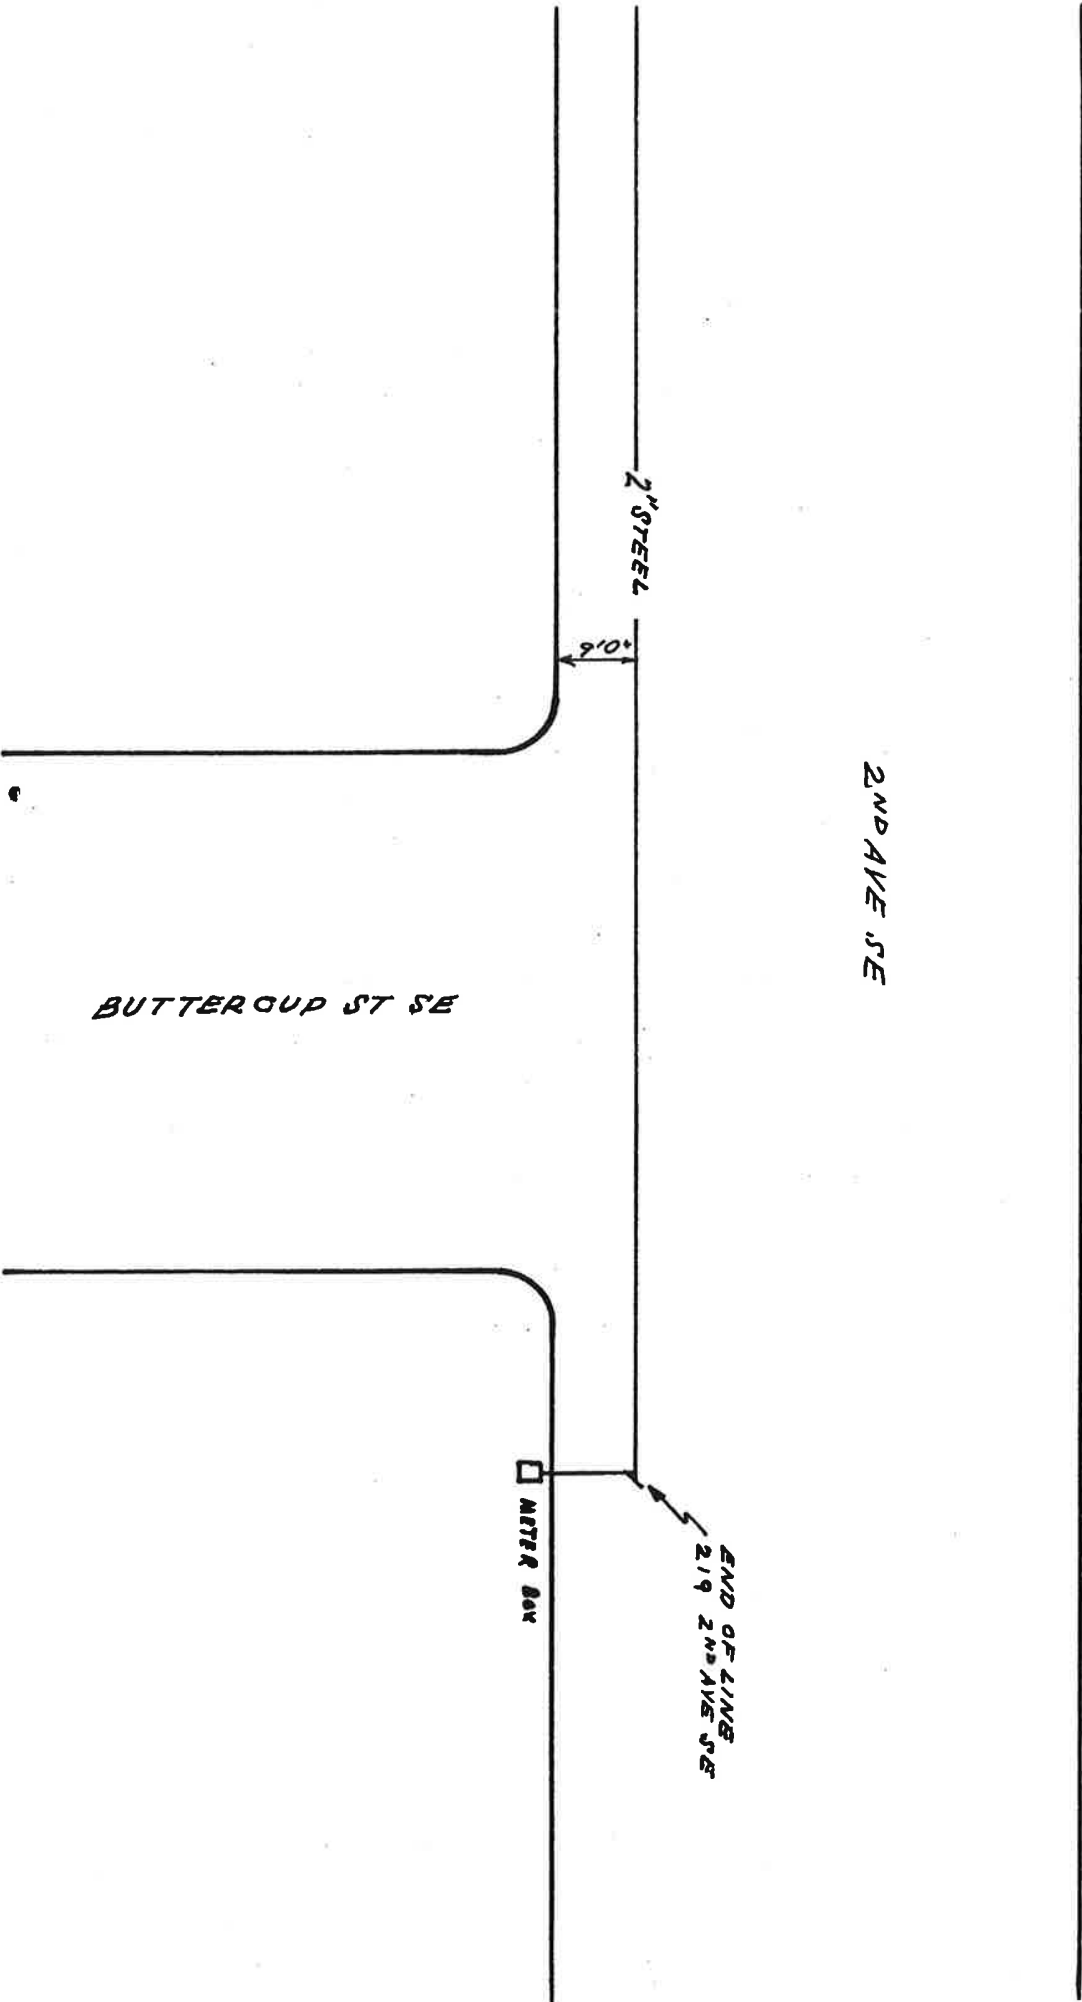

2ND Ave S.E.

78

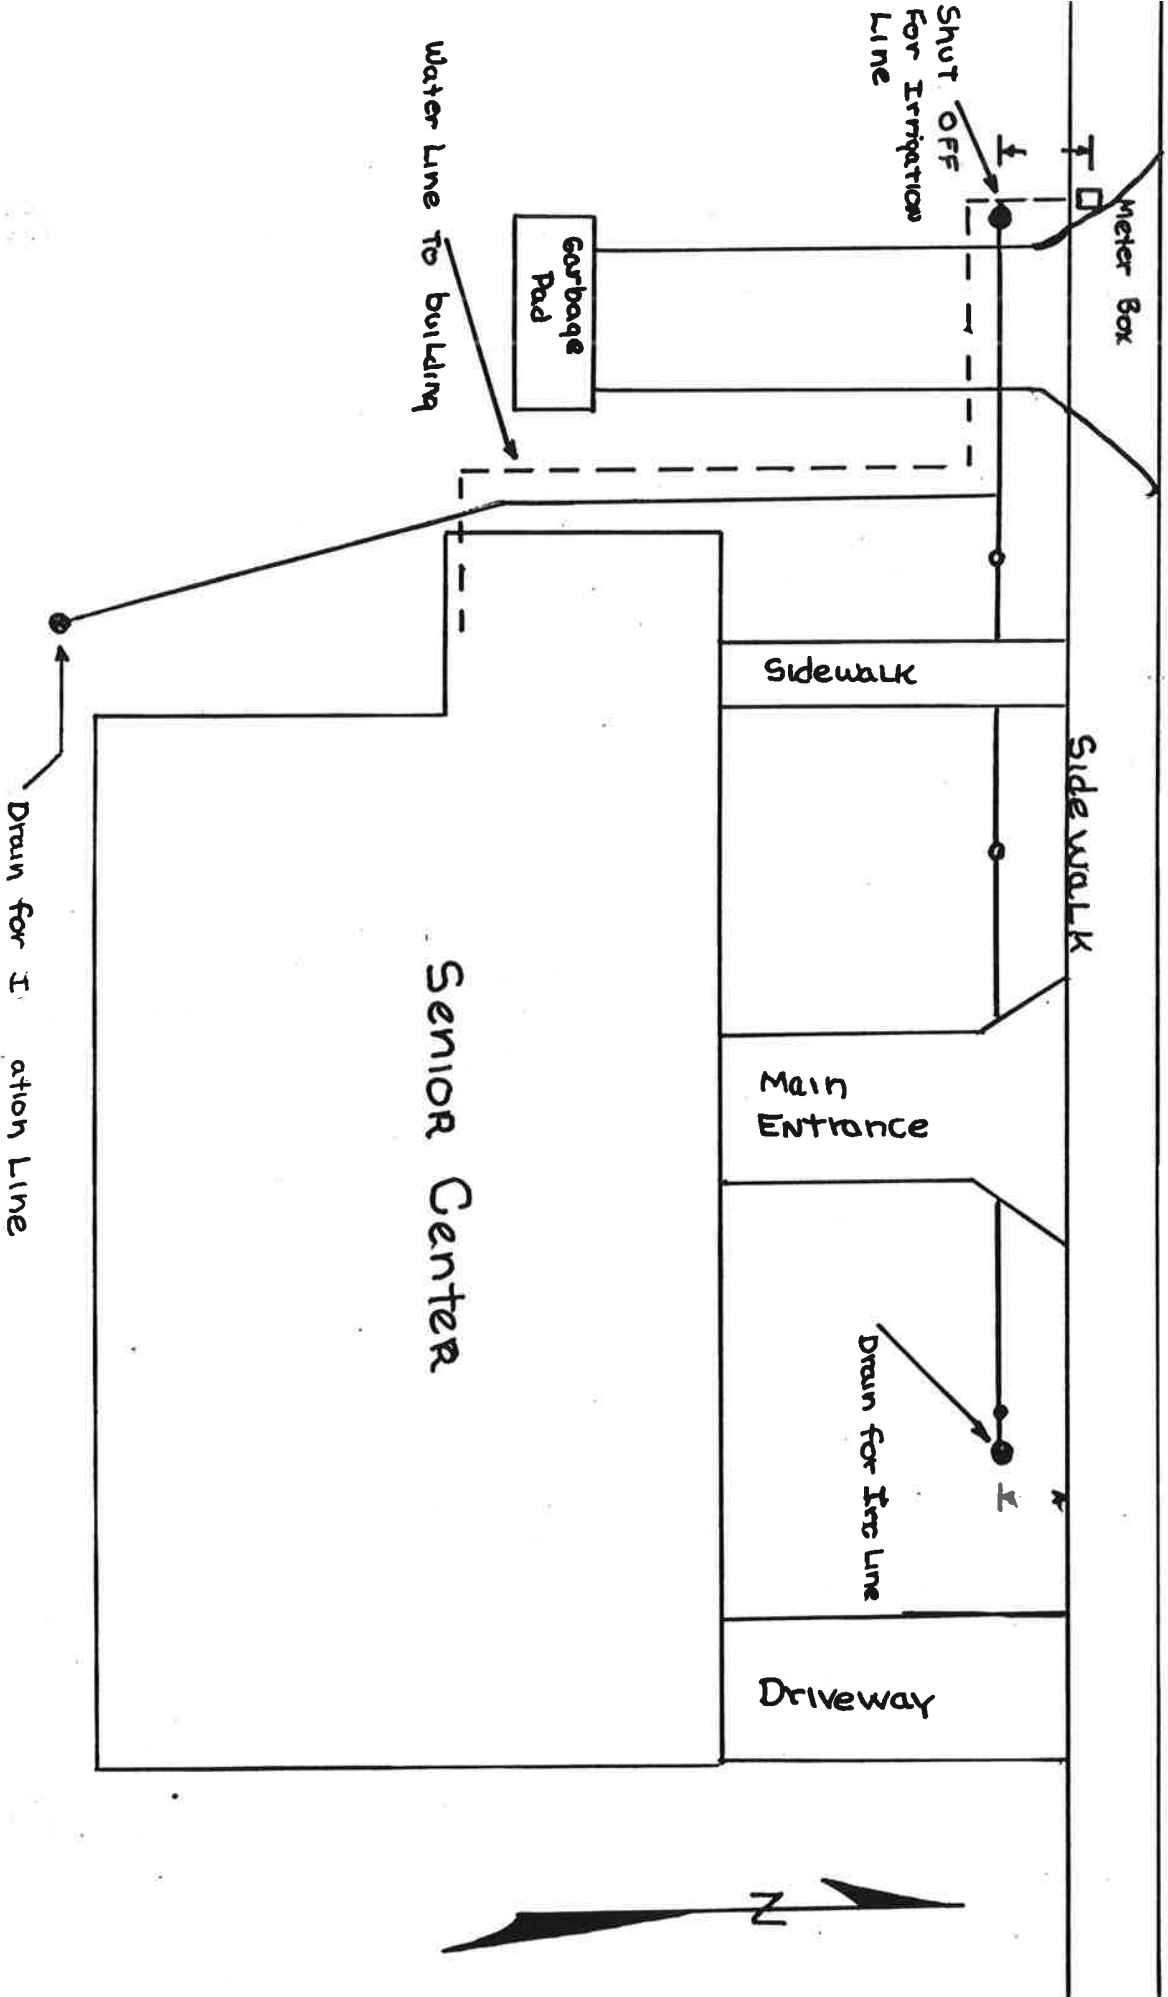

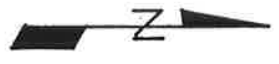

2ND AVE / CANNA ST SE

CANNA ST SE

2ND AVE SE

To city hall

CITY HALL

8" C-900

C-900

C-900

4" C-900 SL

8" C-900

15' 6" 4" C-900 TO 3" PVC


2ND AVE SE


3" PLASTIC
4" AC

HYDRANT

5 POLE


79

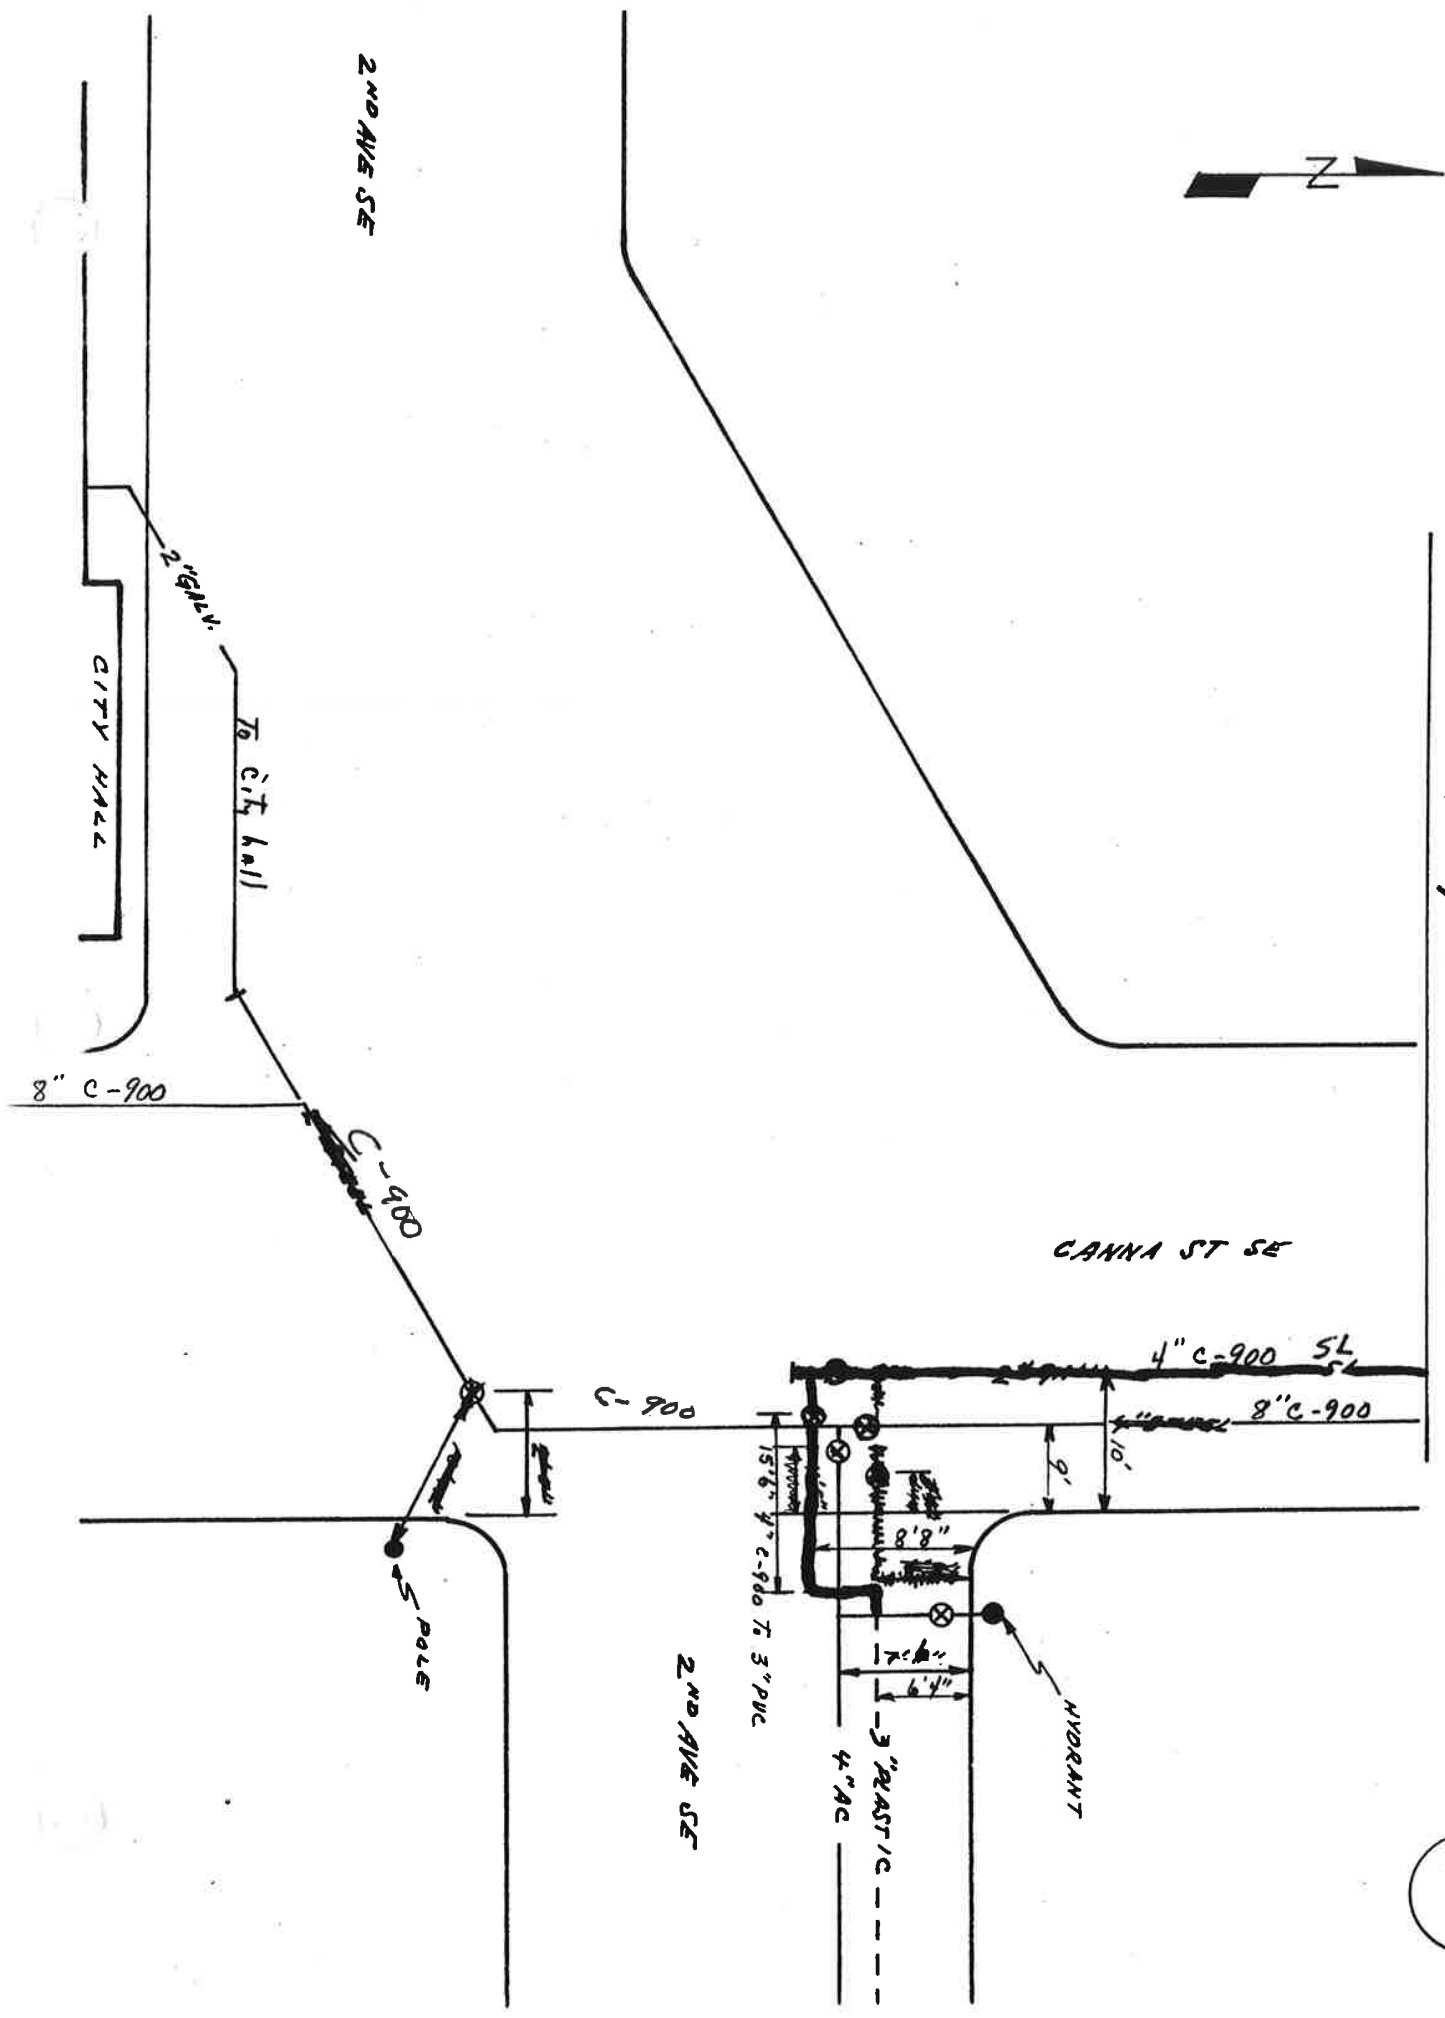


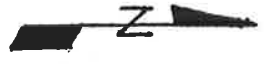

2ND AVE / DAISY ST SE

80

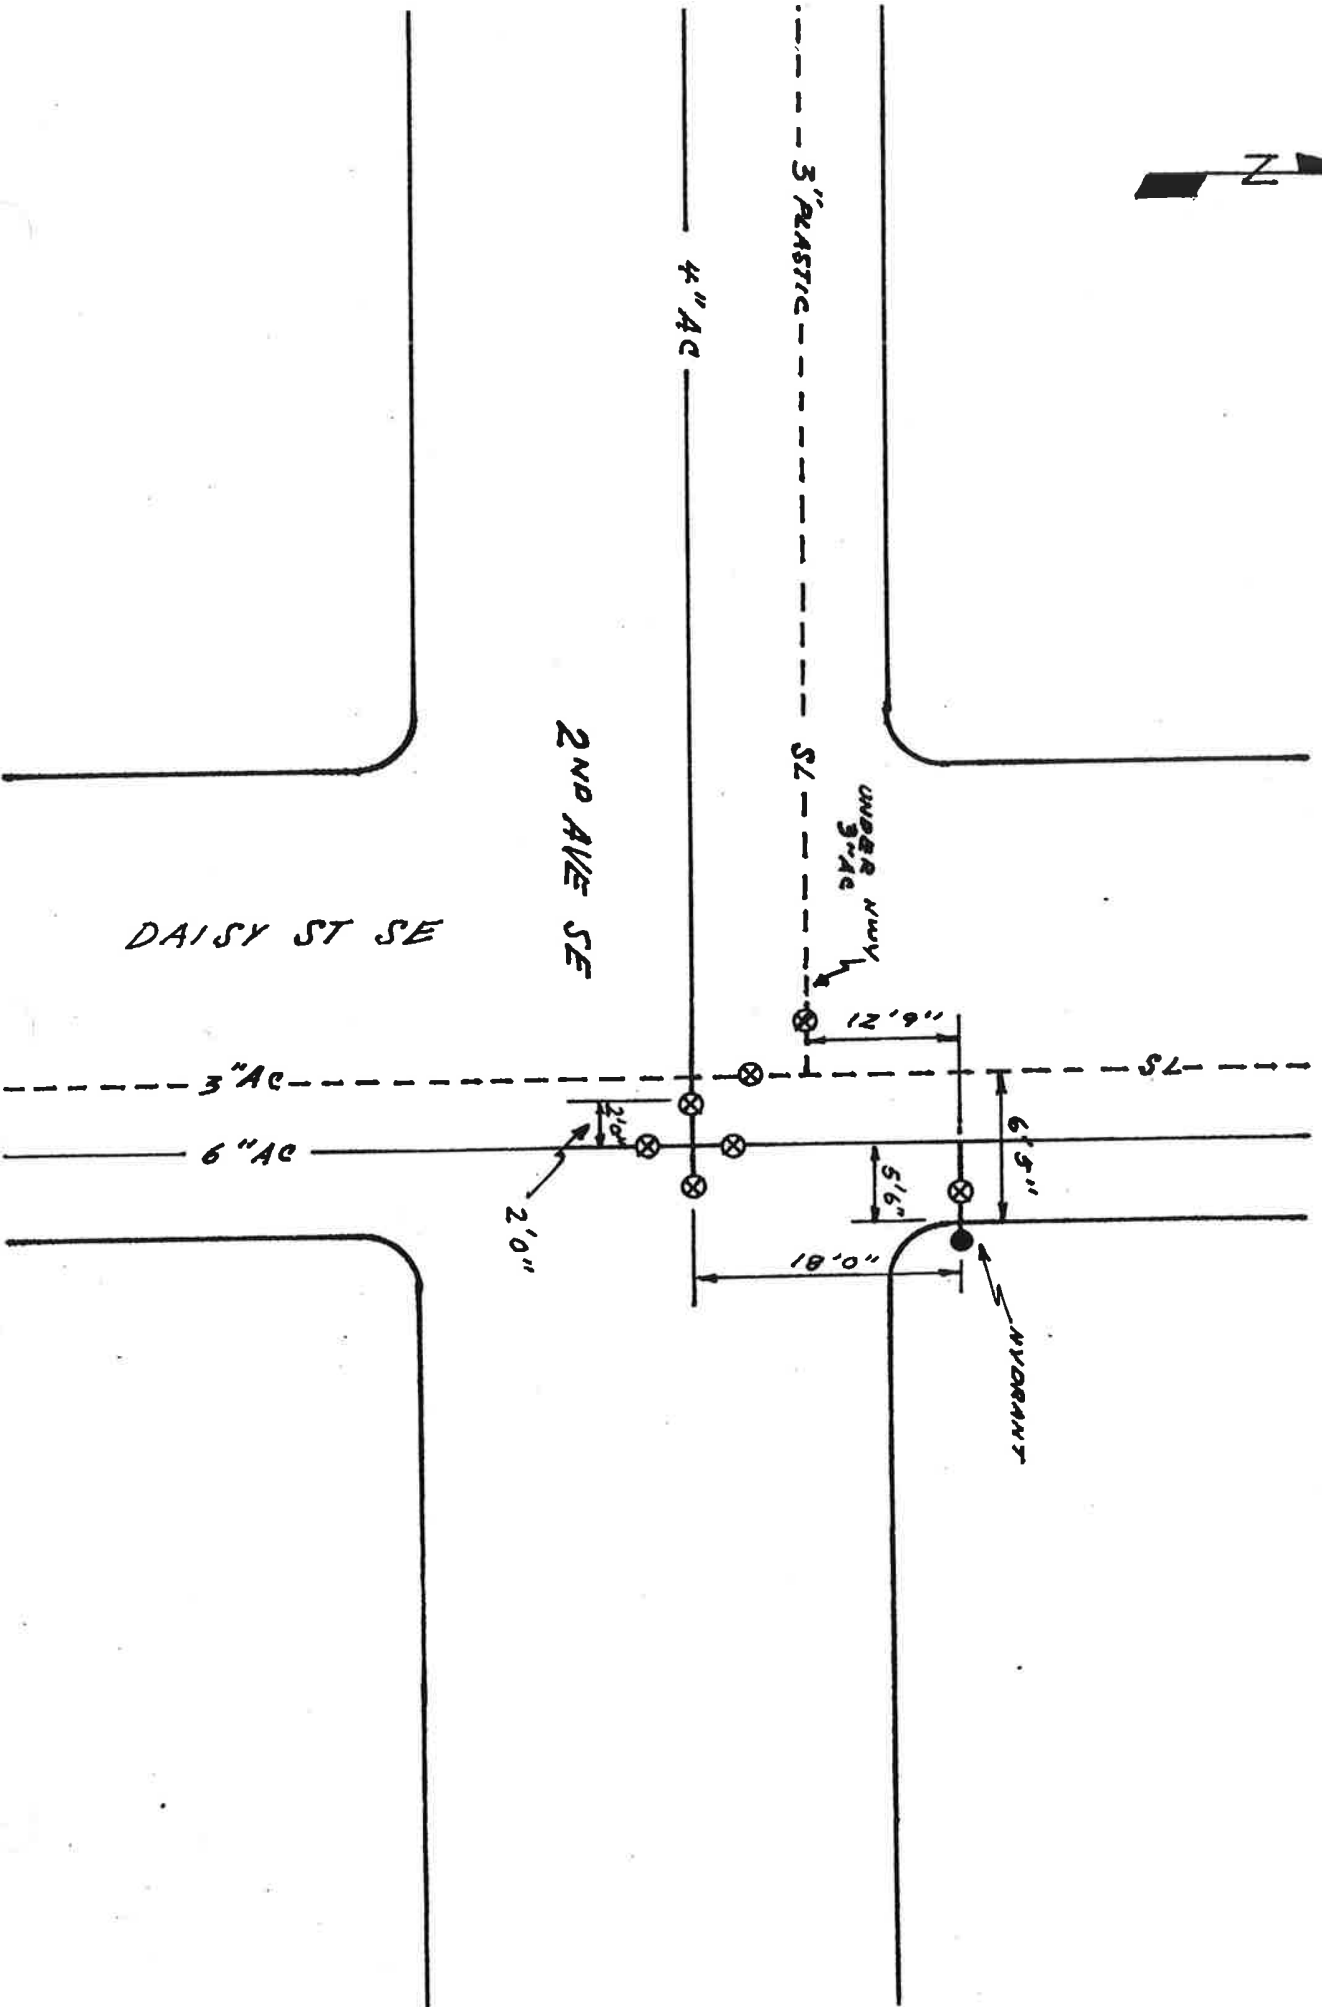

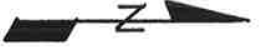


2ND AVE SE



2ND AVE / FERN ST SE

8" AC

FERN ST SE

82

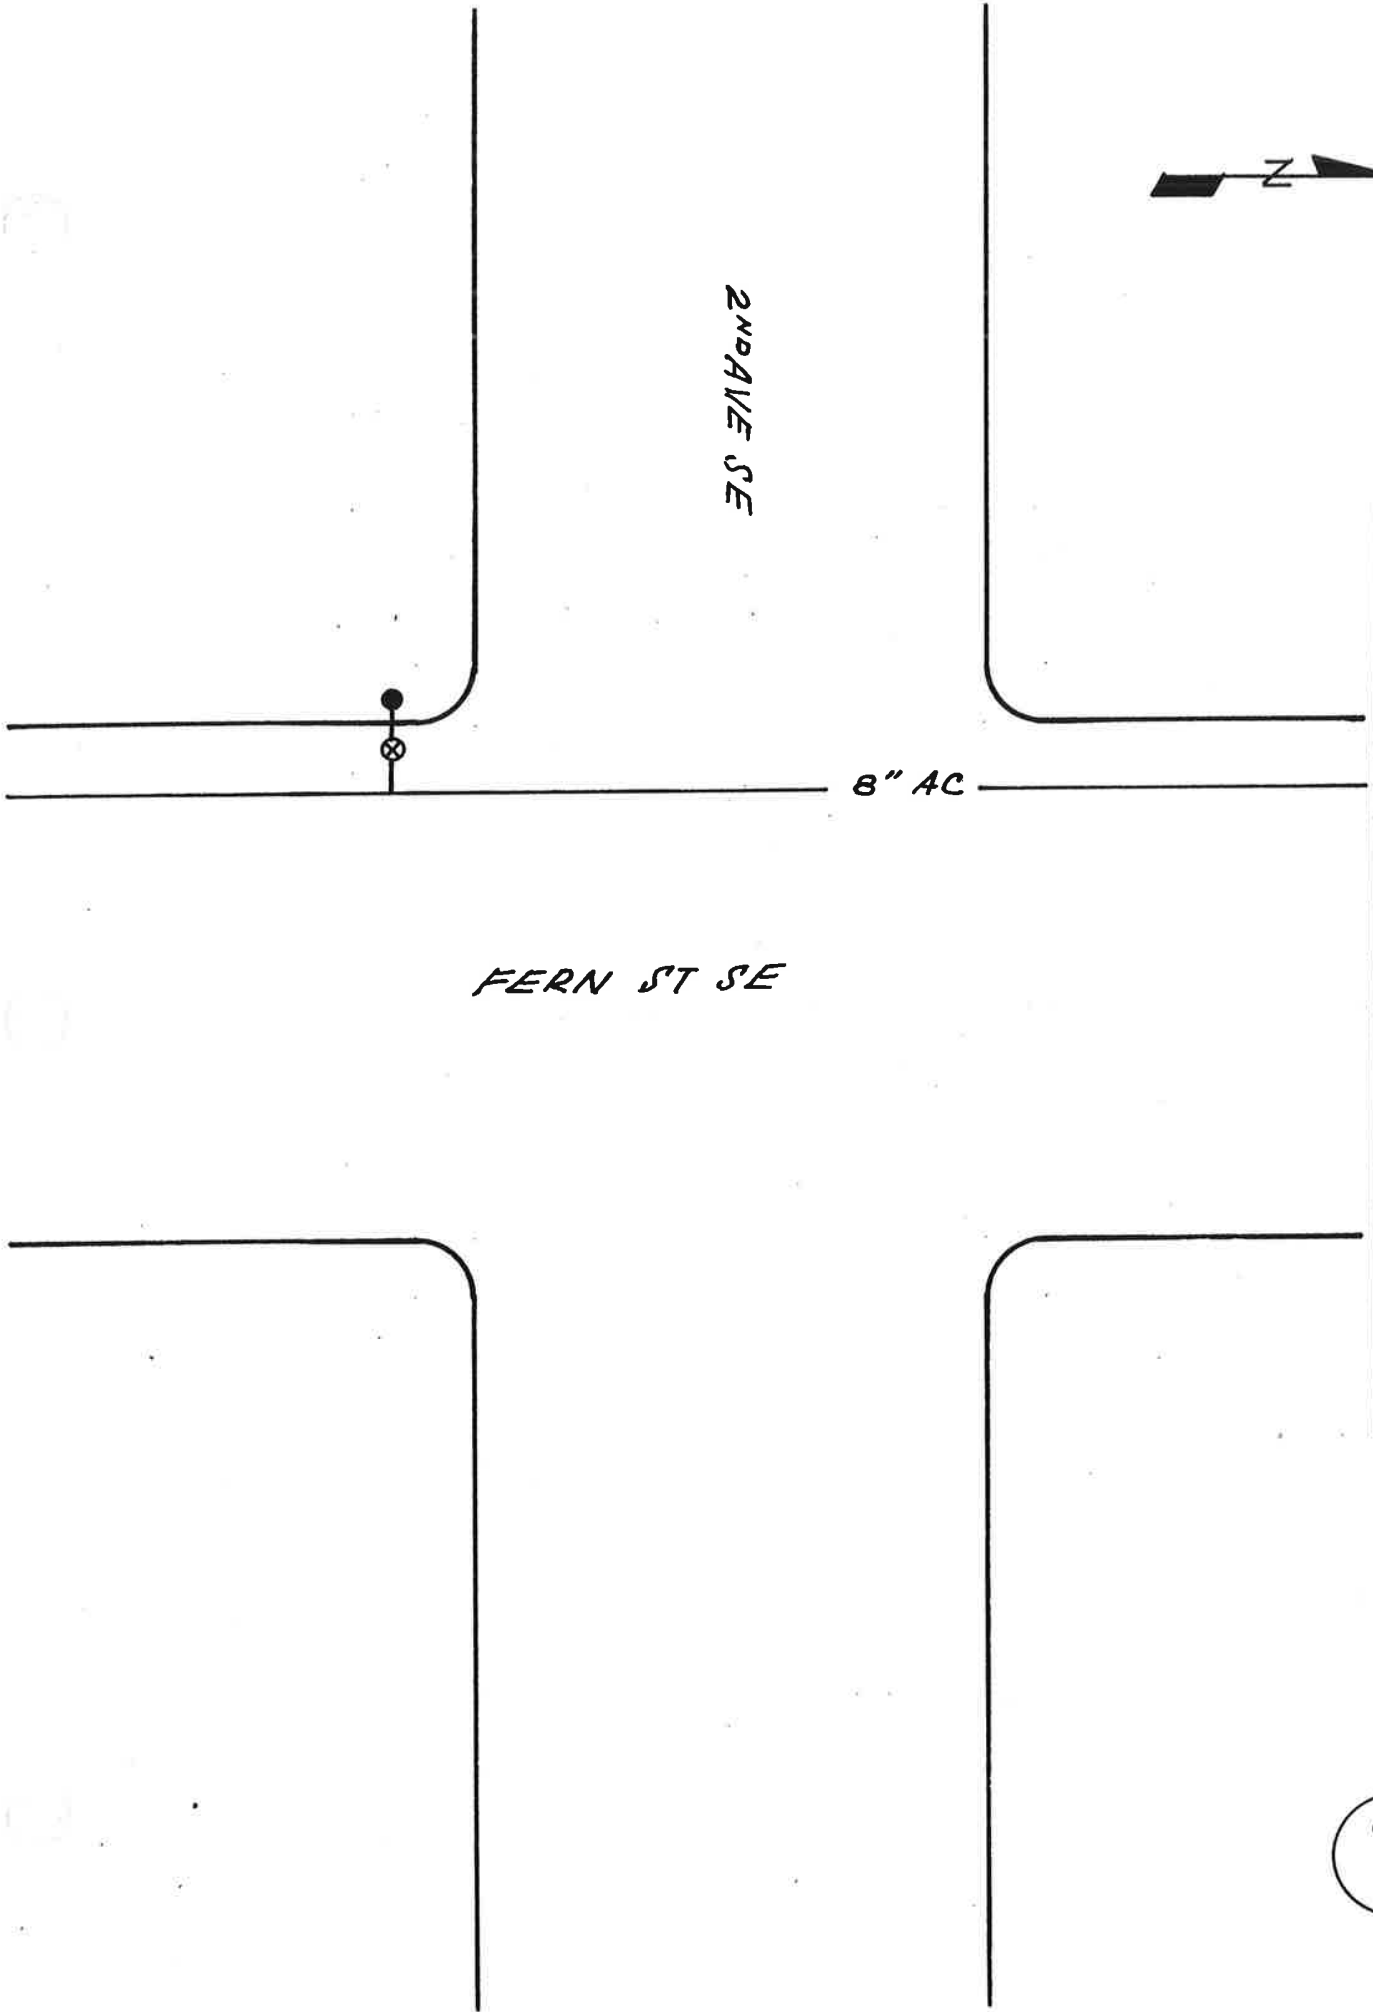


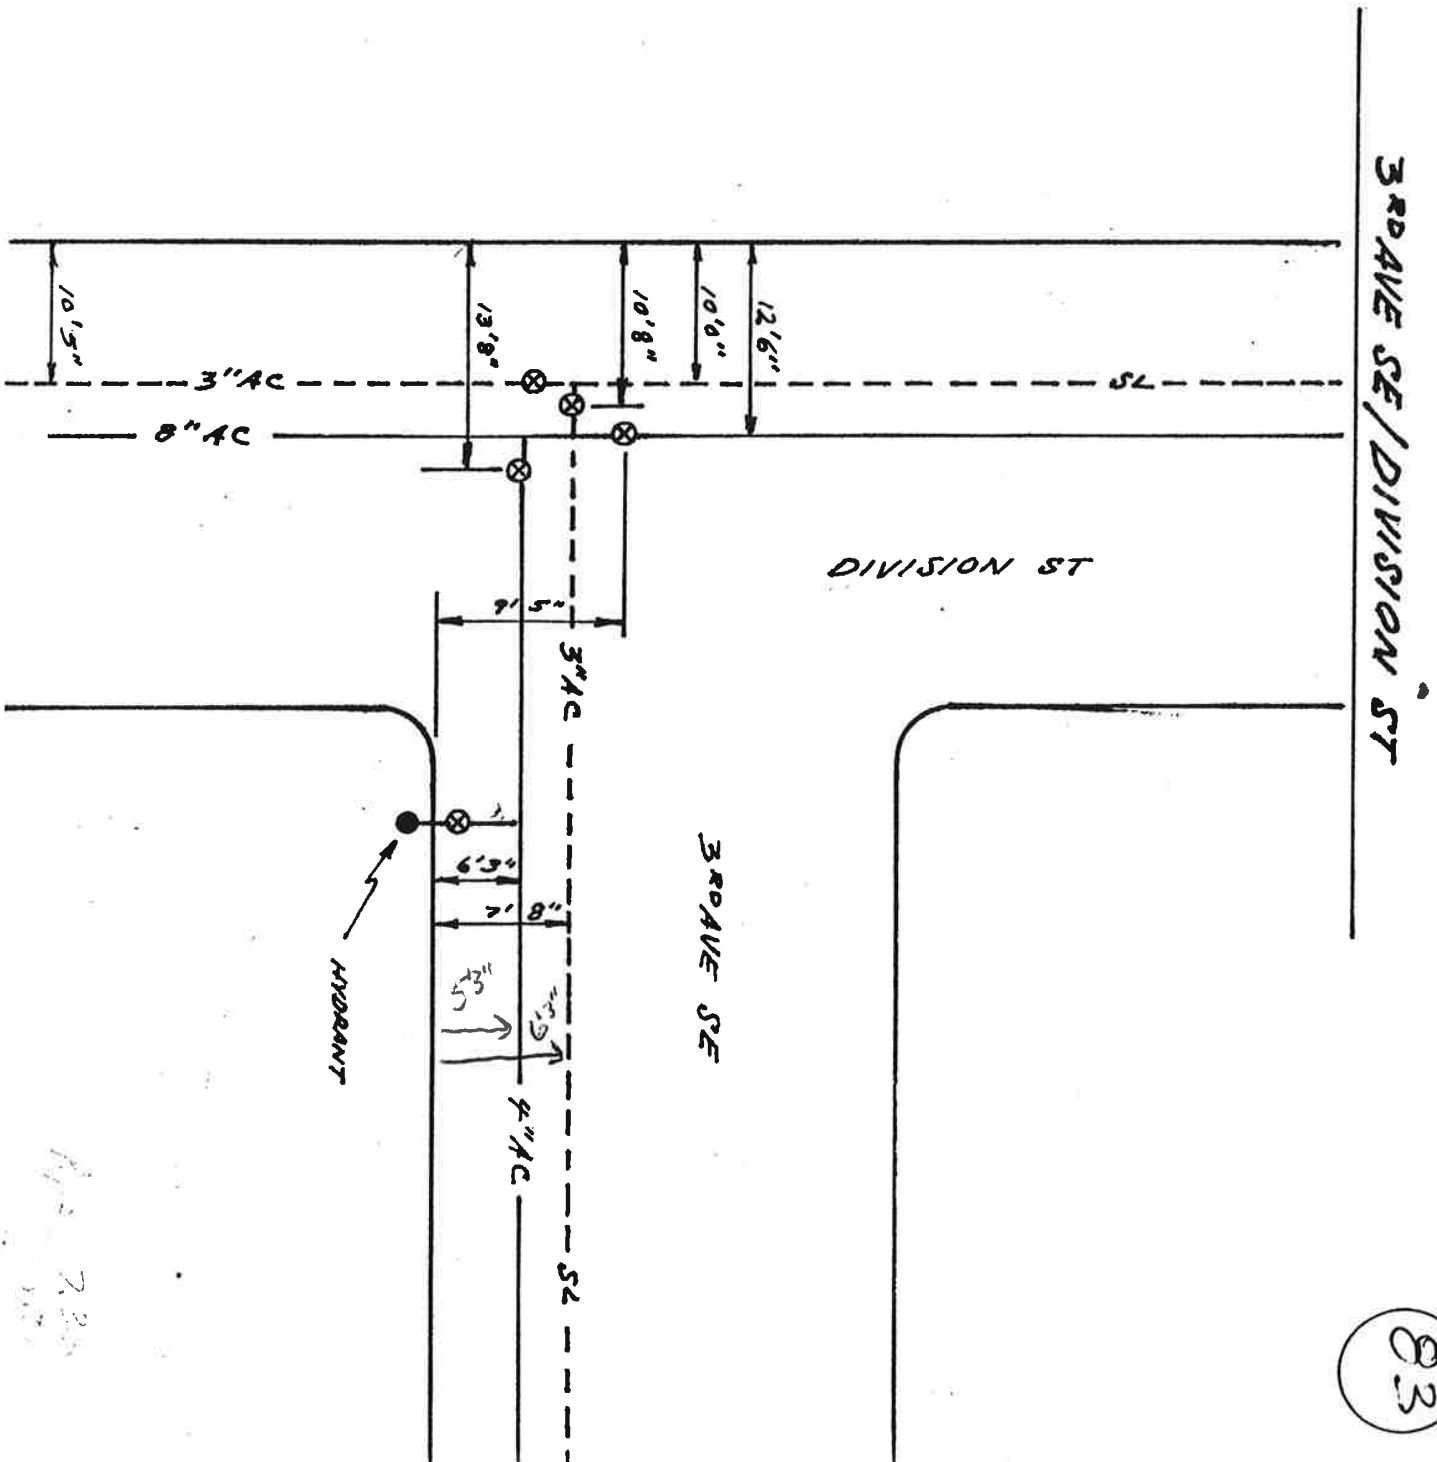
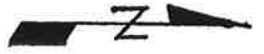


Apr 23 2011



3RD AVE / ASTER ST SE

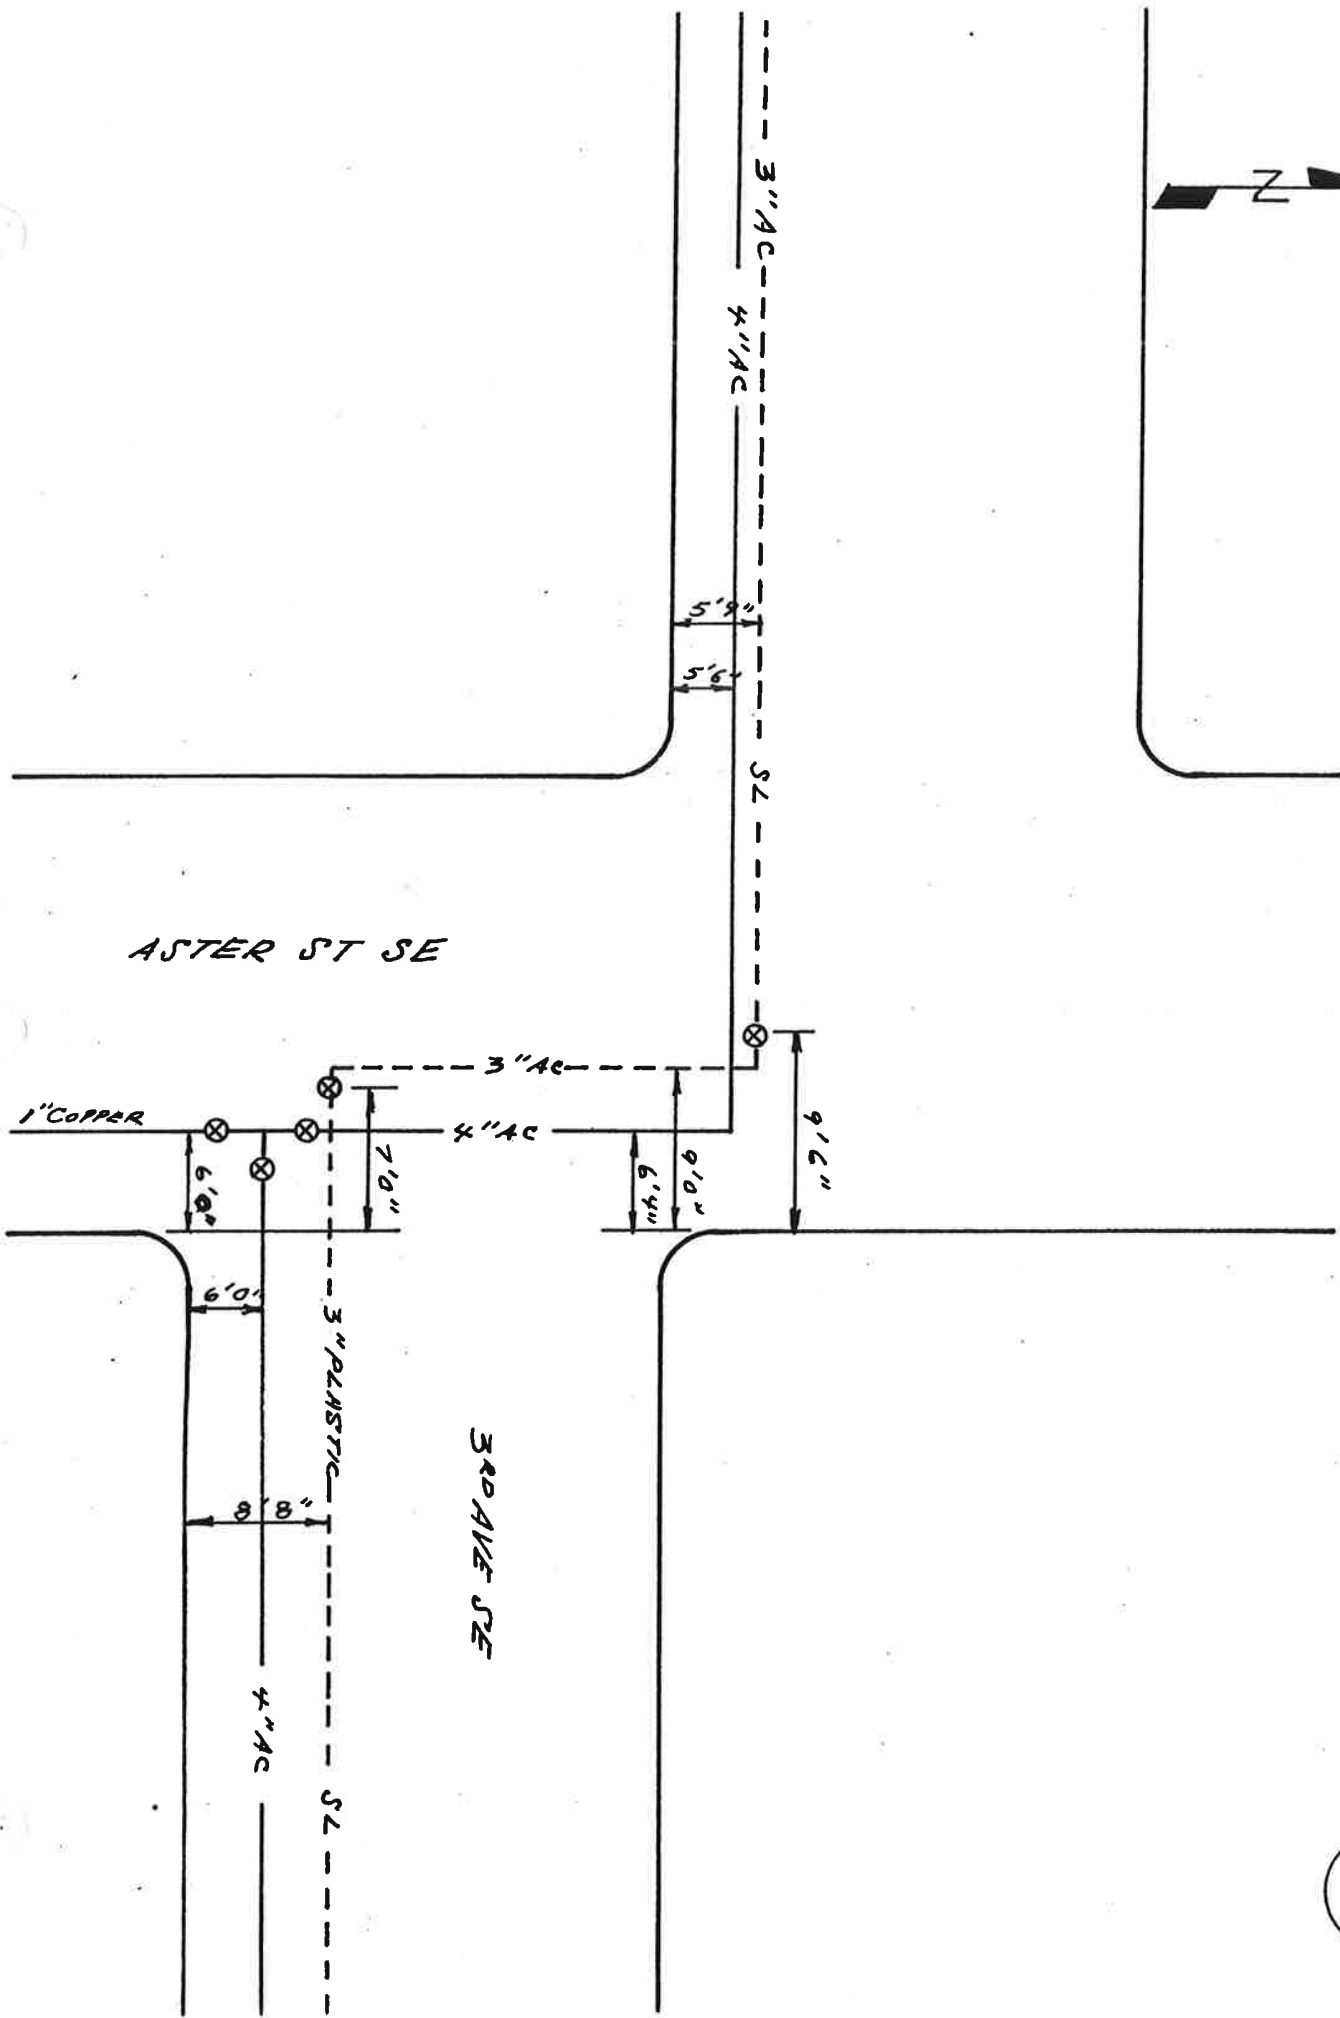


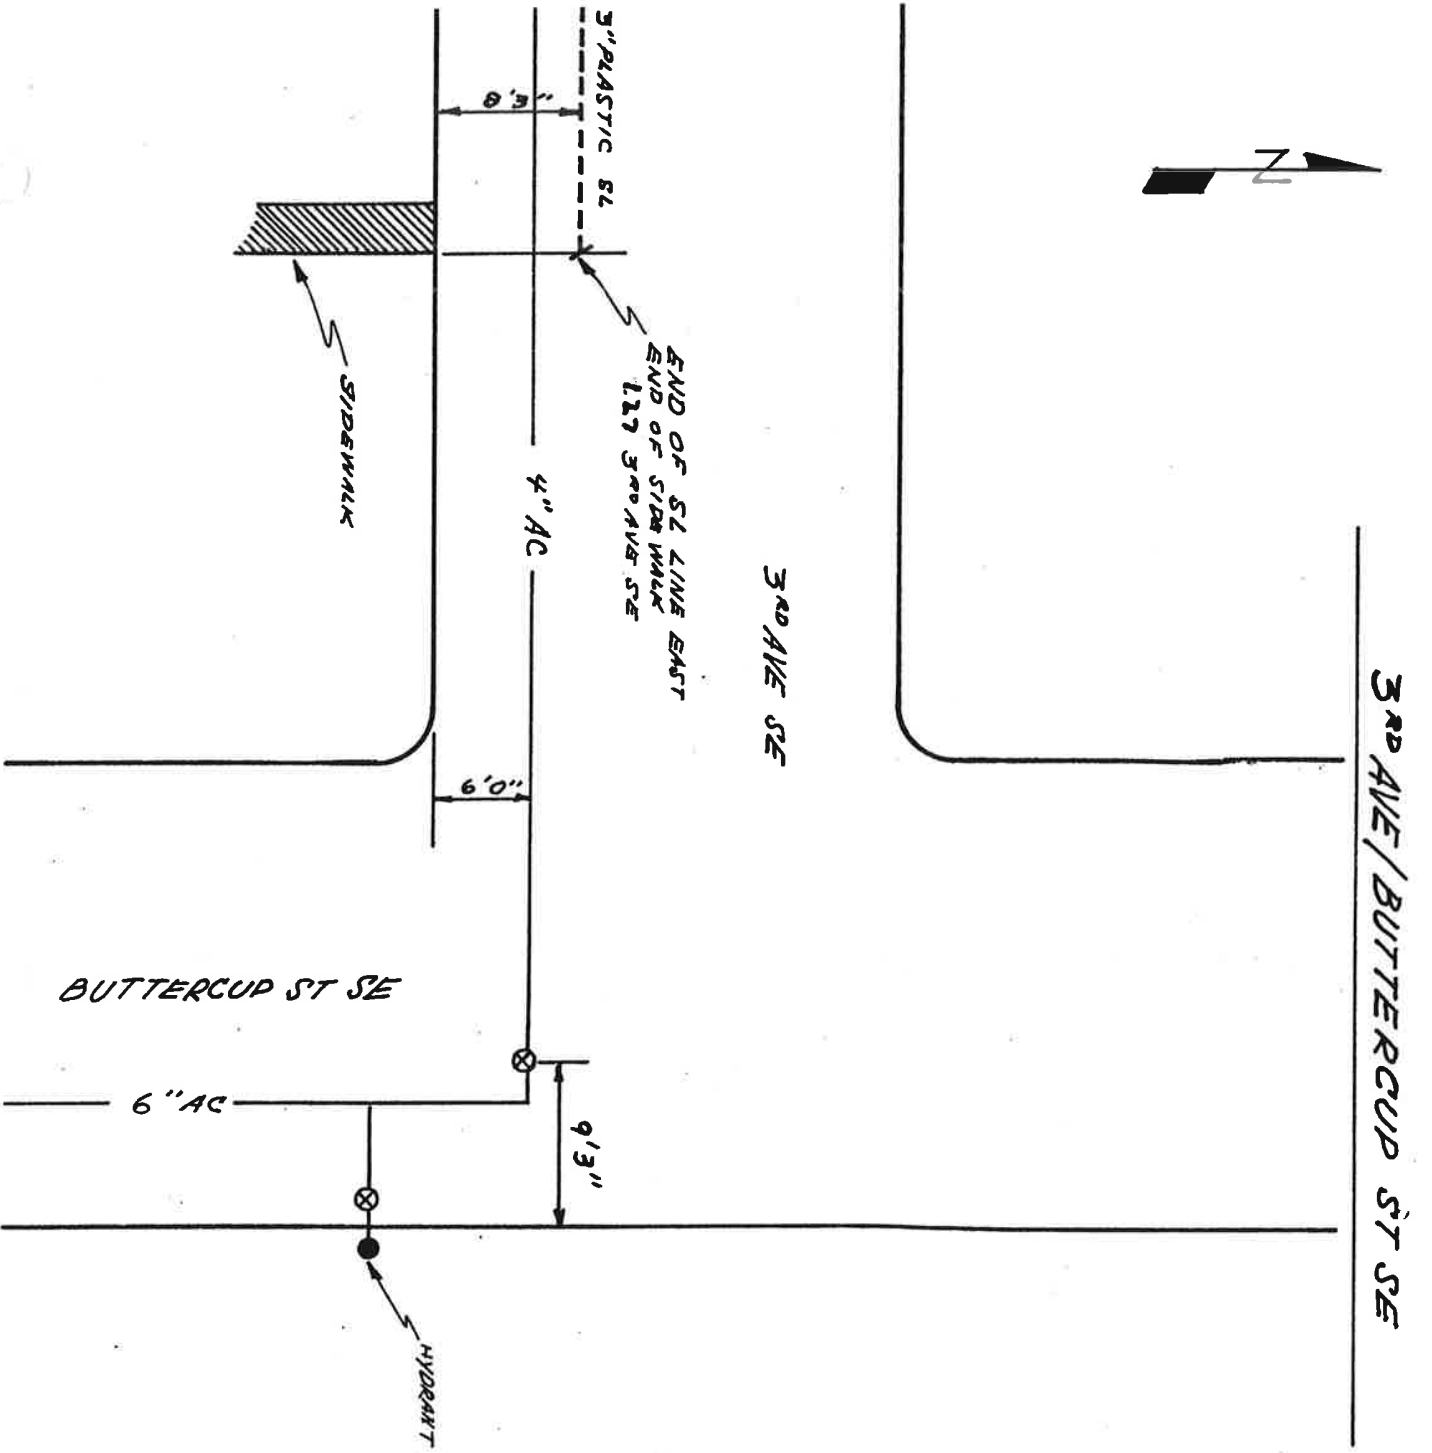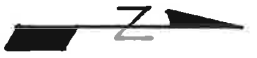




3RD AVE / CANNA ST SE

for future tie in
8" x 6" fly Tee

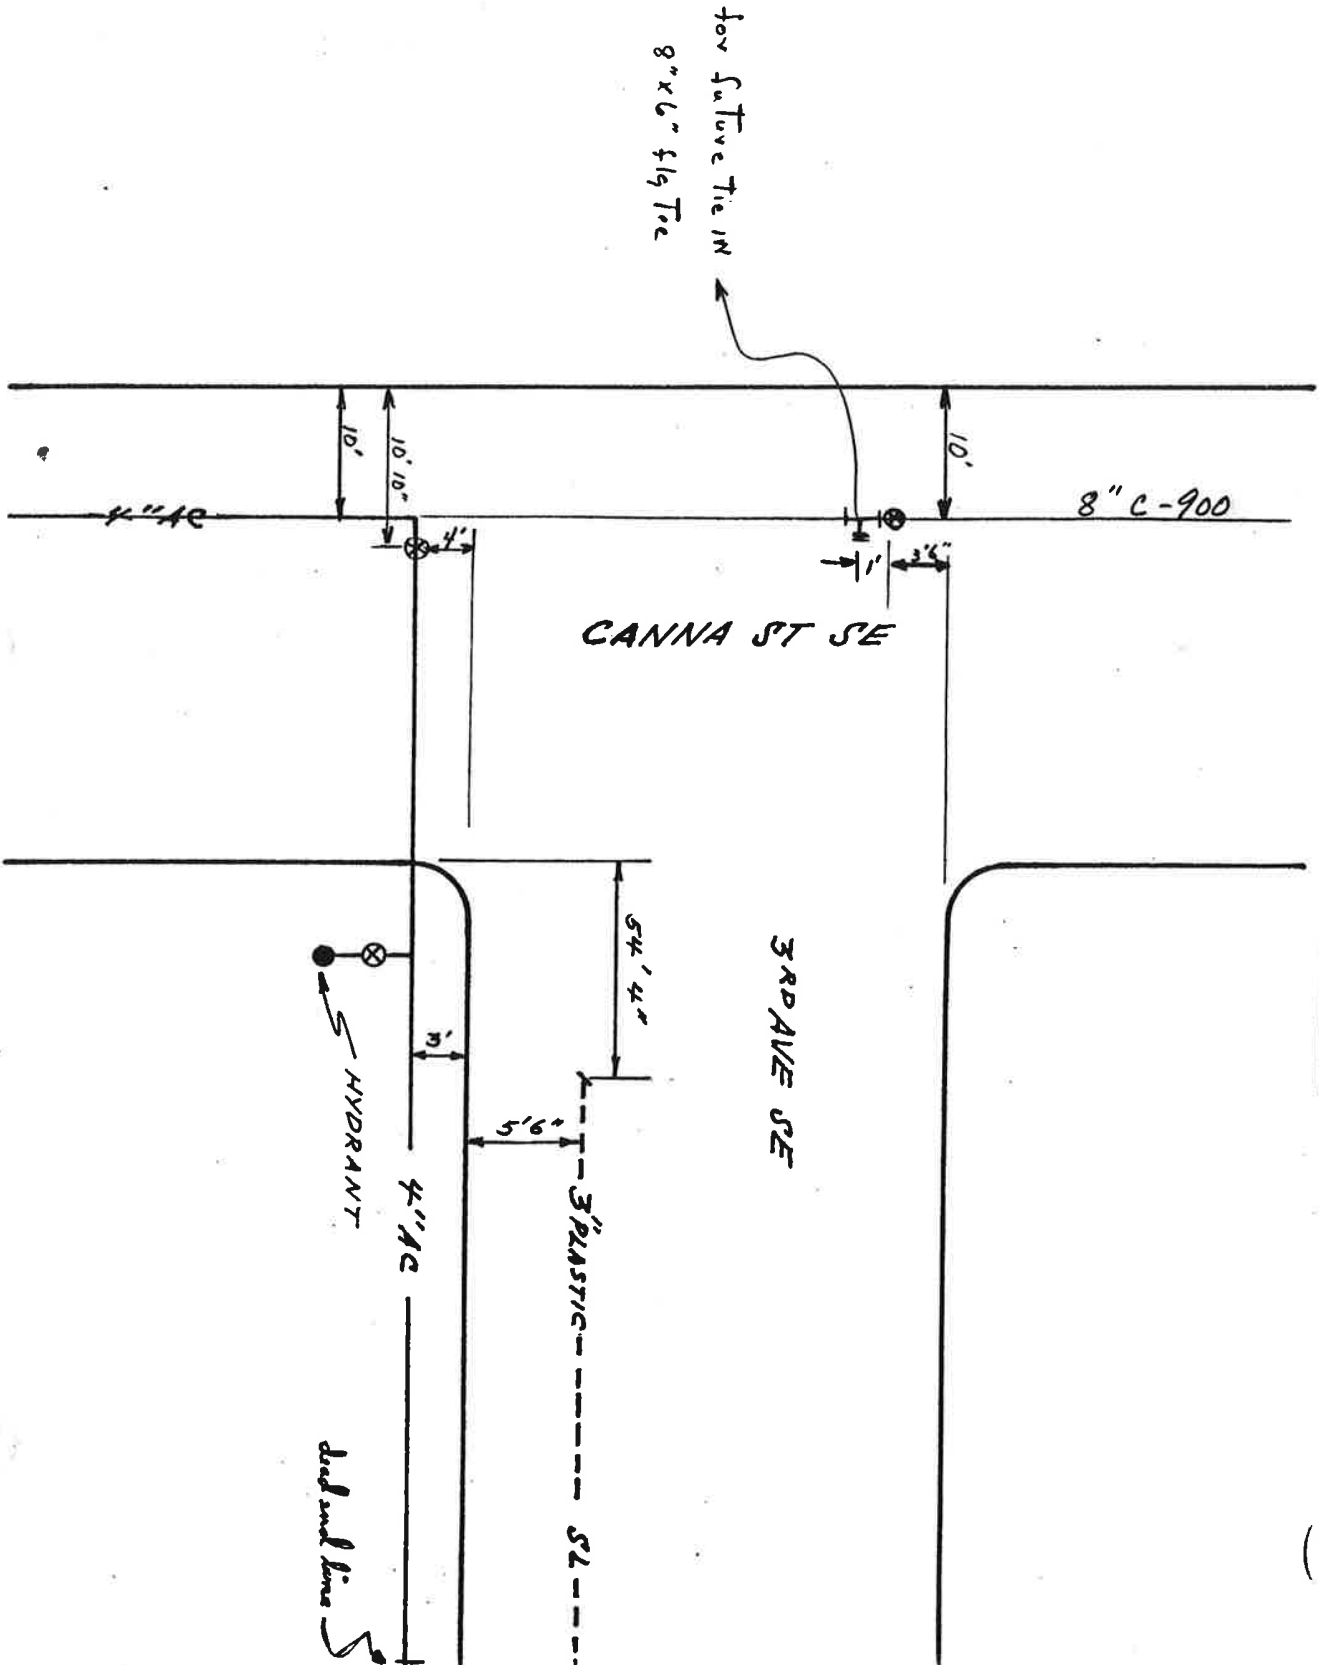


(10/15)

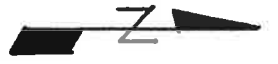

3RD AVE / DAISY ST SE

87

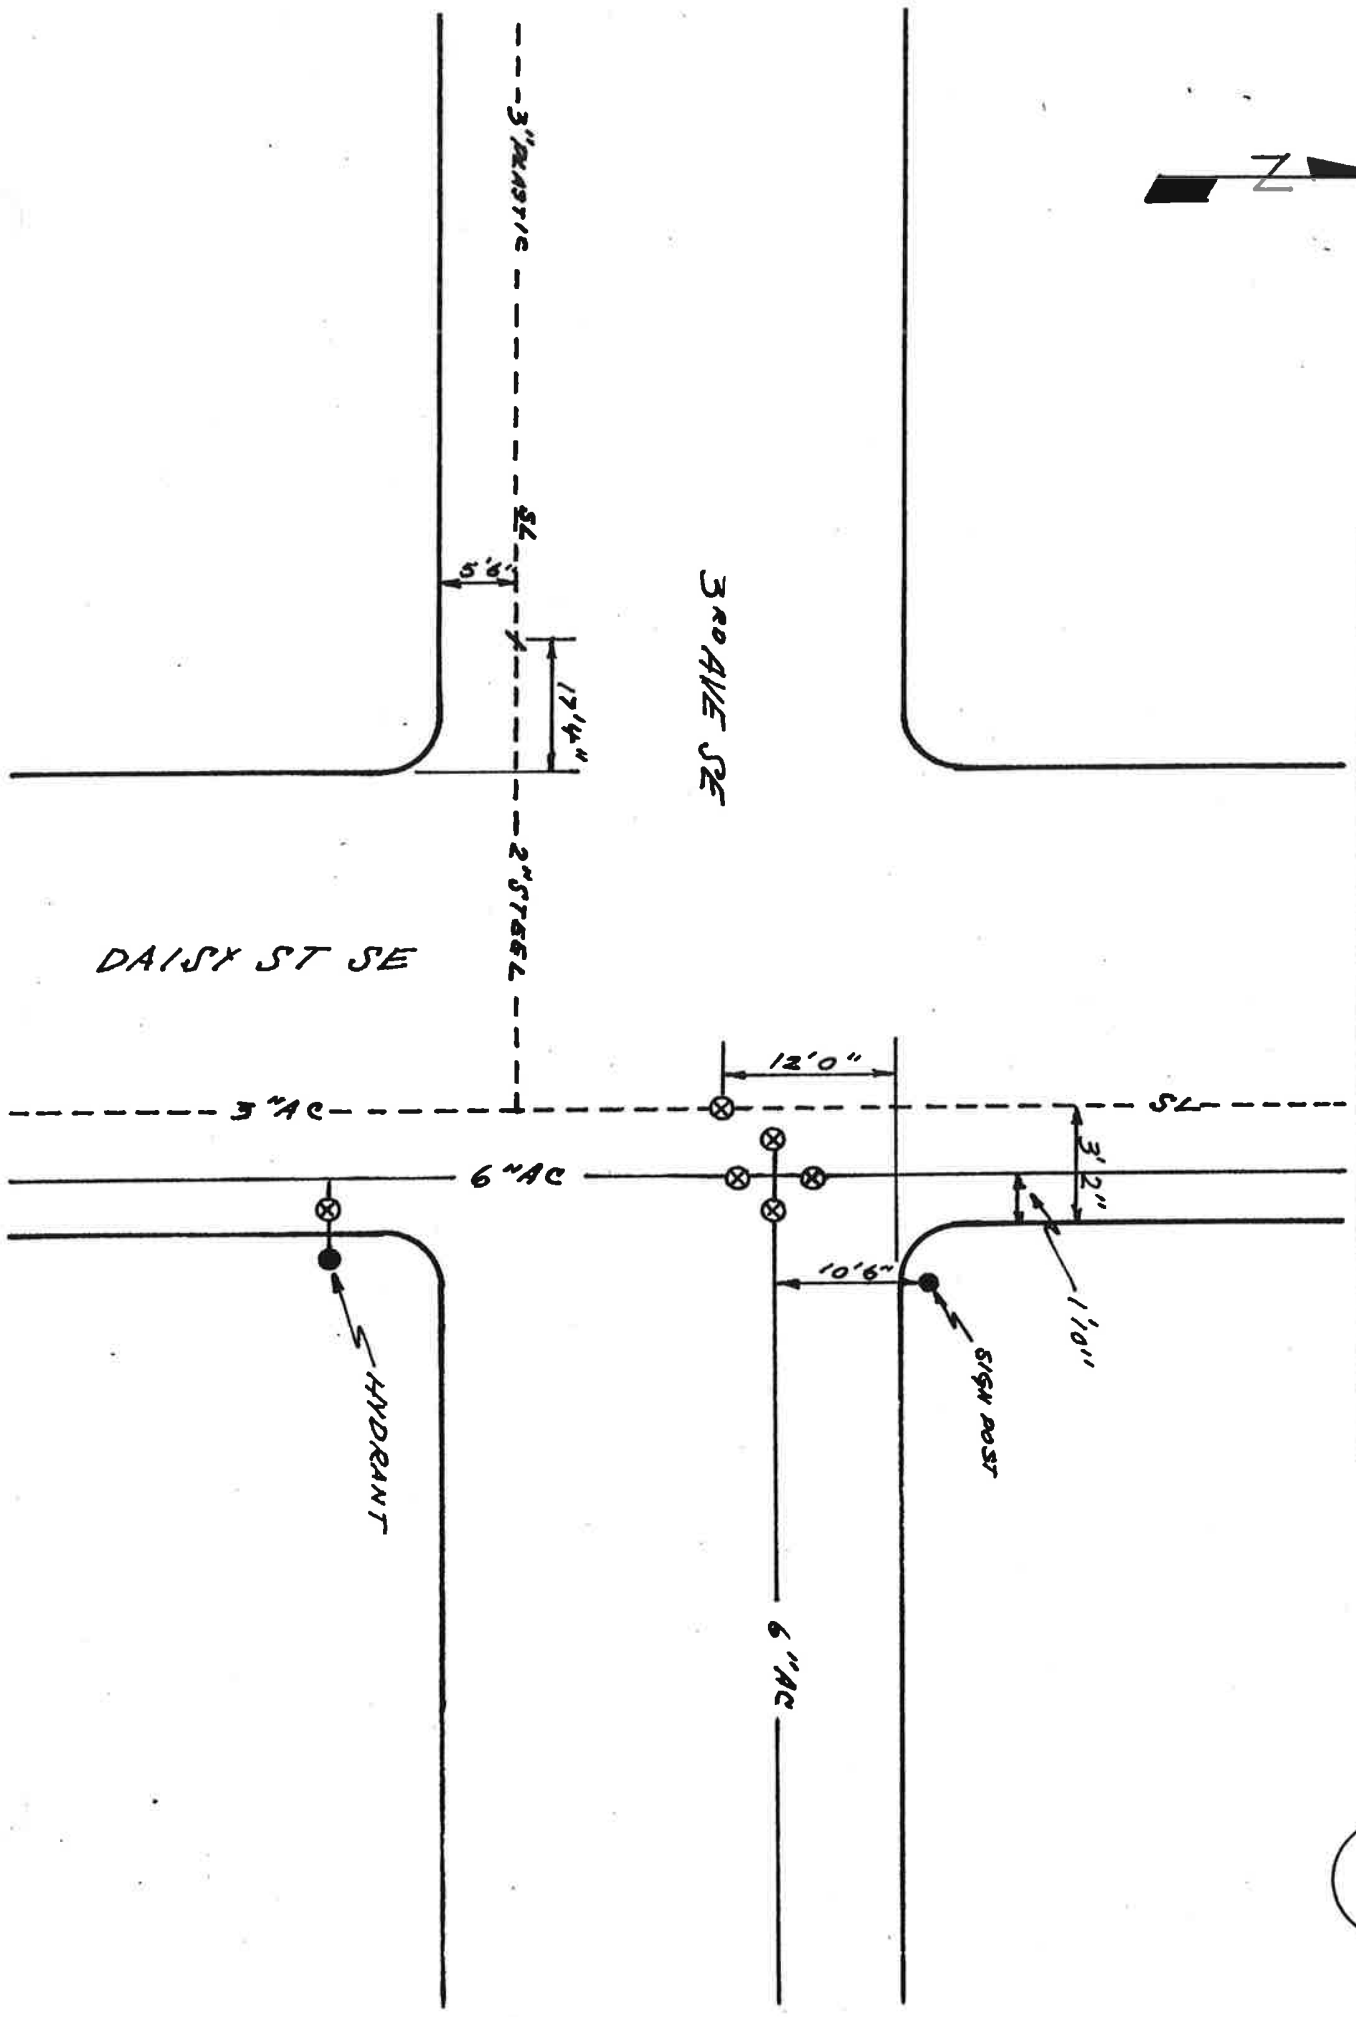

3RD AVE SE

DAISY ST SE

3" PLASTIC

2" STEEL



3" AC



6" AC



6" AC

HYDRANT

SIGN POST

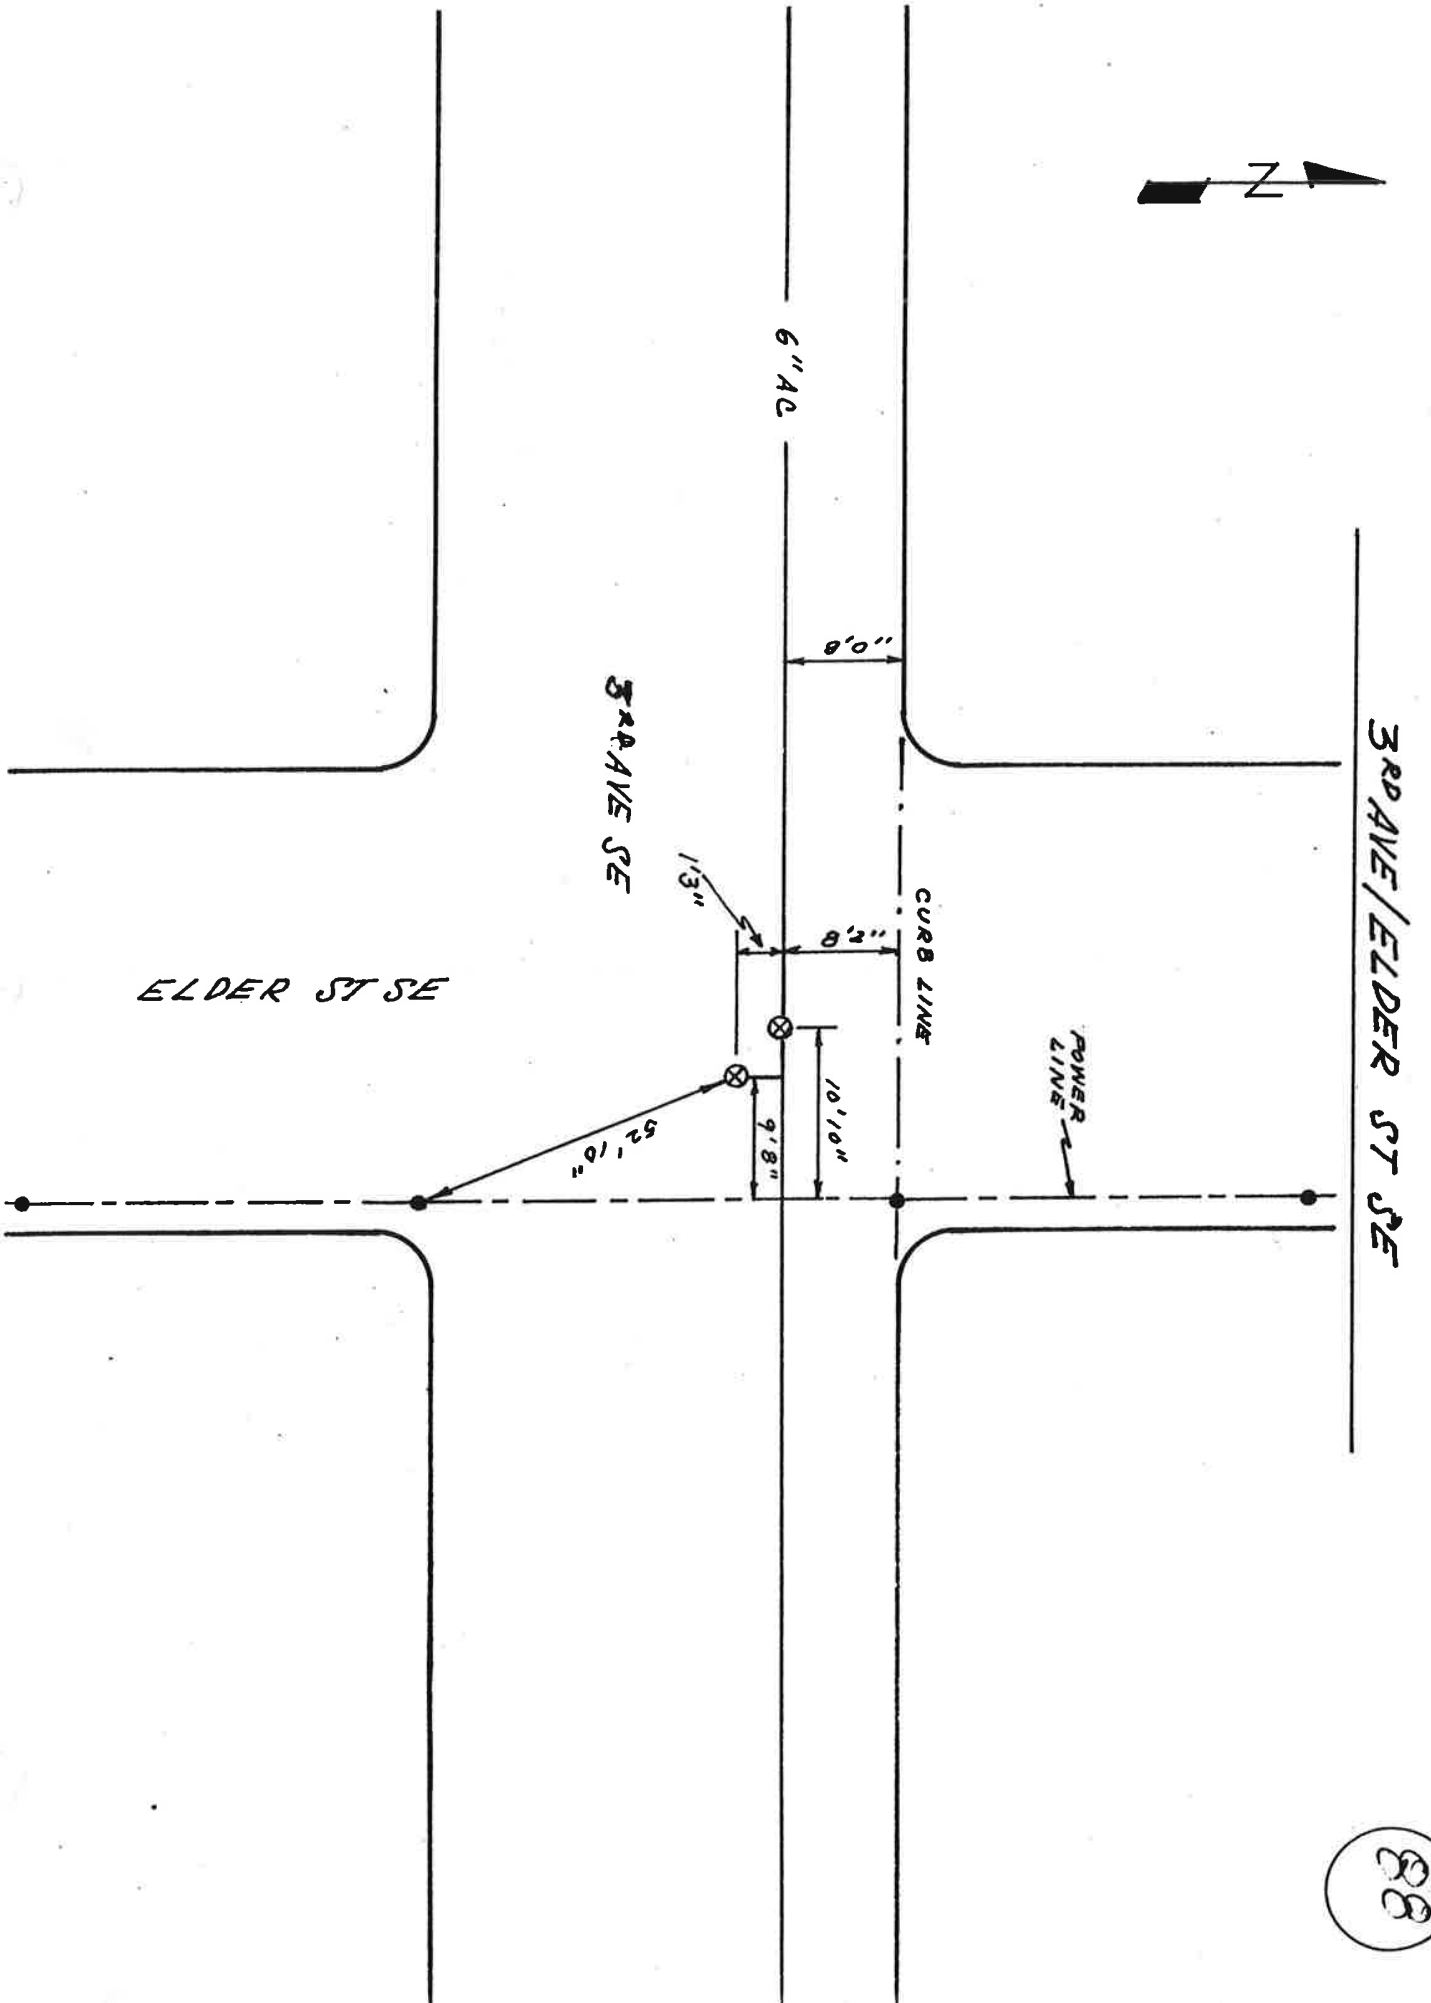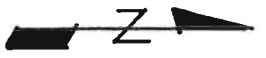

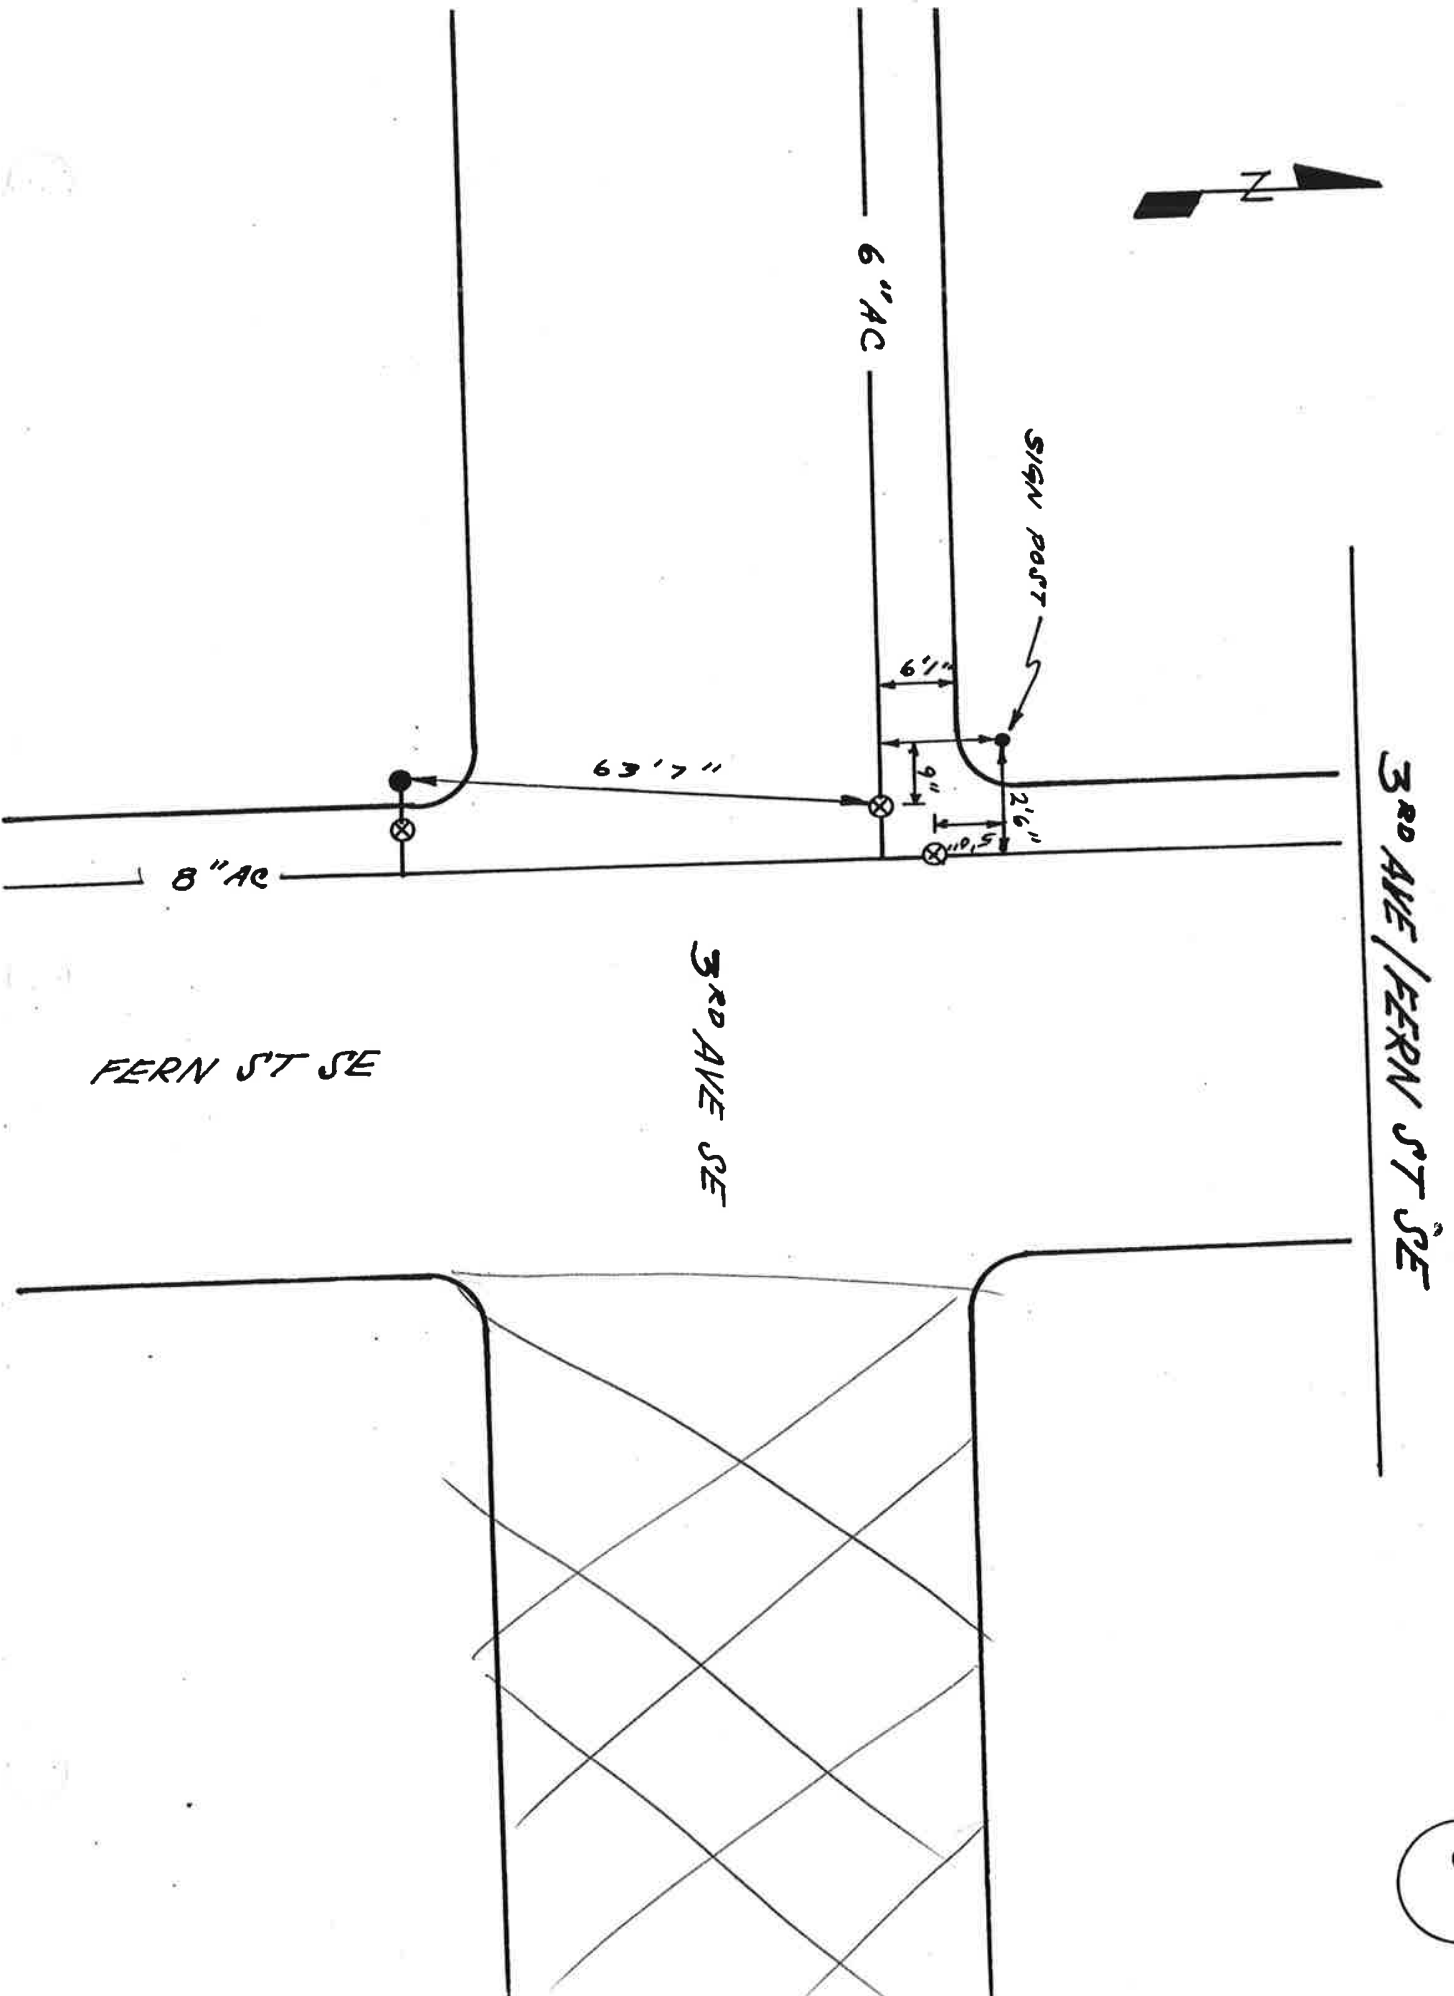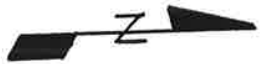


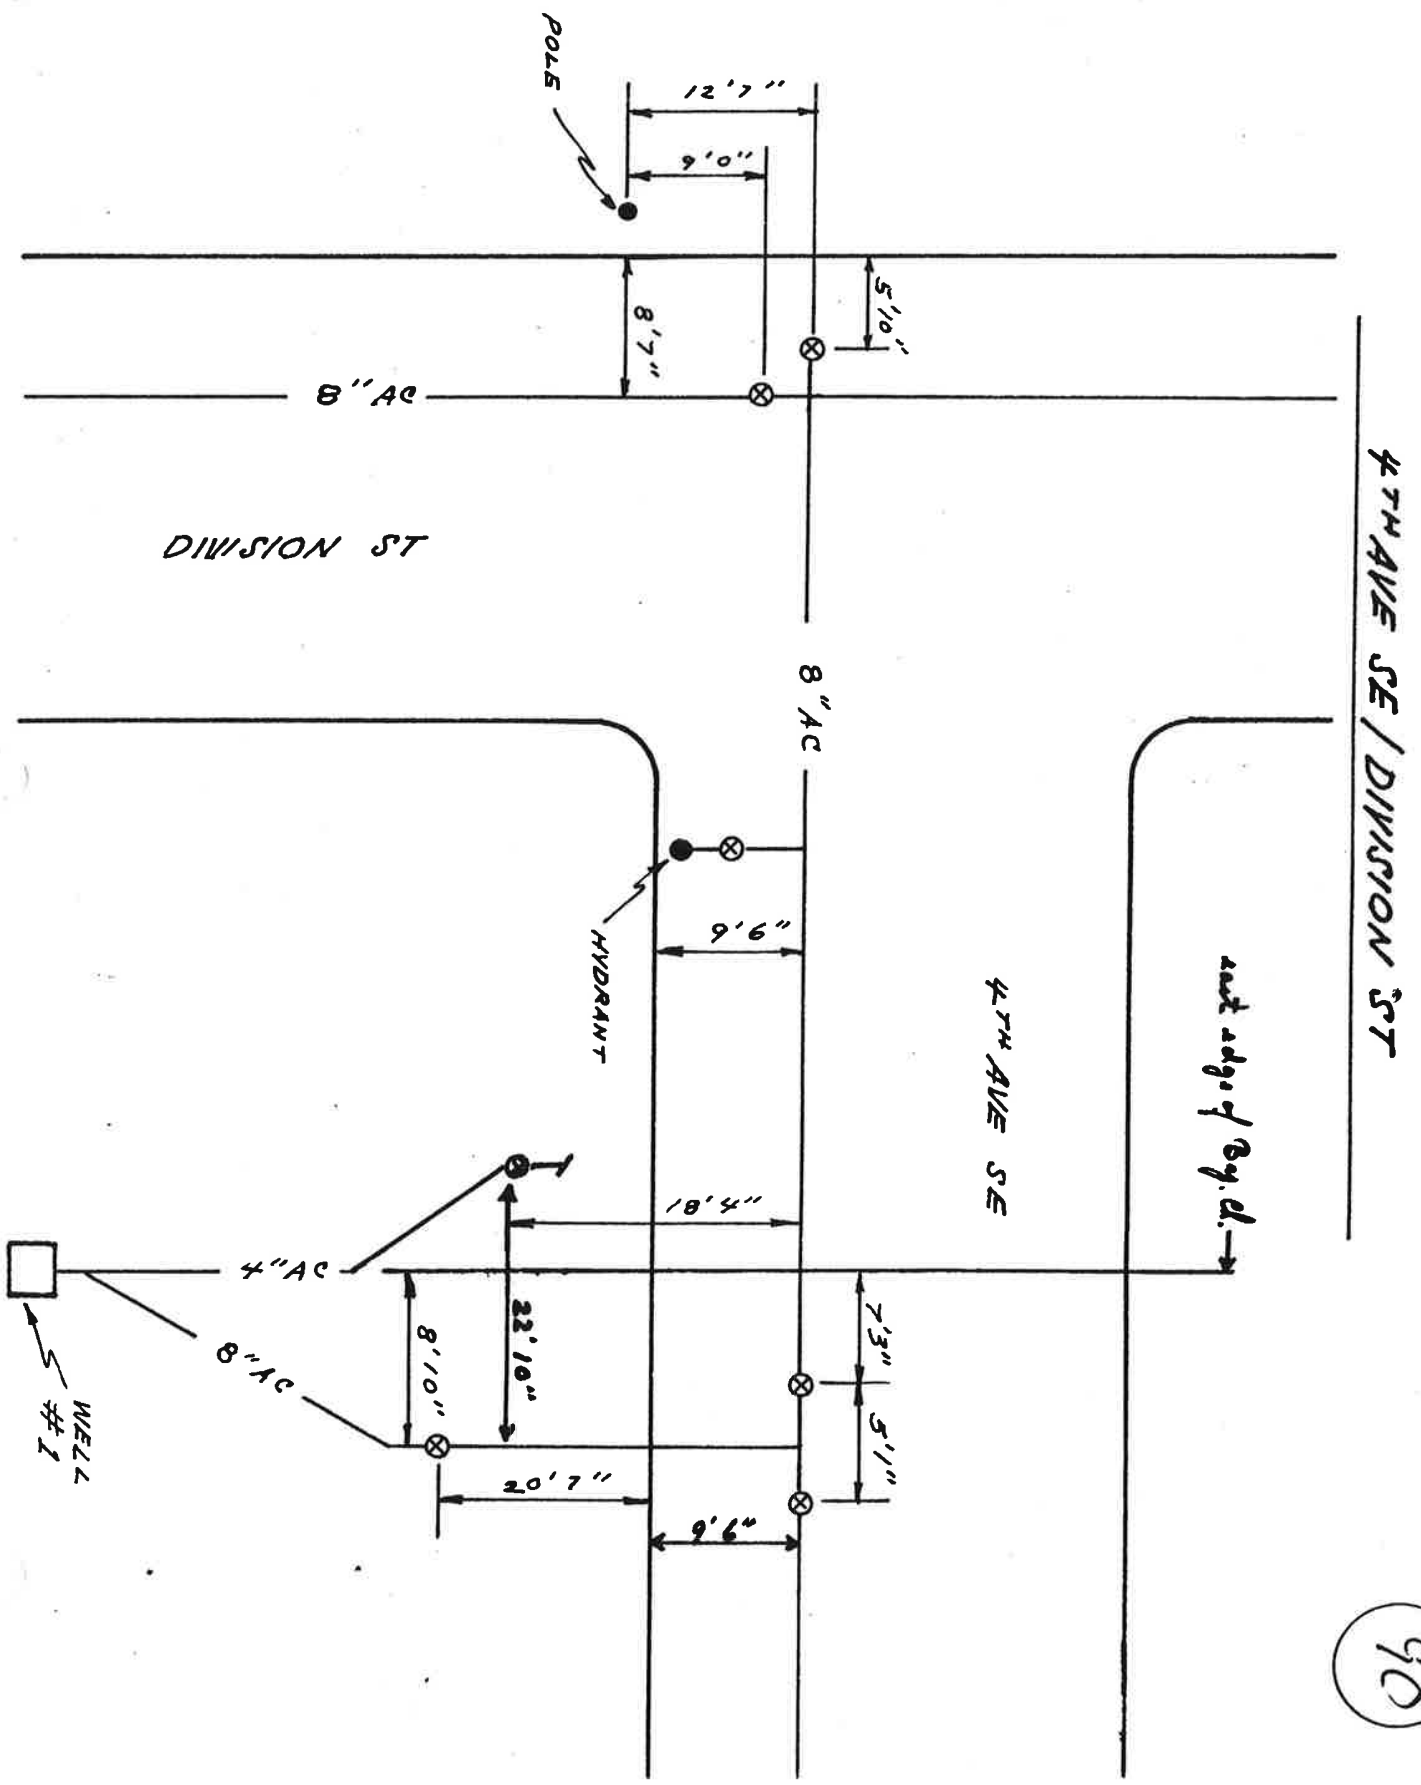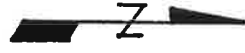

90

4TH PLACE / 4TH AVE / ASTER ST SE

4TH AVE SE

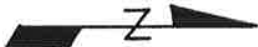

8" AC

CO

MH

MH

ASTER ST SE

HYDRANT

8" AC

4TH AVE SE

WELL #2

FENCE

2" PLASTIC


4TH PLACE SE


13'0"

12'7"

CO

MH

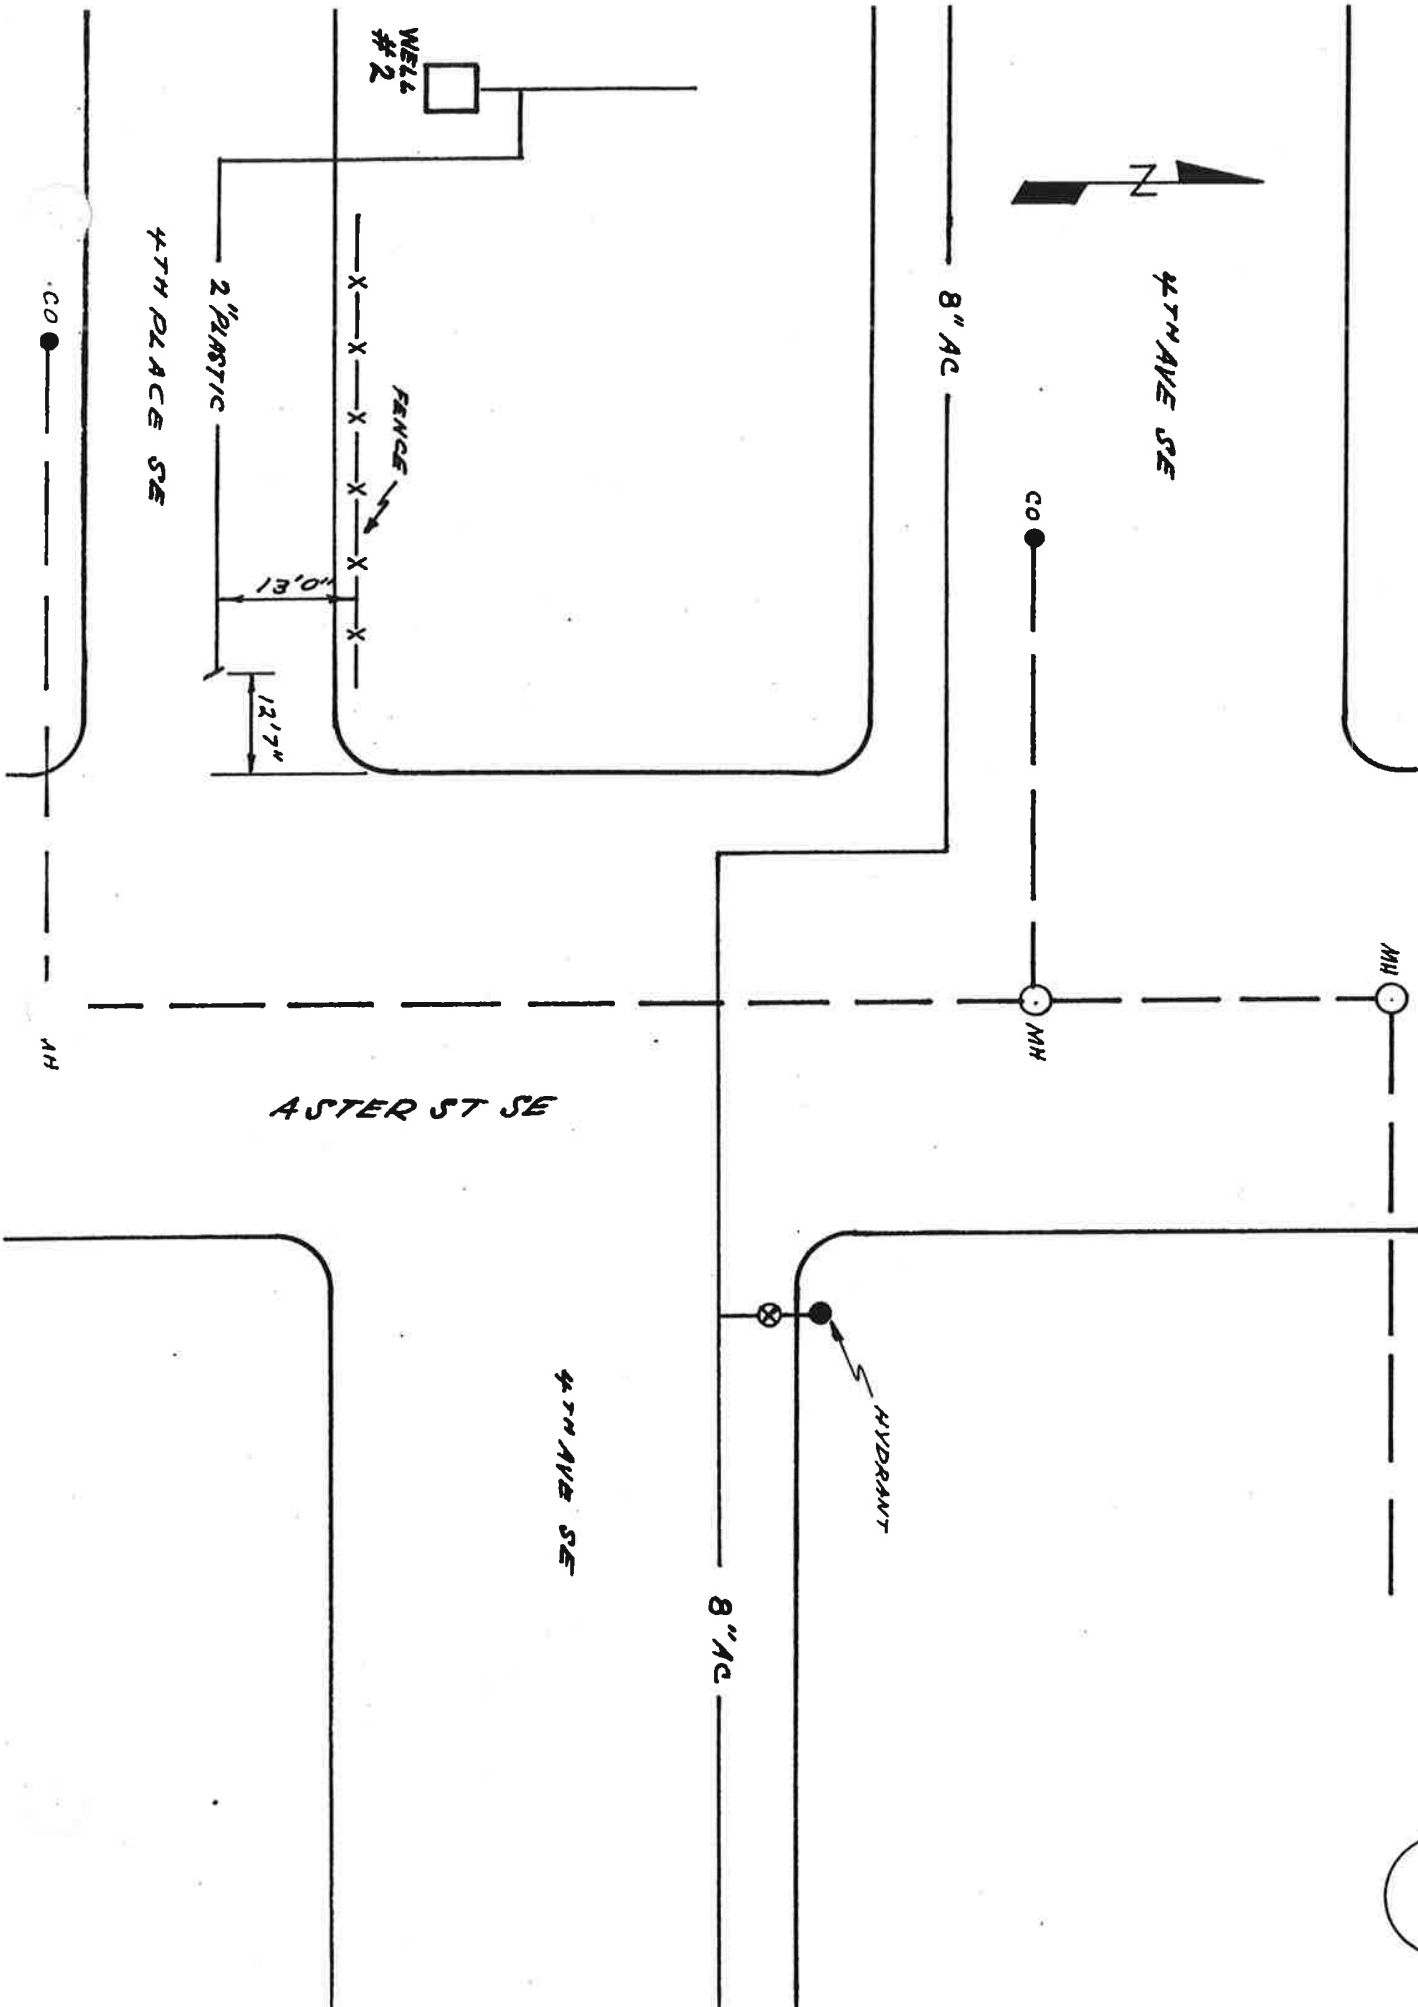

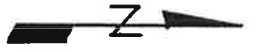

4TH AVE / BUTTERCUP ST SE

92

8" AC

4TH AVE SE

BUTTERCUP ST SE

6" AC

5'11"


HYDRANT


5' 2 1/2"

17'4"

S2 WATER LINE UNDER SIDEWALK

2" STBR L

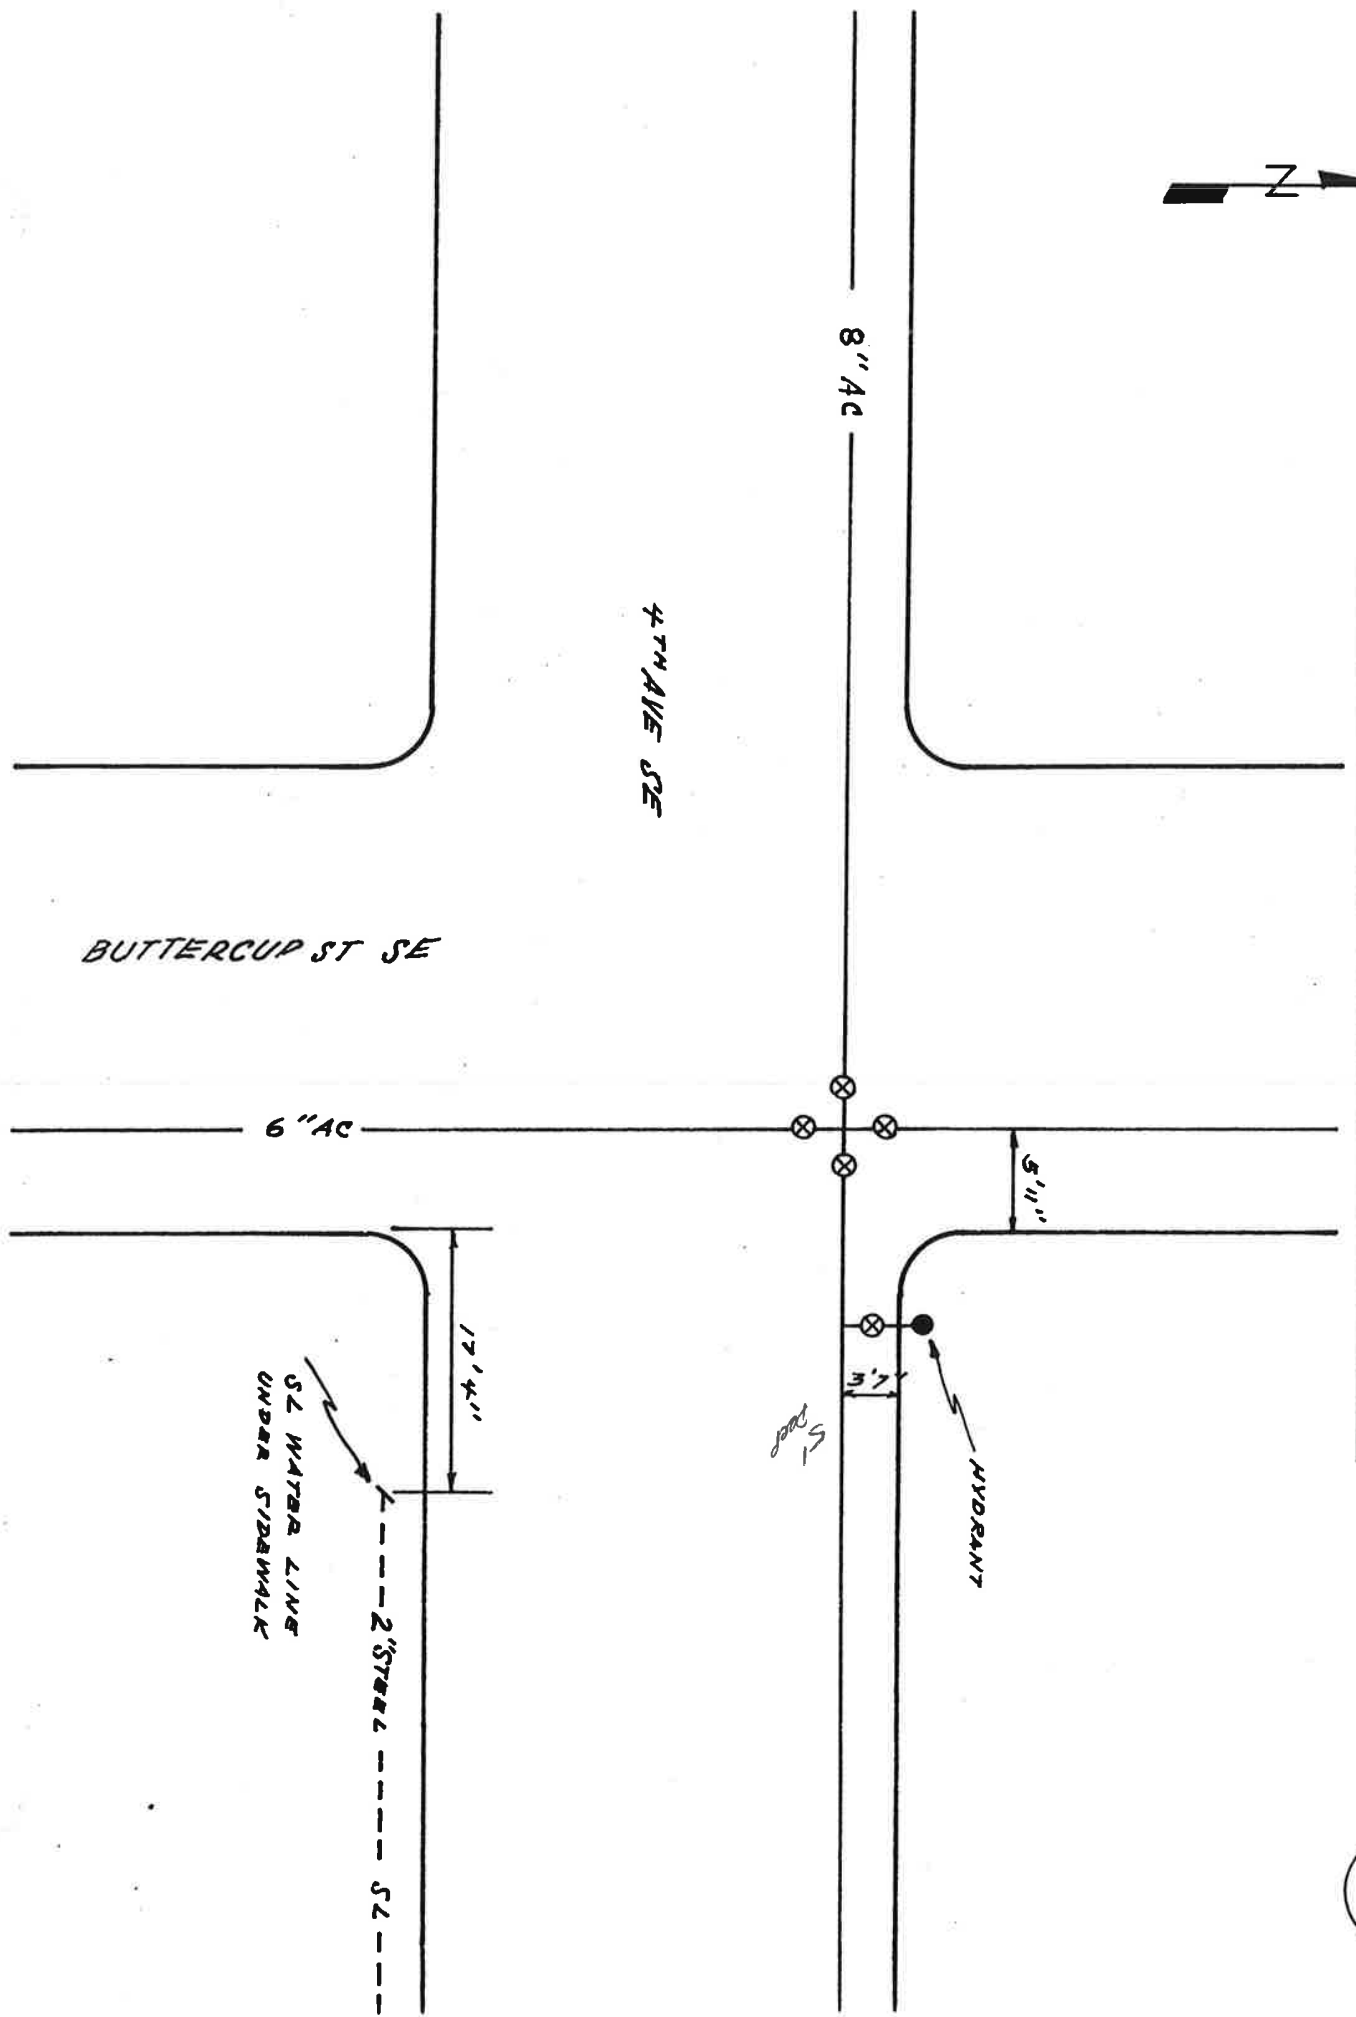

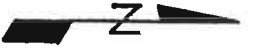

4TH AVE / CANNA ST SE

93

GRADE SCHOOL
METER BOX

8" AC

1.5"

4" AC

4TH AVE SE

HYDRANT


2" PVC


-2" PVC ends AT WEST SIDE
OF 243 4TH AVE. S.E. FENCE
REPLACED 1982

8" C-900

CANNA ST SE


SL

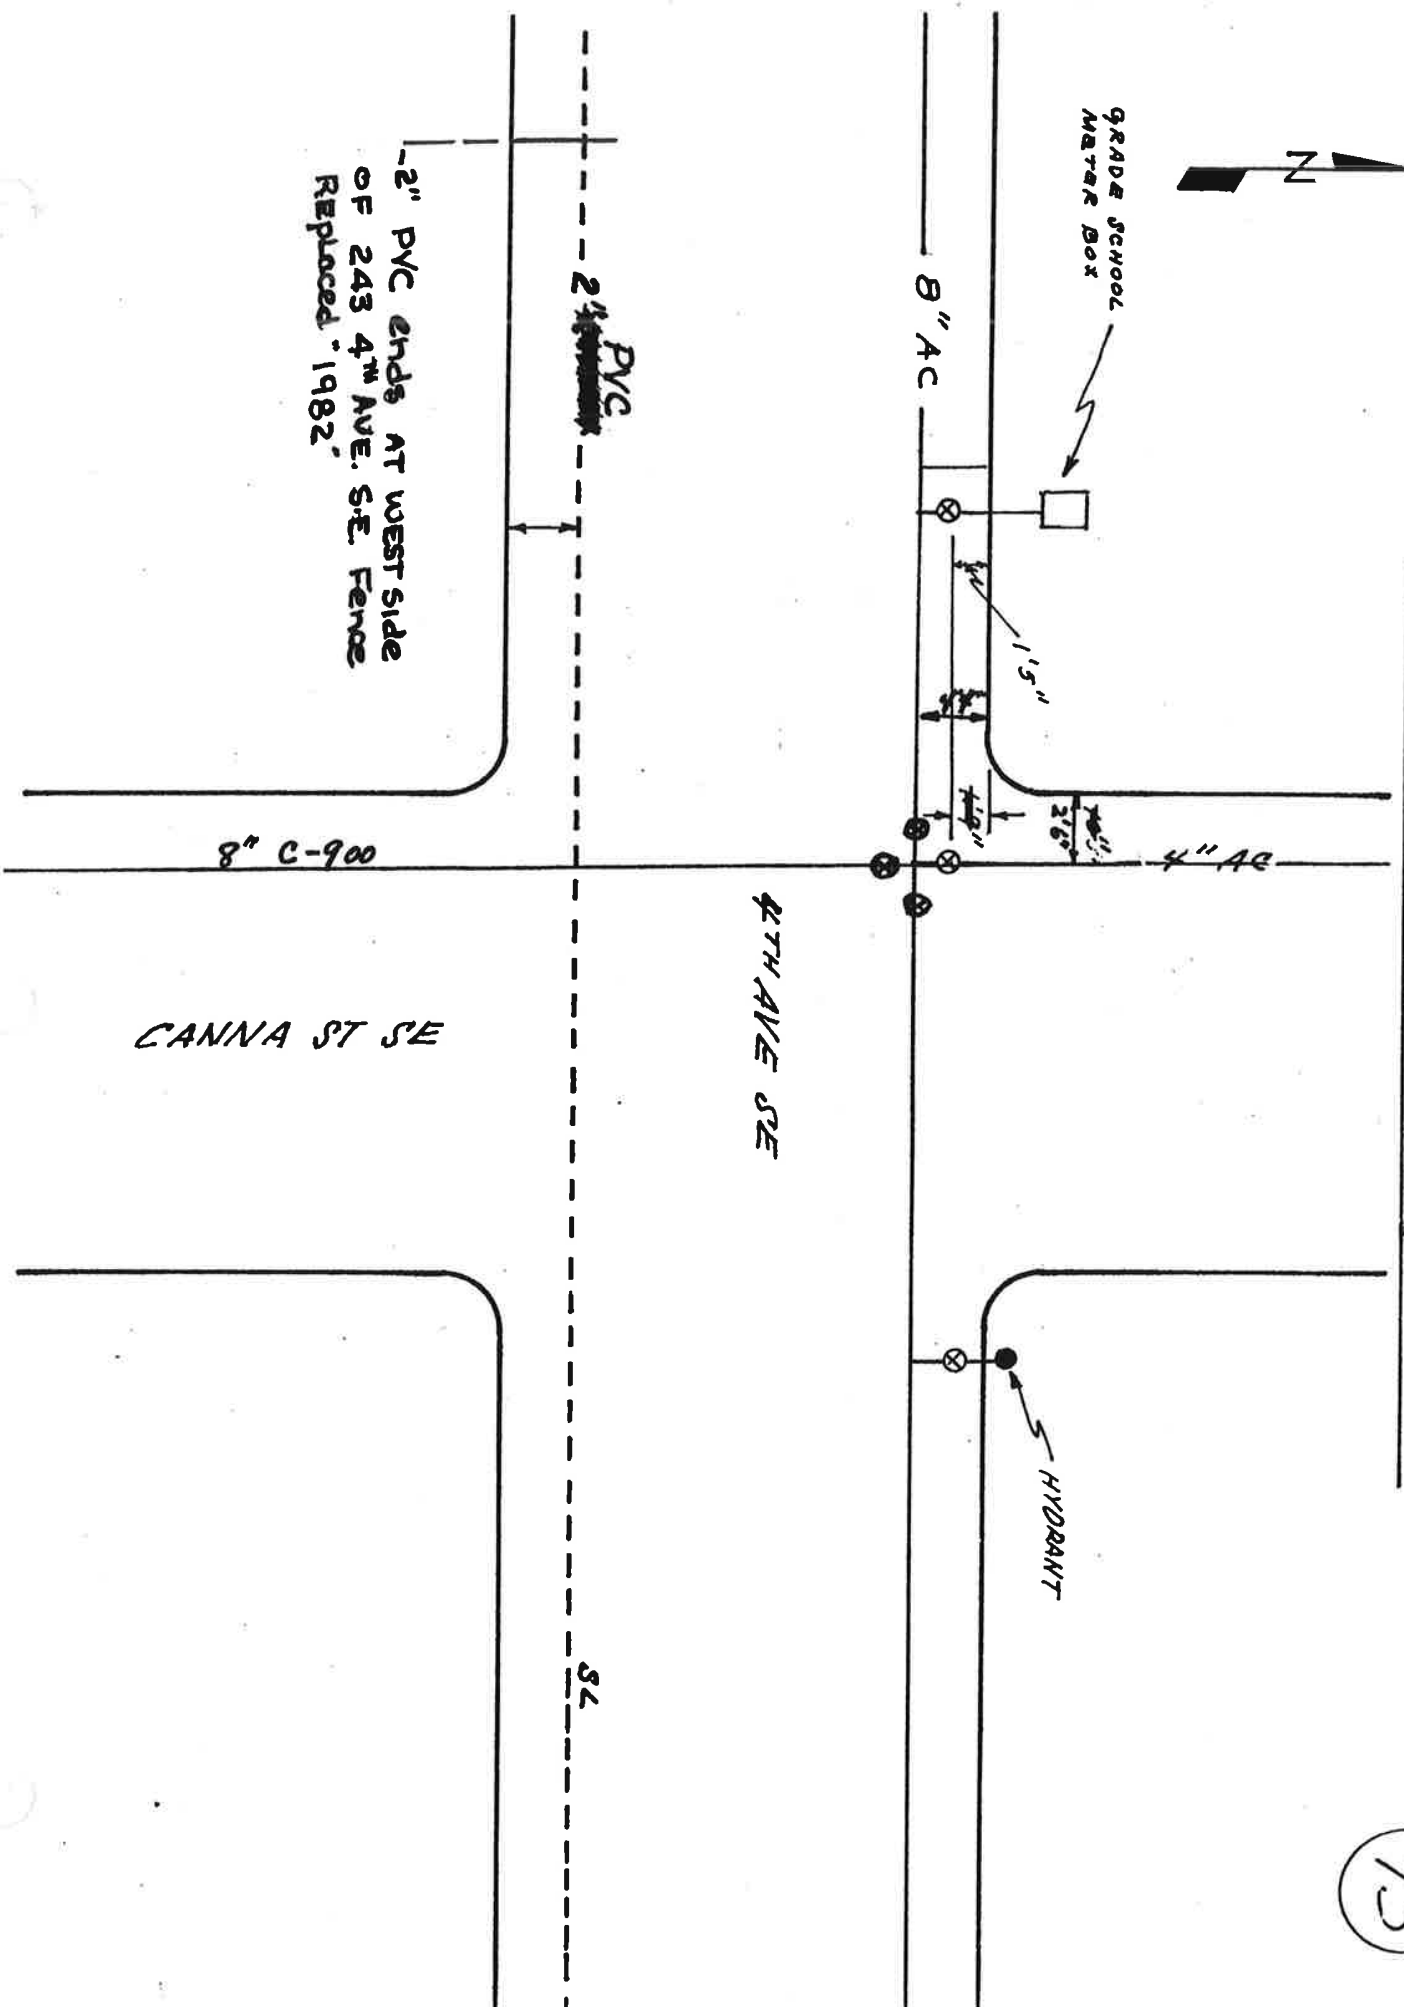

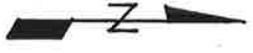

4TH AVE / DAISY ST SE

94

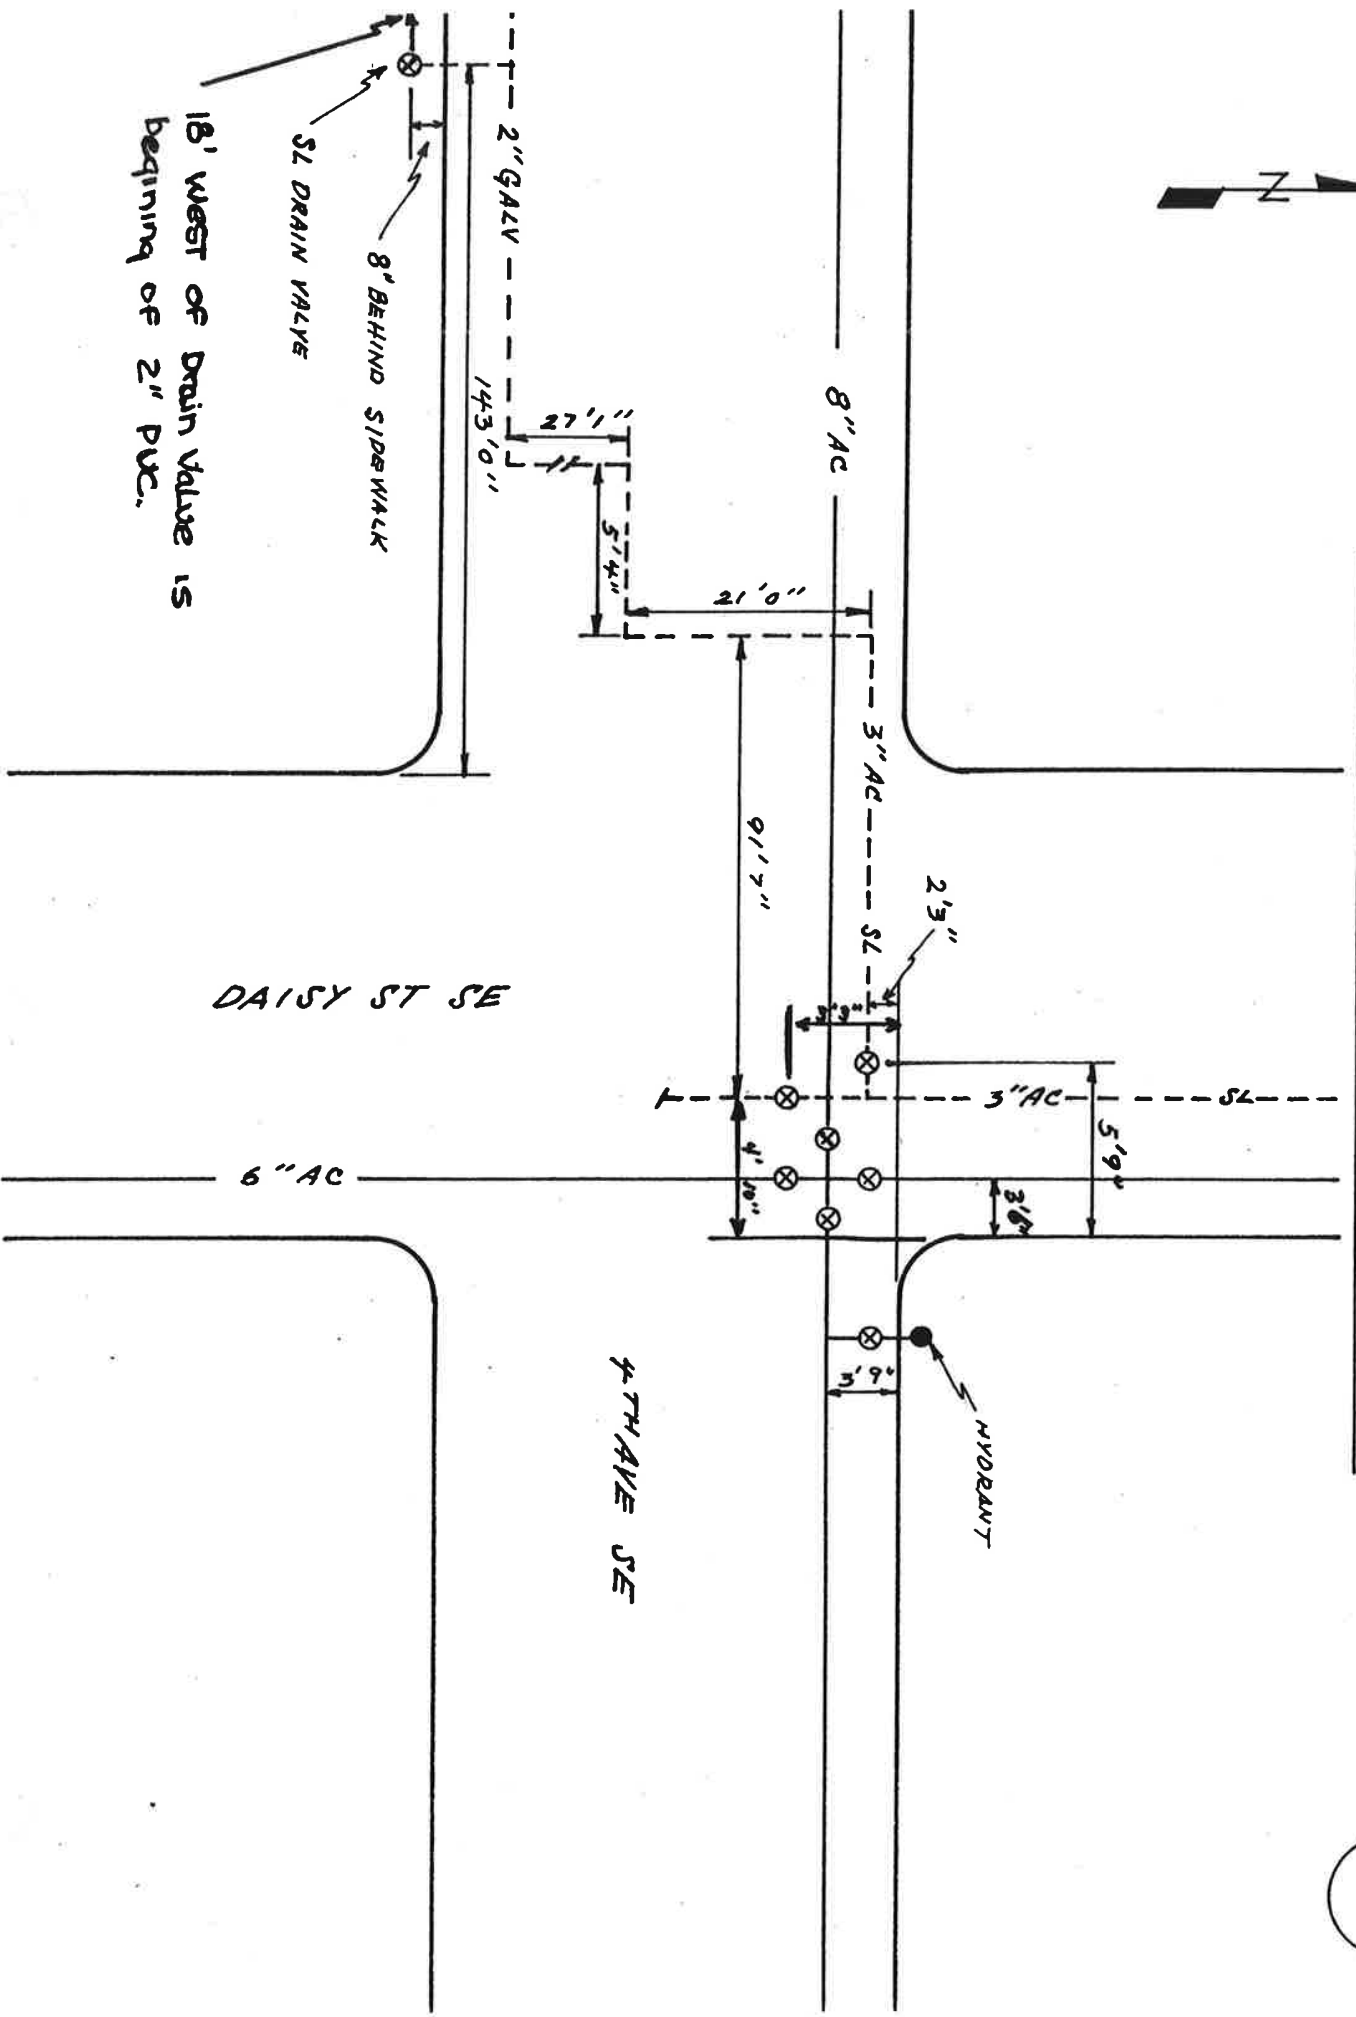

18' WEST OF DRAIN VALVE IS
BEGINNING OF 2" PVC.


SL DRAIN VALVE
8' BEHIND SIDEWALK

DAISY ST SE

6" AC

4TH AVE SE

HYDRANT

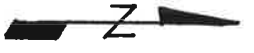

4TH AVE / ELDER ST SE

95


8" AC

6" AC




4TH AVE SE

ELDER ST SE

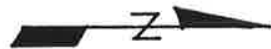


4TH AVE / FERN ST SE

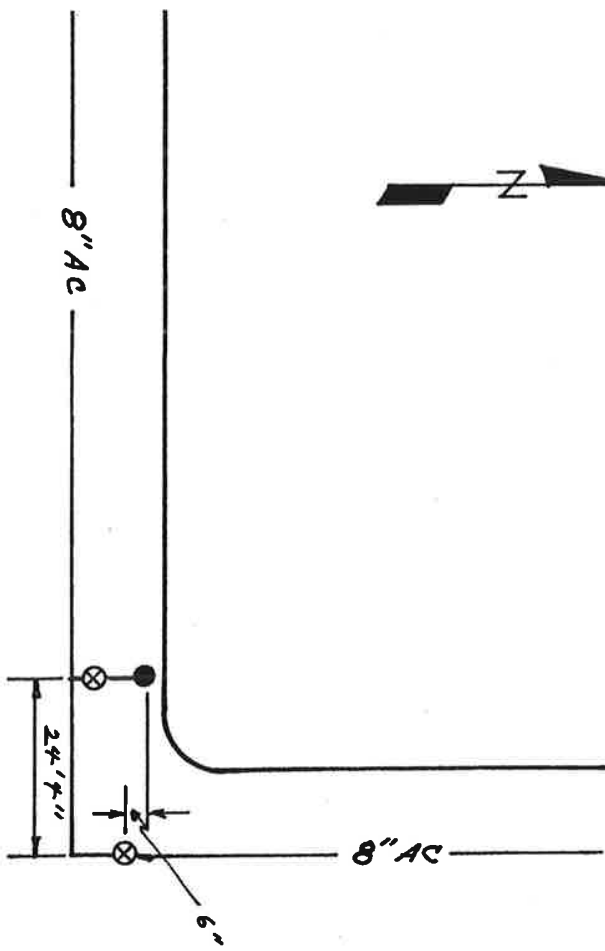


4TH AVE SE


FERN ST SE

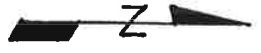

5TH AVE SE / DIVISION ST S

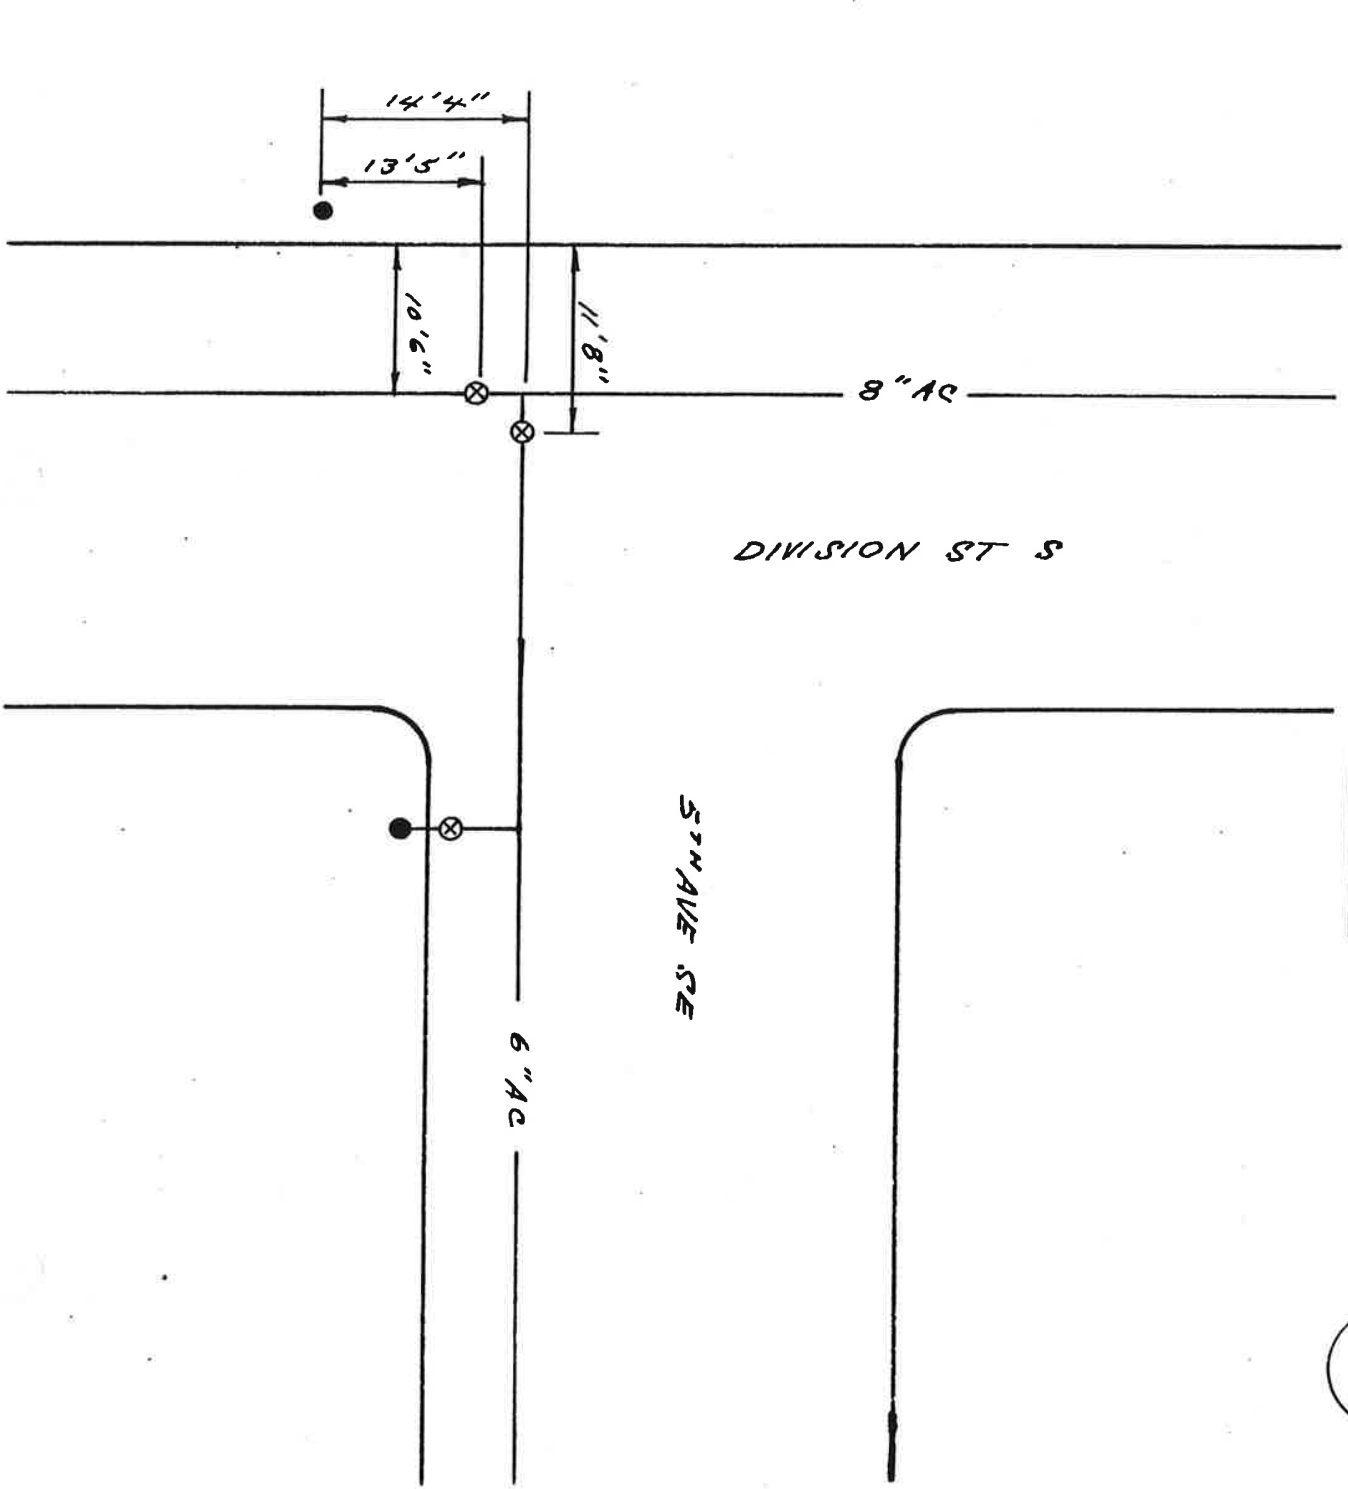

97

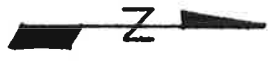


98


5TH AVE / ASTER ST SE

5TH AVE SE

6" AC

ASTER ST SE

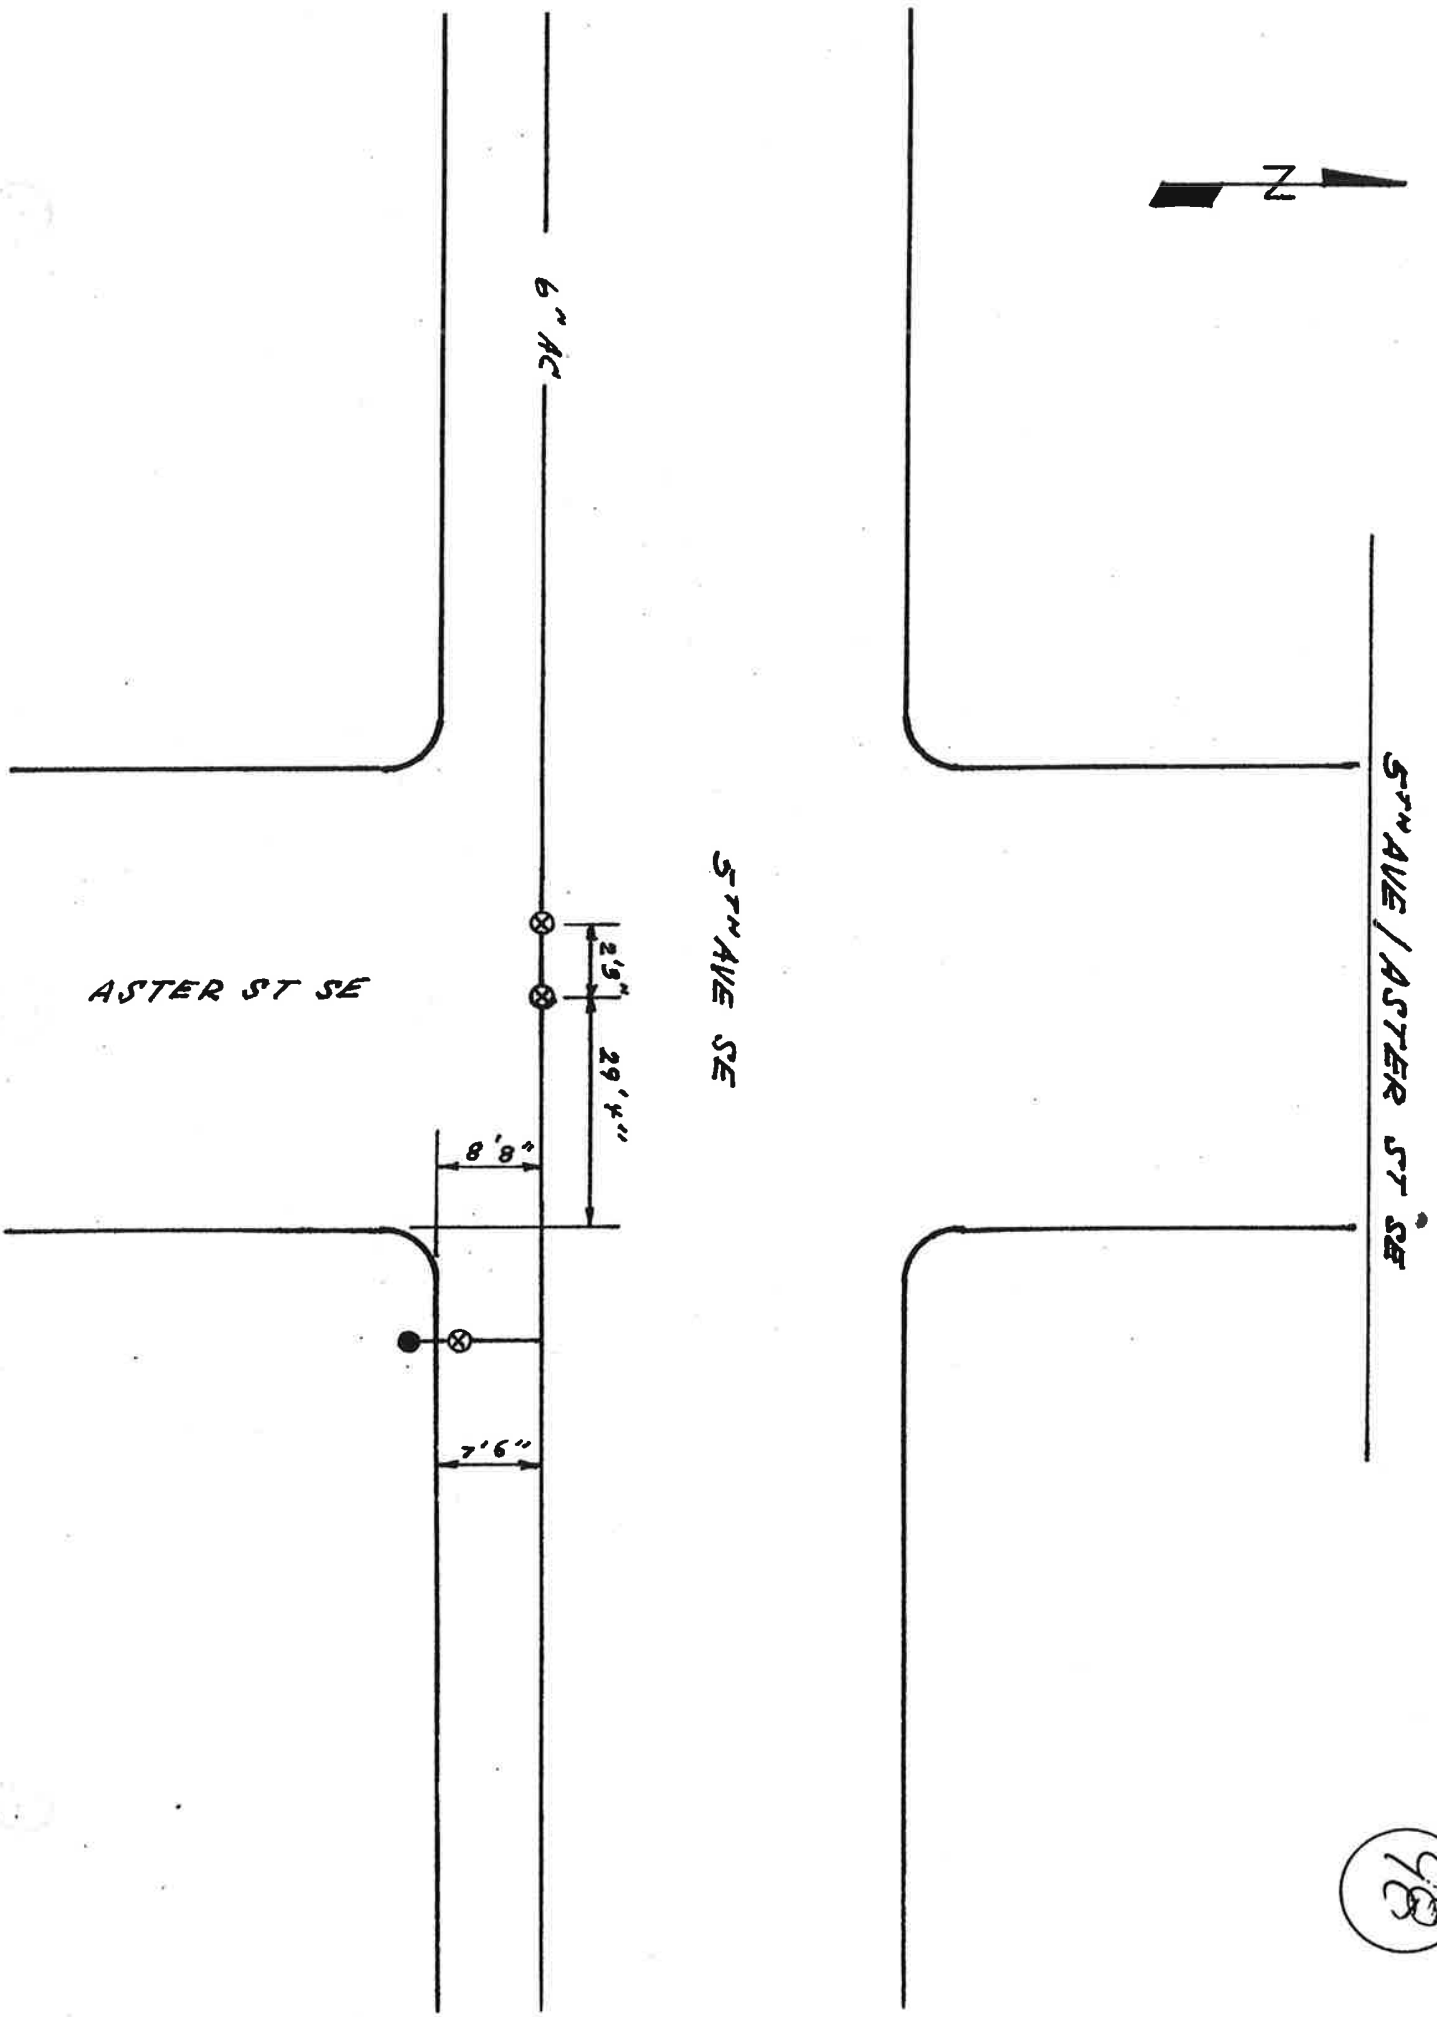


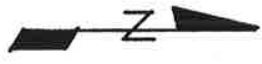



5TH AVE / BUTTERCUP ST SE

5TH AVE SE


BUTTERCUP ST SE

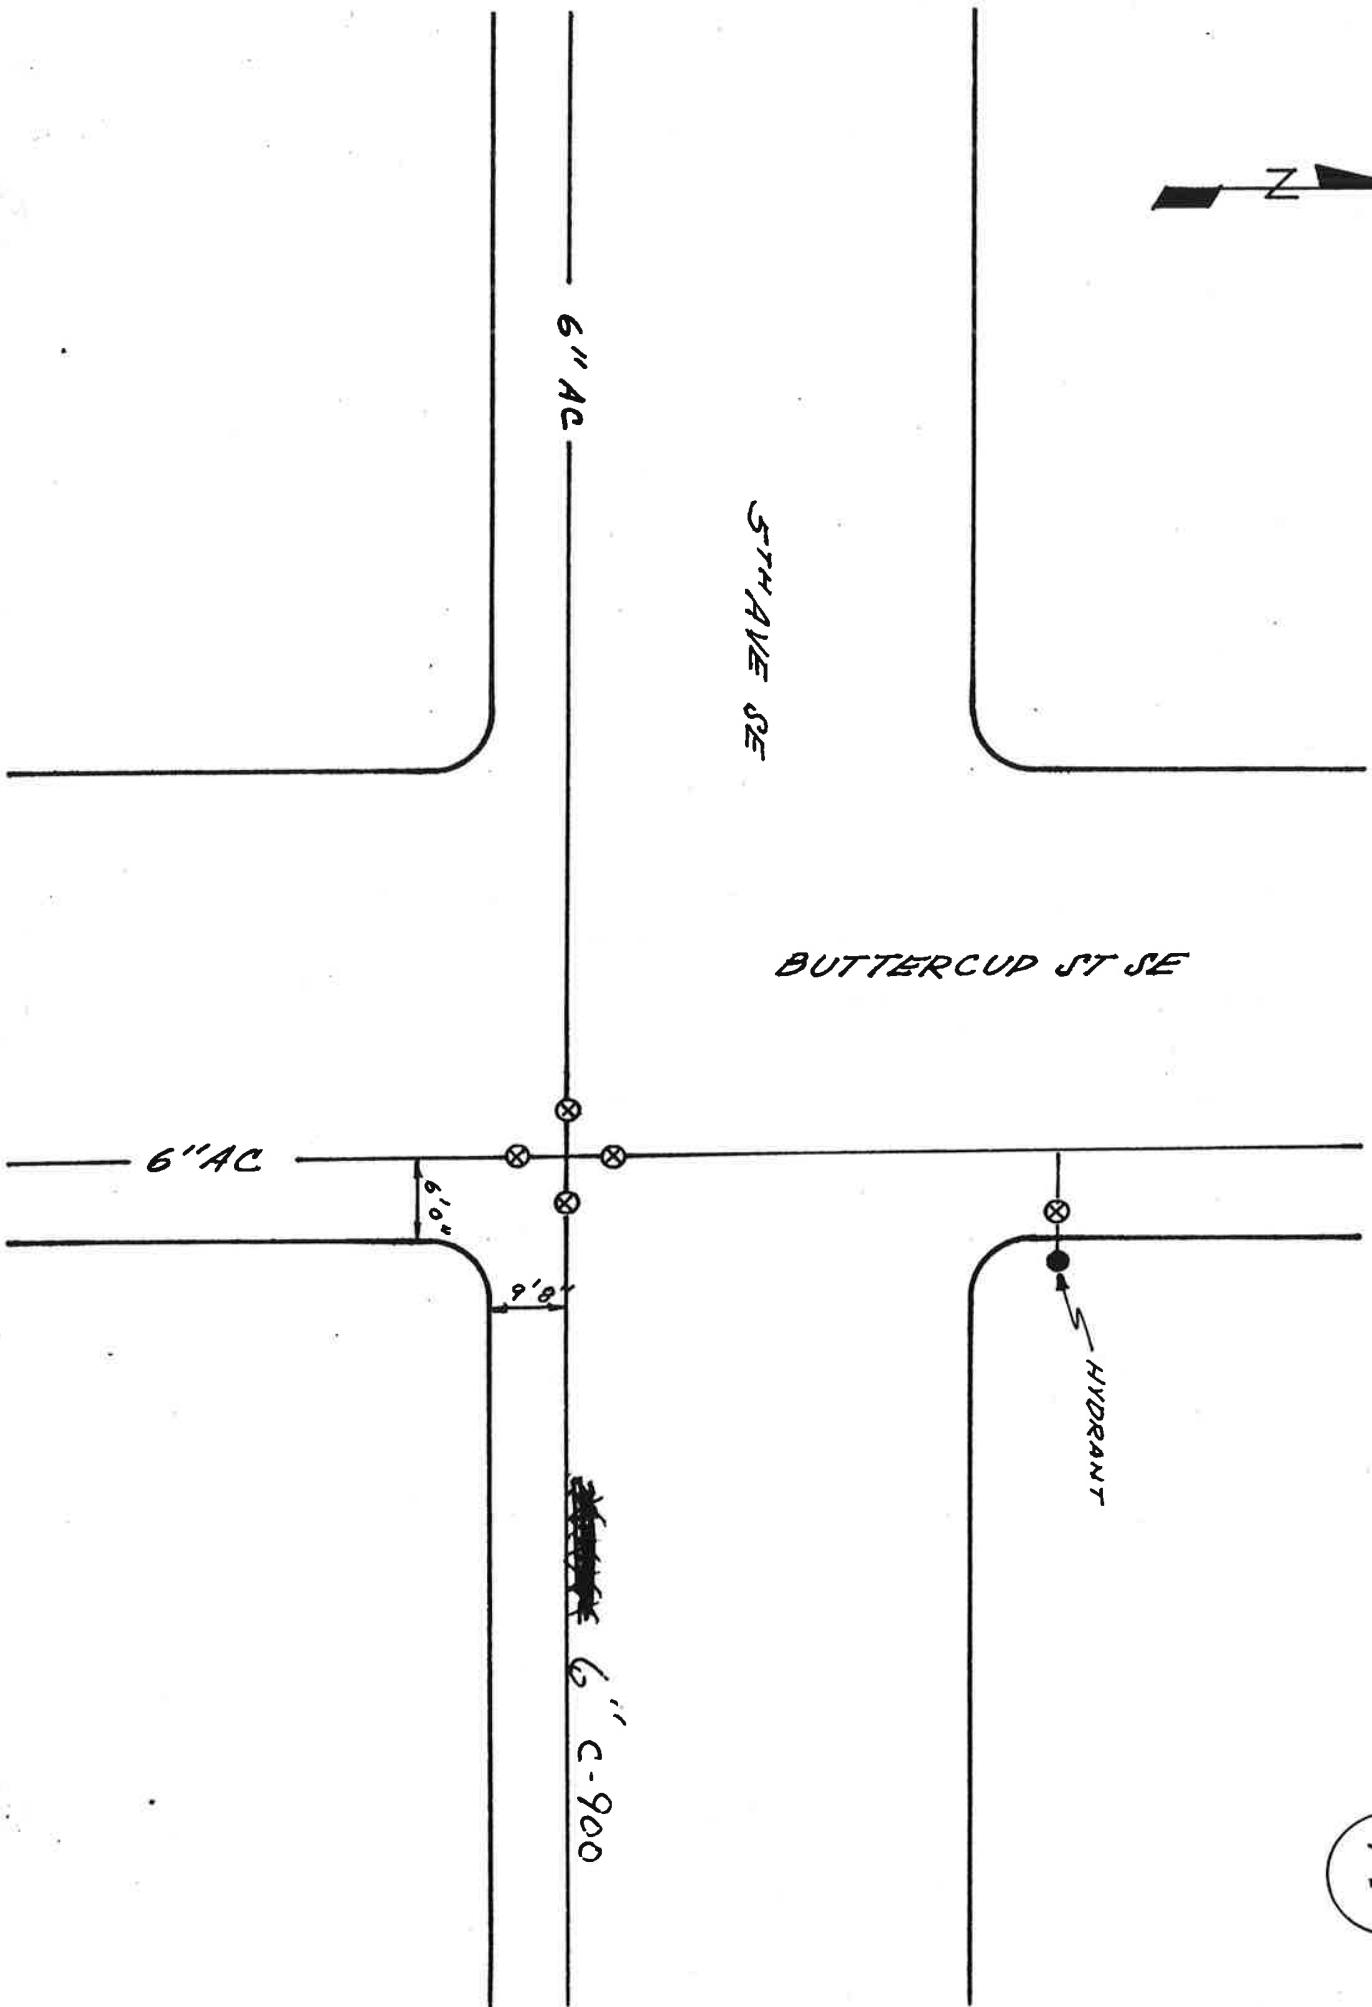

99

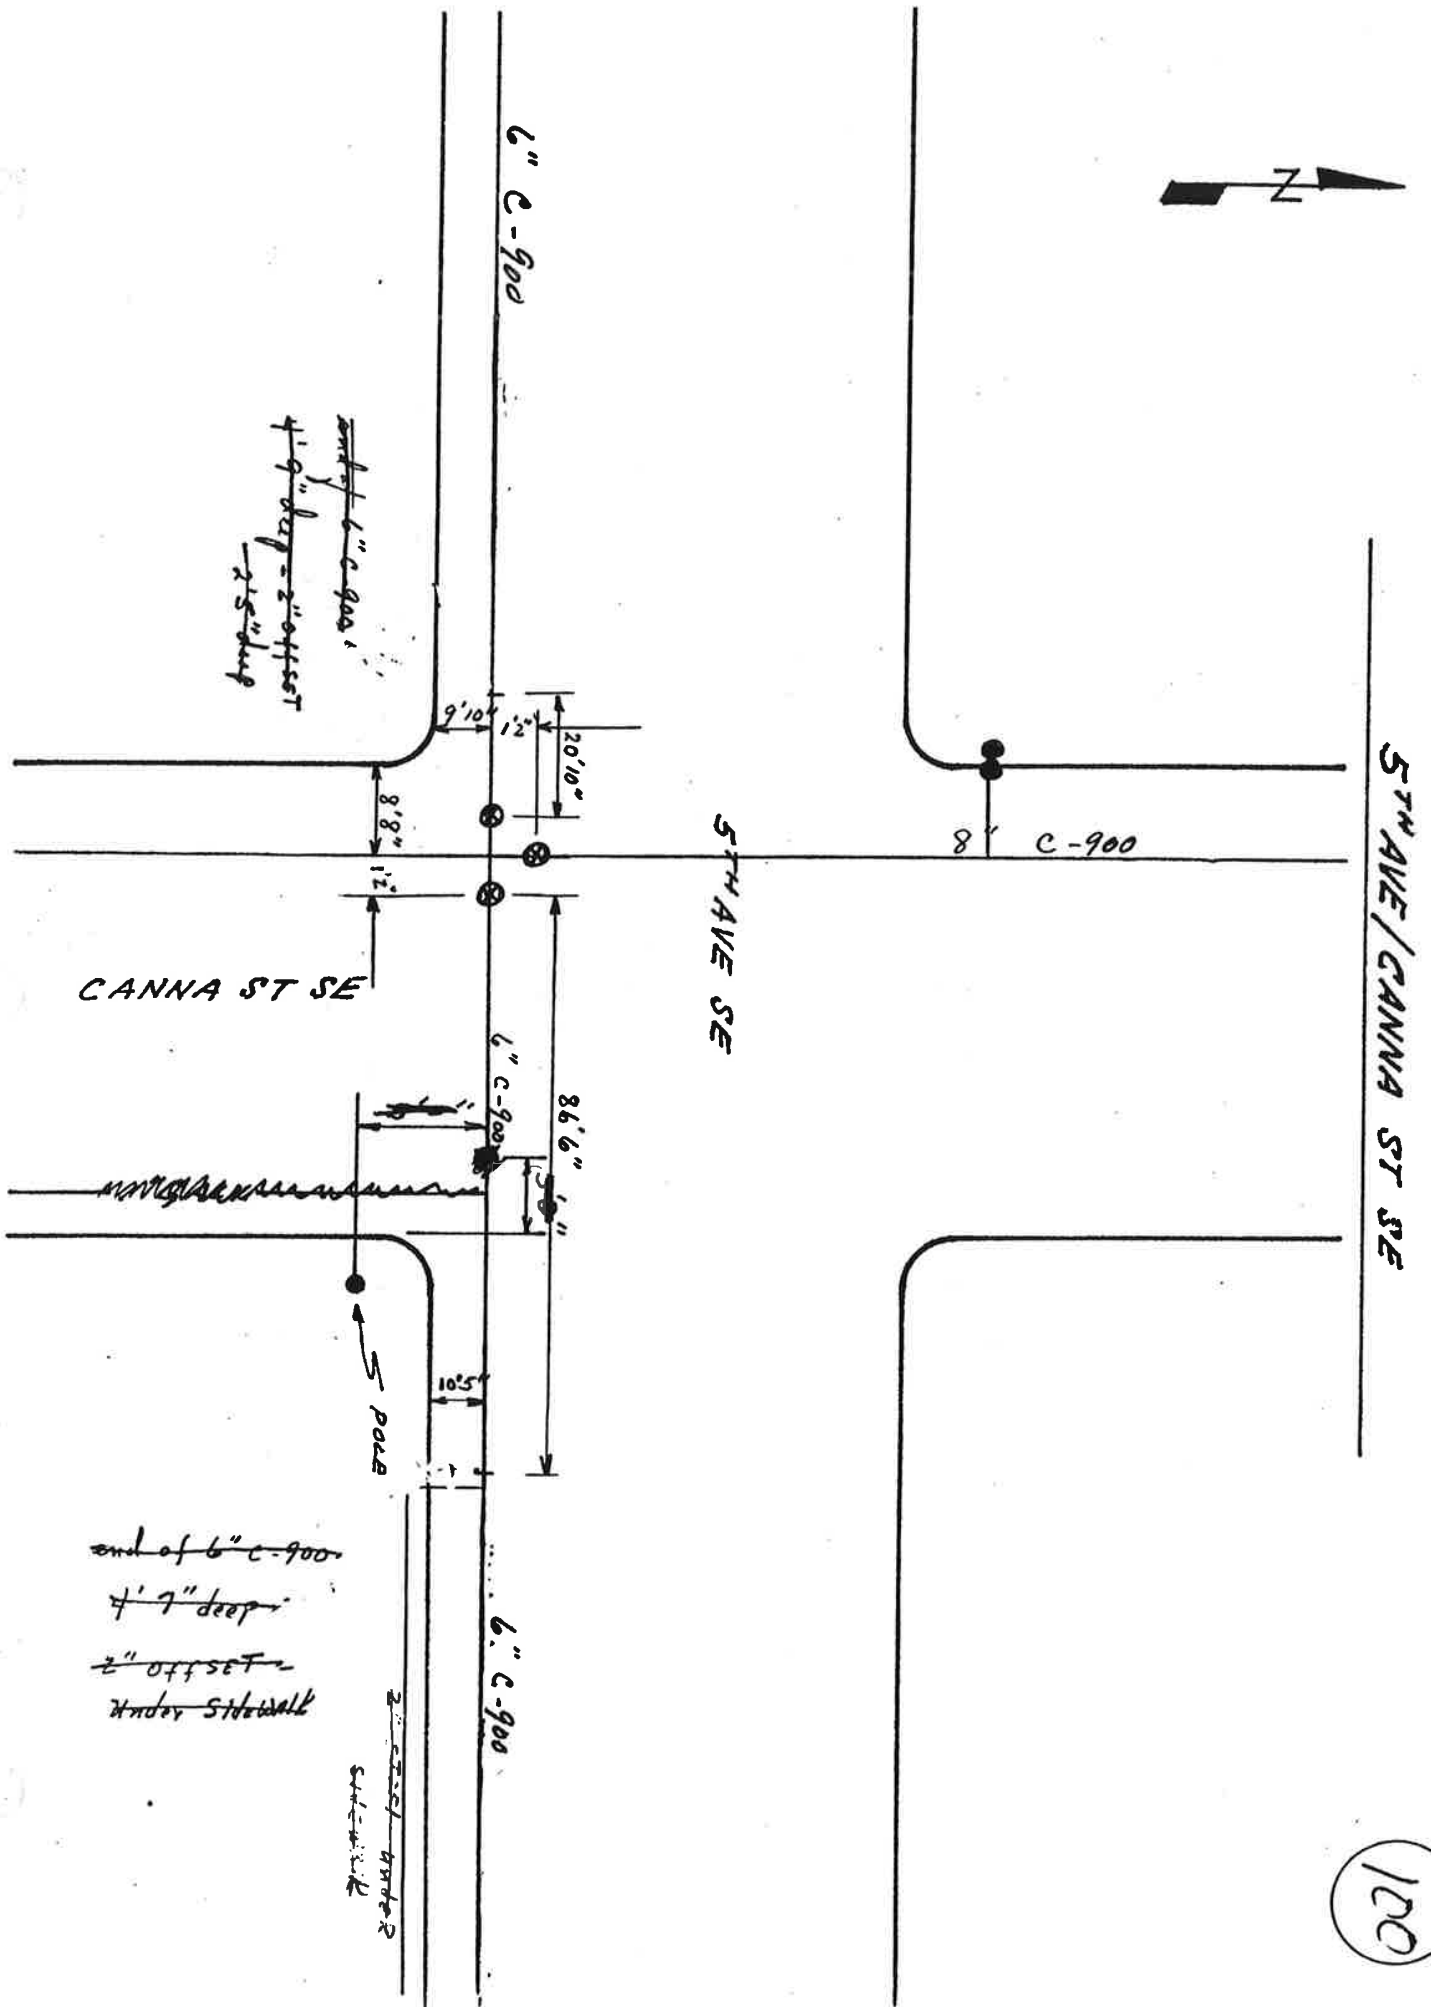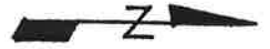


120

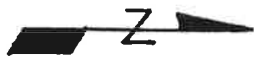


5TH AVE / DAISY ST. SE

5TH AVE SE

DAISY ST SE

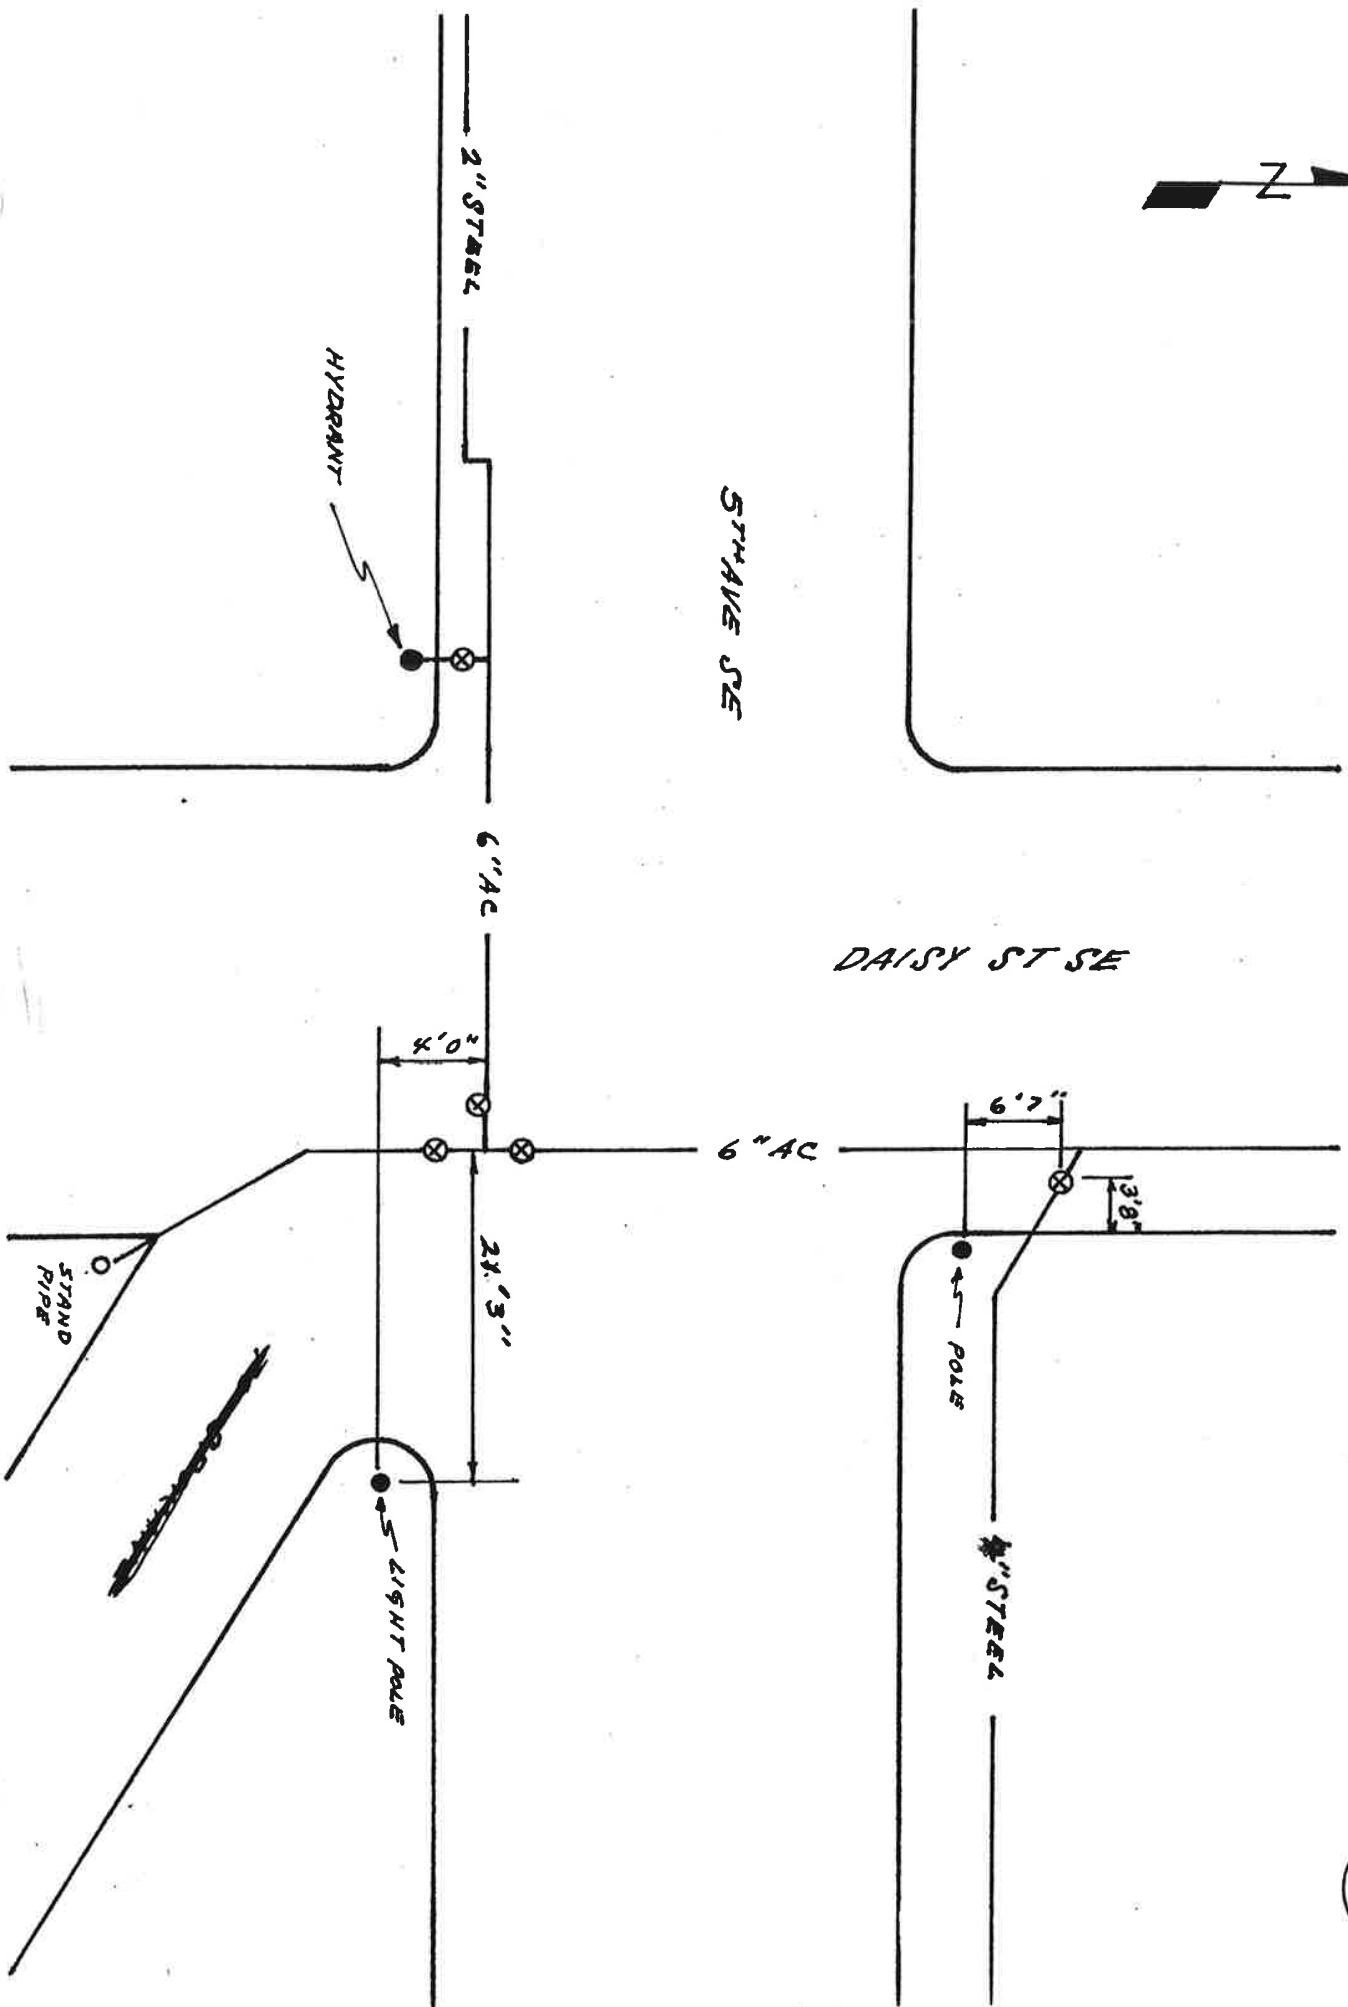

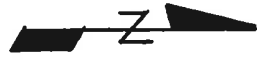



5TH AVE / ELDER ST SE

102

5TH AVE SE

ELDER ST SE

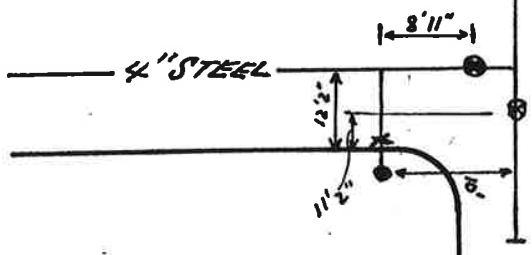

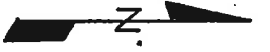



5TH AVE / FERN ST SE

4" STEEL

5TH AVE SE


FERN ST SE

103

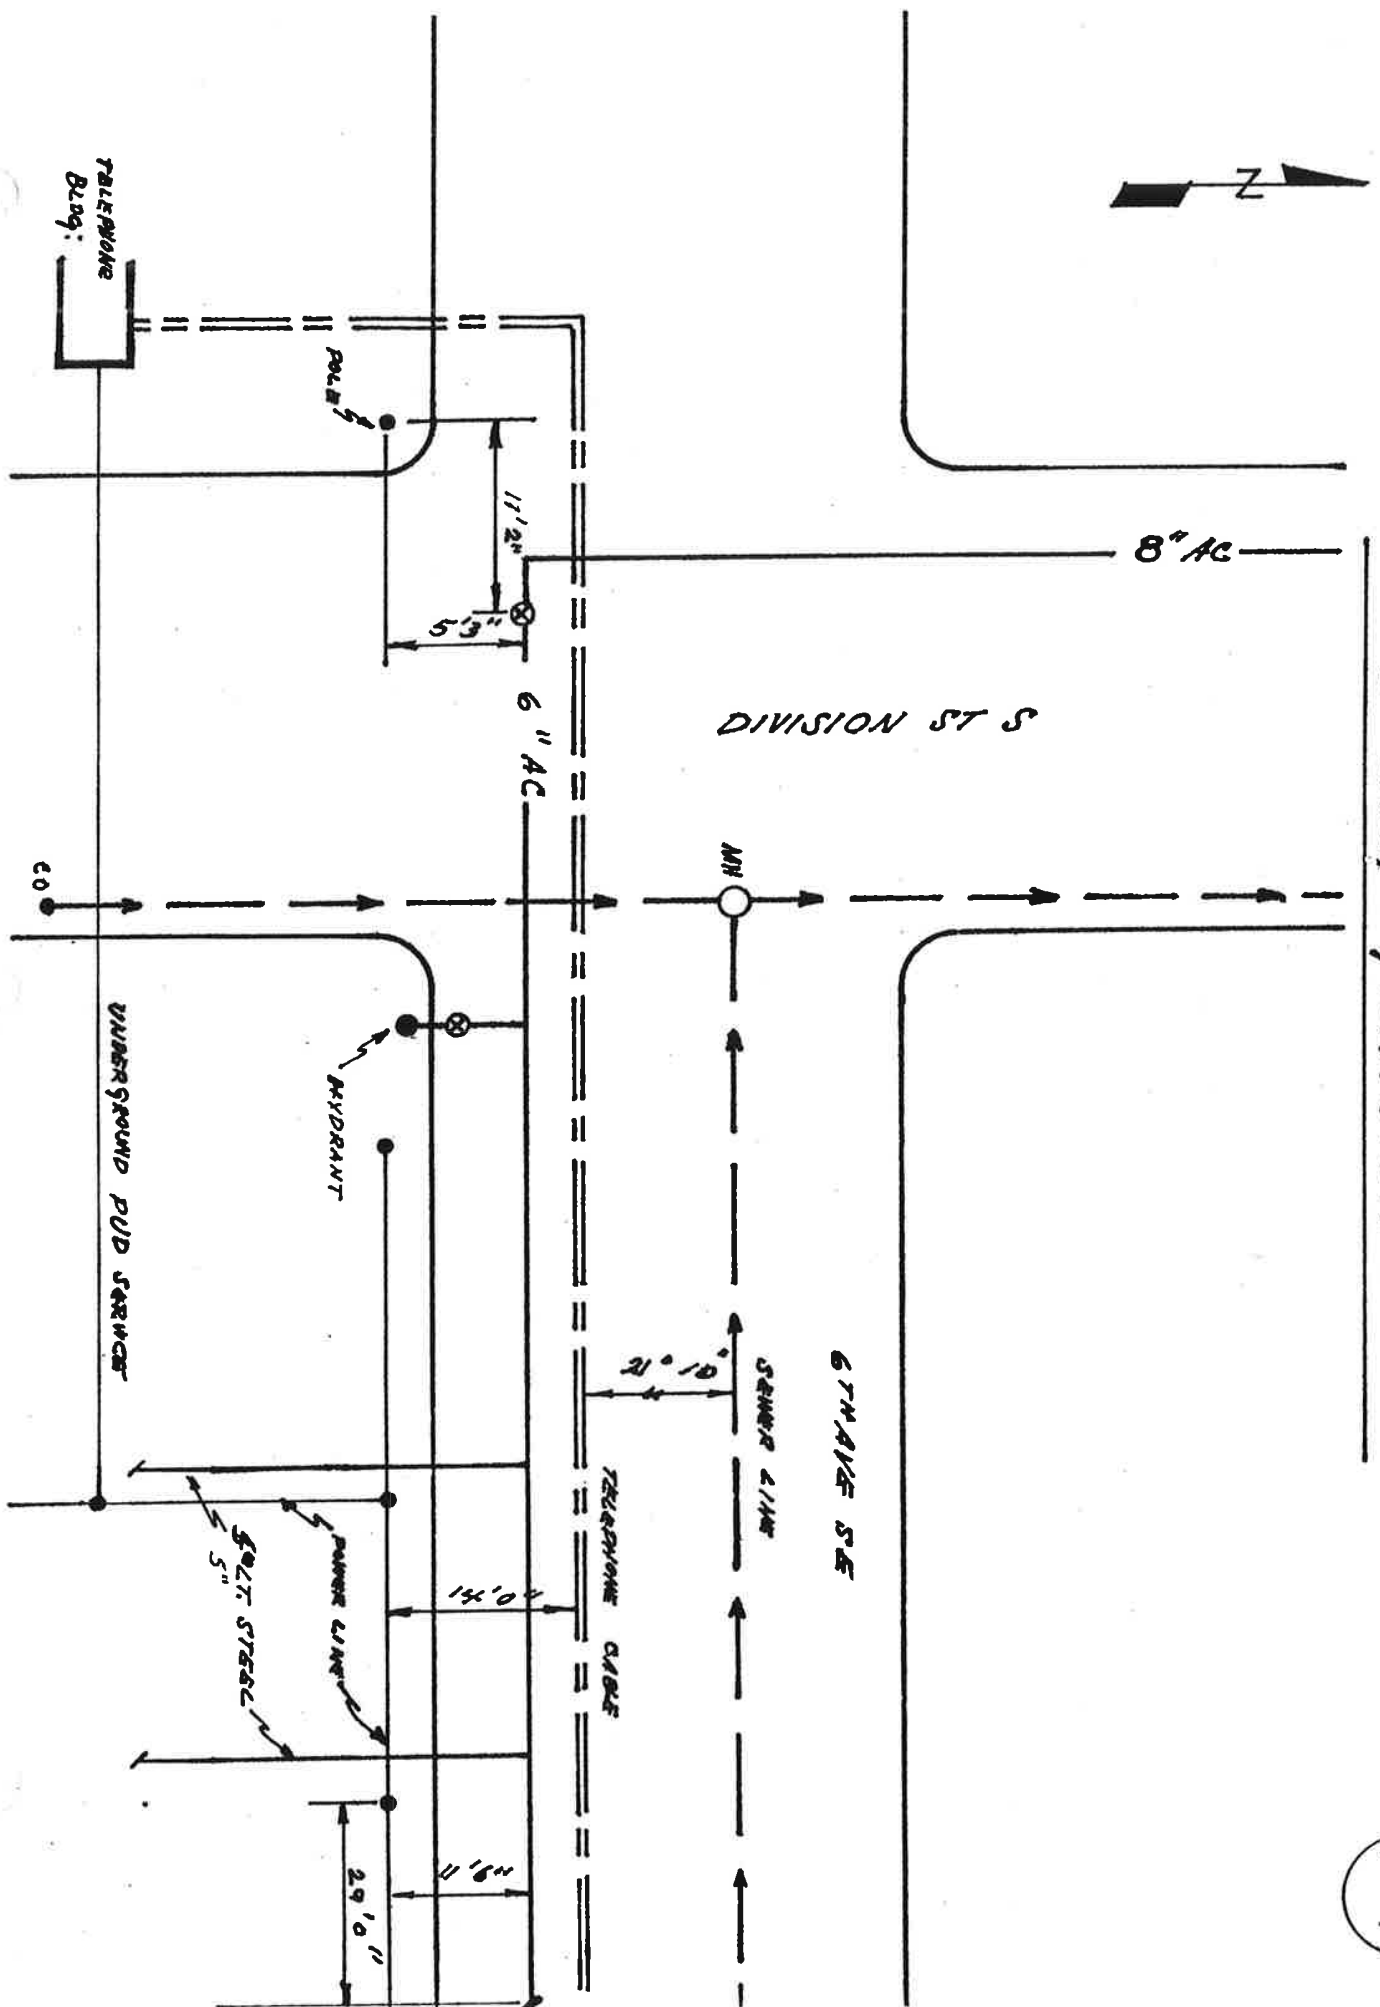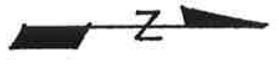

6th Ave / Aster Street S.E.


ASTER STREET S.E.


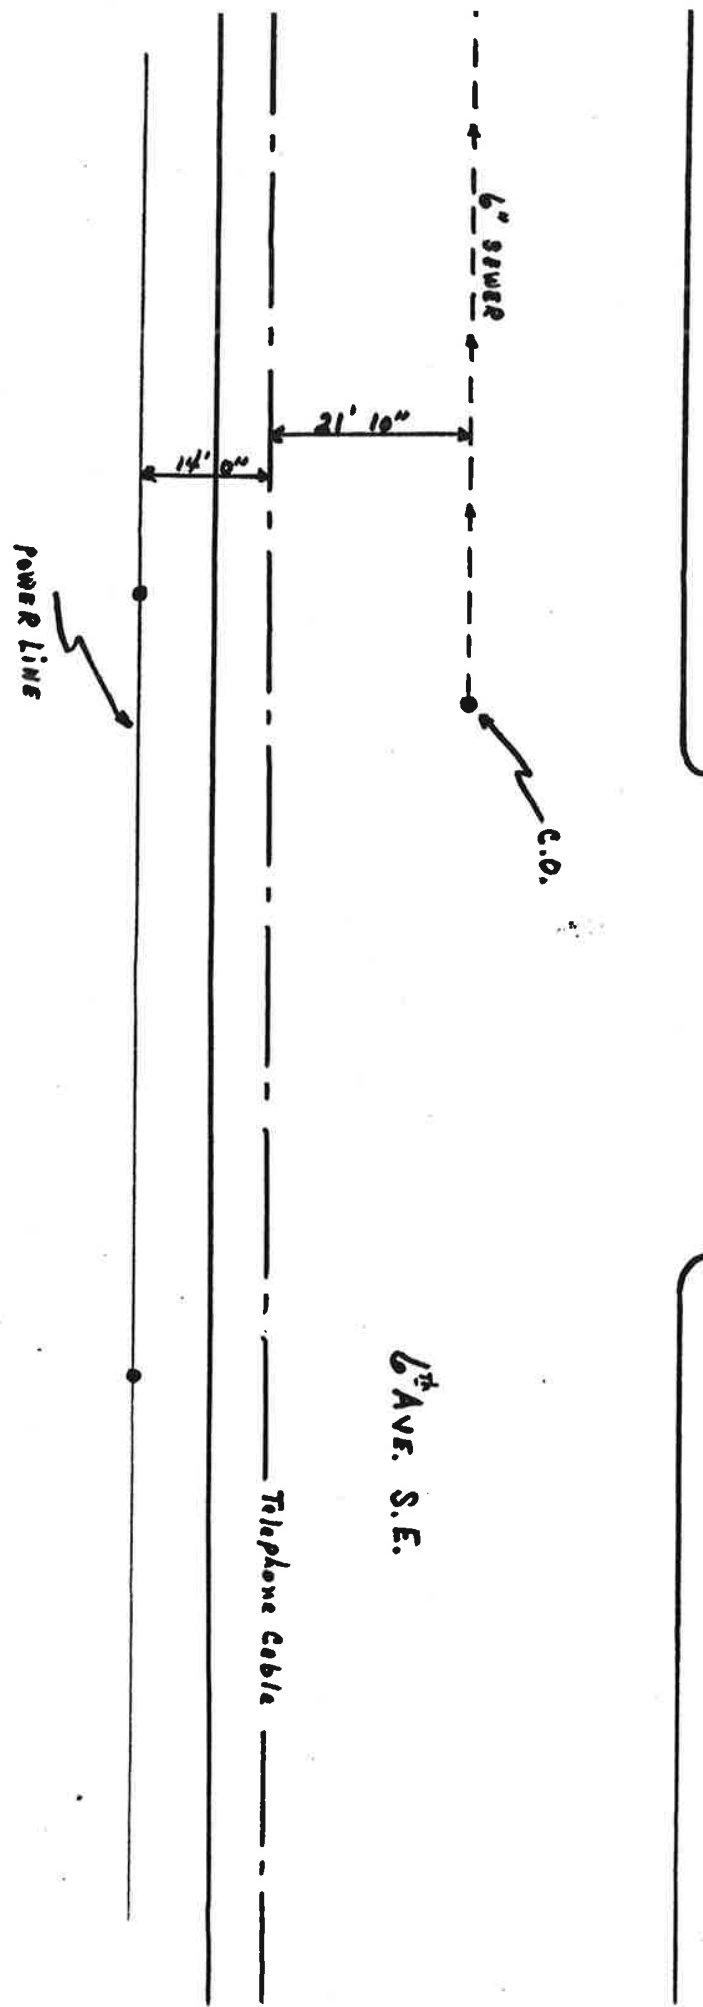




6TH AVE / 3RD PLACE SE

106

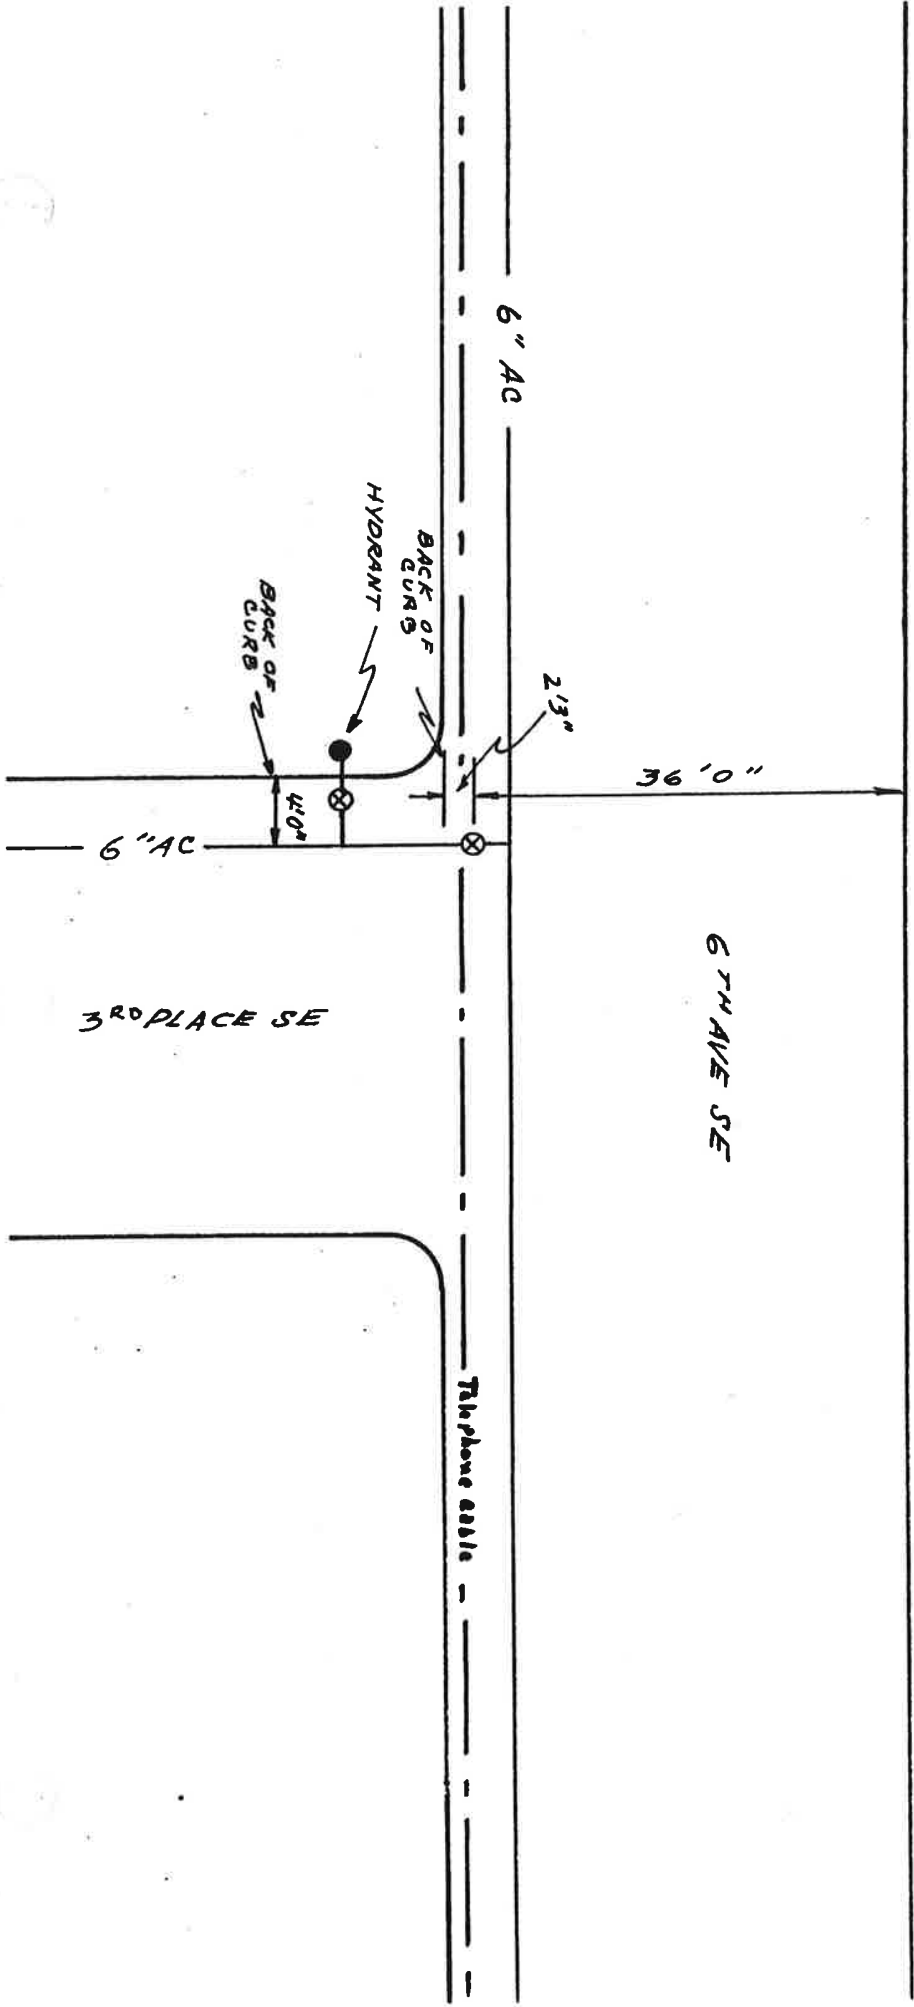

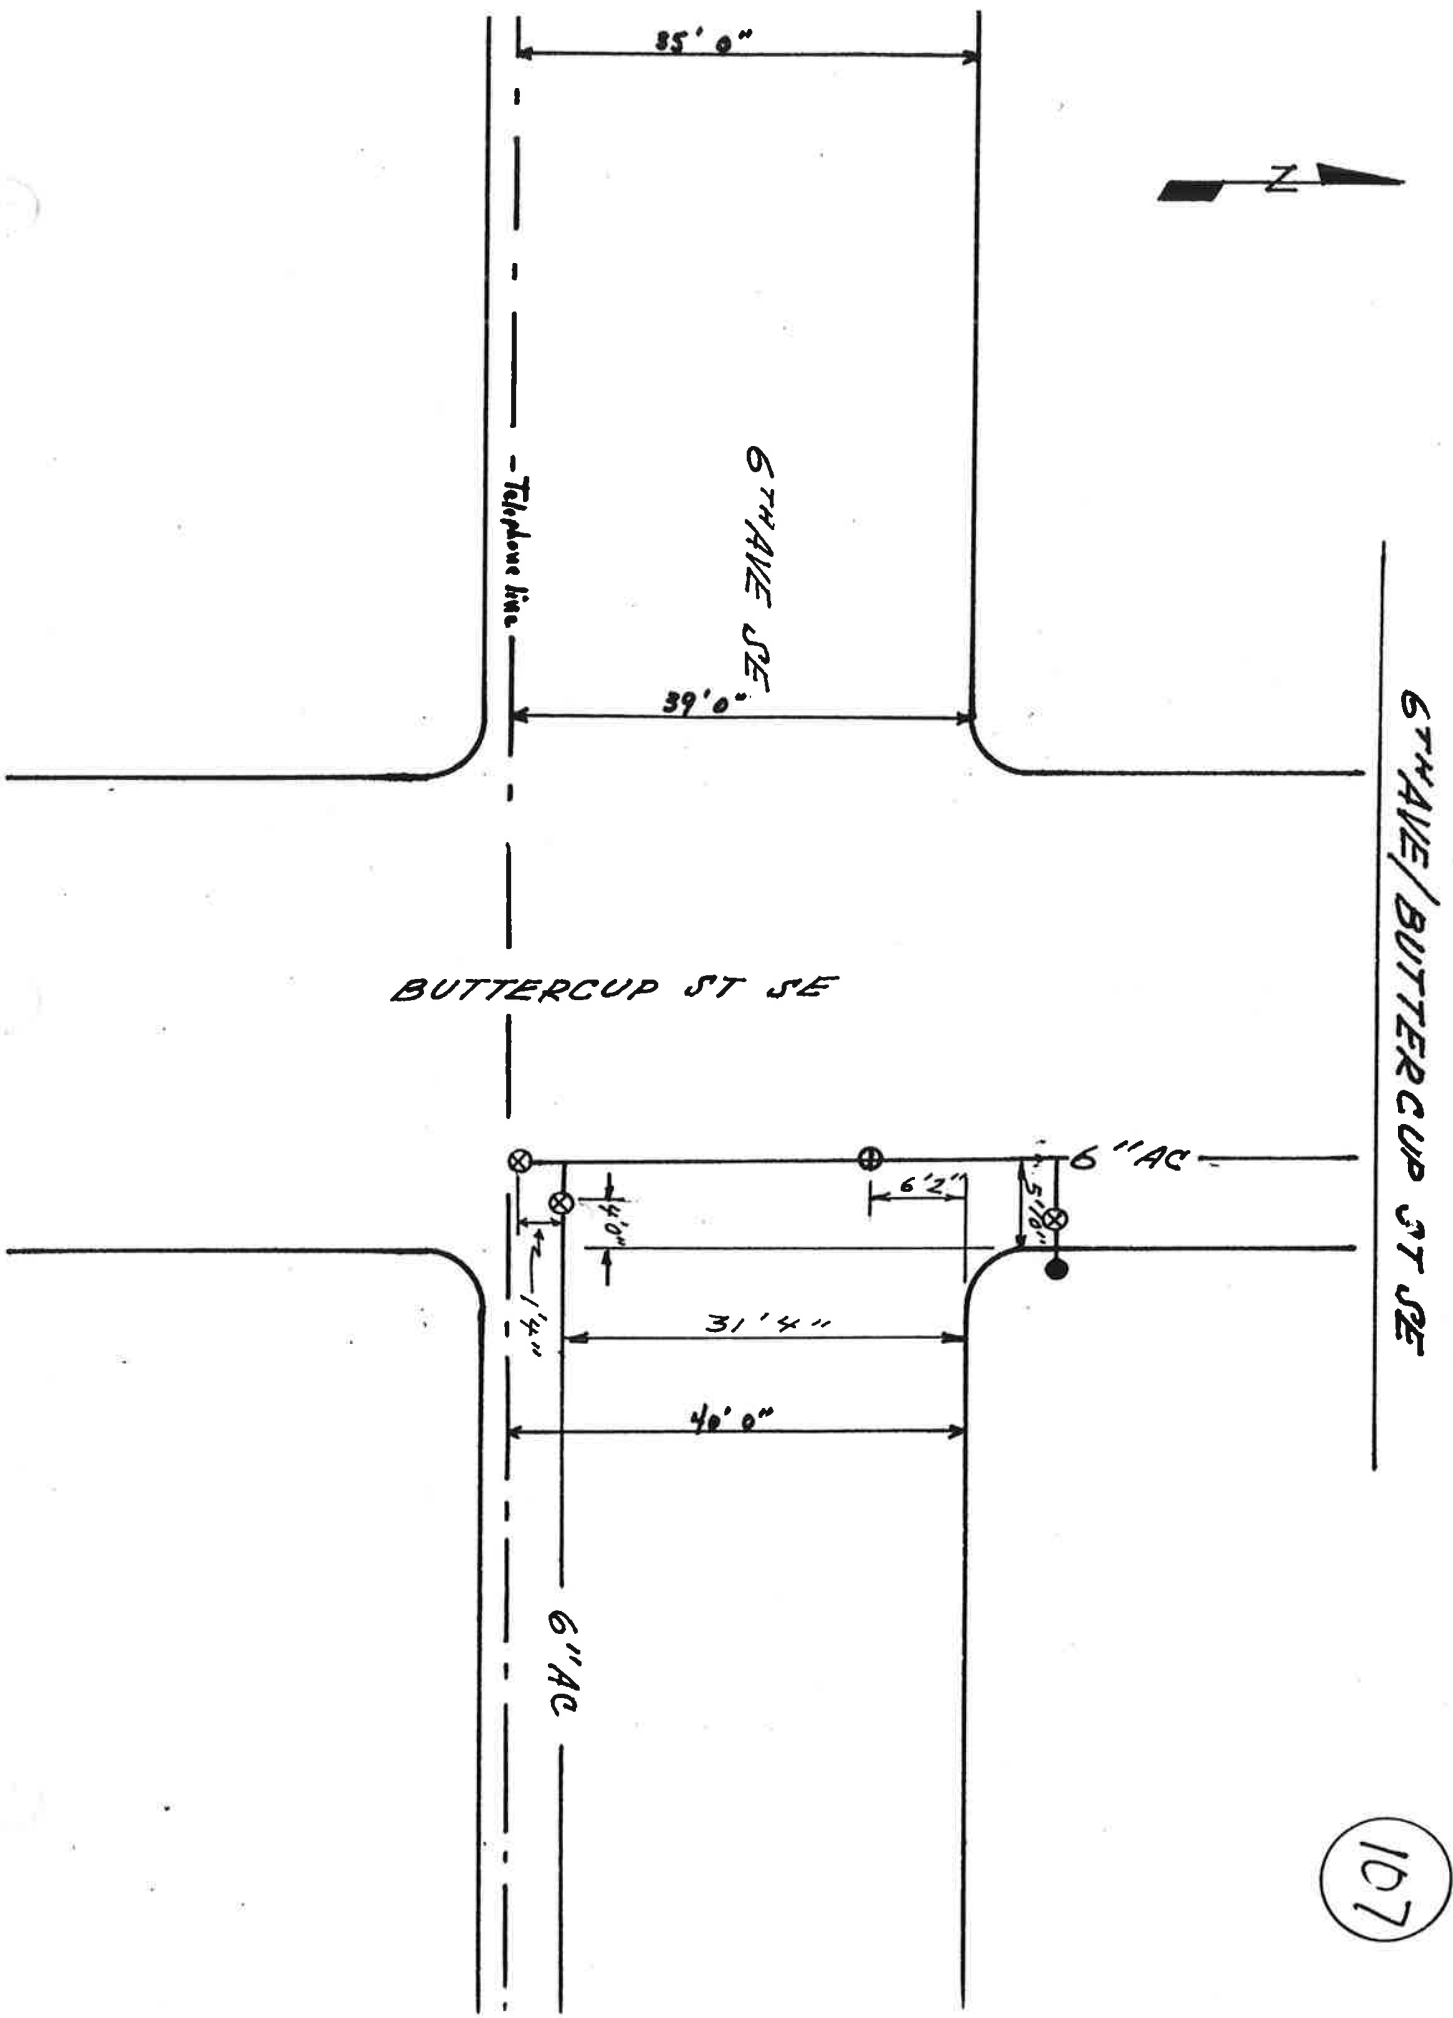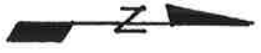

107

6th Ave / 2nd Place SE

108





35'0"


6th Ave. S.E.

Telephone Cable




2nd Place S.E.

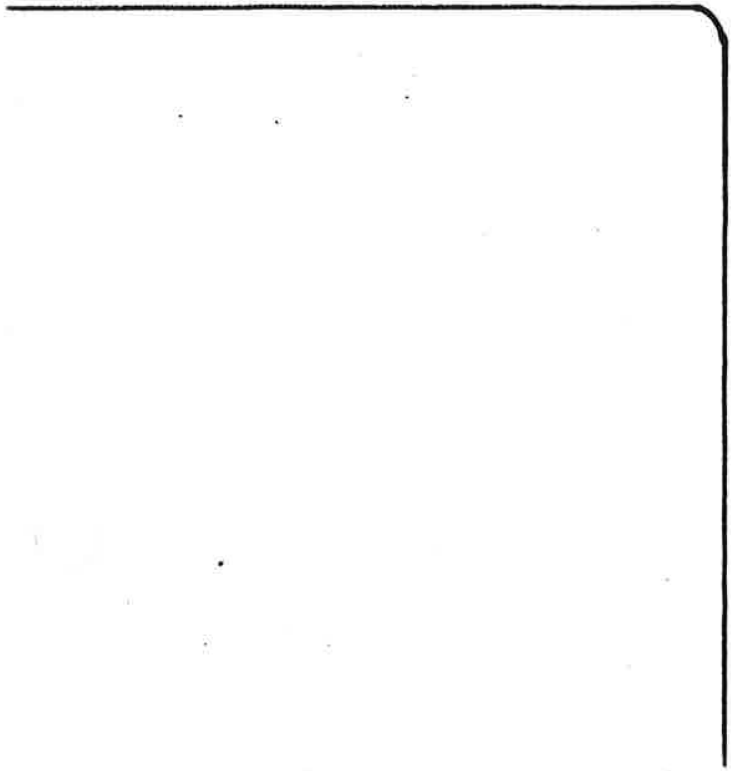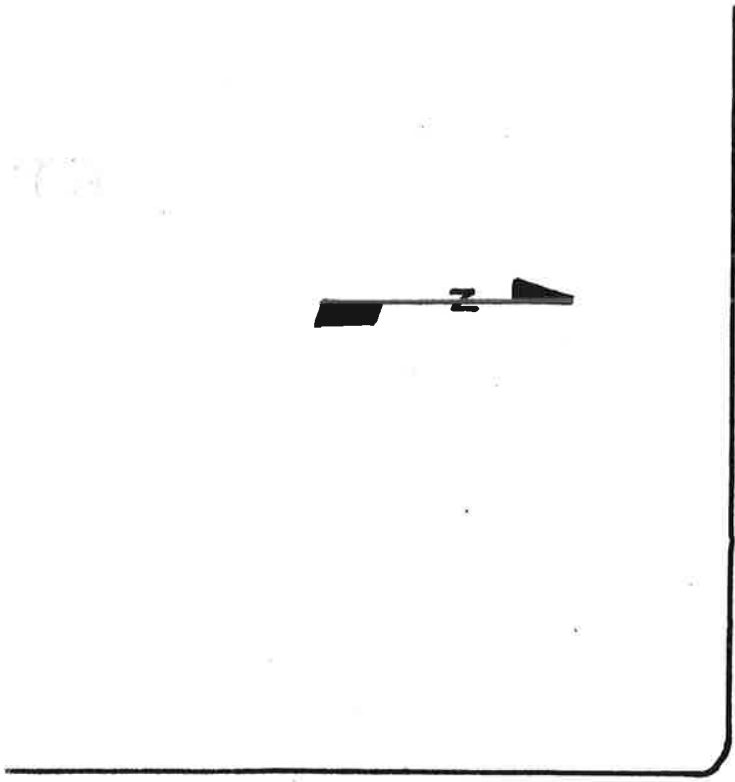


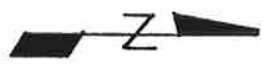

6TH AVE / CANNA ST SE

109

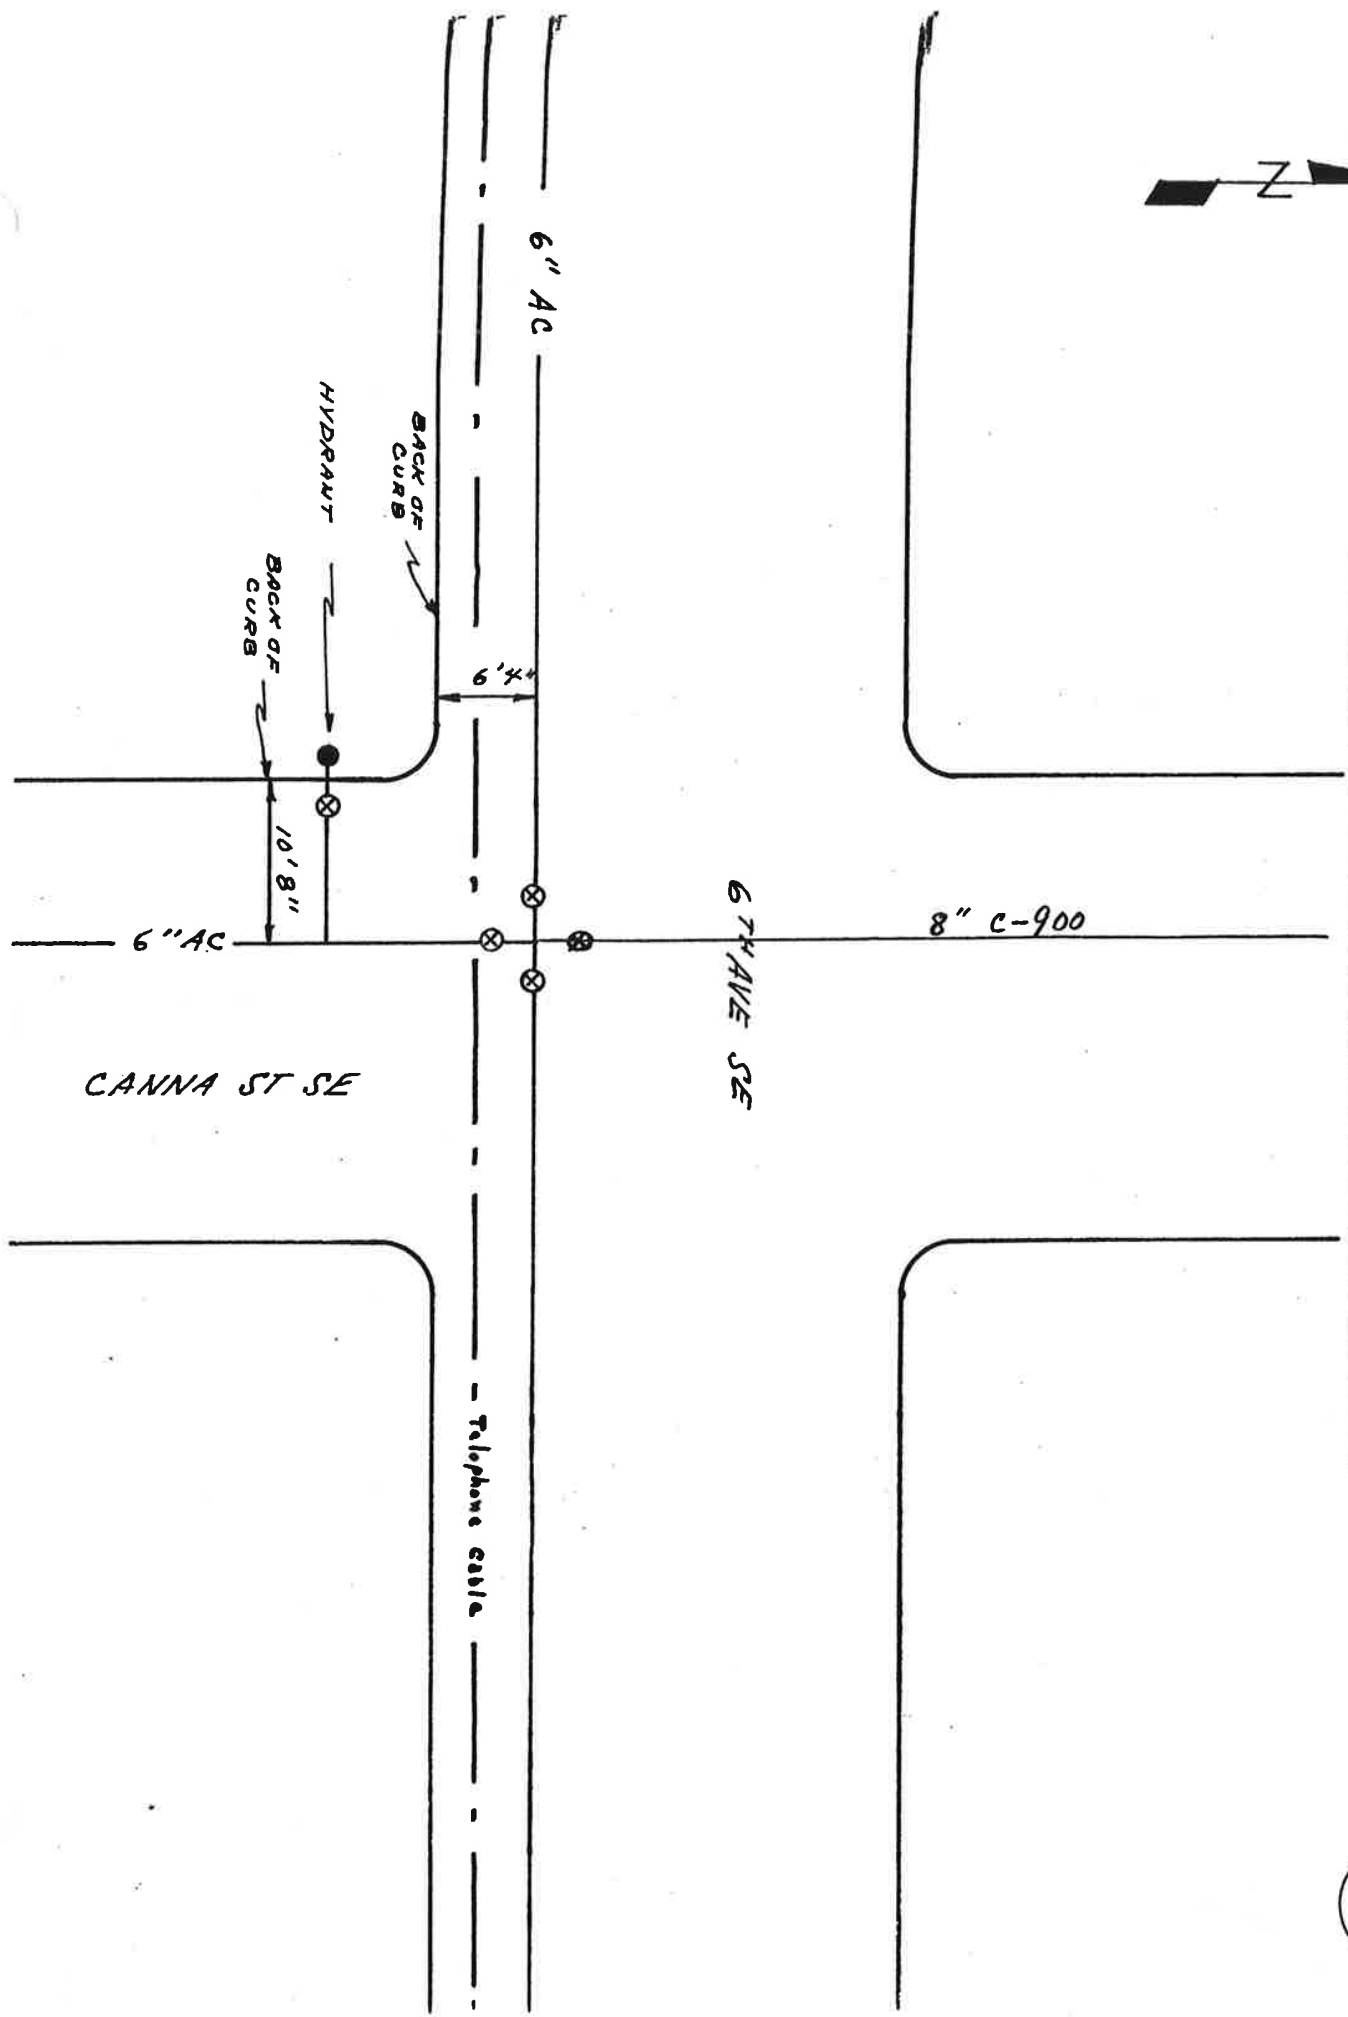

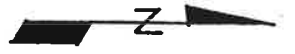


6TH AVE / DAISY ST SE

6TH AVE SE

DAISY ST SE

110

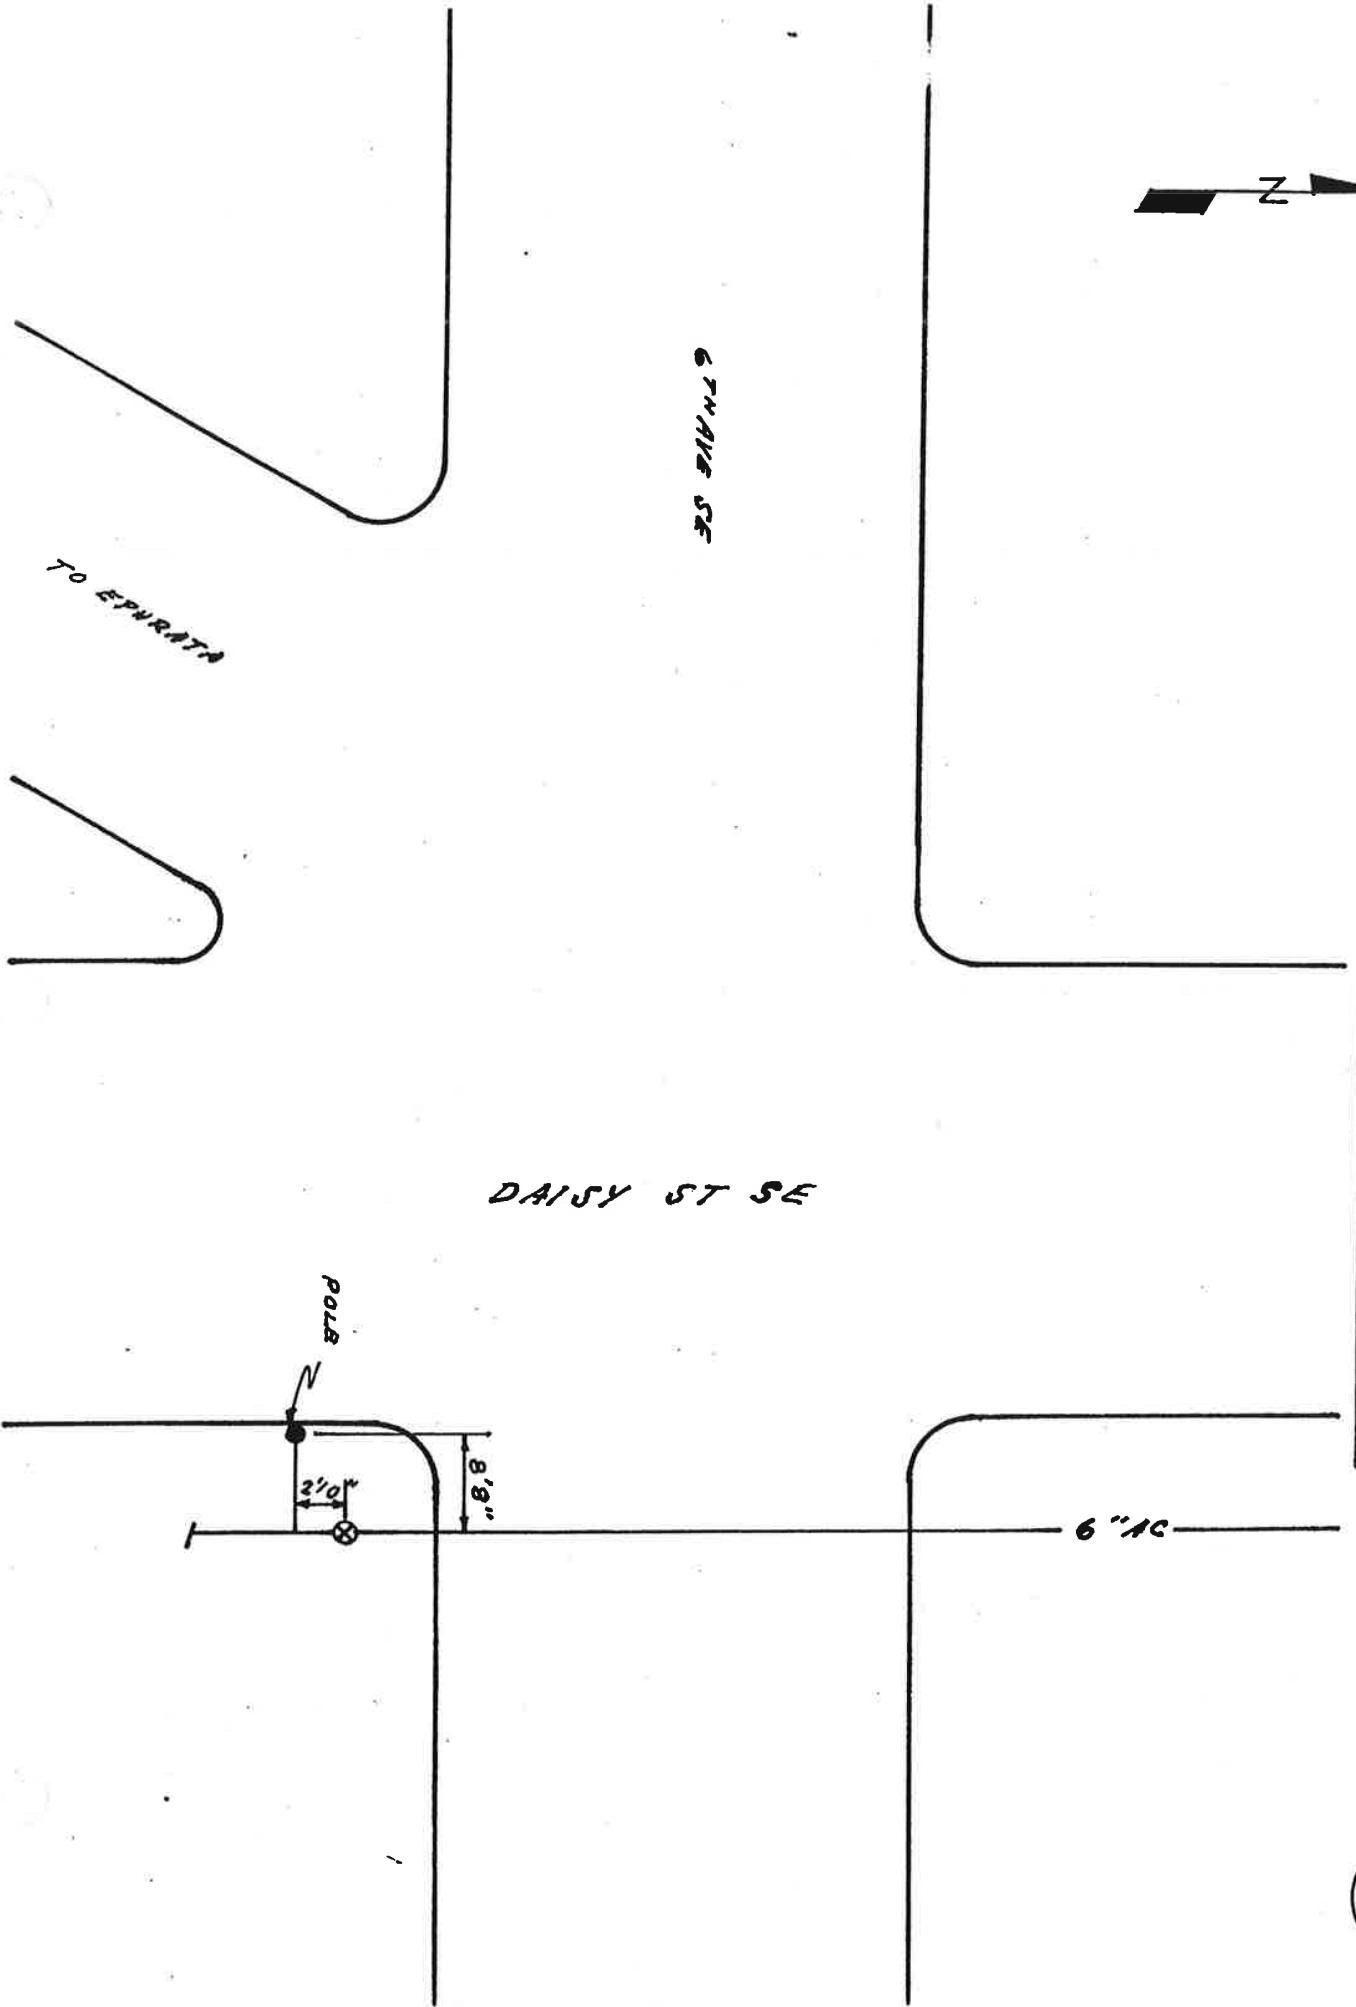

TO EPHRATA

POLE

2'0"

8'8"

6" AC



6TH AVE / ELDER ST SE

ELDER ST SE

6TH AVE SE

4" STEEL

4" STEEL

meter box


57'10"


center line -

26'8"

6th Ave

1111

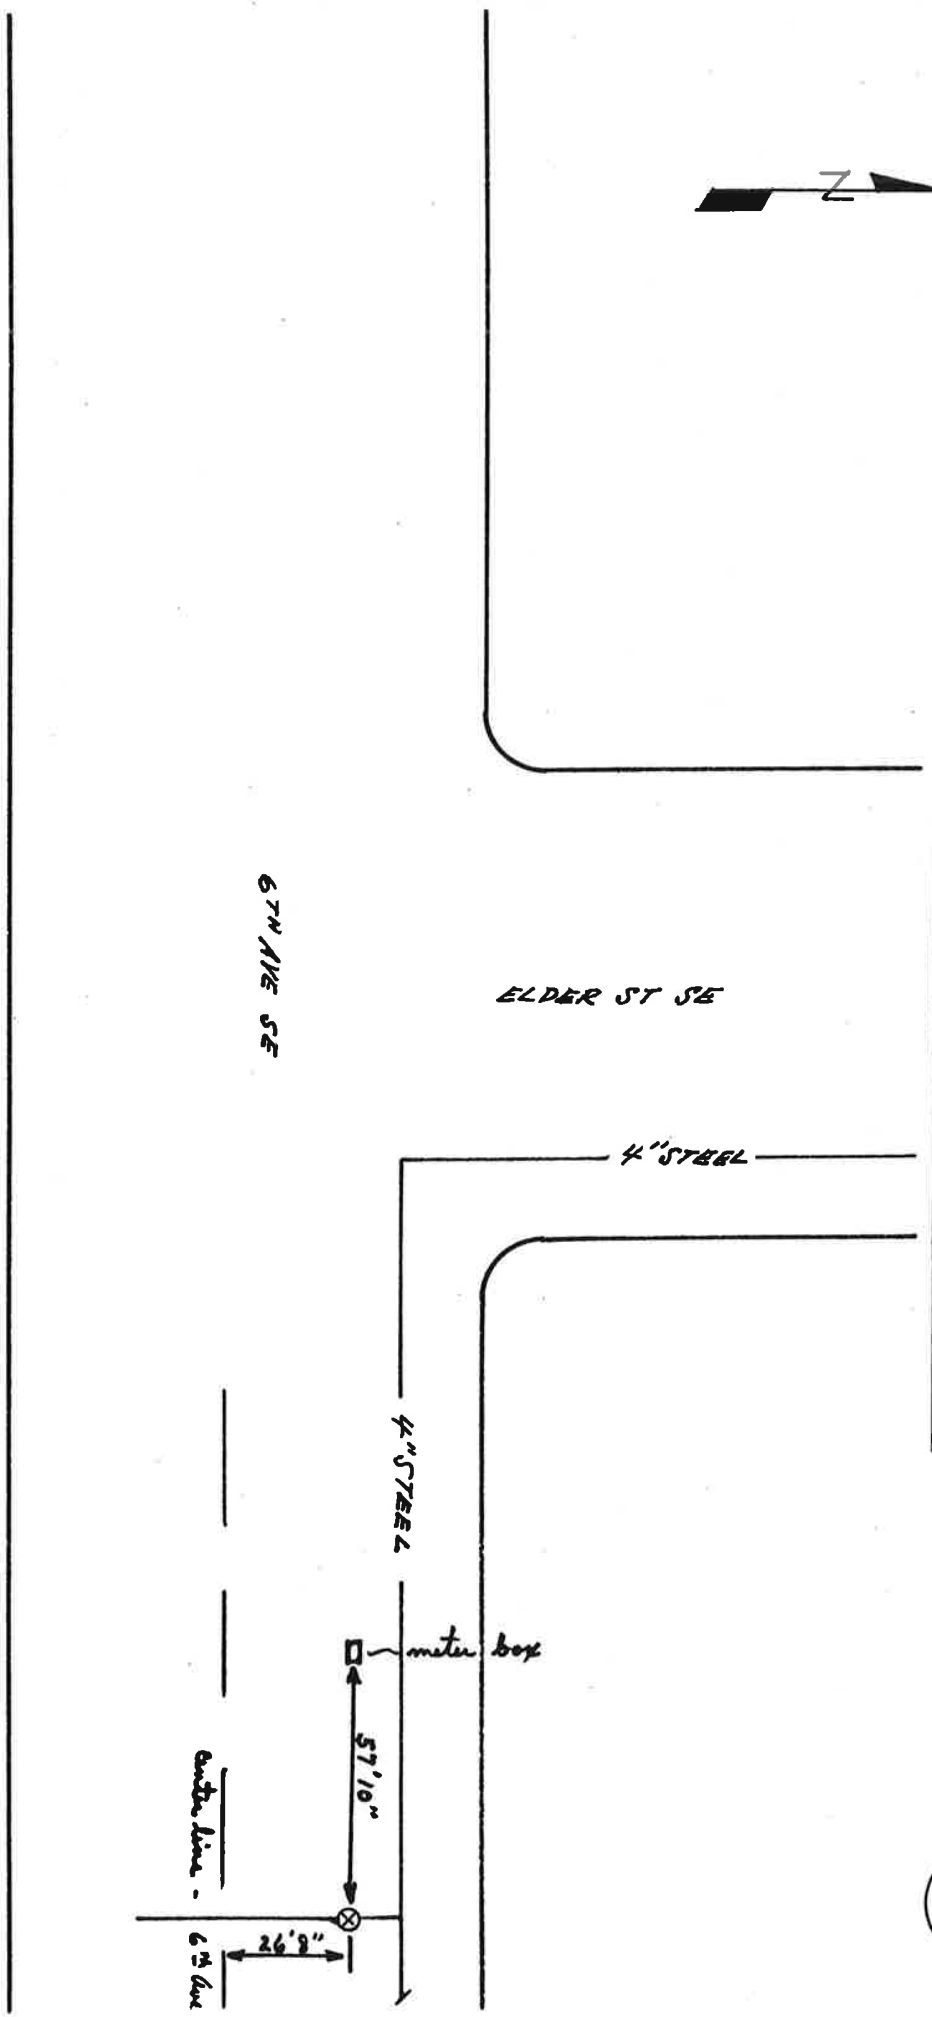

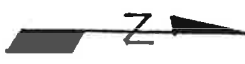

← S.W. →
7TH AVE SE / DIVISION ST →

112

7TH S.W.

CURB CUT

3" PLASTIC




7TH AVE SE

4" AC


7TH S.E.



DIVISION ST

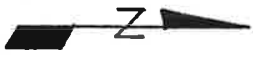


7TH AVE / ASTER ST SE

113

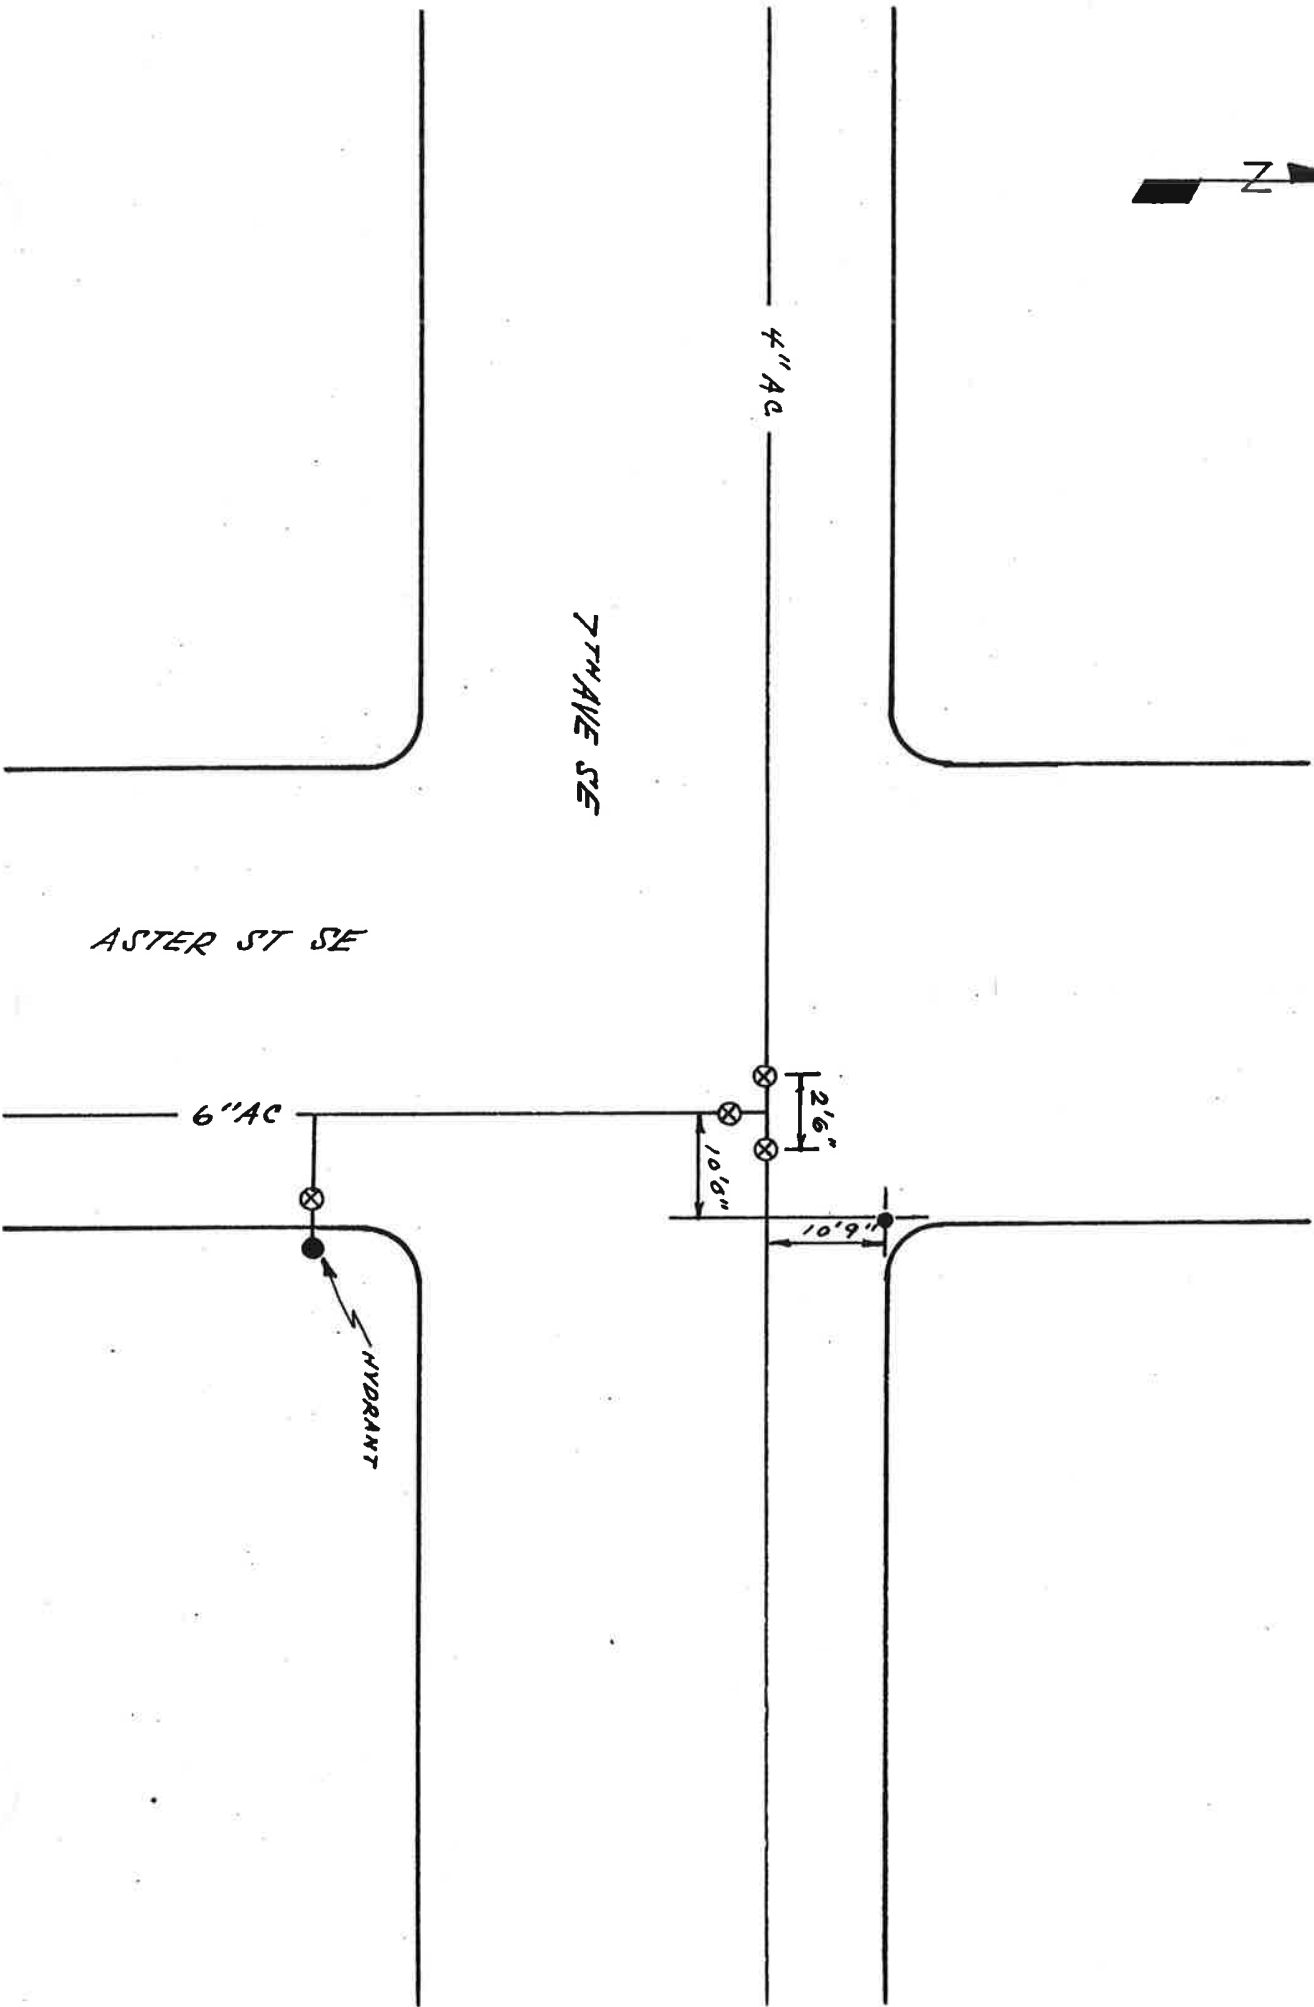

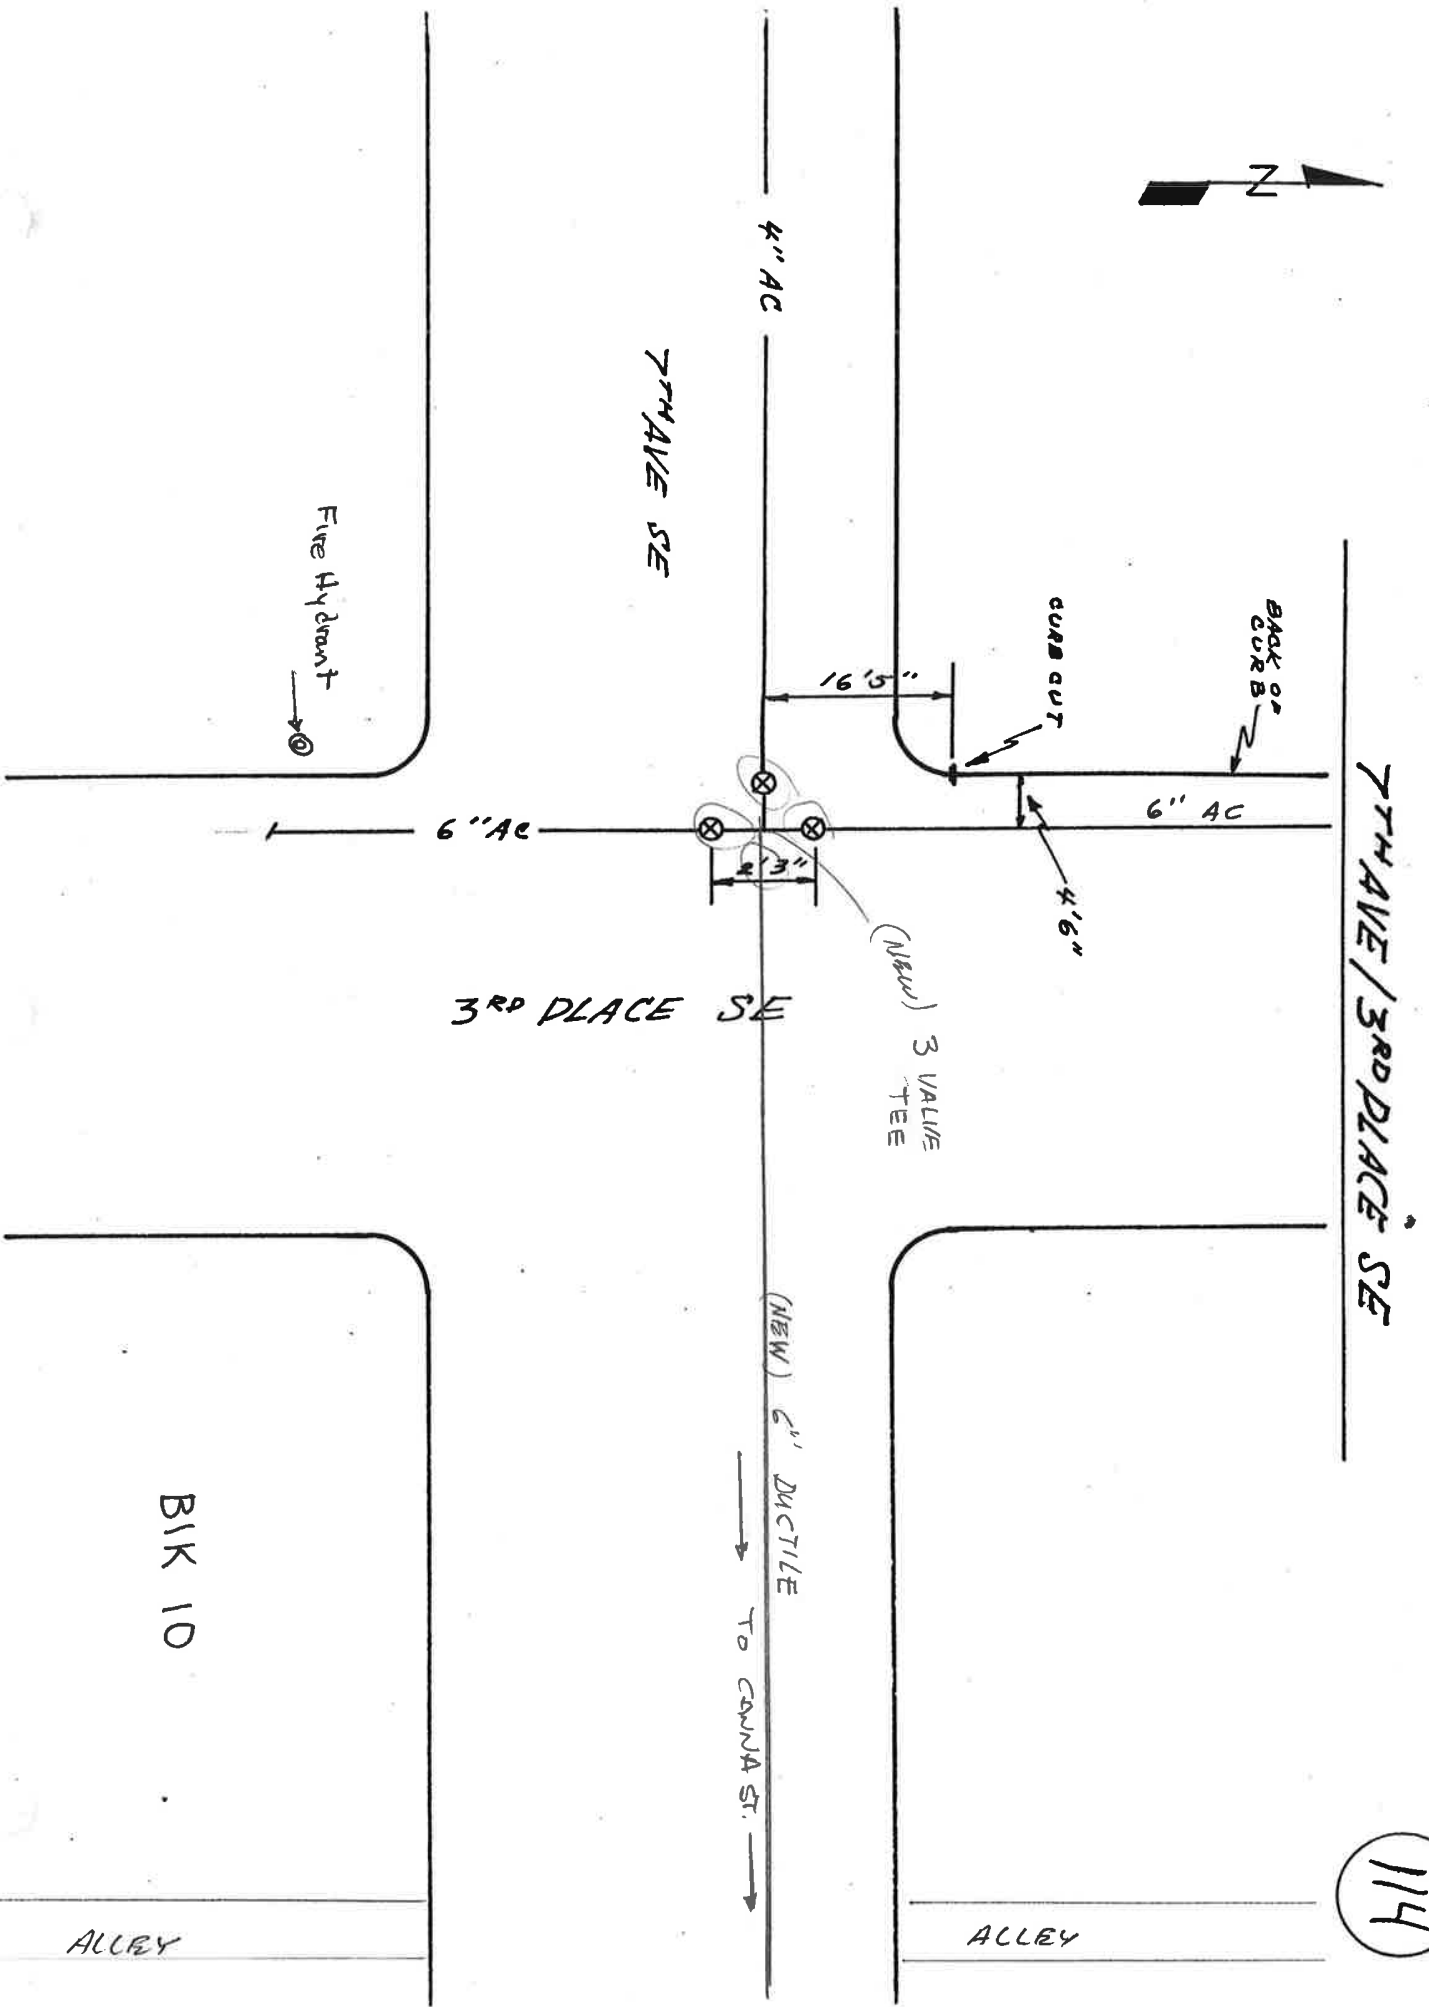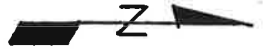

114

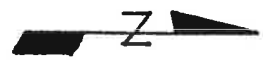




7TH AVE / BUTTERCUP ST SE


4TH AC

7TH AVE SE


BUTTERCUP ST SE

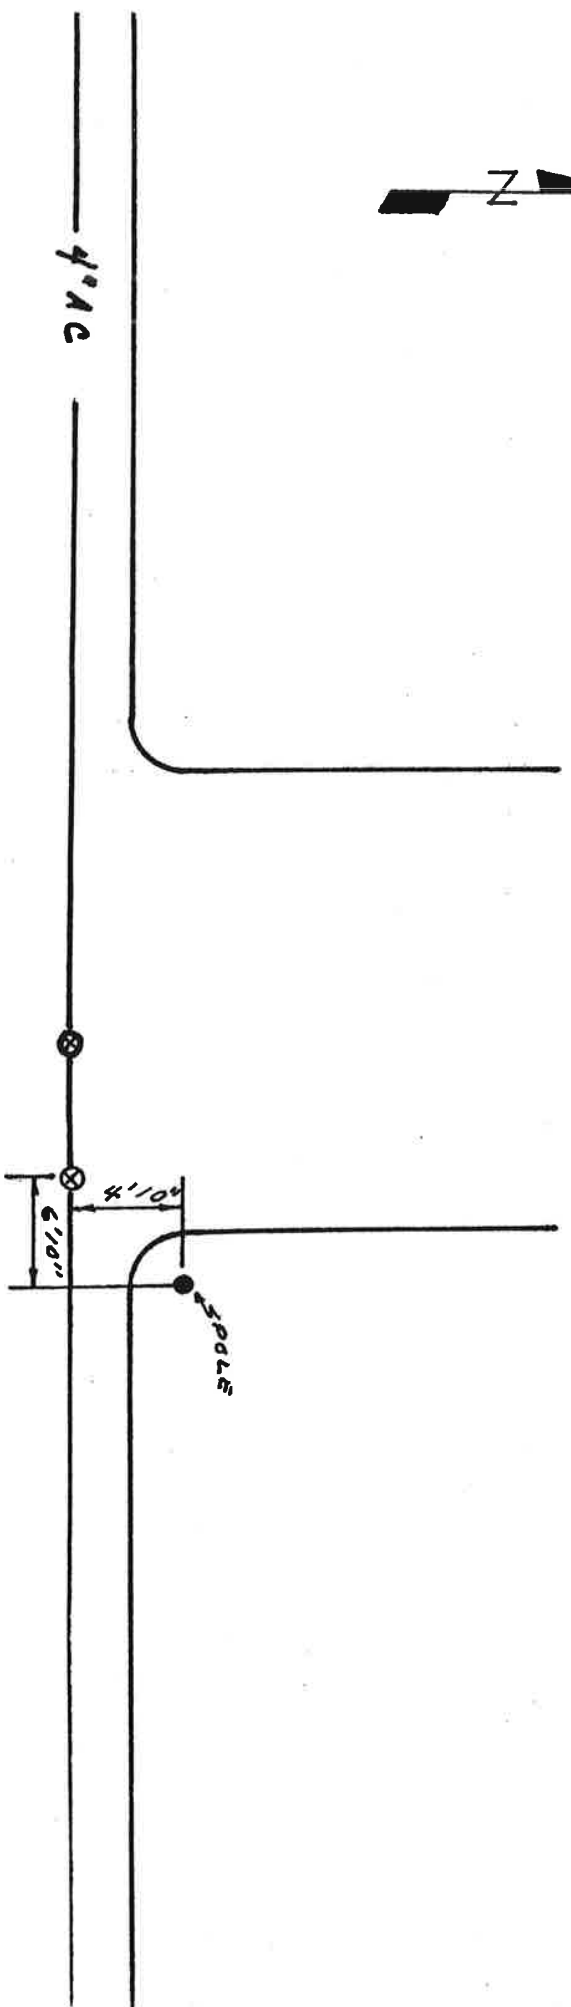

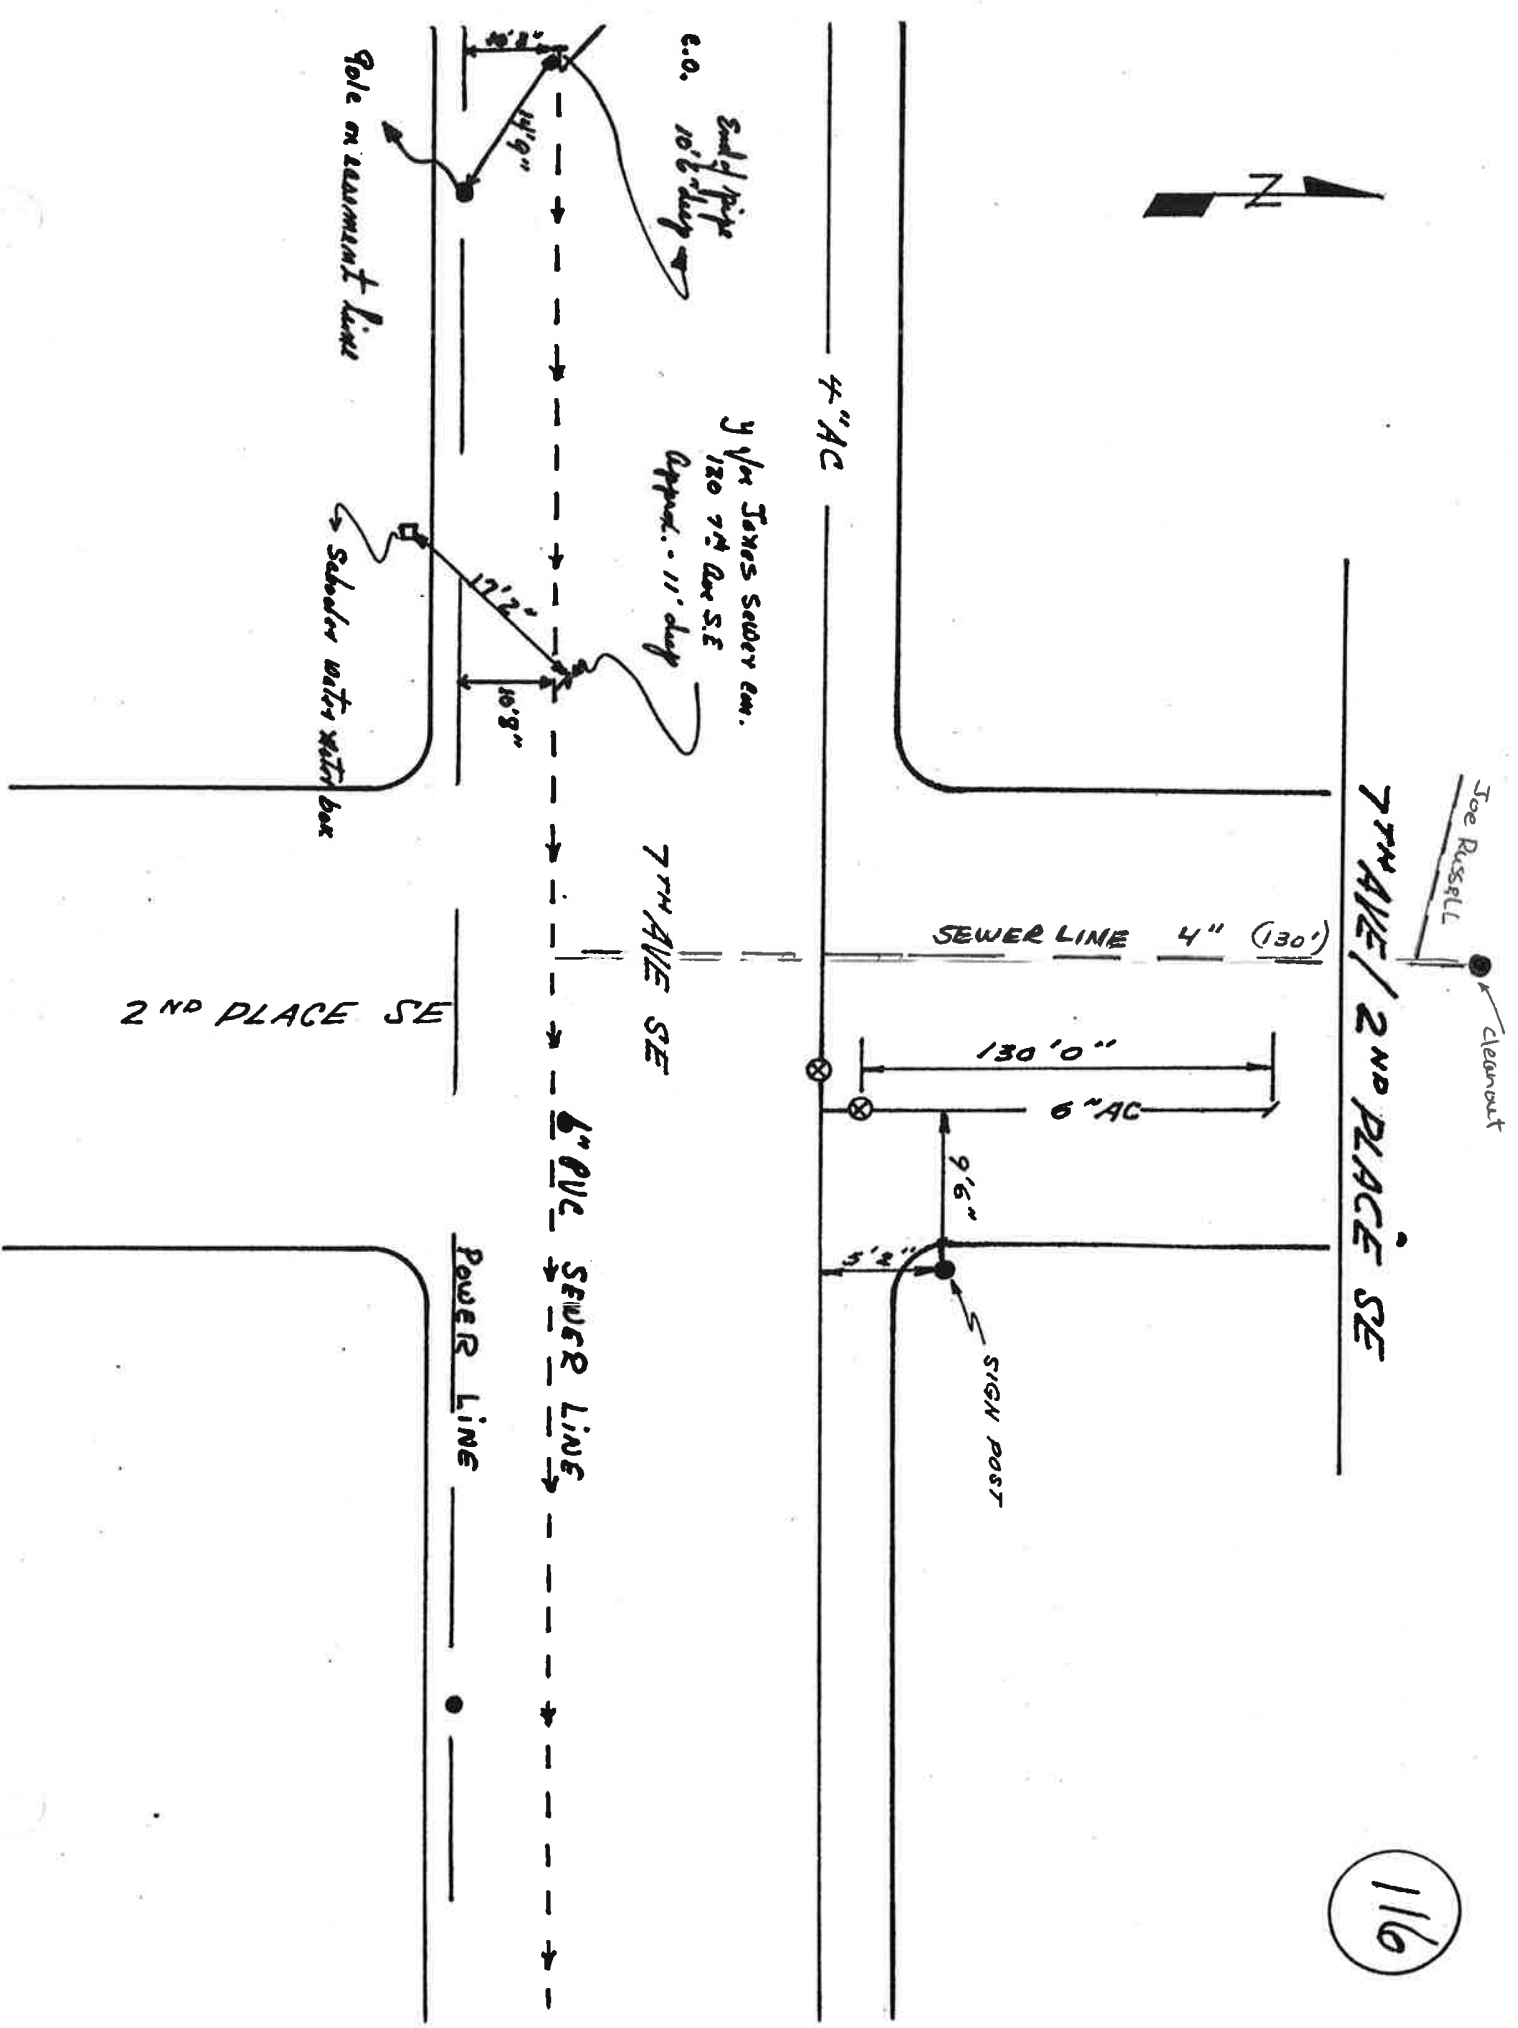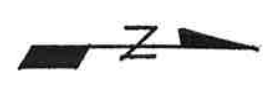

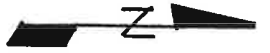

JOHN ASKER
NO. 14 8TH AVE SE
METER BOX

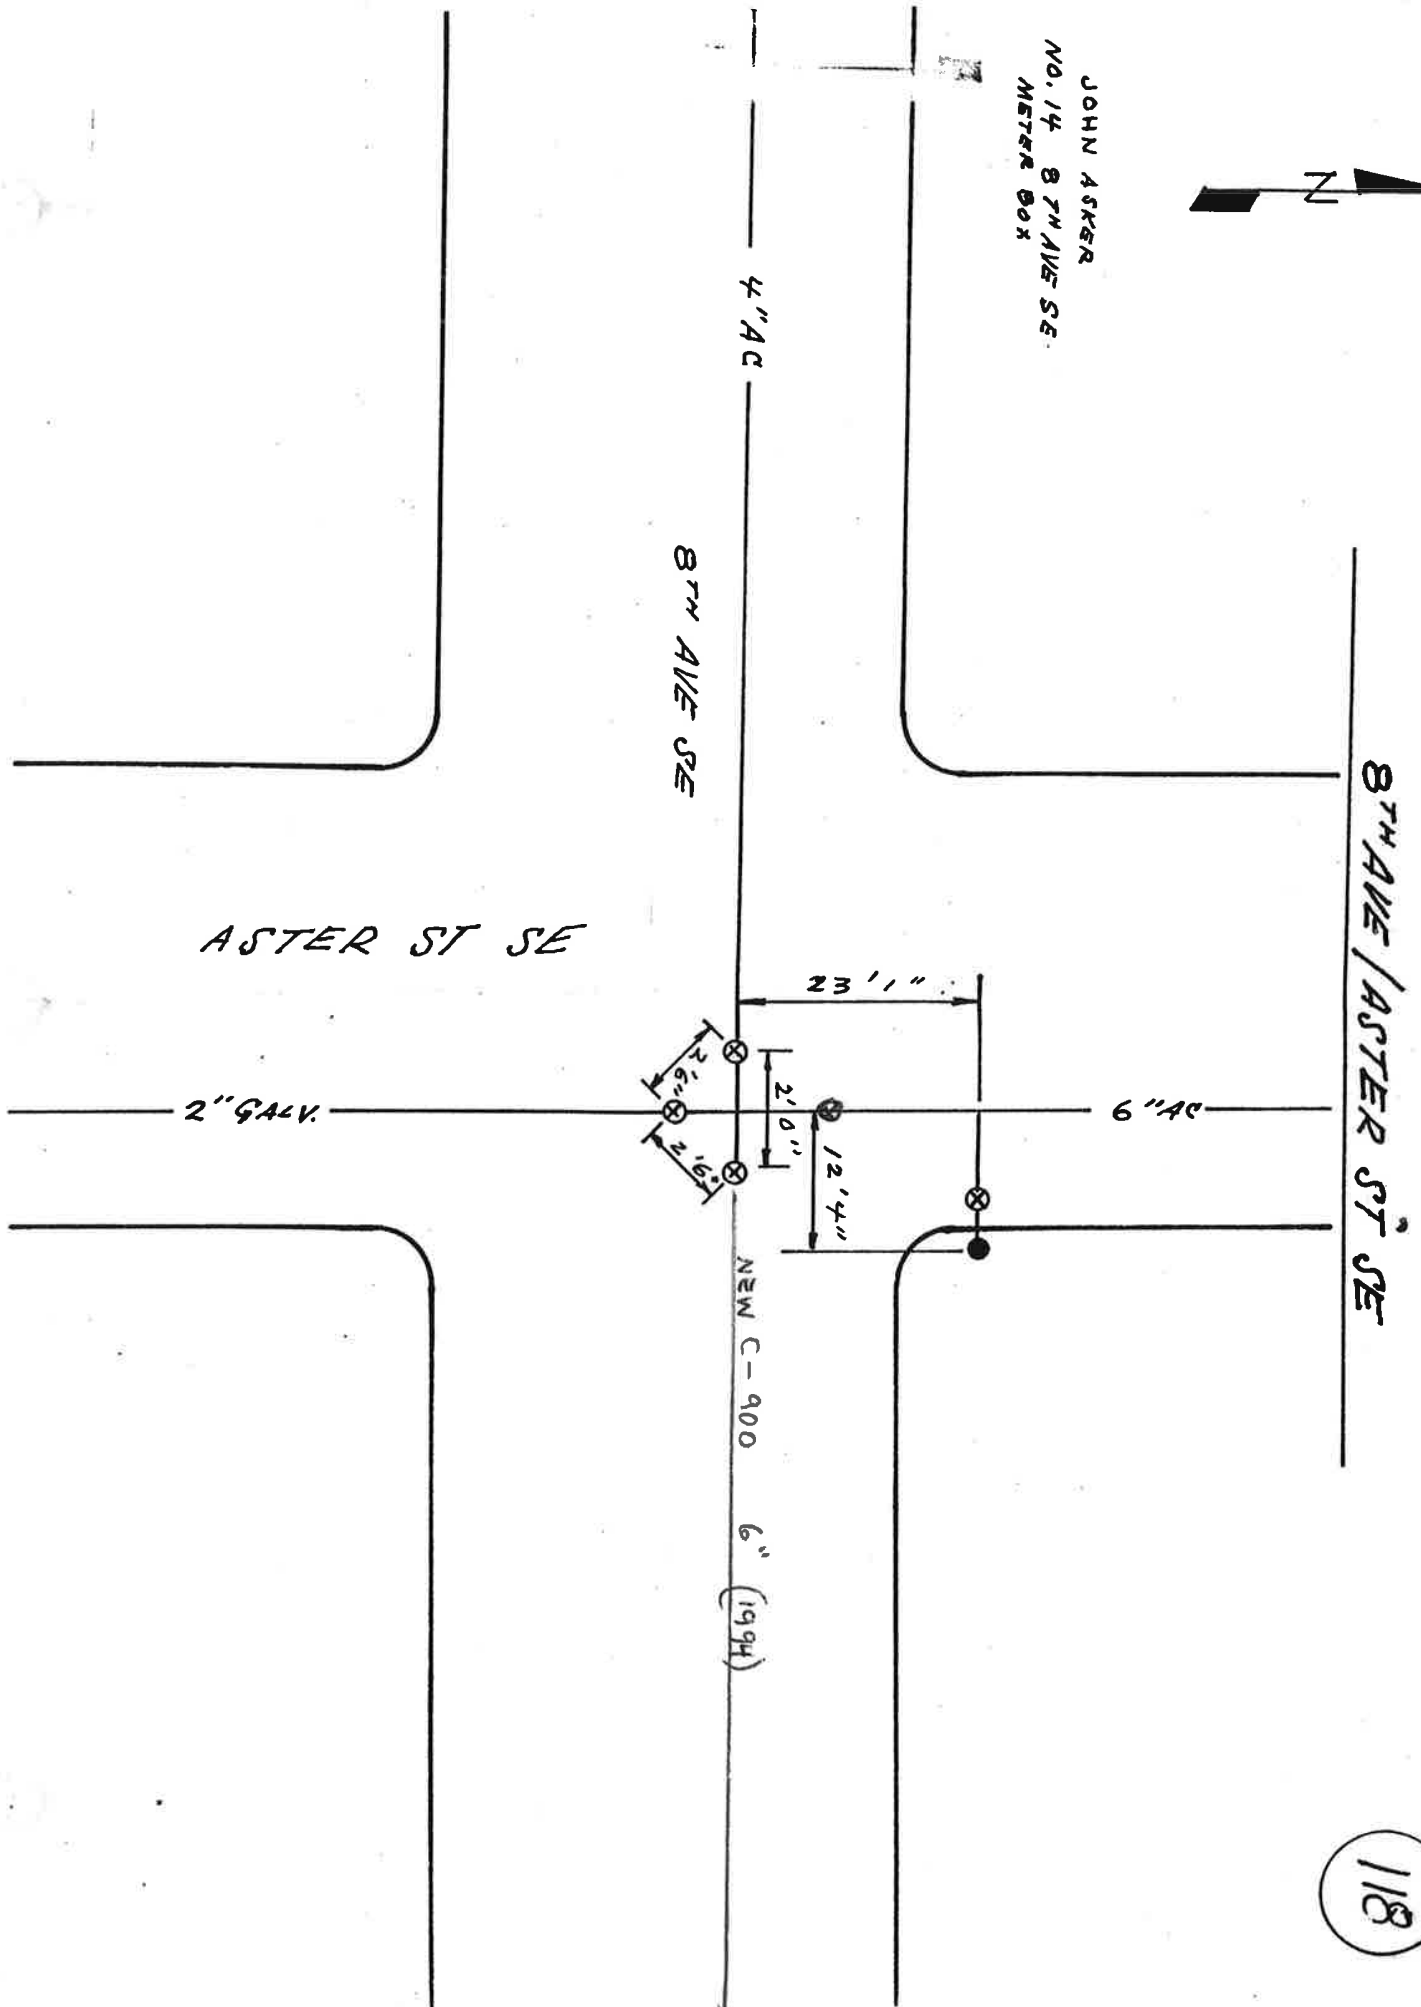



DIVISION ST / 1ST AVE NW, NE

POLE MONUMENT

26' 6"

MH

2' 10"

67' 4"

HOUSE

2" STEEL

1ST AVE NE

SEWER MAIN


DIVISION ST

1ST AVE NW


2" STEEL SL

2" STEEL

119

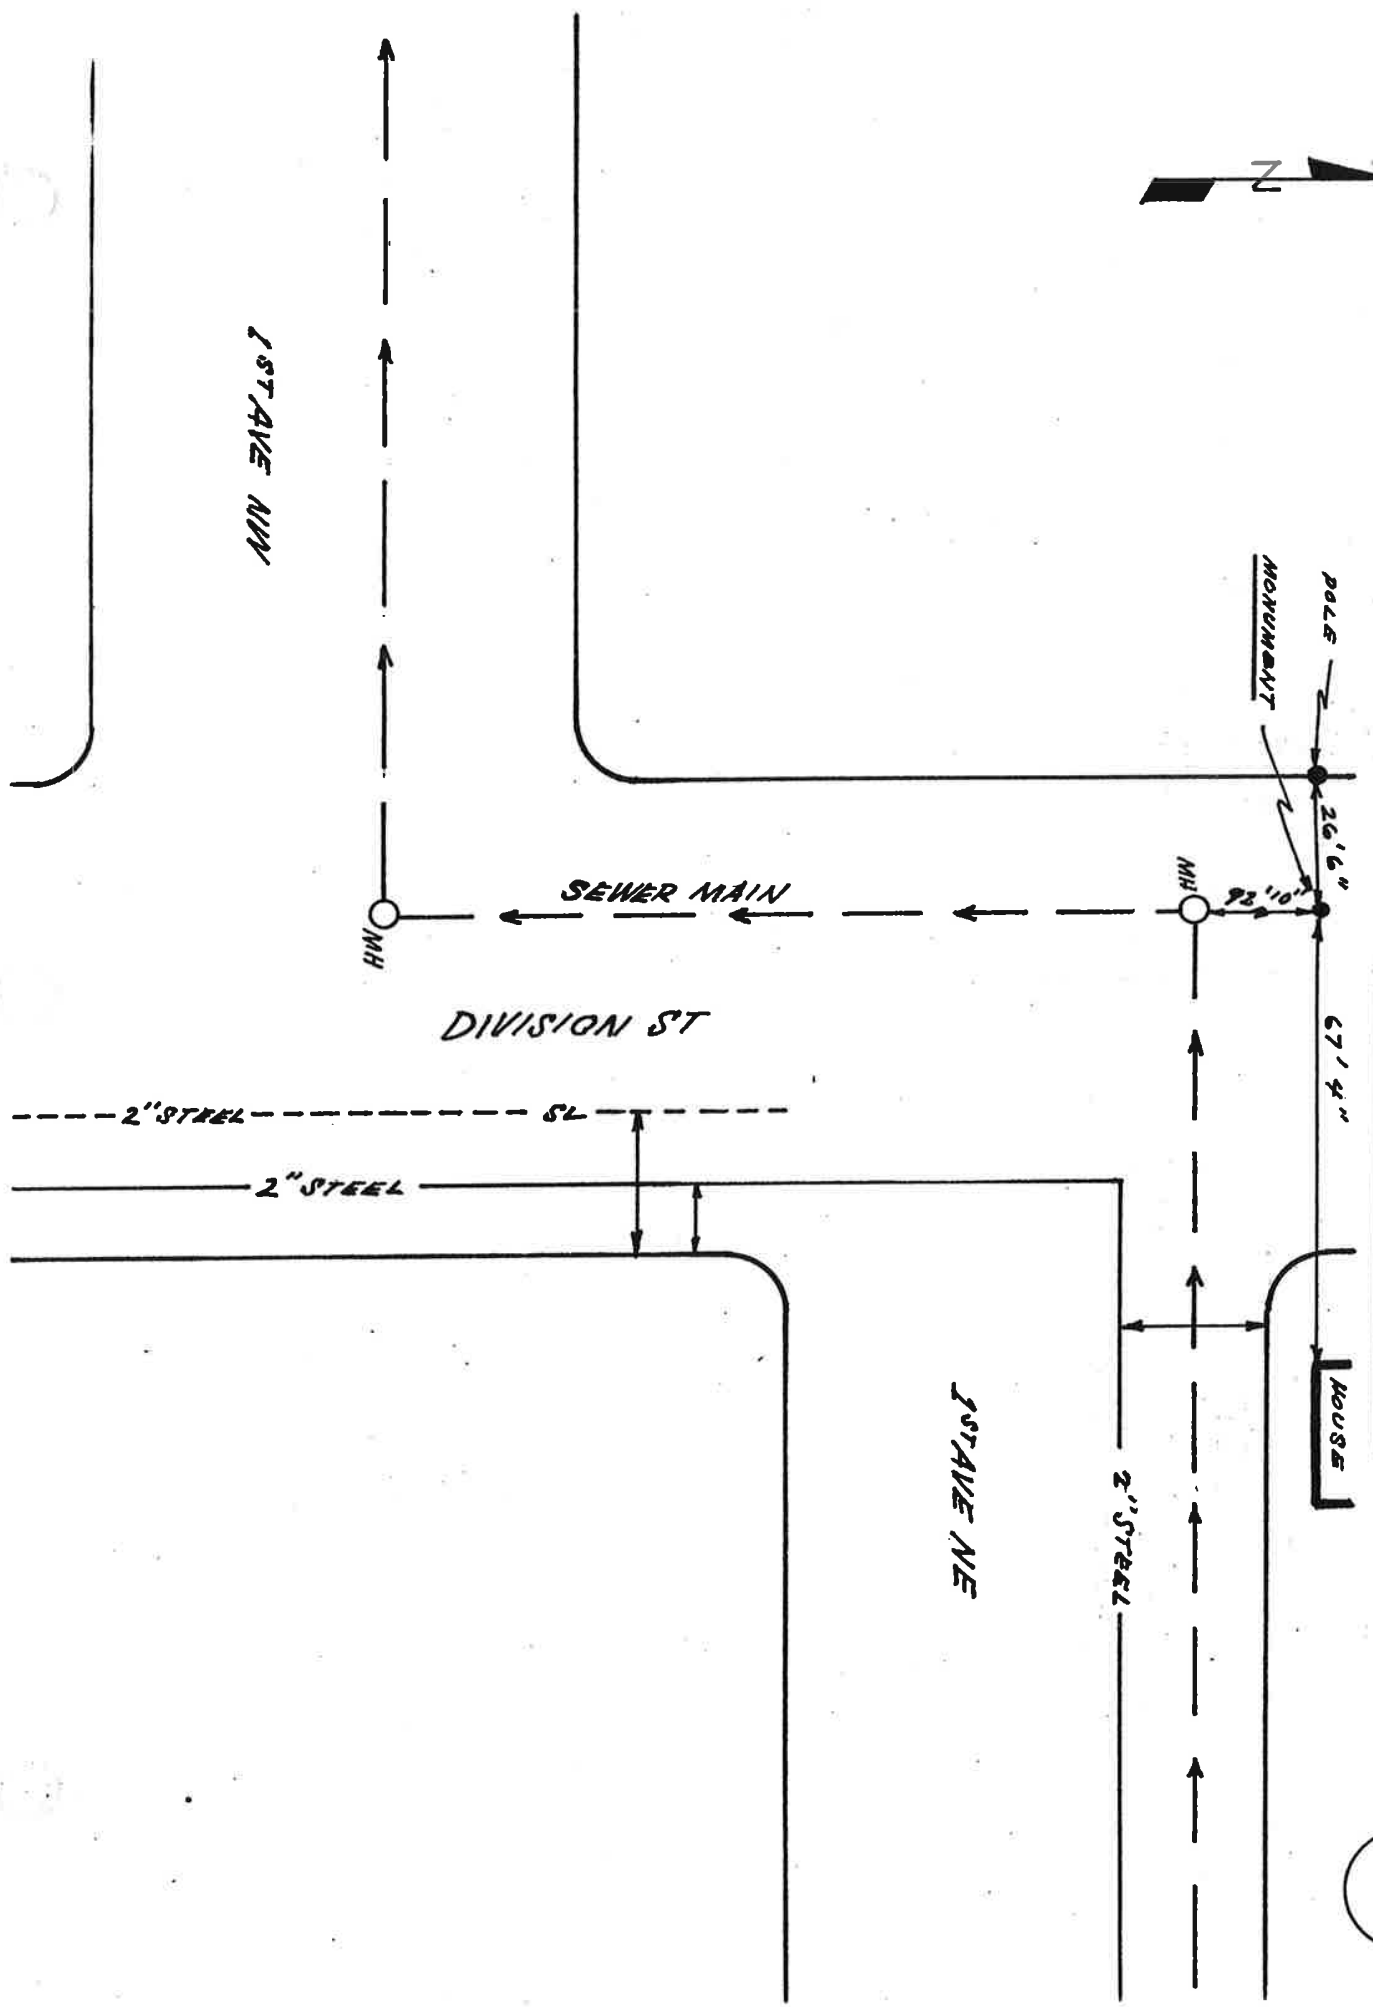


120

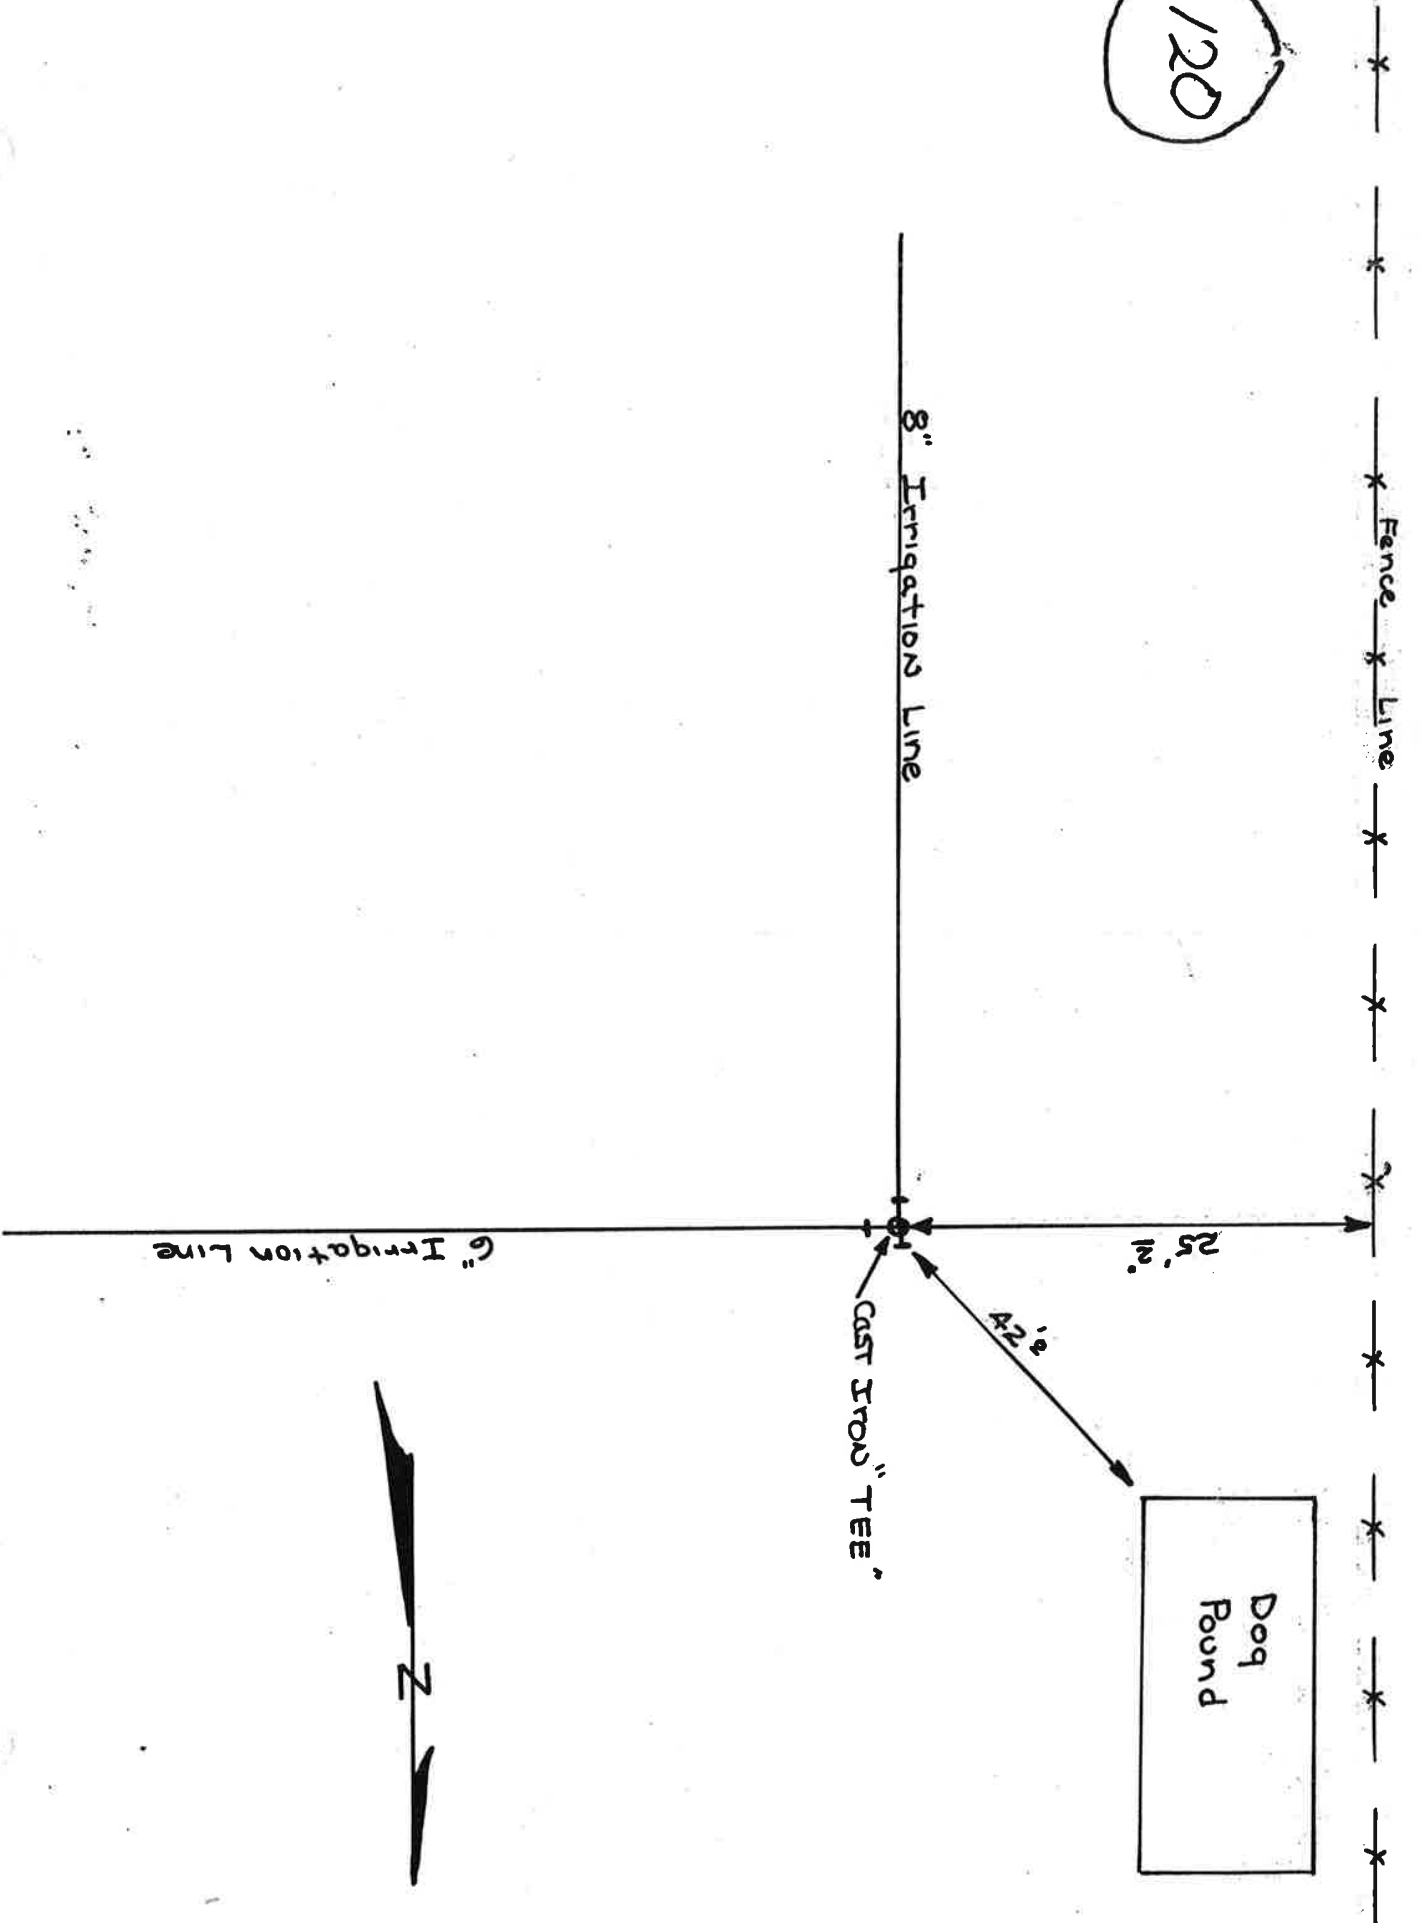

8TH & 2ND PLACE S.E.

HIRAM KNOT WATER EXTENSION

(121)

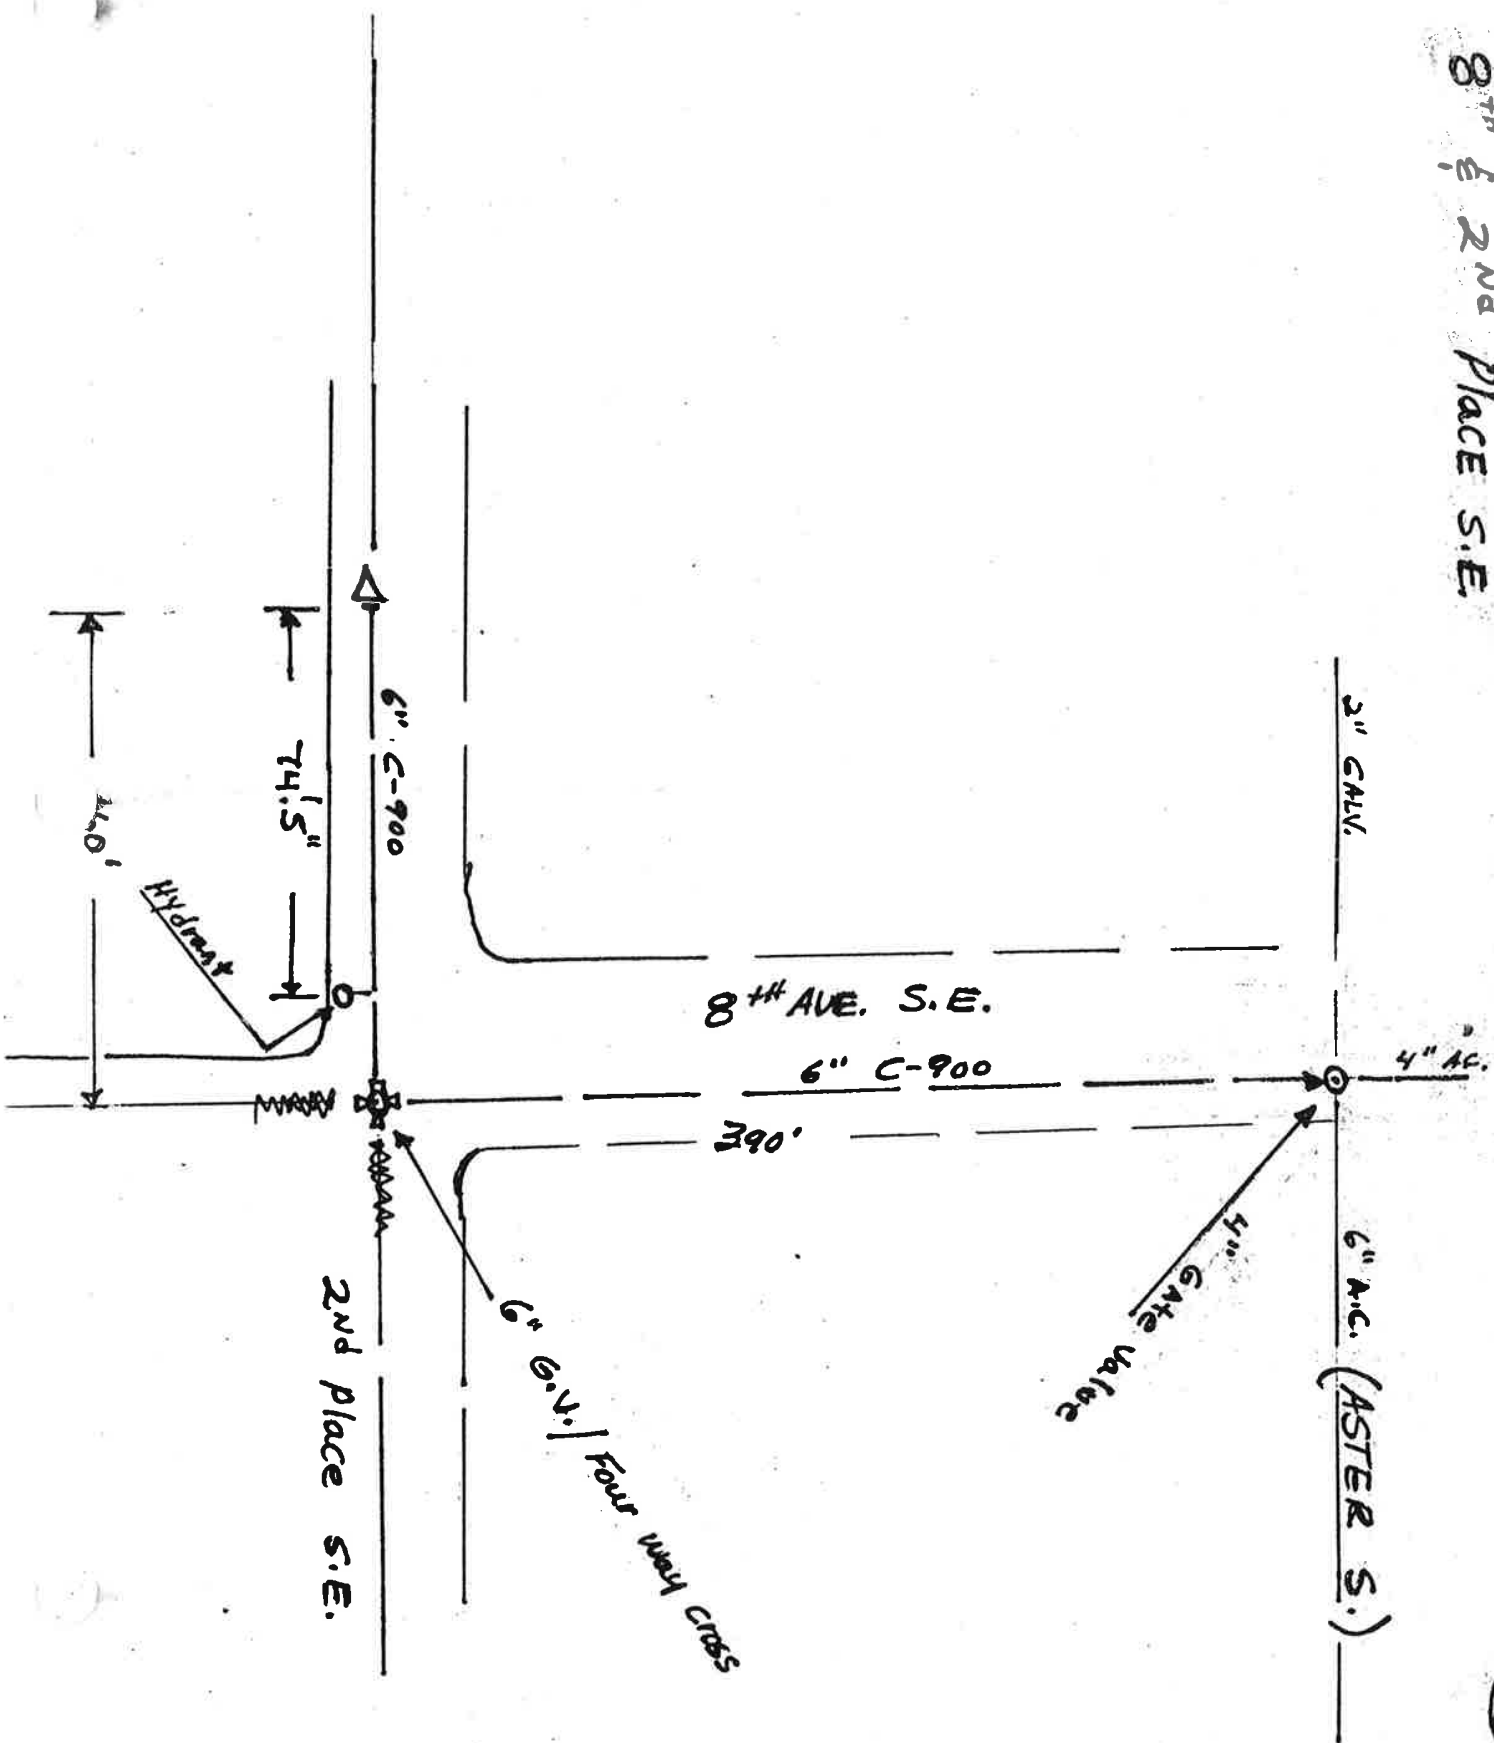

3" G.V.V.

8TH AVE. S.E.

6" A.C. (ASTER S.)

4" A.C.

4" GATE VALVE

390'

6" G.V.V. / Four way cross

2ND PLACE S.E.


6" C-900

74.5'

Hydrant

400'

400'

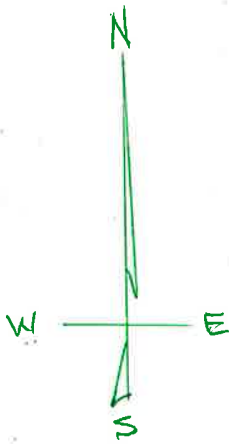

2ND AVE. S.W.

2" water meter

SIDEWALK

CLASS ROOM UNITS

CLASS ROOM UNIT

126.20'

TO LIFT STA II

FLOW

HIGH PRESSURE LINE

HIGH PRESSURE SEWER LINE
FROM LIFT STA. II TO THE
TREATMENT PLANT CROSSING
SCHOOL DIST. PROPERTY

7-27-95

TO TREATMENT PLANT

SEWER

HIGH PRESSURE LINE

57.60'


P.U.D. POWER PEDestal

SCHOOL TRACK

Soap Lake Mineral Water System Failure Report

By John Glassco & Steve Wellein for the City of Soap Lake

January 26, 2017

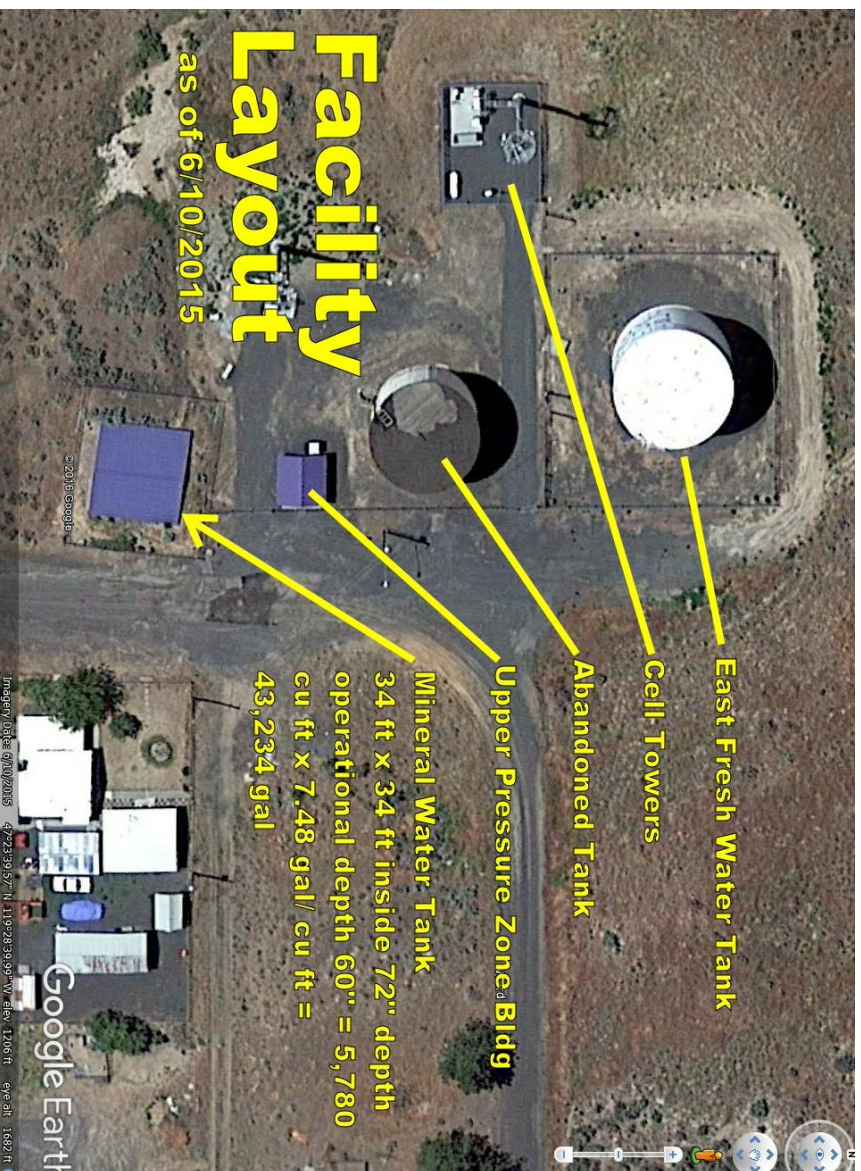

Contents

1. History and timing of the system failure:	3
2. Fix #1 and Fix #2, January 7 – January 10:	4
3. What was Learned from this Experience?:	7
4. Our Plan for Moving Forward:	8
5. Addendum, Costs of the immediate fix, and Estimate from Wire 2 Water for necessary repairs to the pumping and suction systems:	9

Cover: This image is an aerial photo taken on June 10, 2015 showing the City's facilities on the east side of town on Scenic Drive at Ward Street. This image shows the mineral water tank. North in this image is at the top.

1. History and timing of the system failure:

On December 29, 2016 at 3:50 PM, Glassco was called by Sherry Xio and alerted to the loss of mineral water service at several of her buildings. Other mineral water customers had noticed the break in service. Due to the extreme cold weather, some customers believed that their pipes had frozen.

Glassco called the Mayor and was told that the mineral water tank was found to be unexpectedly empty. Further, the mineral water pump house located near the old flag pole behind the library had been without adequate heat. As a result of the cold weather, the pump and various lines had frozen, and restoring service to the mineral water customers would be a challenge.

Public works was struggling with emergency snow removal during the severe cold snap and intermittent heavy snows and other equipment breakdown including the road sander. Glassco and Wellein who both have some experience with pumping systems, agreed to monitor the situation on behalf of the City to oversee the restoration of the mineral water service.

Public works had been unable to locate a 220 volt heater for the pump house claiming a shortage in the area. A local citizen donated a heater which public works installed for temporary use to attempt to thaw out the pump and pipes.

On January 5, 2017, Glassco called Kirk Youngers, a commercial pump and control expert who was recently hired by the City to restore and repair the Upper Pressure Zone which supplies fresh water to the homes in the northeast corner of town. By chance, Youngers was performing a final inspection of his successful repair to the Upper Pressure Zone (see cover air photo,) a pumping system which had never operated properly almost since its original construction over 12 years ago.




**in-ground mineral
water tank under
blue metal roof**

Youngers when finished with his inspection was solicited by Glassco and Wellein to inspect the mineral water pumping system and to consult specifically on the condition of the 5 horsepower pump which suctions lake water out of the lake at the flag pole and delivers it through a two inch diameter line to the approximately 50,000 gallon concrete mineral water tank on Scenic Drive, a pipeline distance of approximately a mile from the pump with a lift of over 150 feet.

During Youngers' inspection of the Upper Pressure Zone, Glassco observed public works nearby, introducing fresh water into the mineral water tank from the nearby hydrant. This practice was intended to "stir up" the mineral deposits in the bottom of the tank.

The pumping and transport system had frozen up in the past, and fresh water had been introduced into the tank with the goal of delivering a facsimile of mineral water to the downstream distribution system. In reality, the product of this practice delivers essentially fresh water to the bathtubs on the system. The introduction of fresh water into the distribution system has resulted in customers of the mineral water questioning the strength of the system. The fresh water can linger in the distribution system long after it is introduced. This can dilute the strength of the water at the individual tap long after the operation of the system is restored.

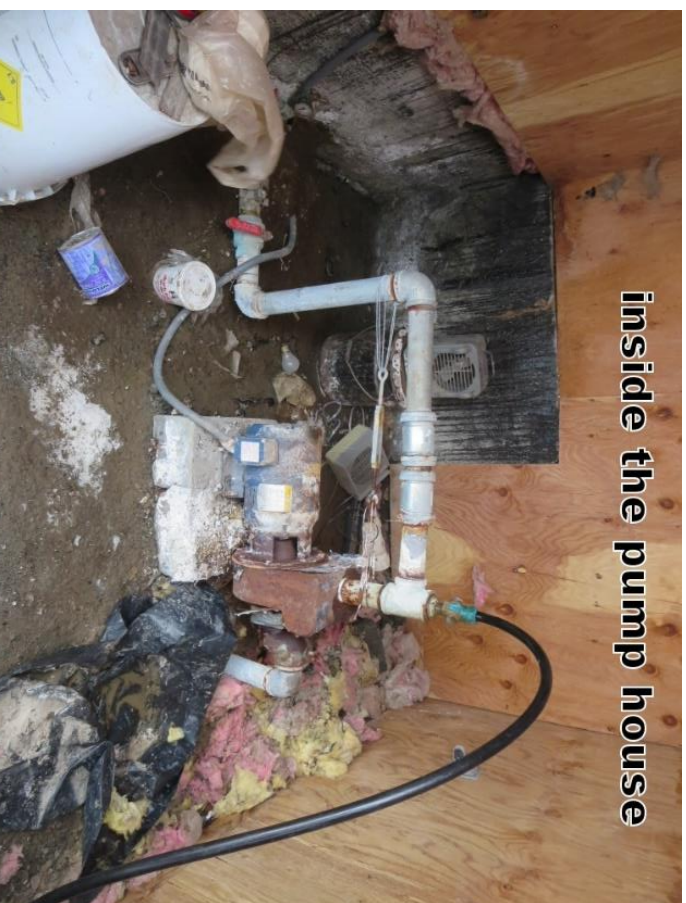


inside the pump house

2. Fix #1 and Fix #2, January 7 – January 10:

With the help and advice of pump expert Youngers, Wellein and Glassco decided that there was a chance that the system could be repaired. If the mile-long line between the pump house and the tank was not frozen anywhere along its length, and the pump body was undamaged, it might be possible to replace the frozen suction line, fill the tank with mineral water and restore the system to operation. This was our chosen course of action.

On January 6th, the suction line was rebuilt out onto the surface of the lake with an inlet stubbed through a hole cut in the ice. The pump and pump house had thawed by this time and the lake was sucking air when removed from the lake water.

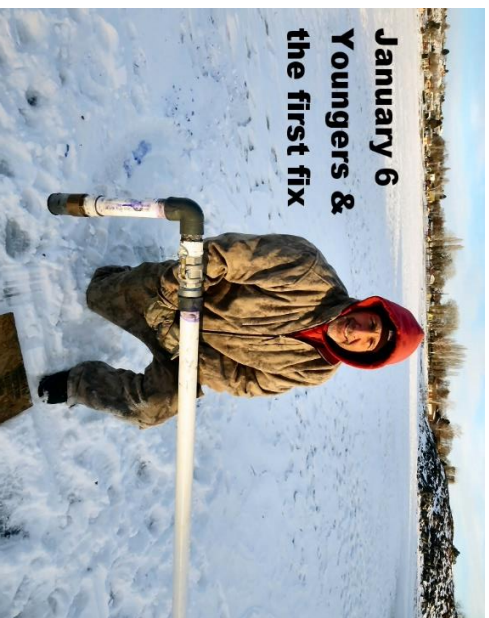

**January 6
Youngers &
the first fix**



**January 7
total freeze**



placing the booster pump on the ice - Jan 8

That night the pump ran continuously, and the temperature dropped several degrees below zero. In the morning an inspection of the fresh water level in the tank showed no change. Returning to the pump house we discovered that the entire suction line had frozen solid and shattered. Apparently the old pump was too weak to move the water fast enough to prevent freezing.

On January 7th, materials were purchased to rebuild the suction line with the additional purchase of a portable 5 horsepower gasoline powered booster pump to be placed out on the ice to supply sufficient force to supplement the weak centrifugal electric pump.

In the image to the left, the booster pump is being placed on the ice and set up with a new suction line out to a new hole in the ice that now is around 5 inches thick. You can see at the bottom left of

the image, next to our shattered line and our new line under construction, at least two of several former suction lines into the lake. One of these lines is a three inch diameter transite pipe similar to the water lines throughout the town that were replaced in the 1950s for both the fresh and mineral water systems.

This portable temporary setup pictured on the previous page is standing by for use when the lake is frozen, and when the temperature is too cold to operate the permanent suction line. By nightfall on January 8th, this system was still not able to deliver water into the pump house.

On January 9th, a kerosene turbine heater was purchased to direct a hot air blast to the base of the pump house. This setup was shrouded to keep out the cold air, and the base of the building was thawed completely. Chunks of ice exited the line onto the ice confirming that this was the location of a blockage in the suction line that probably was a major part of the problem to that point. The ball valve in the pump house was opened that afternoon to drain all of the fresh water out of the tank on the hill, through the transport line between the tank and the pump, and through the stationary pump and the suction line out onto the ice over the next 5 or so hours.



January 7
Fix #2

That night of the 9th, the system was primed, and both pumps were turned on. The night was again bitter cold and below zero, but the booster pump ran flawlessly through the night supplementing the stationary pump in the pump house. Although the booster pump with its small gas tank required fuel every two hours, by early morning, the elevation of mineral water in the tank reached its maximum level.

Inspection of the water level in the tank is measured from the bottom of the roof trusses to the surface elevation of the mineral water in the tank.

On January 10th at 9 AM, the elevation of water had reached to within 10 inches of the bottom cord of the trusses, the pumps were shut off, and the temporary setup was removed from the lake.



**access hatch to
inspect water
level in tank**

Twenty four hours later, the elevation in the tank was still holding at 10 inches, and the officials of the Natural Spa and Resort were told to purge their lines of fresh water and to expect that the mineral water would return to the expected strength.

Later that day, the Secretary of the Soap Lake Conservancy, Gene Wing, visited a room at the Lodge and using equipment for this purpose, tested the water strength at a tub faucet to compare it with the with readings from the lake where the water was extracted. The concentration of minerals at the tub approximately matched those of the lake, verifying that the conditions had returned to normal, and that the crisis was over.

3. What was Learned from this Experience?:

The most important finding from this whole experience in our estimation was:

1. The mineral water pumping system is obsolete. You can see from the picture of the inside of the pump house that even the concrete base of the pump is cracked placing the pump and the pump motor out of alignment stressing the bearings. The entire pumping setup needs replacement with a more robust and perhaps more powerful pump plus redundant equipment to ensure consistent and reliable operation.
2. The transport line between the tank and the pump did not freeze, even during the coldest night with no circulation in the system due to the frozen pump. This means that the line is buried at sufficient depth to be serviceable except for the line condition. The line is likely of transite construction placed along with the complete re-piping of the town during the 1950s. It should likely be considered due for replacement along with the entire fresh water and mineral water delivery systems. The fresh water system is slated for eventual replacement, and the public discussion concerning the scope of and eventual replacement of components for the mineral water system is overdue.
3. The concrete holding tank, and the transport line discussed in point 2 do not leak. When the pump was shut off, and the valve in the pump house was closed on January 10th, the elevation of the reservoir did not lose even a half inch of elevation in the tank over 24 hours. This is indeed good news.
4. The several hundred foot long suction line into the lake from the pump house needs to be reengineered and made more robust, along with the repairs to the pump house. The temporary fix is just that – temporary.
5. The elevation in the mineral water tank needs a float and signaling system. The cost of providing this is nominal, and I am surprised that this was not included by our engineers during the installation of telemetry for the fresh water system. Requiring that someone visually inspect the level of water in the tank is primitive and inefficient of people's time, and makes no sense.
6. If the city takes its municipal responsibility seriously, it should ensure a reliable supply of mineral water to its customers without interruption – the failure of the system was unnecessary, and counter to our comprehensive plan

which encourages year-round use of our public and private commercial facilities consistent with our other plans for economic development.

4. Our Plan for Moving Forward:

We need a public discussion to determine the current and future value of the mineral water delivery system. This is a true municipal system unique in the country. Our lake is unique in all the world, and a resource that we must protect.

Working out the steps necessary to perfect the mineral water system in conjunction with plans to protect the lake, and our economic developments plans, current and future, will have to take place. If the City decides to divest their interest in any part of the system, or the only remaining certified water right to the mineral water is a decision too important to be left to a handful of people no matter how qualified.

In the short term, the replacement of the pump house and the suction line is necessary to ensure the reliable delivery of mineral water. This is an urgent problem requiring immediate attention. The estimate from a qualified practitioner, Kirk Youngers is included in the addendum. This estimate is for \$64,191.19. Given the neglect of the system, to us this seems reasonable and better than expected.

We also need to provide telemetry to constantly monitor high and low water events at the tank. This cost is not included in the estimate but should be around \$1000, depending on whether we can tie it into our new municipal system.

These changes are what is needed for the next 5 years.

In the longer term, we need a plan for replacing the delivery system. At this time we know that the transport system and the tank are not leaking. However, these facilities will eventually have to be replaced along with the entire delivery system. We do not know if the delivery piping is leaking, but along with the fresh water delivery system, all of the transite pipes in town will have to be replaced in less than twenty years.

The cost of replacing piping systems is mostly in the trenching, and the repair and repaving of surface improvements. Adding a second pipe in the trench for the mineral water delivery system is nominal, and could be accomplished, if well planned, without adding much to the cost of re-piping the town.

Questions of how extensive the mineral water system extends is a great question for debate. We need to restore service to McKay Hospital District who is discussing a wellness facility. We know that at least 300 service connections at one time served the residents of the town. This shows that a mere 60 years ago there was great investment in the system, regardless of recent neglect of the system.

It is unknown how many of our current residents would be interested in being included in a refurbished system to bring water to the homes. We are truly unable to estimate how many future residents might be interested in connecting to the system, or what they might be willing to pay monthly for the service.

There are other issues involving say returning waste bath water back into the lake, either from the commercial facilities or from single family residents. I can certainly imagine holding tanks at the residences for eventual collection by tanker for return to the lake. This discussion also necessitates considering plumbing, health, and legal issues that would have to be worked out.

Who can pay for the repairs, and should the public be required to support a system that currently only serves a handful of commercial customers? This is not a discussion for only a few. After all a school or hospital system does not serve everyone, but it is considered necessary to fund for the public good. When we examine communities with a unique asset, it is possible to boost the economy of an entire city, if the resource is handled thoughtfully and with appropriate input and design.

Traditionally the mineral water system was maintained in concert with the fresh system and using the same fund. When these funds were separated, the water systems held over \$300,000 in reserves, yet none of these reserves were transferred to the mineral water fund at the time for maintenance.

The system was told to sink or swim on your own. They were told to maintain an ancient and ailing system with whatever they could garner from a handful of active services. Obviously this was an impossible task following years of neglect. The results are indicative of what would be expected. The public was not involved in this transfer expect during public comment. It is time to examine all of these issues in an open and wide public forum.

John Glasco – Steve Wellein, January 26, 2017

5. Addendum, Costs of the immediate fix, and Estimate from Wire 2 Water for necessary repairs to the pumping and suction systems:

Receipts and invoices for the Fix of the Soap Lake Mineral Water System

December 27, 2016 - January 10, 2017

January 6 – Ace - \$27.83
January 7 – Home Depot - \$273.41
January 7 –Home Depot - \$9.69
Total Steve & John \$310.93
January 14- Kirk 1 – Fees & Travel - \$935.80 – Parts - \$1,743.25 – Total - \$2,679.05
January 14 – Kirk 2 – Fees & Travel - \$718.50 – Parts - \$402.04 – Total - \$1,120.54
Total Kirk - \$3,799.59
Billed to City account - \$54.79

Total Fix – Parts - \$2,511.01 – Total Fees & Travel - \$1,654.30 – **Total Fix - \$4,165.31**
John Glassco – Steve Wellein - January 26, 2017

Telephone 509 246-1211
Fax 509 246-1213



PO Box 1270
239 2nd Ave SE
Soap Lake WA 98851

August 15, 2018

Gray & Osborne

Re: Soap Lake Mineral Water Accounts

Listed below are the active Soap Lake Mineral Water Accounts:

633	Gustaveson, Linda PO Box 709 Soap Lake, WA 98851 (509) 246-0703	311 1 st Ave SE	Residential	1 unit
637	Gustaveson, Linda	22 S Canna	Multi Family	4 units
840	Slough, Lesley PO Box 1417 Ephrata, WA 98823 (509) 764-4200	318 E Main Ave	Commercial	2 units
2614	Soap Lake Natural Spa & Resort – Inn PO Box 1527 Soap Lake, WA 98851 (509) 246-1132	226 E Main Ave	Commercial	9 units
2642	Soap Lake Natural Spa & Resort – Lodge	236 E Main Ave	Commercial	20 units

I have contacted each customer by phone and let them know you will be contacting them to talk about Soap Lake Mineral Water.

Let me know if I can be of further assistance.

Anita Richardson
Deputy Clerk

Kaleb Smith

From: Sean Comstock <[REDACTED]>
Sent: Wednesday, November 07, 2018 1:39 PM
To: 'Kaleb Smith'; 'Adam Miller'
Subject: FW: Update on Mineral Water System

*Sean Comstock P.E. | 509.853.2460 p | 541.420.4797 c
Gray & Osborne, Inc. | 11 Spokane St., Suite 207, Wenatchee, WA, 98801*

From: Nancy Wetch <[REDACTED]>
Sent: Wednesday, November 07, 2018 1:39 PM
To: 'Sean Comstock' <[REDACTED]>
Subject: FW: Update on Mineral Water System

FYI

Nancy Wetch, P.E. | Gray & Osborne, Inc.
Project Engineer | Yakima, WA
(509) 453-4833 Office | (509) 945- 9894 Cell
www.g-o.com | 180 Iron Horse Court

From: John Glassco <[REDACTED]>
Sent: Wednesday, November 07, 2018 12:21 PM
To: Kirk Youngers <[REDACTED]>; Mau, Russell E (DOH) <[REDACTED]>
Cc: Raymond Gravelle <[REDACTED]>; Dave Tweedy <[REDACTED]>; Steve Wellein <[REDACTED]>; Karen Hand <[REDACTED]>; Robert Brown <[REDACTED]>; Kandis Lair <[REDACTED]>; Katherine Kenison <[REDACTED]>; Nancy Wetch <[REDACTED]>; Mike Meskimen <[REDACTED]>; Judith Gorman <[REDACTED]>; Darryl Piercy <[REDACTED]>; Fronsman Darrin <[REDACTED]>
Subject: Re: Update on Mineral Water System

Russell, Thank you for your comments concerning the mineral water system. As we move forward, public health and safety are our first concerns. After all, the healing properties of the lake water are what inspired the building and incorporation of the town a hundred years ago. Insuring the survival of our unique healing water delivery system is a fitting tribute as part of the city's centennial celebration.

After all, the lake is the original reason for the town being here. The mineral water system provides year-round public access for the enjoyment of bathing in the mineral water. A city sponsored spa development plan from a few years ago emphasized this point. Besides being a bedroom community, preserving the mineral water is a necessary component of any future economic development for our traditional tourist town.

Further to your explanation, I now understand the reason for the check valve on the fresh water system. Probably such a check valve makes sense for any home with or without mineral water service. The reason I say that is because I don't believe that a cross connection from the mineral water system would be a health risk.

Holly Pinkart of CWU with her team conducted the baseline microbiological study of Soap Lake that was published in 2005 by the National Science Foundation. During her study of the lake, Dr. Pinkart experimented with many of the properties of the water. One experiment exposed common species of bacteria to Soap Lake mineral water. Apparently, staph (Staphylococcus) bacteria was able to survive for only a fraction of a second in the water. Rather than a health hazard, Soap Lake mineral water has all natural antibiotic properties. There is no evidence that ingesting mineral water has or has ever had any negative health effects. Over the years many people claim that regular sips of the water has only helped their digestion and this is considered to be a healthy practice, although due to the sulfur qualities of the water, an acquired taste.

I guess I am making a plea that the mineral water not be officially classified by the state as possibly hazardous similar to irrigation water or waste water. Especially at our Centennial, the town is attempting to promote the historic and traditional therapeutic properties of taking the waters. If our ordinance must have the bath houses, hotels, and home tubs bear a sign at the faucet warning of the dangers of the water, it seems contrary to our main message about the water's therapeutic qualities.

The city is currently revising our mineral water ordinance, confirming the city's mineral water right with Ecology, and updating the mineral water system's engineering and equipment. It is time also to make sure that we satisfy the concerns and requirements of state health. Our city engineers, our Mayor and city staff will be working with you and your staff over the next few months to go over these issues face-to-face. Thanks again for your help with this important work on updating this unique feature of our special place. John

On Tuesday, November 6, 2018, 10:36:55 AM PST, Mau, Russell E (DOH) <[REDACTED]> wrote:

All:

Thanks for the updated information regarding the Mineral Water System.

I wanted to clarify that DOH requirement for “installation of check valves on mineral water service connections” – this means that check valves are installed on the drinking water service line serving the property, so that if the property, within its property, cross-connects between the mineral water piping and the drinking water piping, then this cross-connected water is prevented from flowing back into the drinking water distribution system and could then enter other homes or businesses.

Thanks,

Russell E. Mau, PhD, PE

Regional Engineer

Office of Drinking Water

Environmental Public Health

Washington State Department of Health

[REDACTED]
509-329-2116 | www.doh.wa.gov

From: John Glassco [REDACTED]
Sent: Monday, October 8, 2018 11:26 AM
To: Kirk Youngers <[REDACTED]>
Cc: Raymond Gravelle <[REDACTED]>; Dave Tweedy <[REDACTED]>; Steve Wellein <[REDACTED]>; Karen Hand <[REDACTED]>; Robert Brown <[REDACTED]>; Kandis Lair <[REDACTED]>; Katherine Kenison <[REDACTED]>; Nancy Wetch <[REDACTED]>; Mike Meskimen <[REDACTED]>; Judith Gorman <[REDACTED]>; Mau, Russell E (DOH) <[REDACTED]>; Darryl Piercy <[REDACTED]>; Fronsman Darrin <[REDACTED]>
Subject: Update on Mineral Water System

Kirk, Further to the last Council meeting, the Mayor and Council have decided to move forward on certain improvements to the mineral water distribution system at this time.

First, the Mineral Water Ordinance is being reviewed by the city attorney based on certain updates. One of the changes will enable meters to be installed by the city for our 5 or 6 existing mineral water customers. You may recall that over two years ago the state department of health required the installation of check valves on mineral water service connections as part of their review of our system standards and their cross-connection control requirements for having "non-potable" water delivered to a residential or commercial property. Since that time, check valves have been installed on the handful of known connections, and inside the buildings as I understand. Having meters on the services will allow the city to compare the volume of water taken from the lake with point of use metering. This will help us determine if we have customers using the mineral water who are not signed-up with the city if the numbers do not match.

Further, we are now working with Nancy, and Mike of Gray & Osborne, our municipal engineers, to assist in the mapping and planning of the withdrawal, storage, and delivery components of the mineral water system. They are currently preparing plans and documents that we will use going forward when we meet with state and federal officials to apply for the second phase of our plan, which is to recycle the mineral water back into the lake. This plan will apply to future customers through the use of holding tanks, and other means to ensure a sustainable use of this limited resource so vital to our city's future development plans.

Please contact Anita for help getting access to the 5 properties so that it can be determined how much effort, and what size meter is needed for each property. I suspect that the former Notaras Lodge, and the former Inn may each require a separate meter. Each property will have to be inspected. The purpose of the inspection is *to develop a bid spec* to have the meters installed. The city is planning to use the expedited small-works roster process so we must have three bids because the cost exceeds the threshold requiring a bid spec. We would like to have you provide the bid specs for the entire job of installing meters on all of the city's signed-up customers connected to the mineral water system. Please use your standard rates to bill us for this work.

Mater Type and Cost: When we talked on the phone about this last Tuesday, we discussed various types of meters and their costs. We would request that you exercise your professional judgement while developing our metering program by keeping the following points in mind:

- We would prefer the cheapest reliable meter that will give reasonable accuracy of say within 2 or 3% with an ability to withstand the somewhat alkaline and corrosive substance being metered. It is understood that no single type of meter may work for all of the service connections, depending on space available, pipe diameters, prospective volumes, etc.
- Consider the addition of radio metering that allows the city staff to read the meter without requiring entry of the building. This could either be included now or later depending on a further decision.
- Anita was here when the city required the check valves be installed on mineral water services. She can help plan how to gain access into the building's service connections and work with the existing owners for the performance of the work.
- Nancy and Mike at Gray & Osborne are available if you need anything from them in preparing these specs. However, we are confident that we will use the simplest process available to perfect this important addition to our mineral water system..